

TWP


O
103
C

O-41-B
MADISON TWP
R.21 TWP.11



SCALE 1"=200'
E=HIGHWAY EASEMENT
TAXING DISTRICTS DISTRICT CODES
MADISON TWP 180
CITY OF COLS GROVEPORT MADISON SD. 530
H=HOUSE NUMBERS
C=COUNTY SURVEY INSTRUMENT

O
42
A

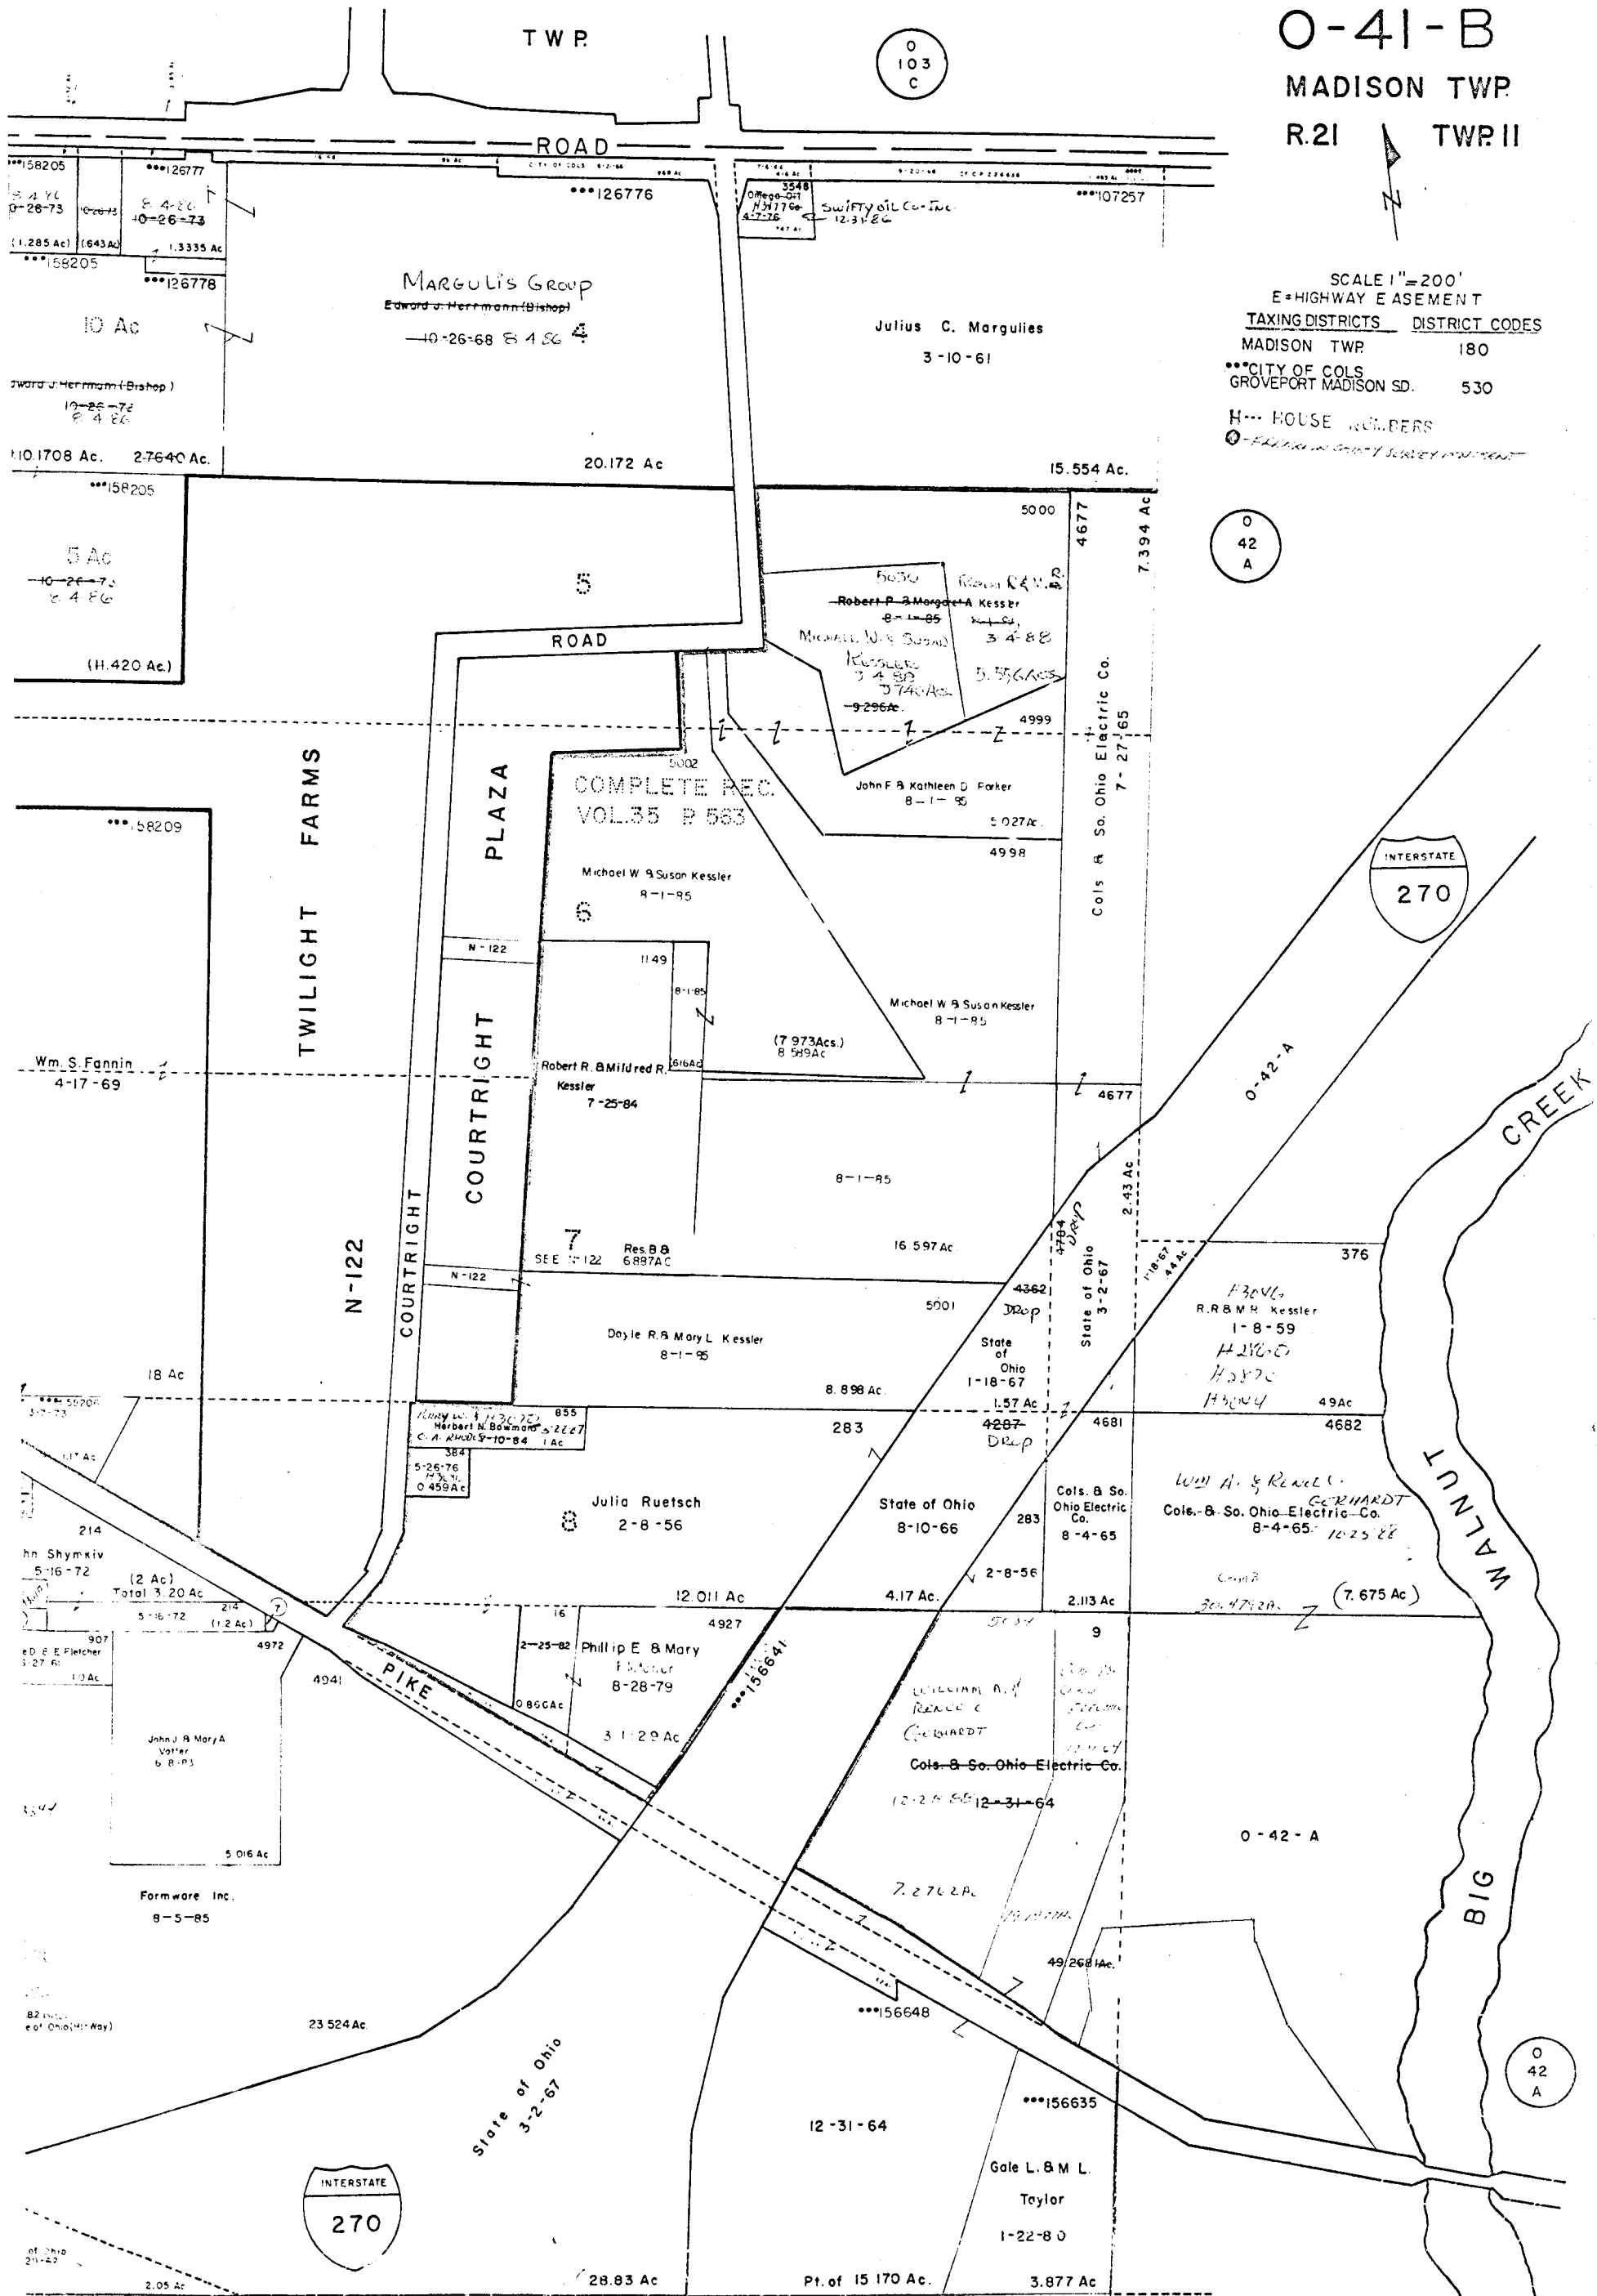

WALNUT CREEK

O
42
A

O
41
D

O-41-B

596

3-13-86