


TRURO

O
103
D

REFUGEE

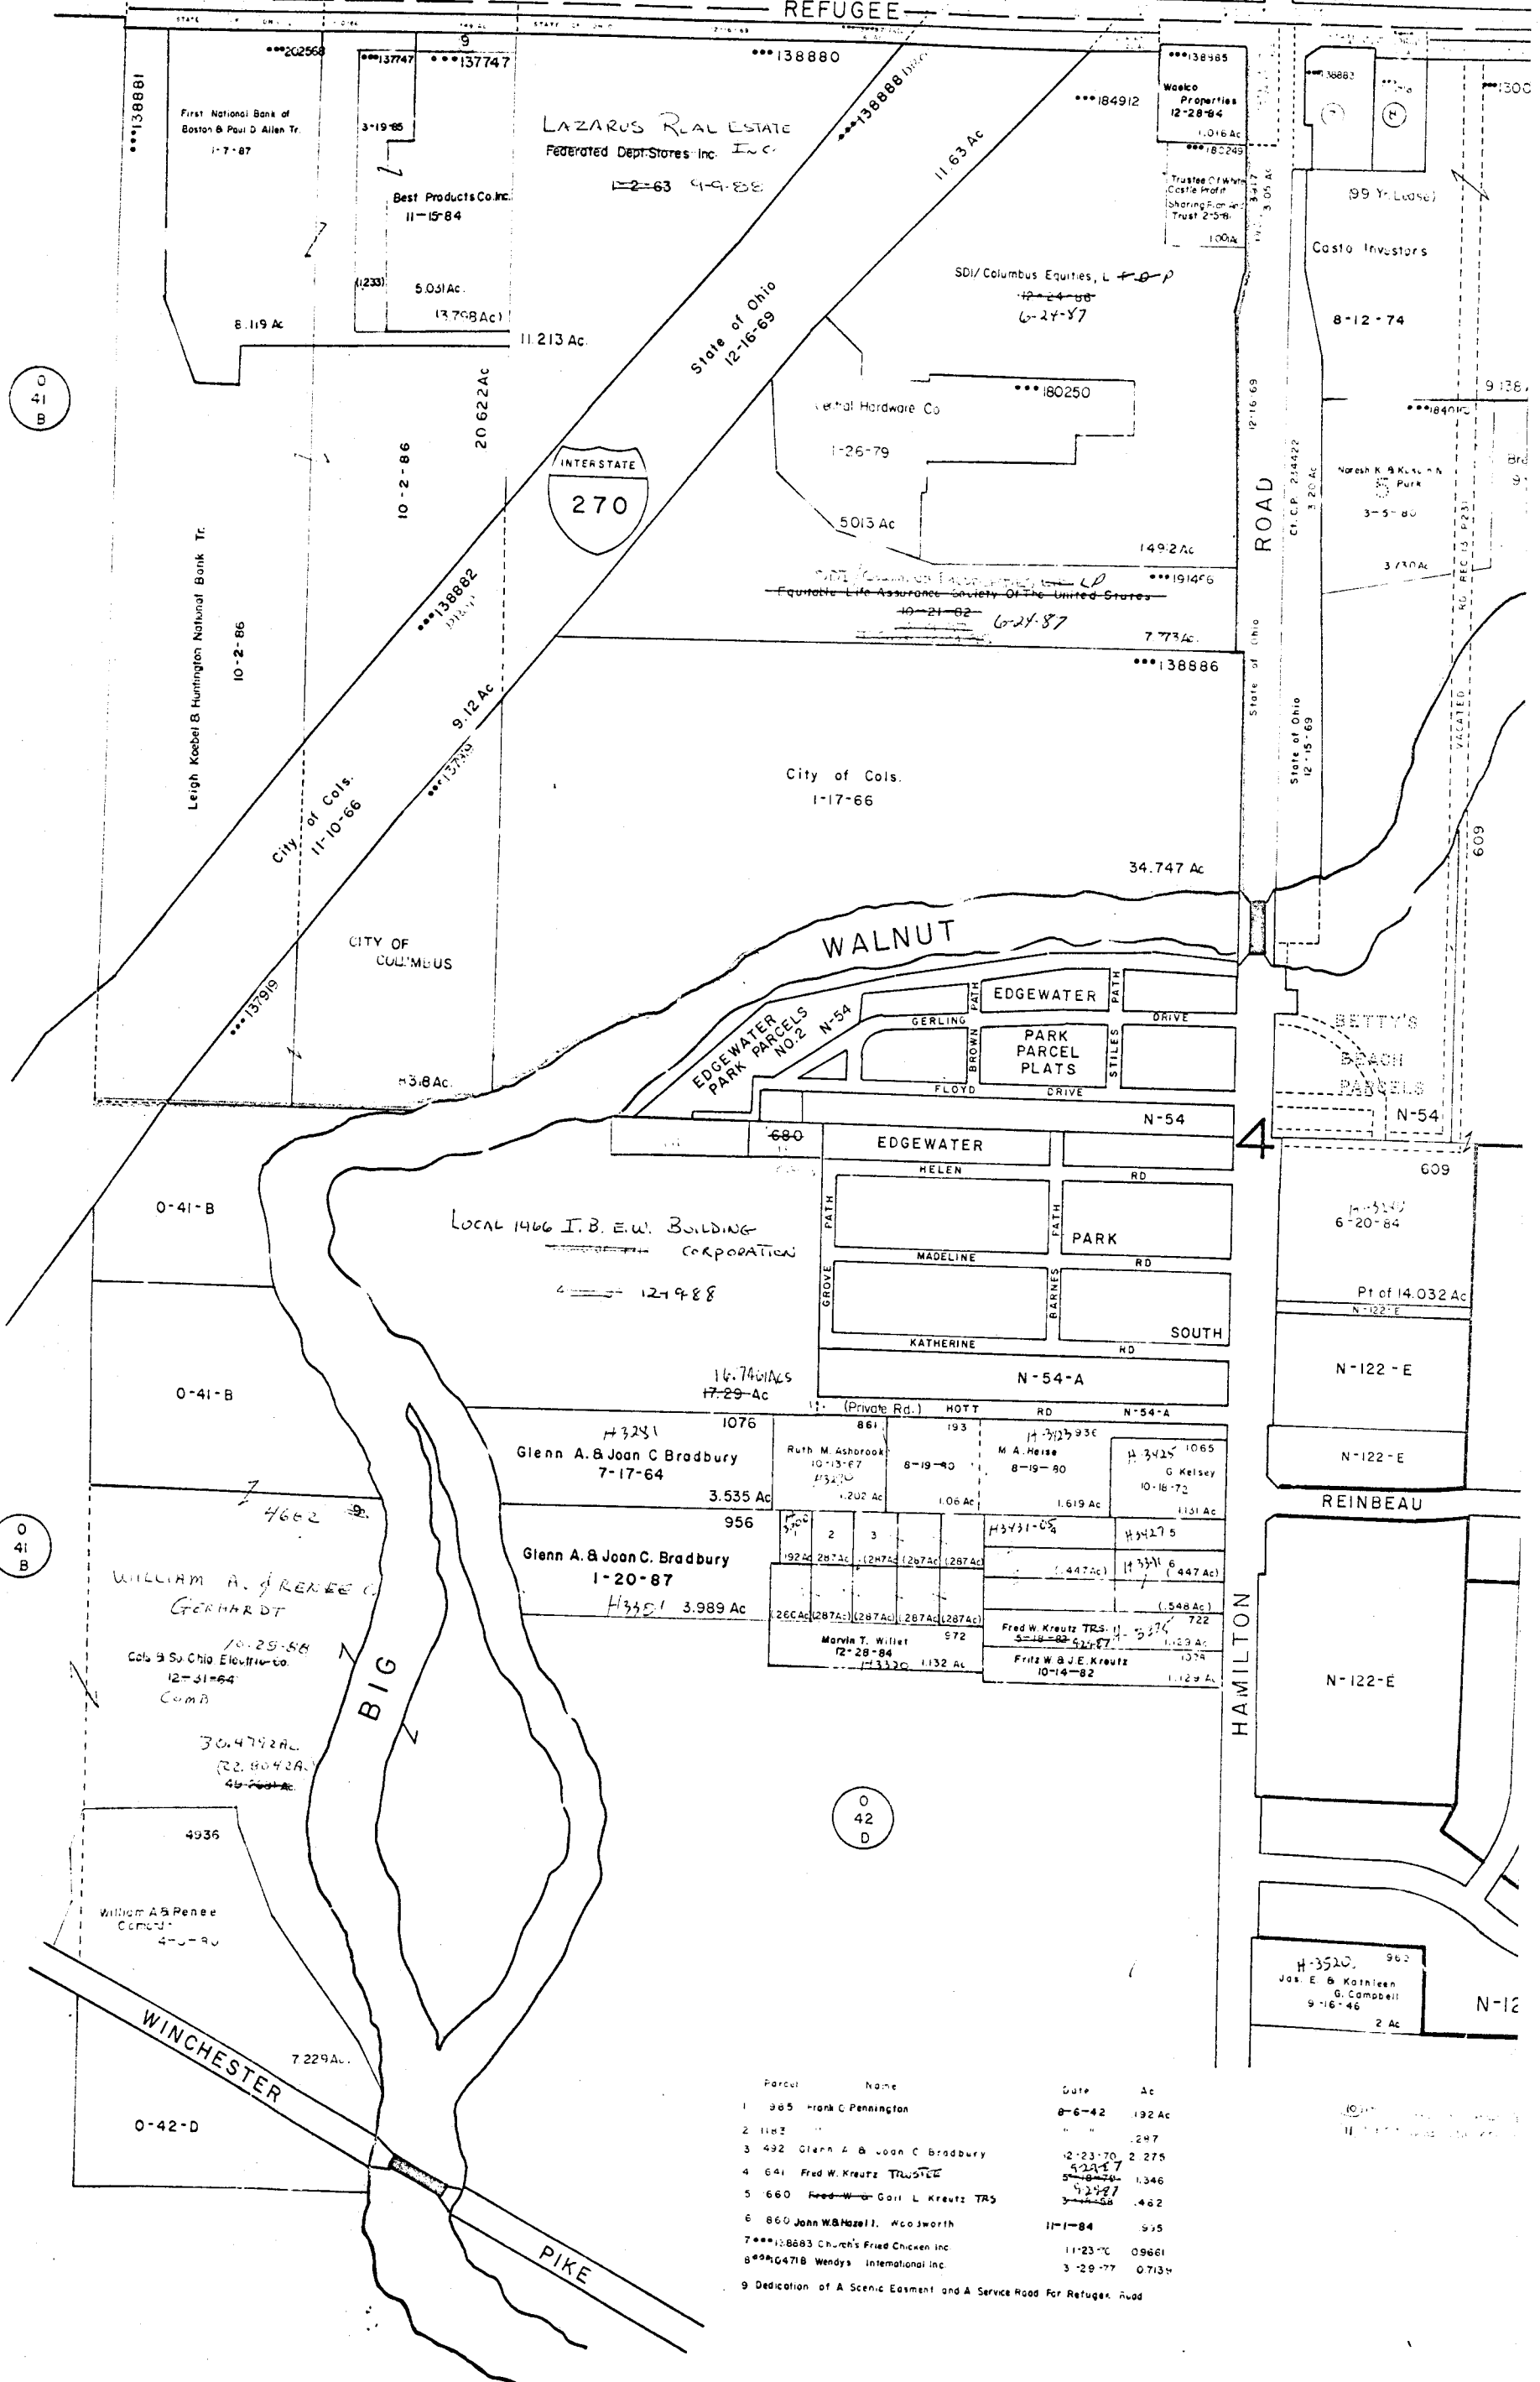

O
41
B

O
41
B

O
42
D


Parcel	Name	Date	Ac
1	385 Frank C Pennington	8-6-42	192
2	1182 "	"	287
3	432 Glenn A & Joan C Bradbury	1-23-70	2 275
4	641 Fred W. Kreutz TRUSTEE	5-22-87	1.346
5	660 Fred W & Gail L Kreutz TRS	5-22-87	4.62
6	860 John W & Hazel J. Woodworth	11-1-84	5.75
7	108683 Church's Fried Chicken Inc	11-23-70	0.9661
8	104718 Wendy's International Inc.	3-29-77	0.7134
9	Dedication of A Scenic Easement and A Service Road For Refugee Road		

TWP

0
104
D

0-42-A

MADISON TWP
R.21 TWP II

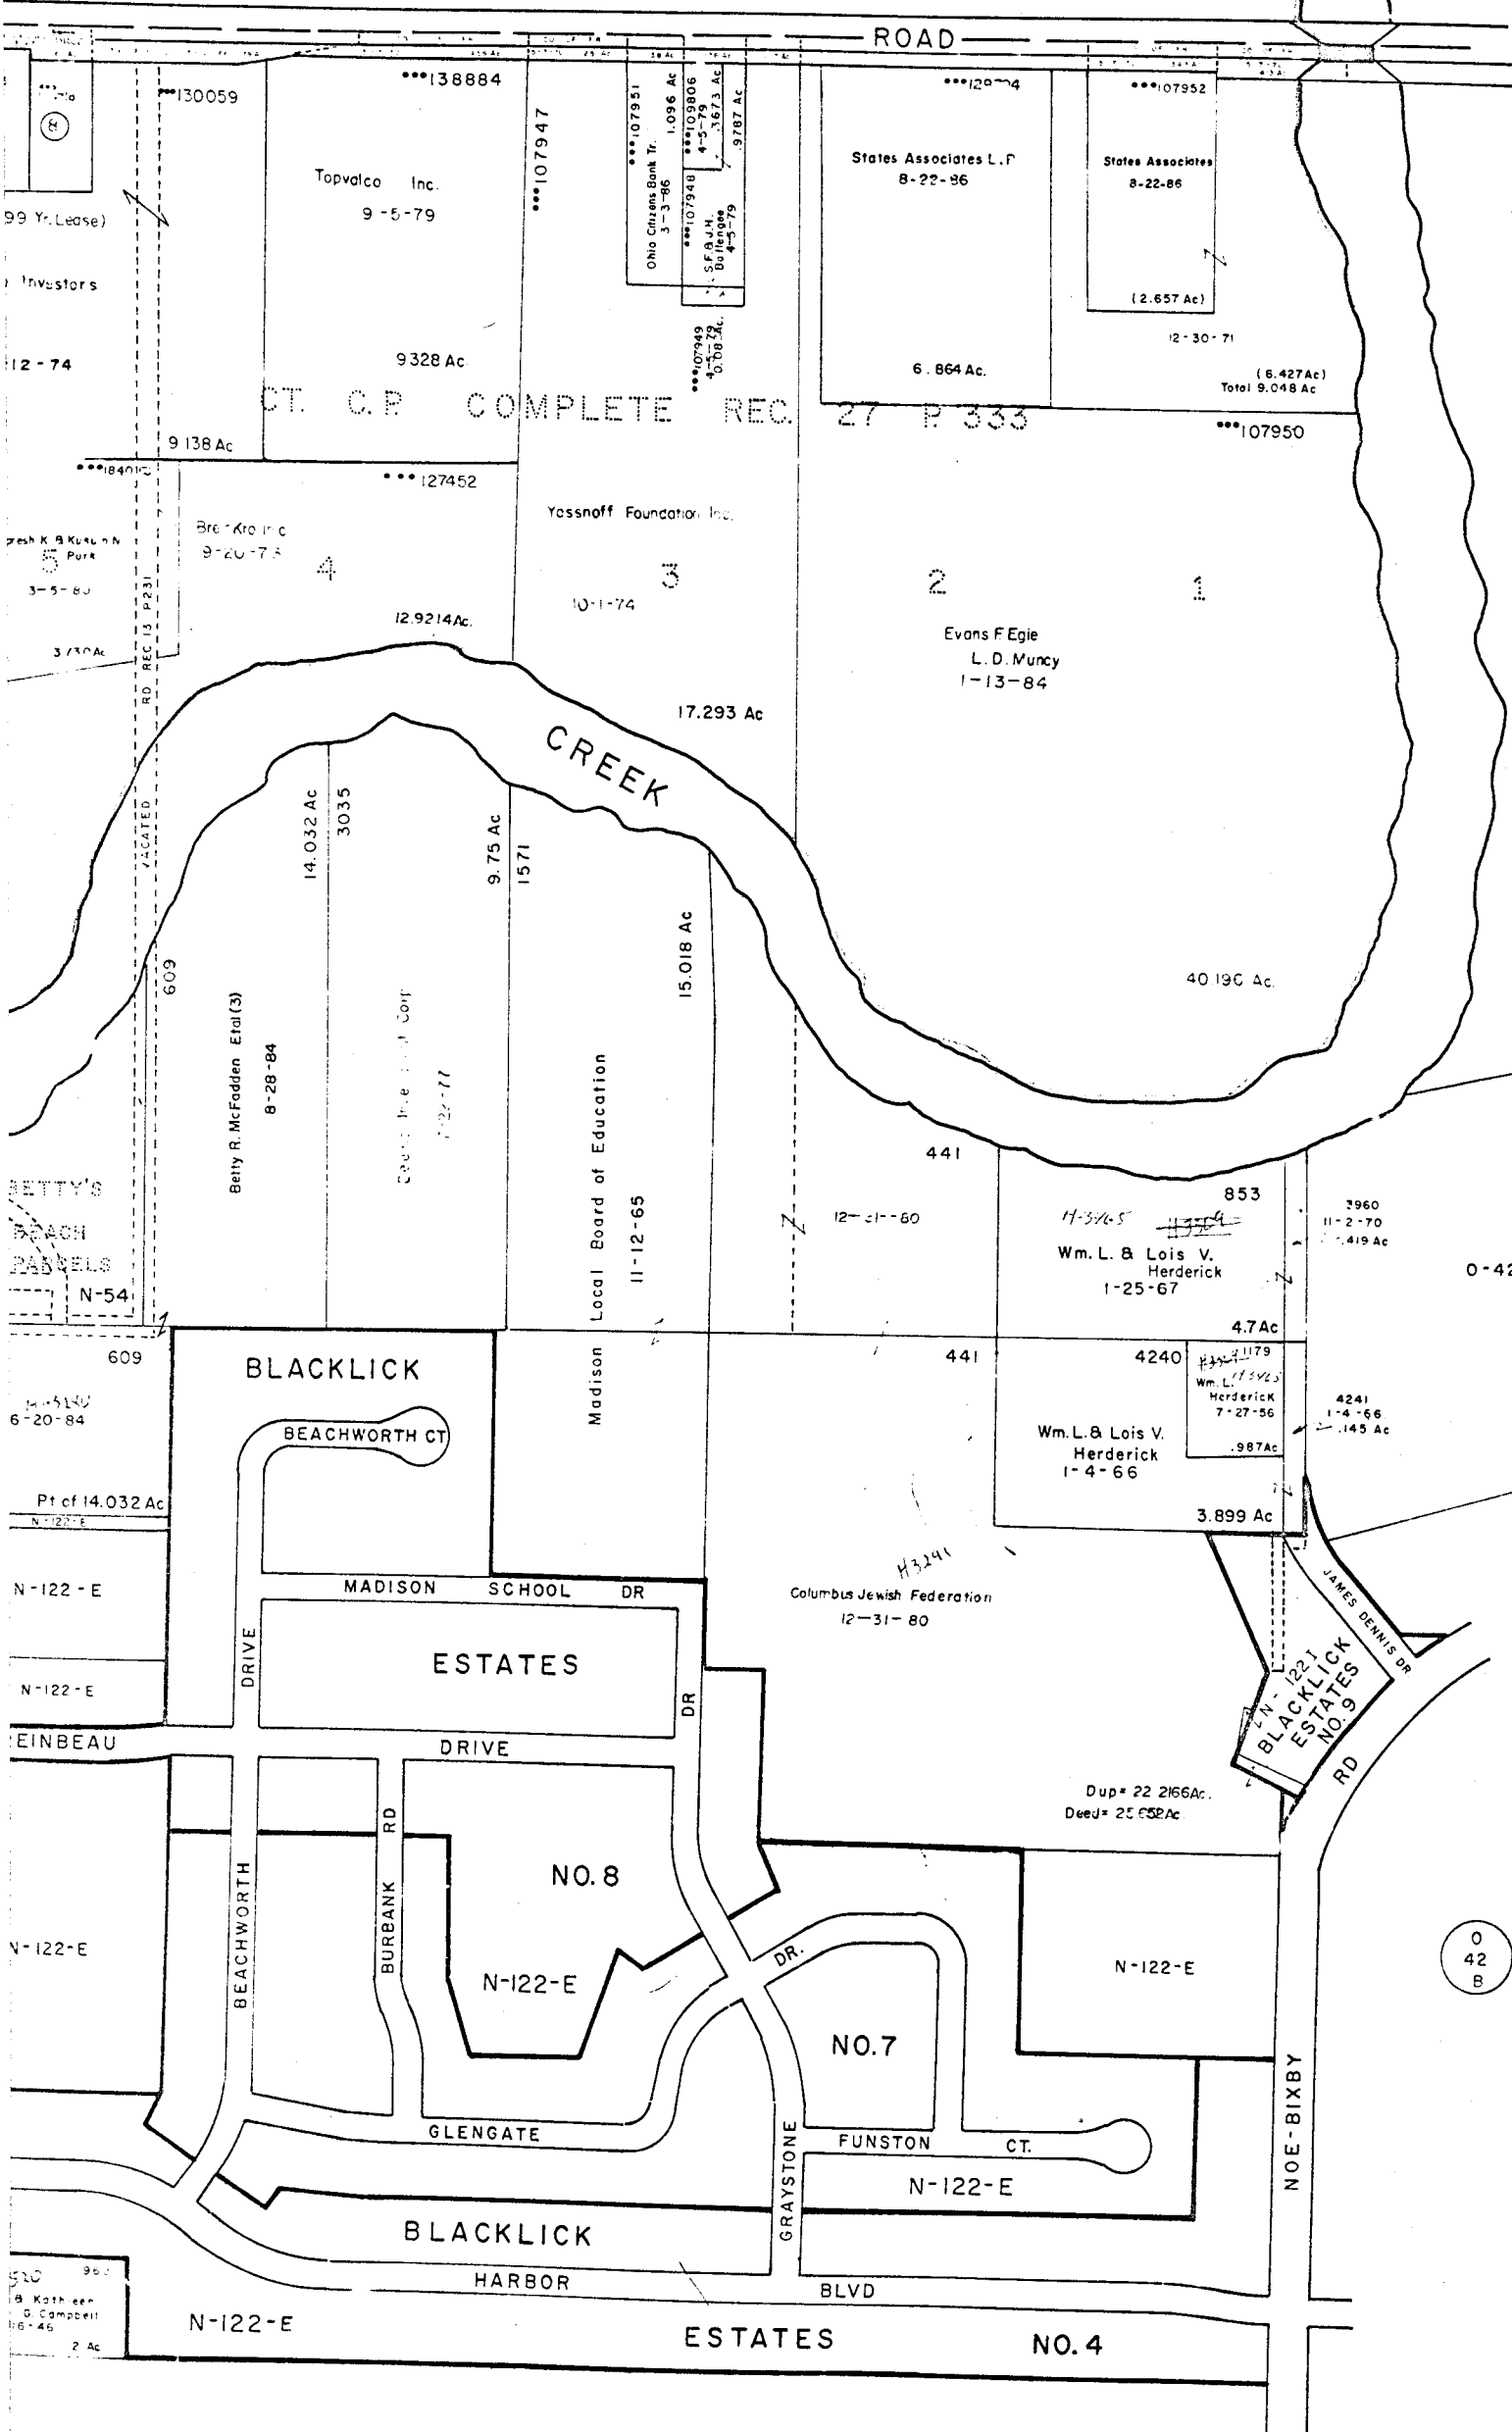

SCALE = 1" = 200'
 E=HIGHWAY EASEMENT
 TAXING DISTRICT DISTRICT CODE
 MADISON TWP 180
 CITY OF COLS. GROVEPORT MADISON 530
 H... HOUSE NUMBERS

0
42
B

0
42
B

0
42
D

0-42-A

