


O  
51  
A


HAYES

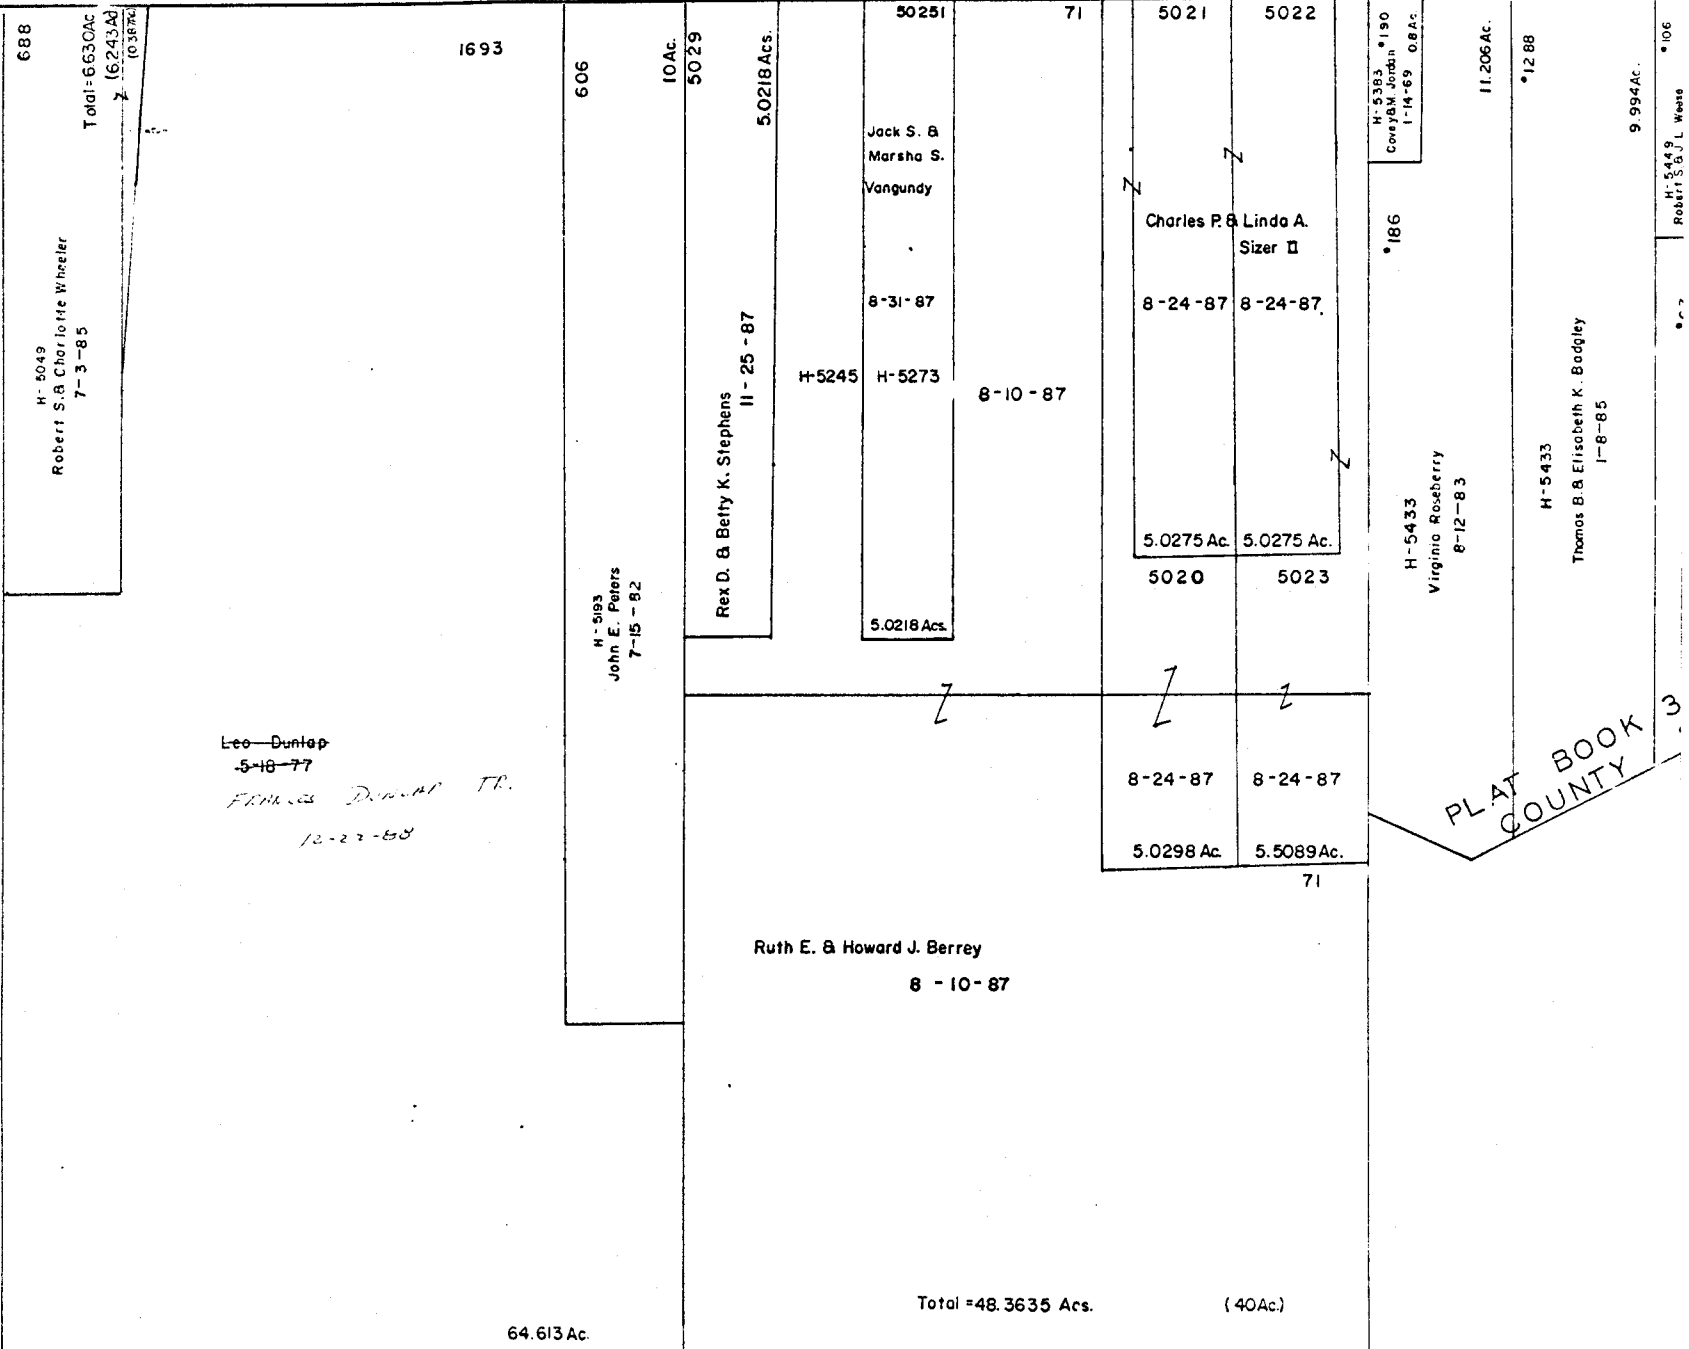

PLAT BOOK  
COUNTY 3

O  
48  
C

O  
48  
E

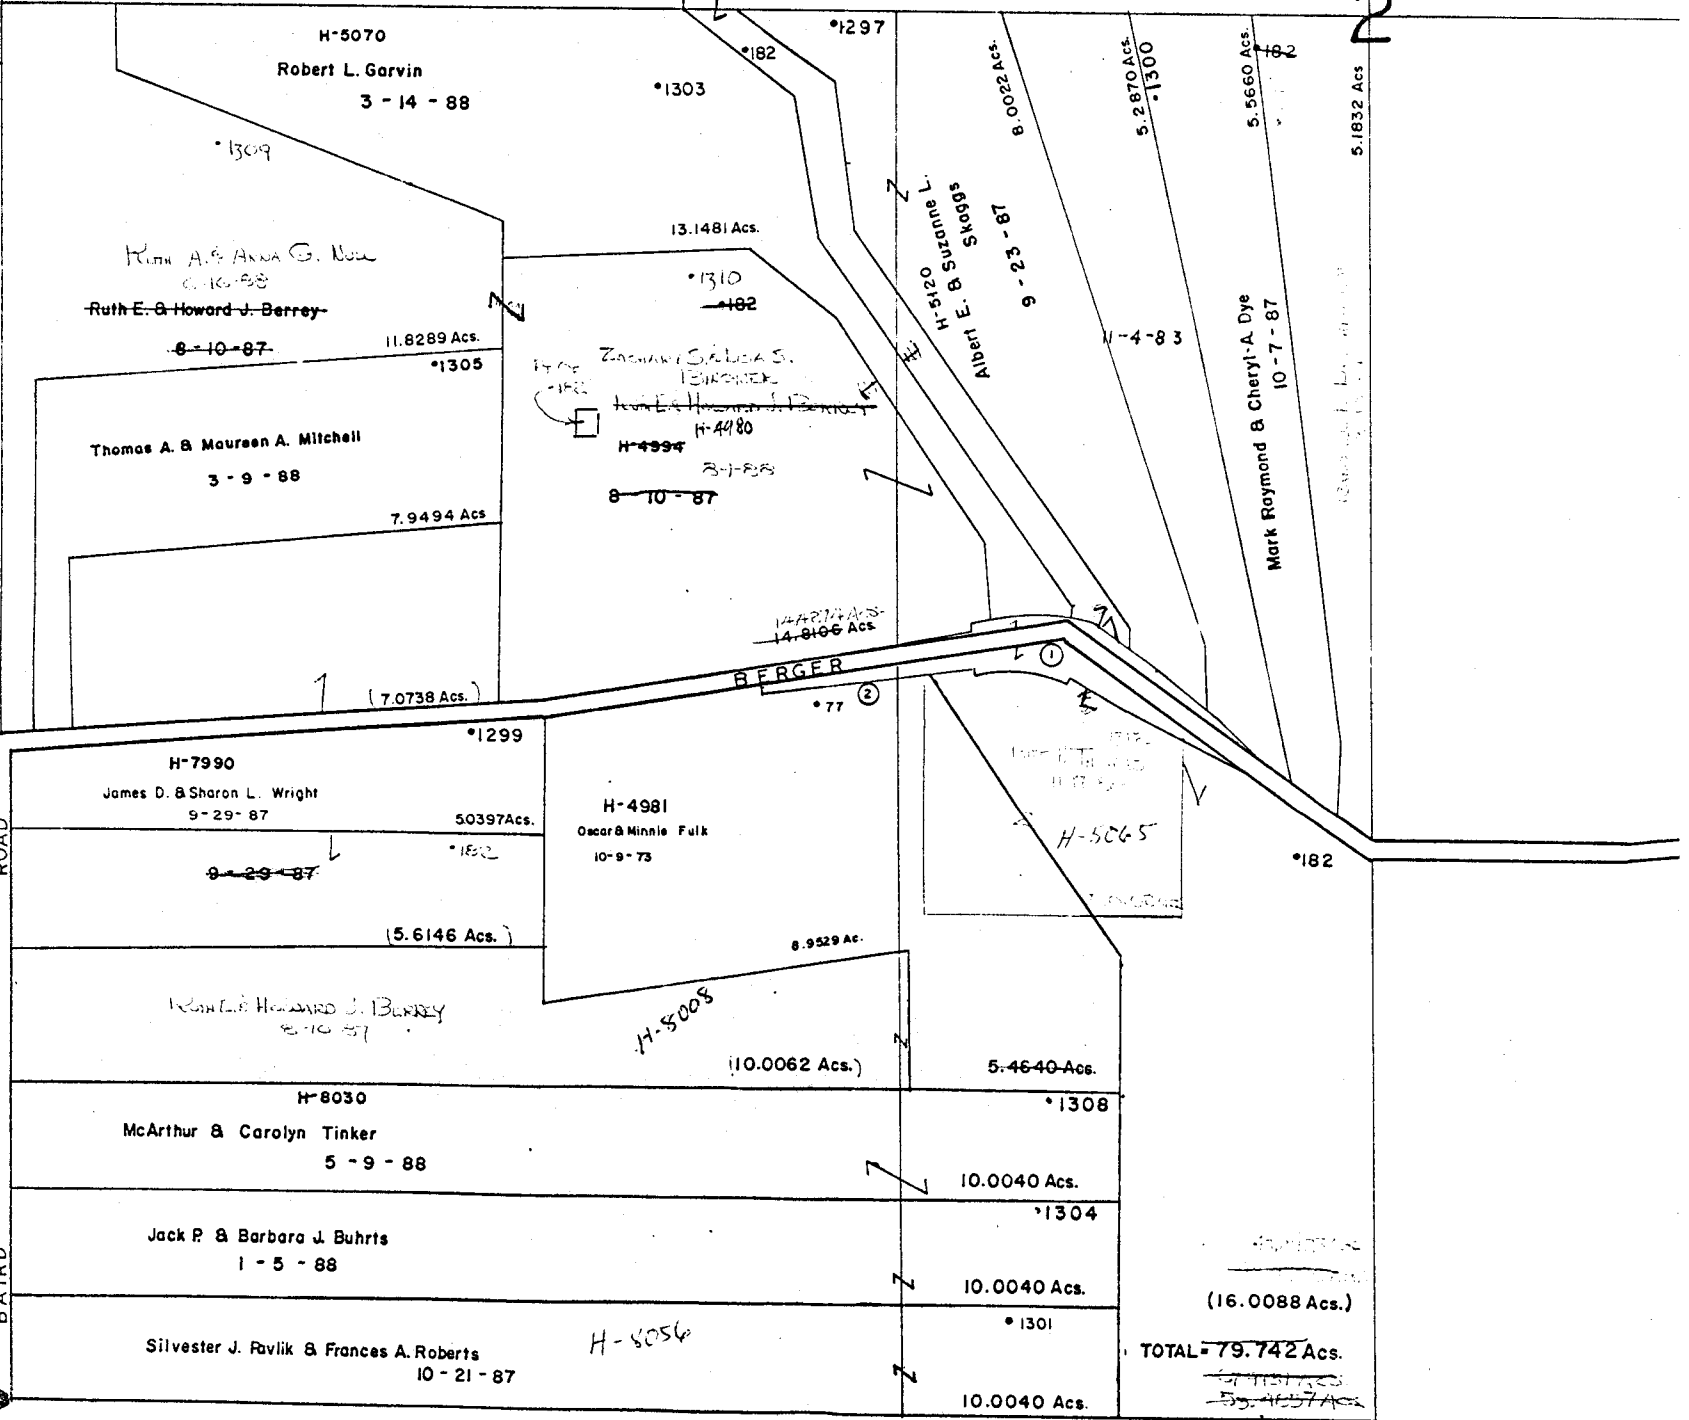

O  
52  
A

0-51-D



MADISON TWP.  
R.21 TWP.10



SCALE 1"=200'  
E=HIGHWAY EASEMENT  
TAXING DISTRICT DISTRICT CODE  
MADISON 180  
\*MADISON TWP  
CANAL WINCHESTER SD 181  
FRANKLIN COUNTY SURVEY MONUMENT  
H-HOUSE NUMBERS



1 - Drop Franklin County Commissioners(Hi-way) 6-23-82 14406Ac.  
2 - Drop " " " 7-6-82 0.1471Ac.

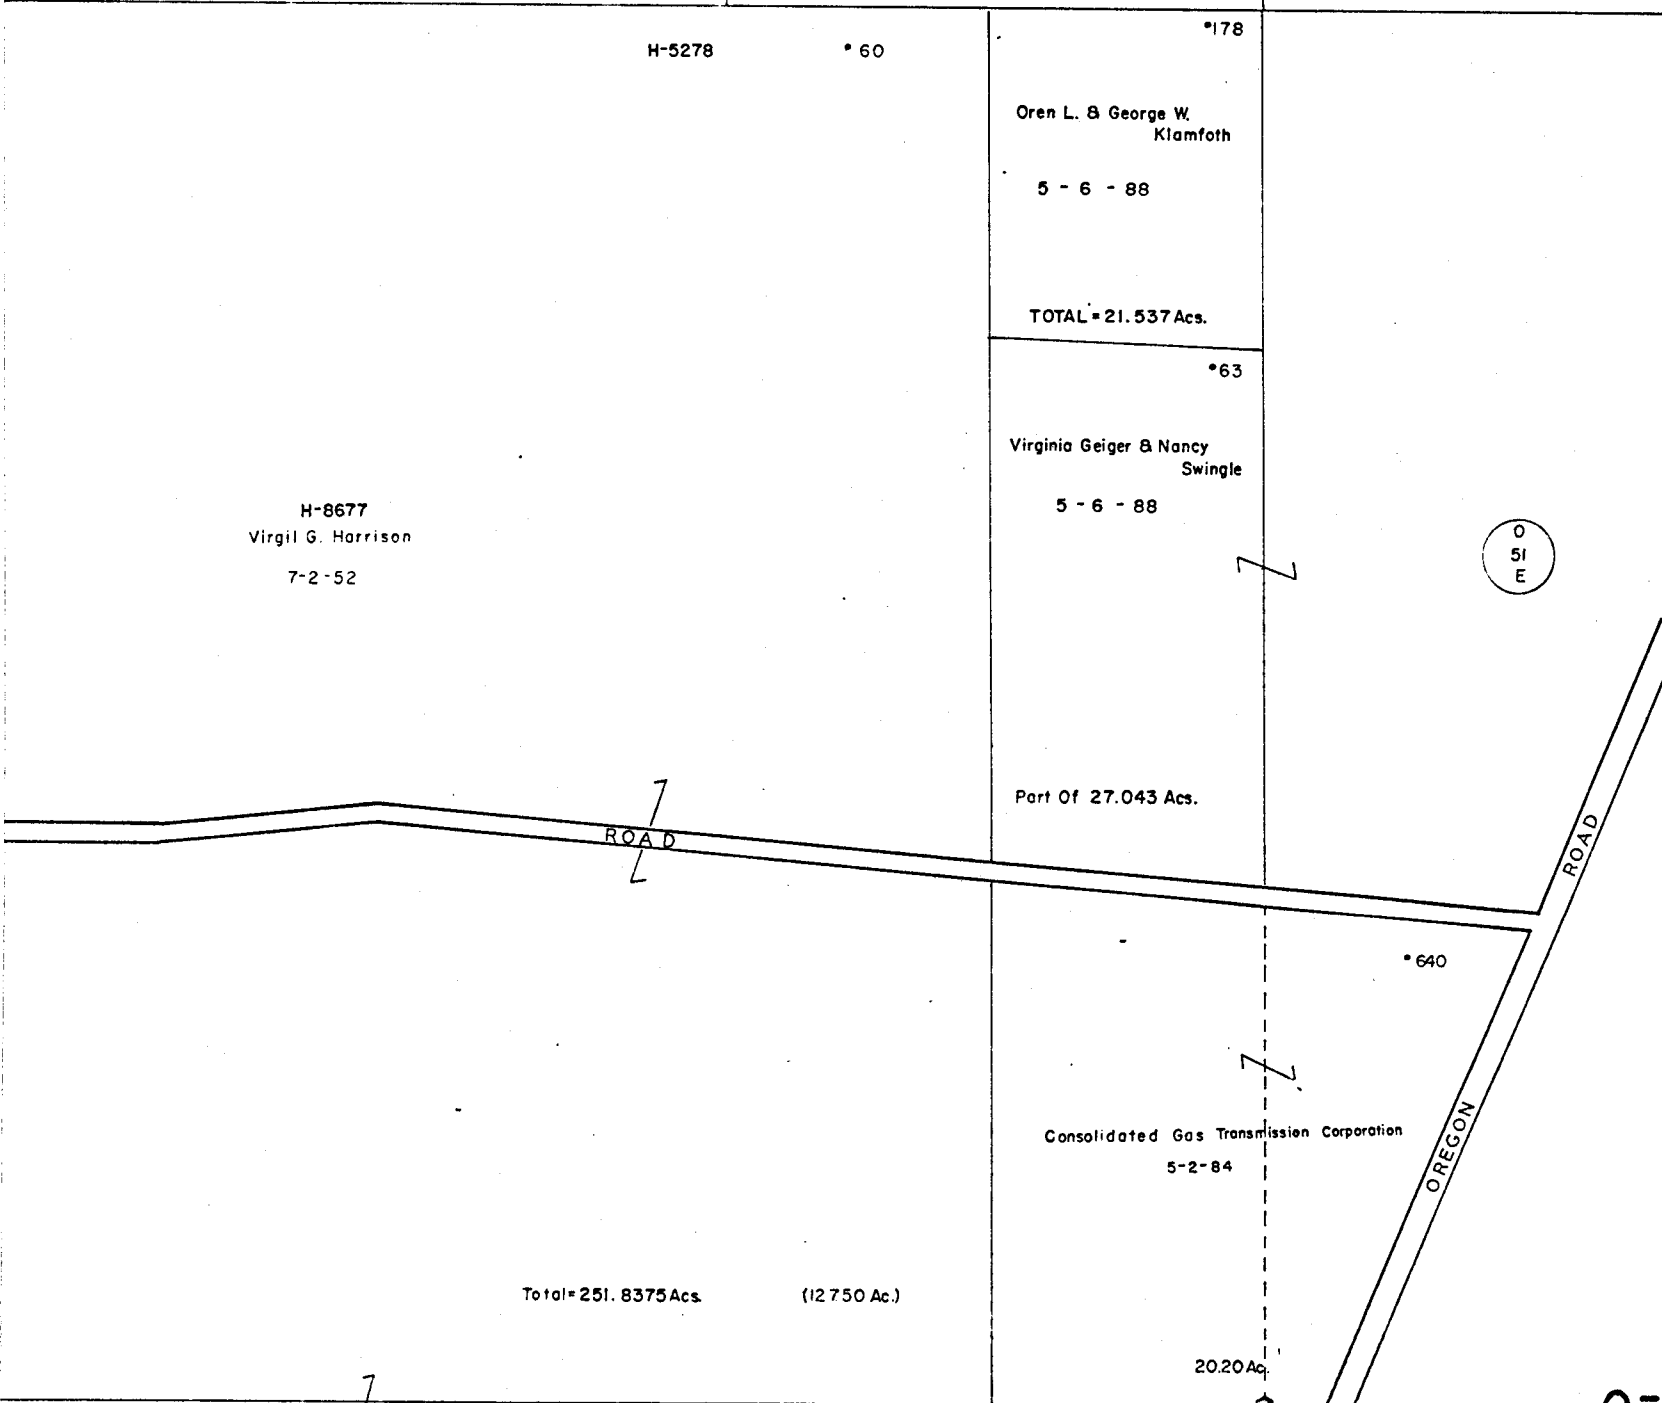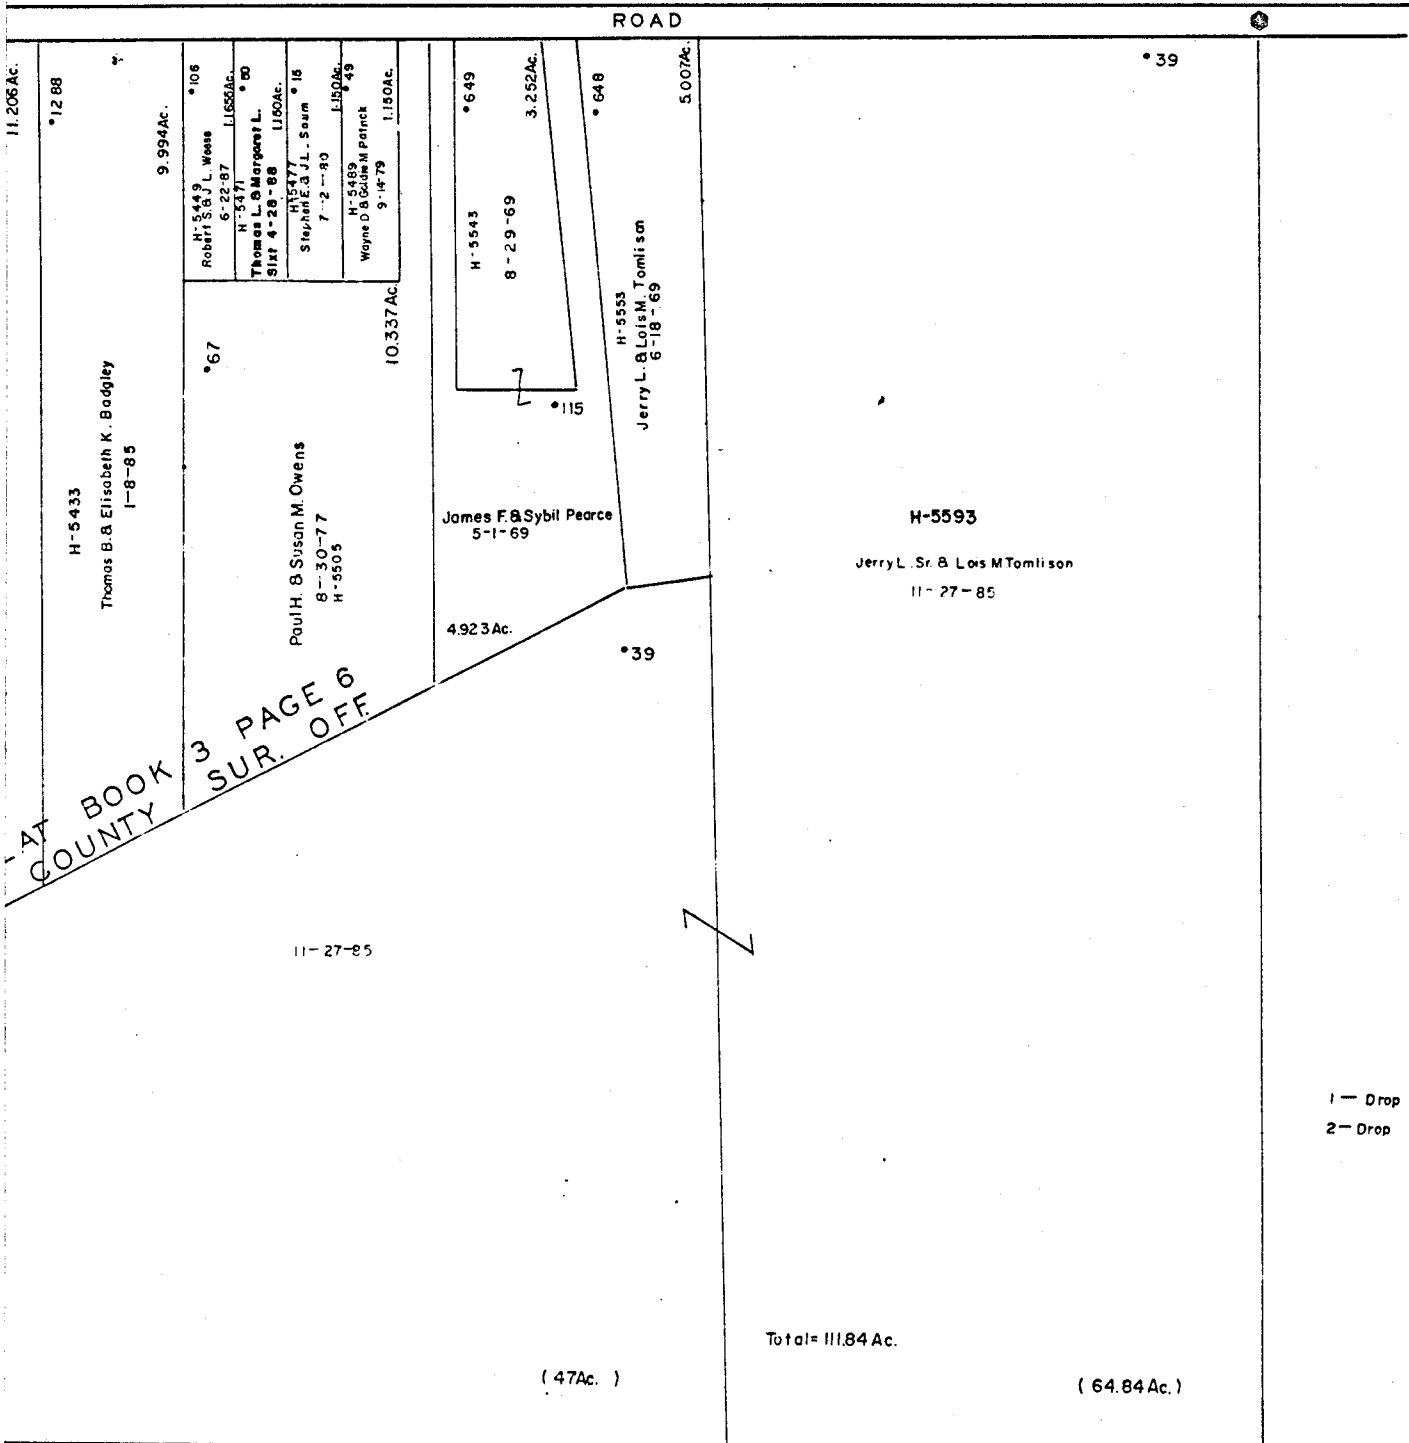

0-51-D

