



0-53-N

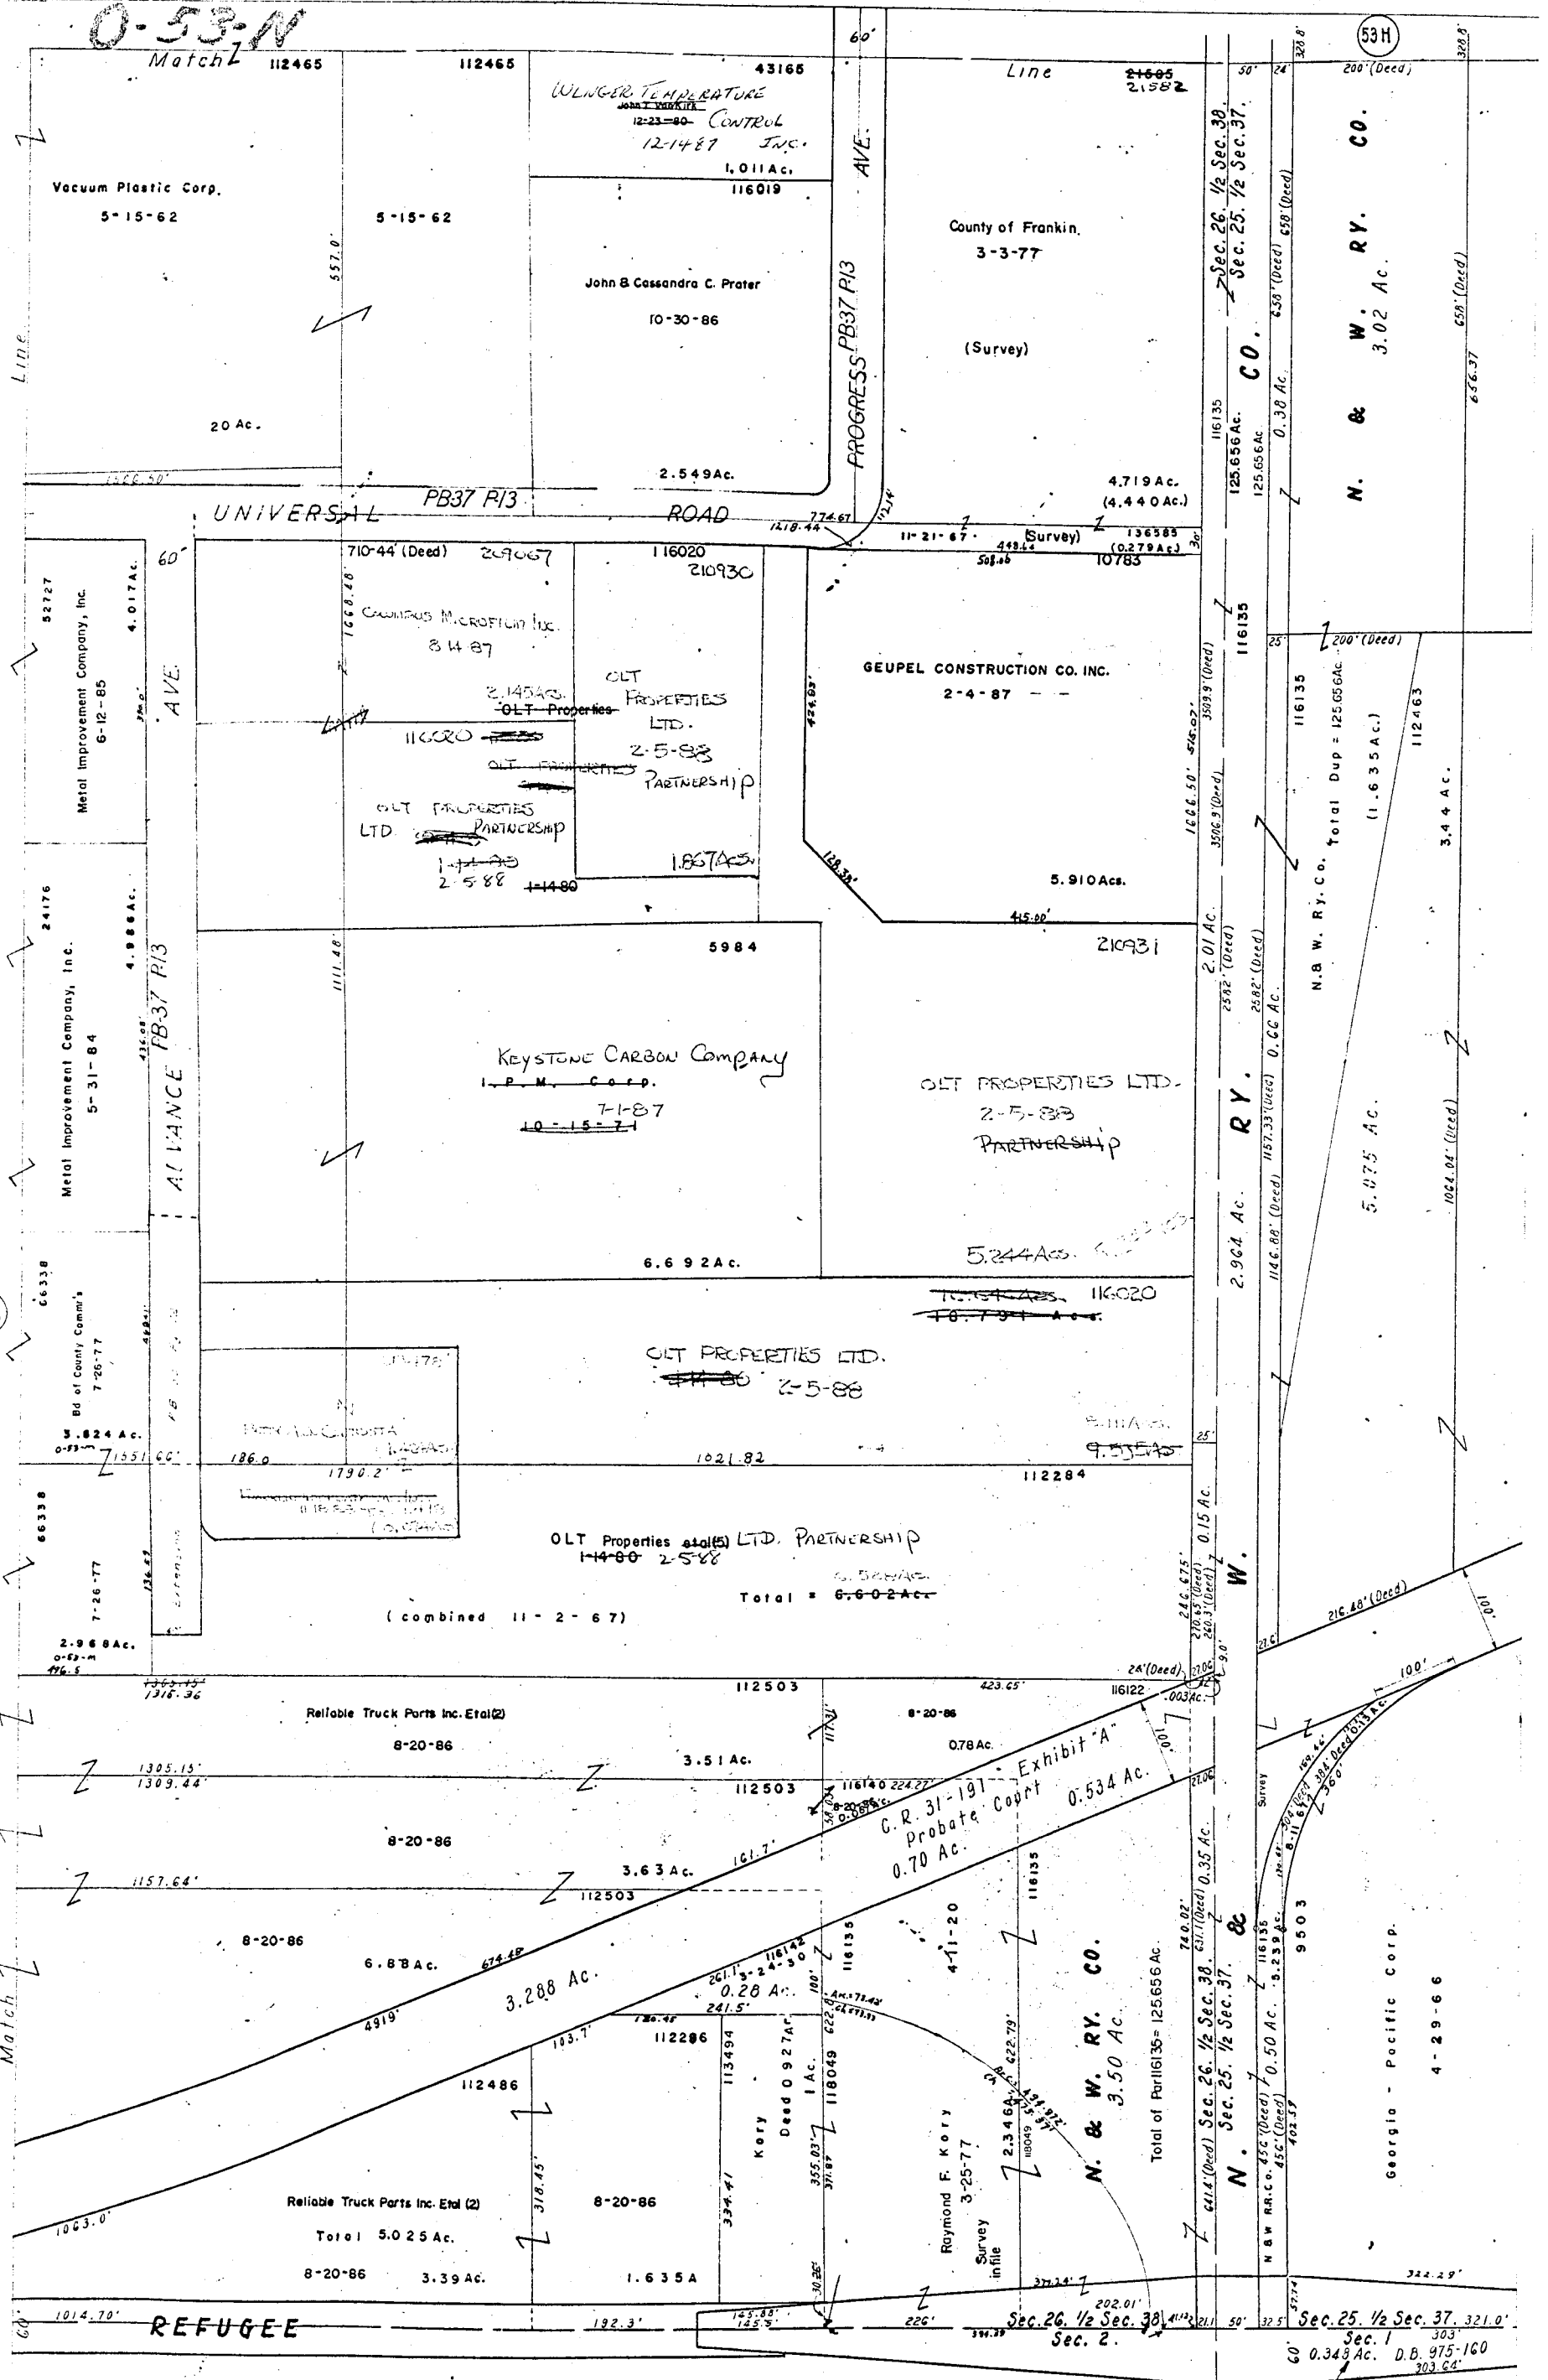

765

See Plans of N. on file in Coun on Dublin Road

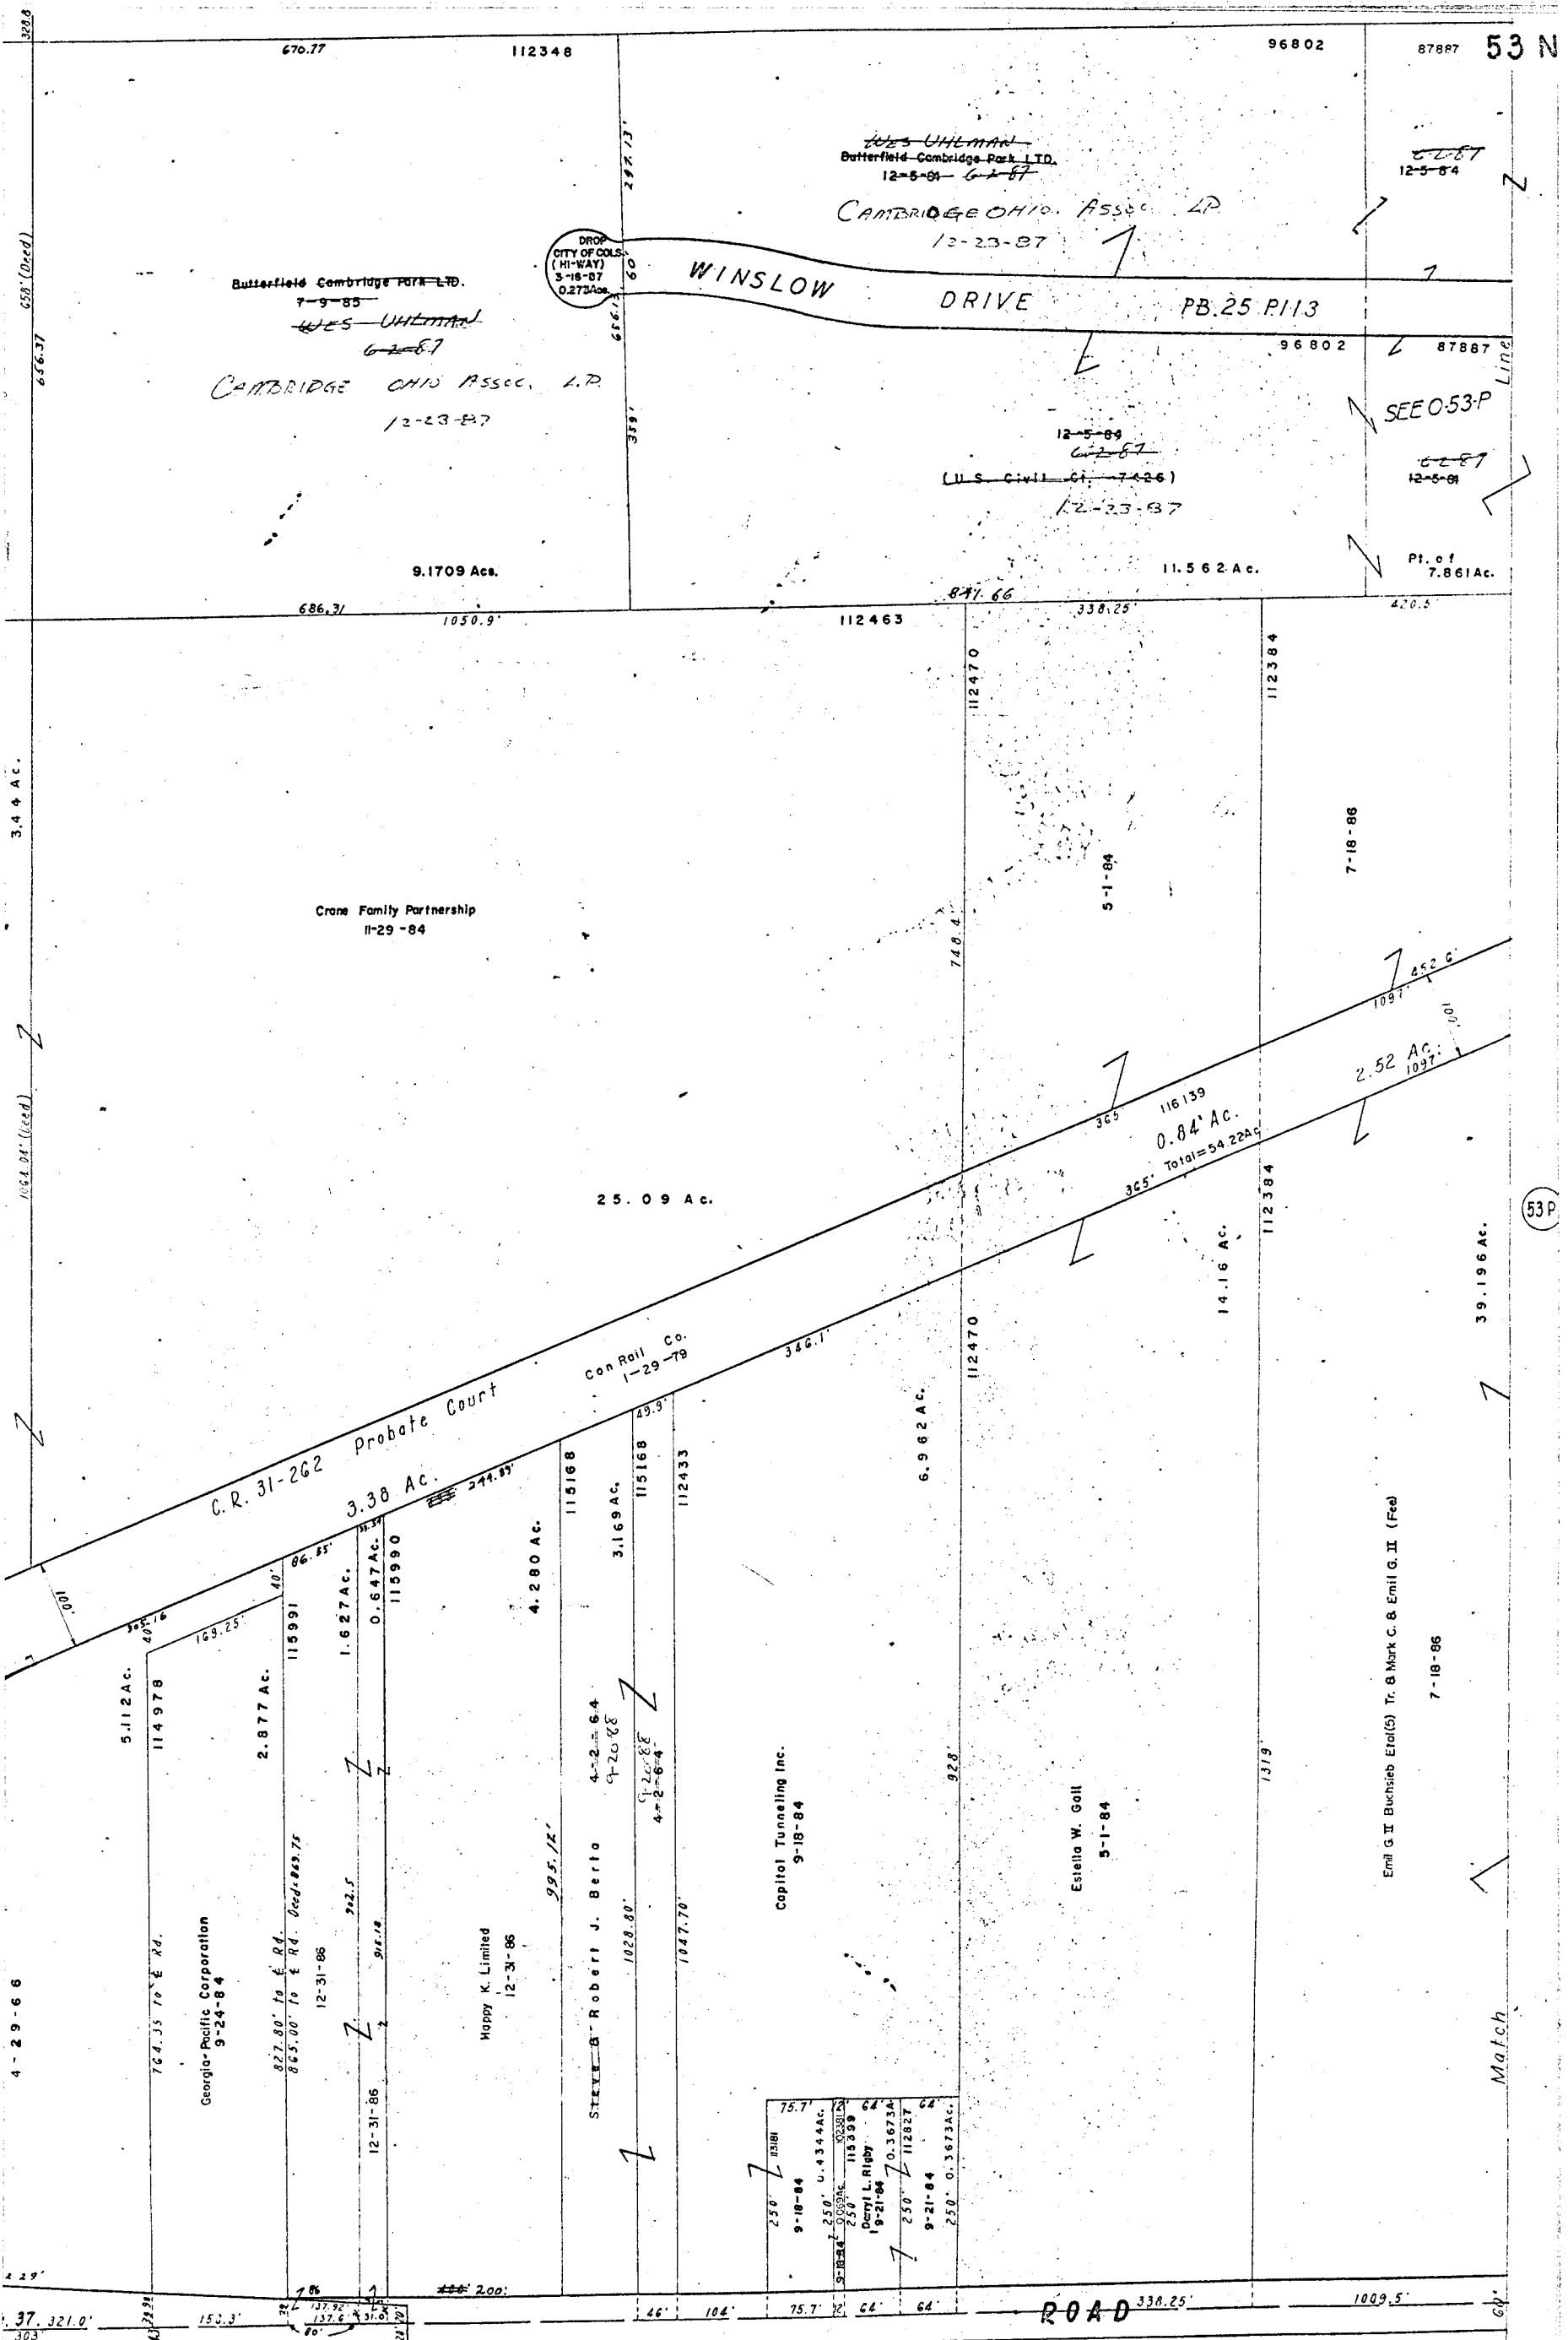

Plans of N. & W. R.R. - Refugee Rd.
 in County Engineers Office
 Dublin Road.

MARION TWP.
 R-22 TWP-5

SCALE 1"=100'

E-HIGHWAY EASEMENT
 TAXING DISTRICT CODE
 COLUMBUS OHIO
 H-HOUSE NUMBERS

0-531
 4/8/87 766

4