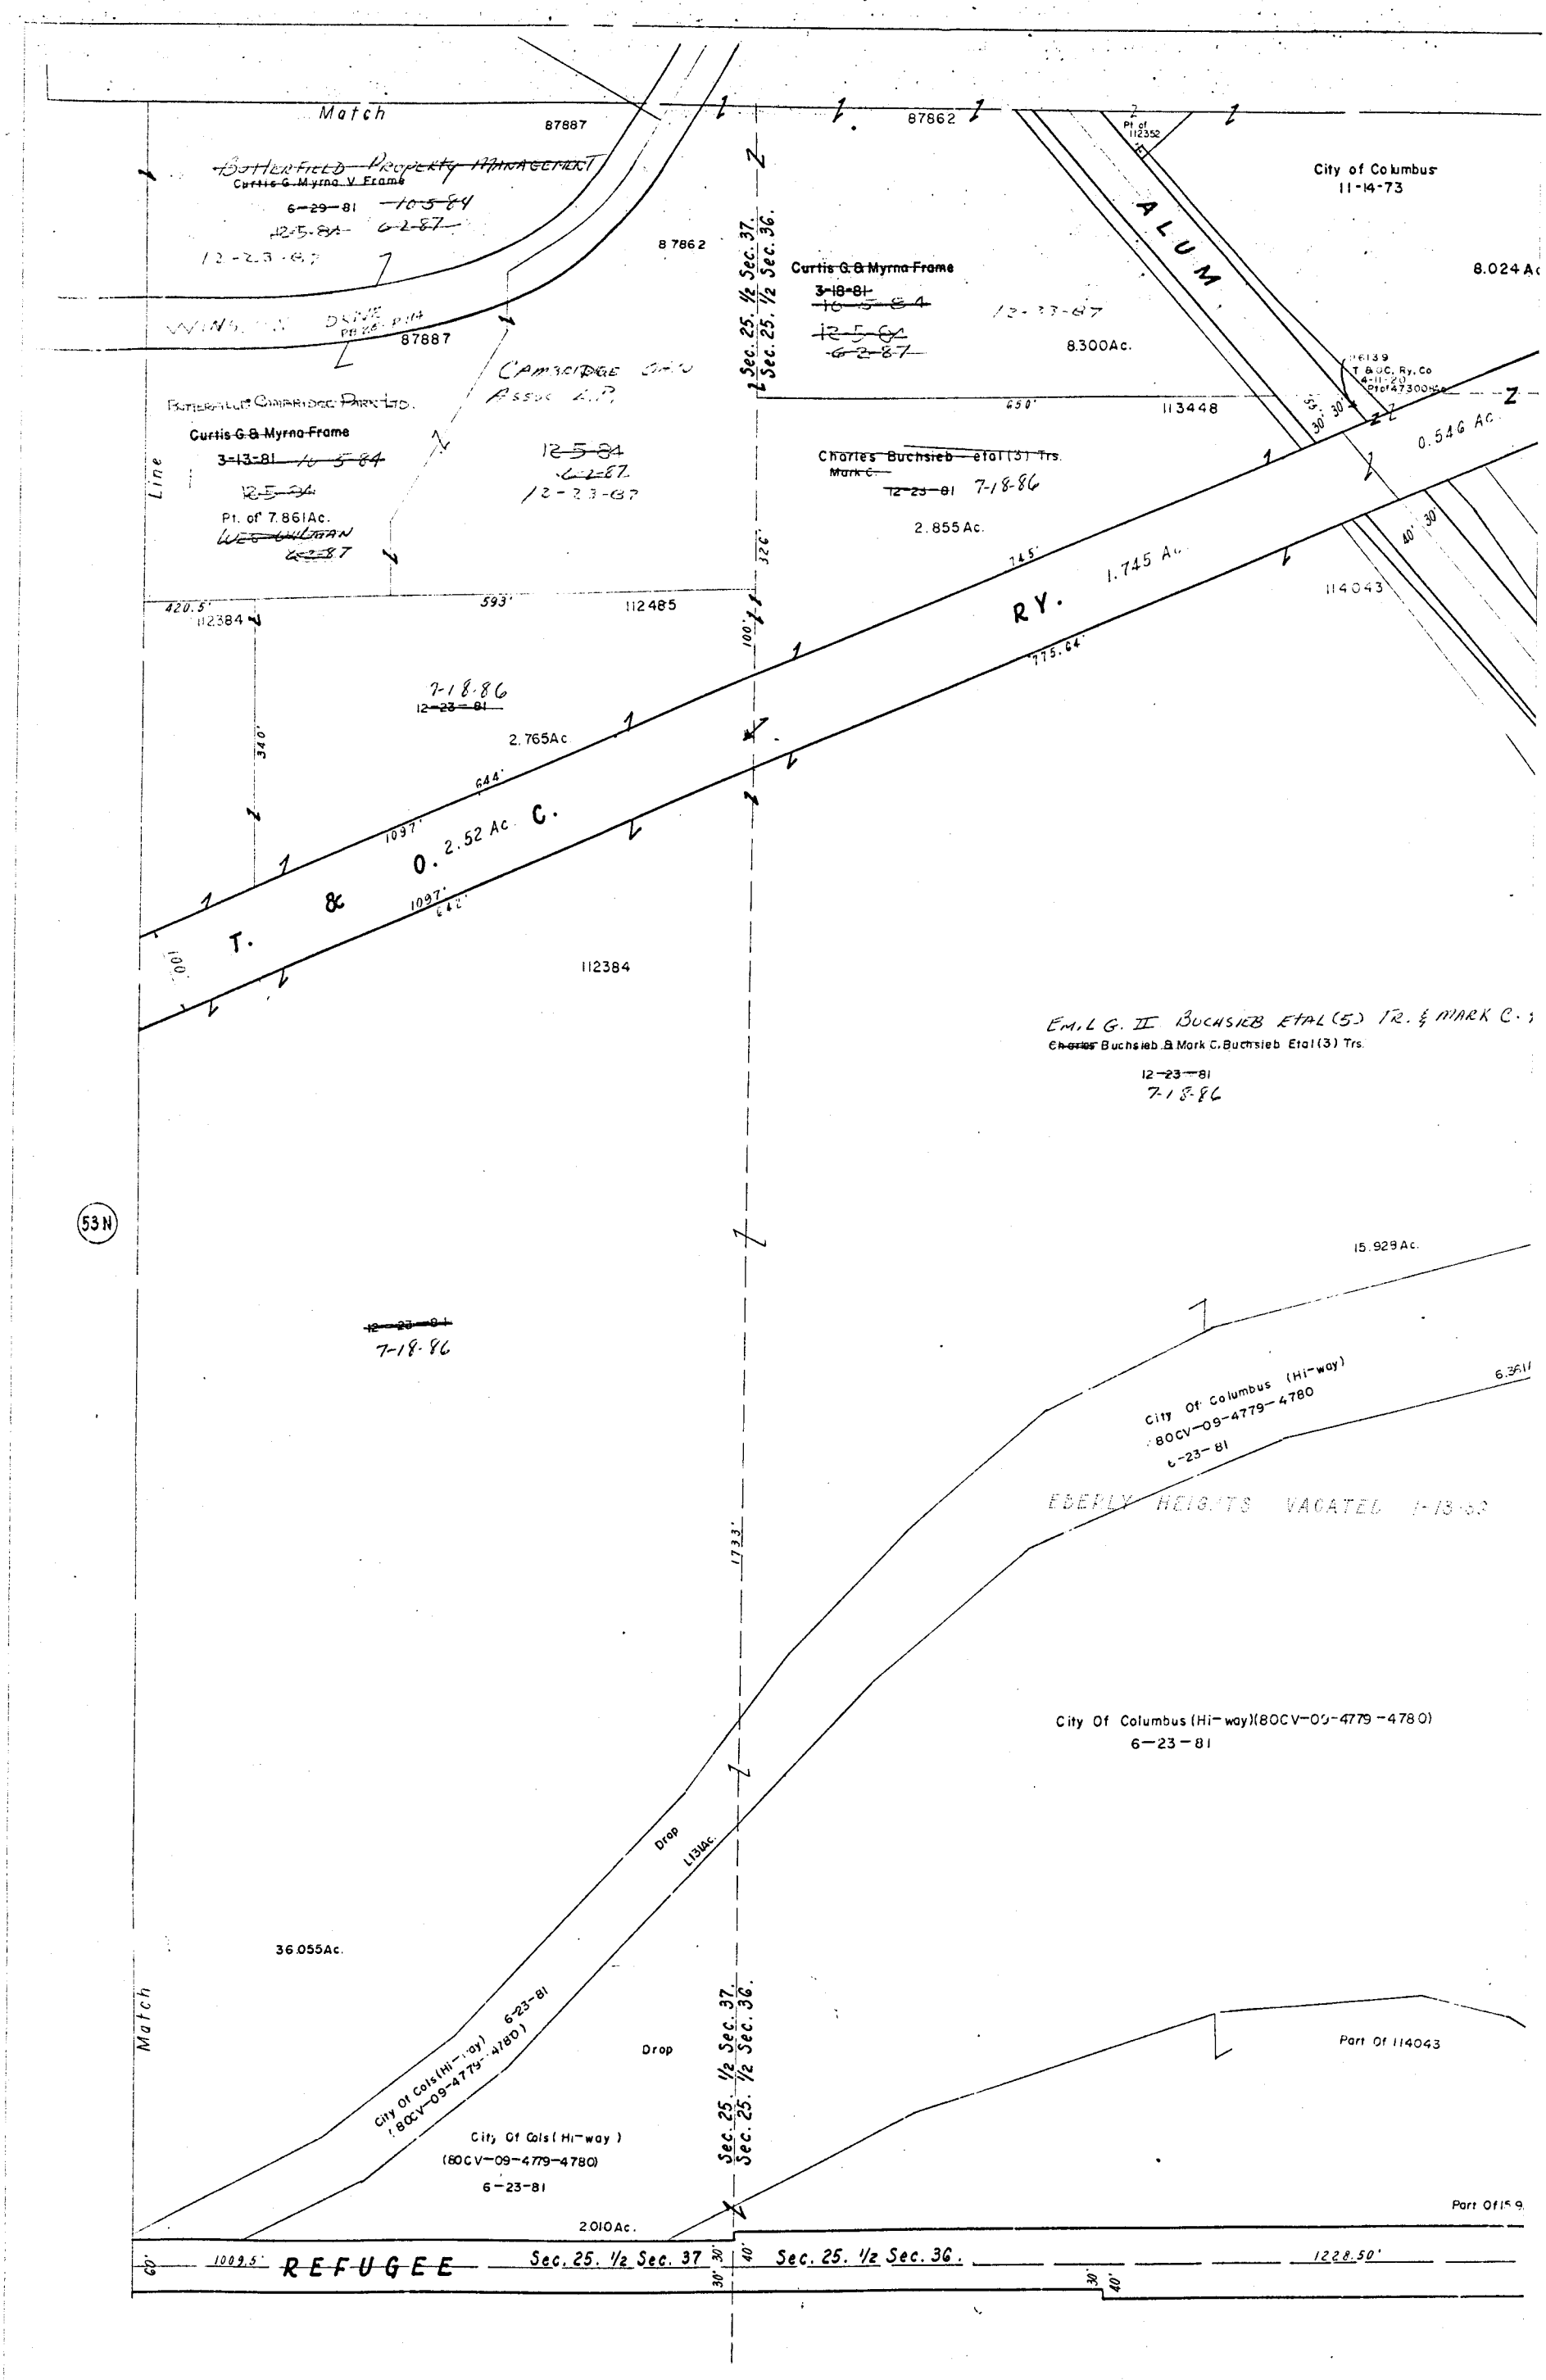
Match
87887
87862
Pt of 112352
City of Columbus
11-14-73
~~Butherfield Property Management~~
~~Curtis G. Myrna V. Frame~~
~~6-29-81~~ ~~10-5-84~~
~~12-5-84~~ ~~6-2-87~~
12-23-87
8 7862
Sec. 25. 1/2 Sec. 37.
Sec. 25. 1/2 Sec. 36.
~~Curtis G. & Myrna Frame~~
~~3-18-81~~
~~10-5-84~~
~~12-5-84~~
~~6-2-87~~
12-23-87
8.024 Ac
ALUM
8.300Ac.
WINDSOR DRIVE
PB 28. P.14
87887
CAMBRIDGE CO-O ASSOC. L.P.
~~Butherfield Cambridge Park Ltd.~~
~~Curtis G. & Myrna Frame~~
~~3-13-81~~ ~~10-5-84~~
~~12-5-84~~
Pt. of 7.861Ac.
~~WED WILTAN~~
~~6-2-87~~
12-5-84
6-2-87
12-23-87
650'
113448
Z
0.546 Ac.
~~Charles Buchsieb etal (3) Trs.~~
~~Mark C.~~
~~12-23-81~~ 7-18-86
2.855 Ac.
326'
745'
RY.
1.745 Ac.
114043
420.5'
112384
593'
112485
100'
775.64'
7-18-86
~~12-23-81~~
2.765Ac.
340'
644'
1097'
T. & O. C.
2.52 Ac.
1097'
642'
100'
112384
EMIL G. II BUCHSIEB ETAL (5) TR. & MARK C.
~~Charles~~ Buchsieb & Mark C. Buchsieb Etal (3) Trs.
~~12-23-81~~
7-18-86
53N
15.929 Ac.
~~12-23-81~~
7-18-86
City Of Columbus (Hi-way)
80CV-09-4779-4780
6-23-81
6.361
EDERLY HEIGHTS VACATED
1733'
City Of Columbus (Hi-way)(80CV-09-4779-4780)
6-23-81
Drop
1.131Ac.
36.055Ac.
Match
City Of Cols (Hi-way) 6-23-81
(80CV-09-4779-4780)
Drop
Sec. 25. 1/2 Sec. 37.
Sec. 25. 1/2 Sec. 36.
Part Of 114043
City Of Cols (Hi-way)
(80CV-09-4779-4780)
6-23-81
2.010Ac.
Part Of 15.9
60'
1009.5'
REFUGEE
Sec. 25. 1/2 Sec. 37
30'
40'
Sec. 25. 1/2 Sec. 36.
1228.50'
30'
40'

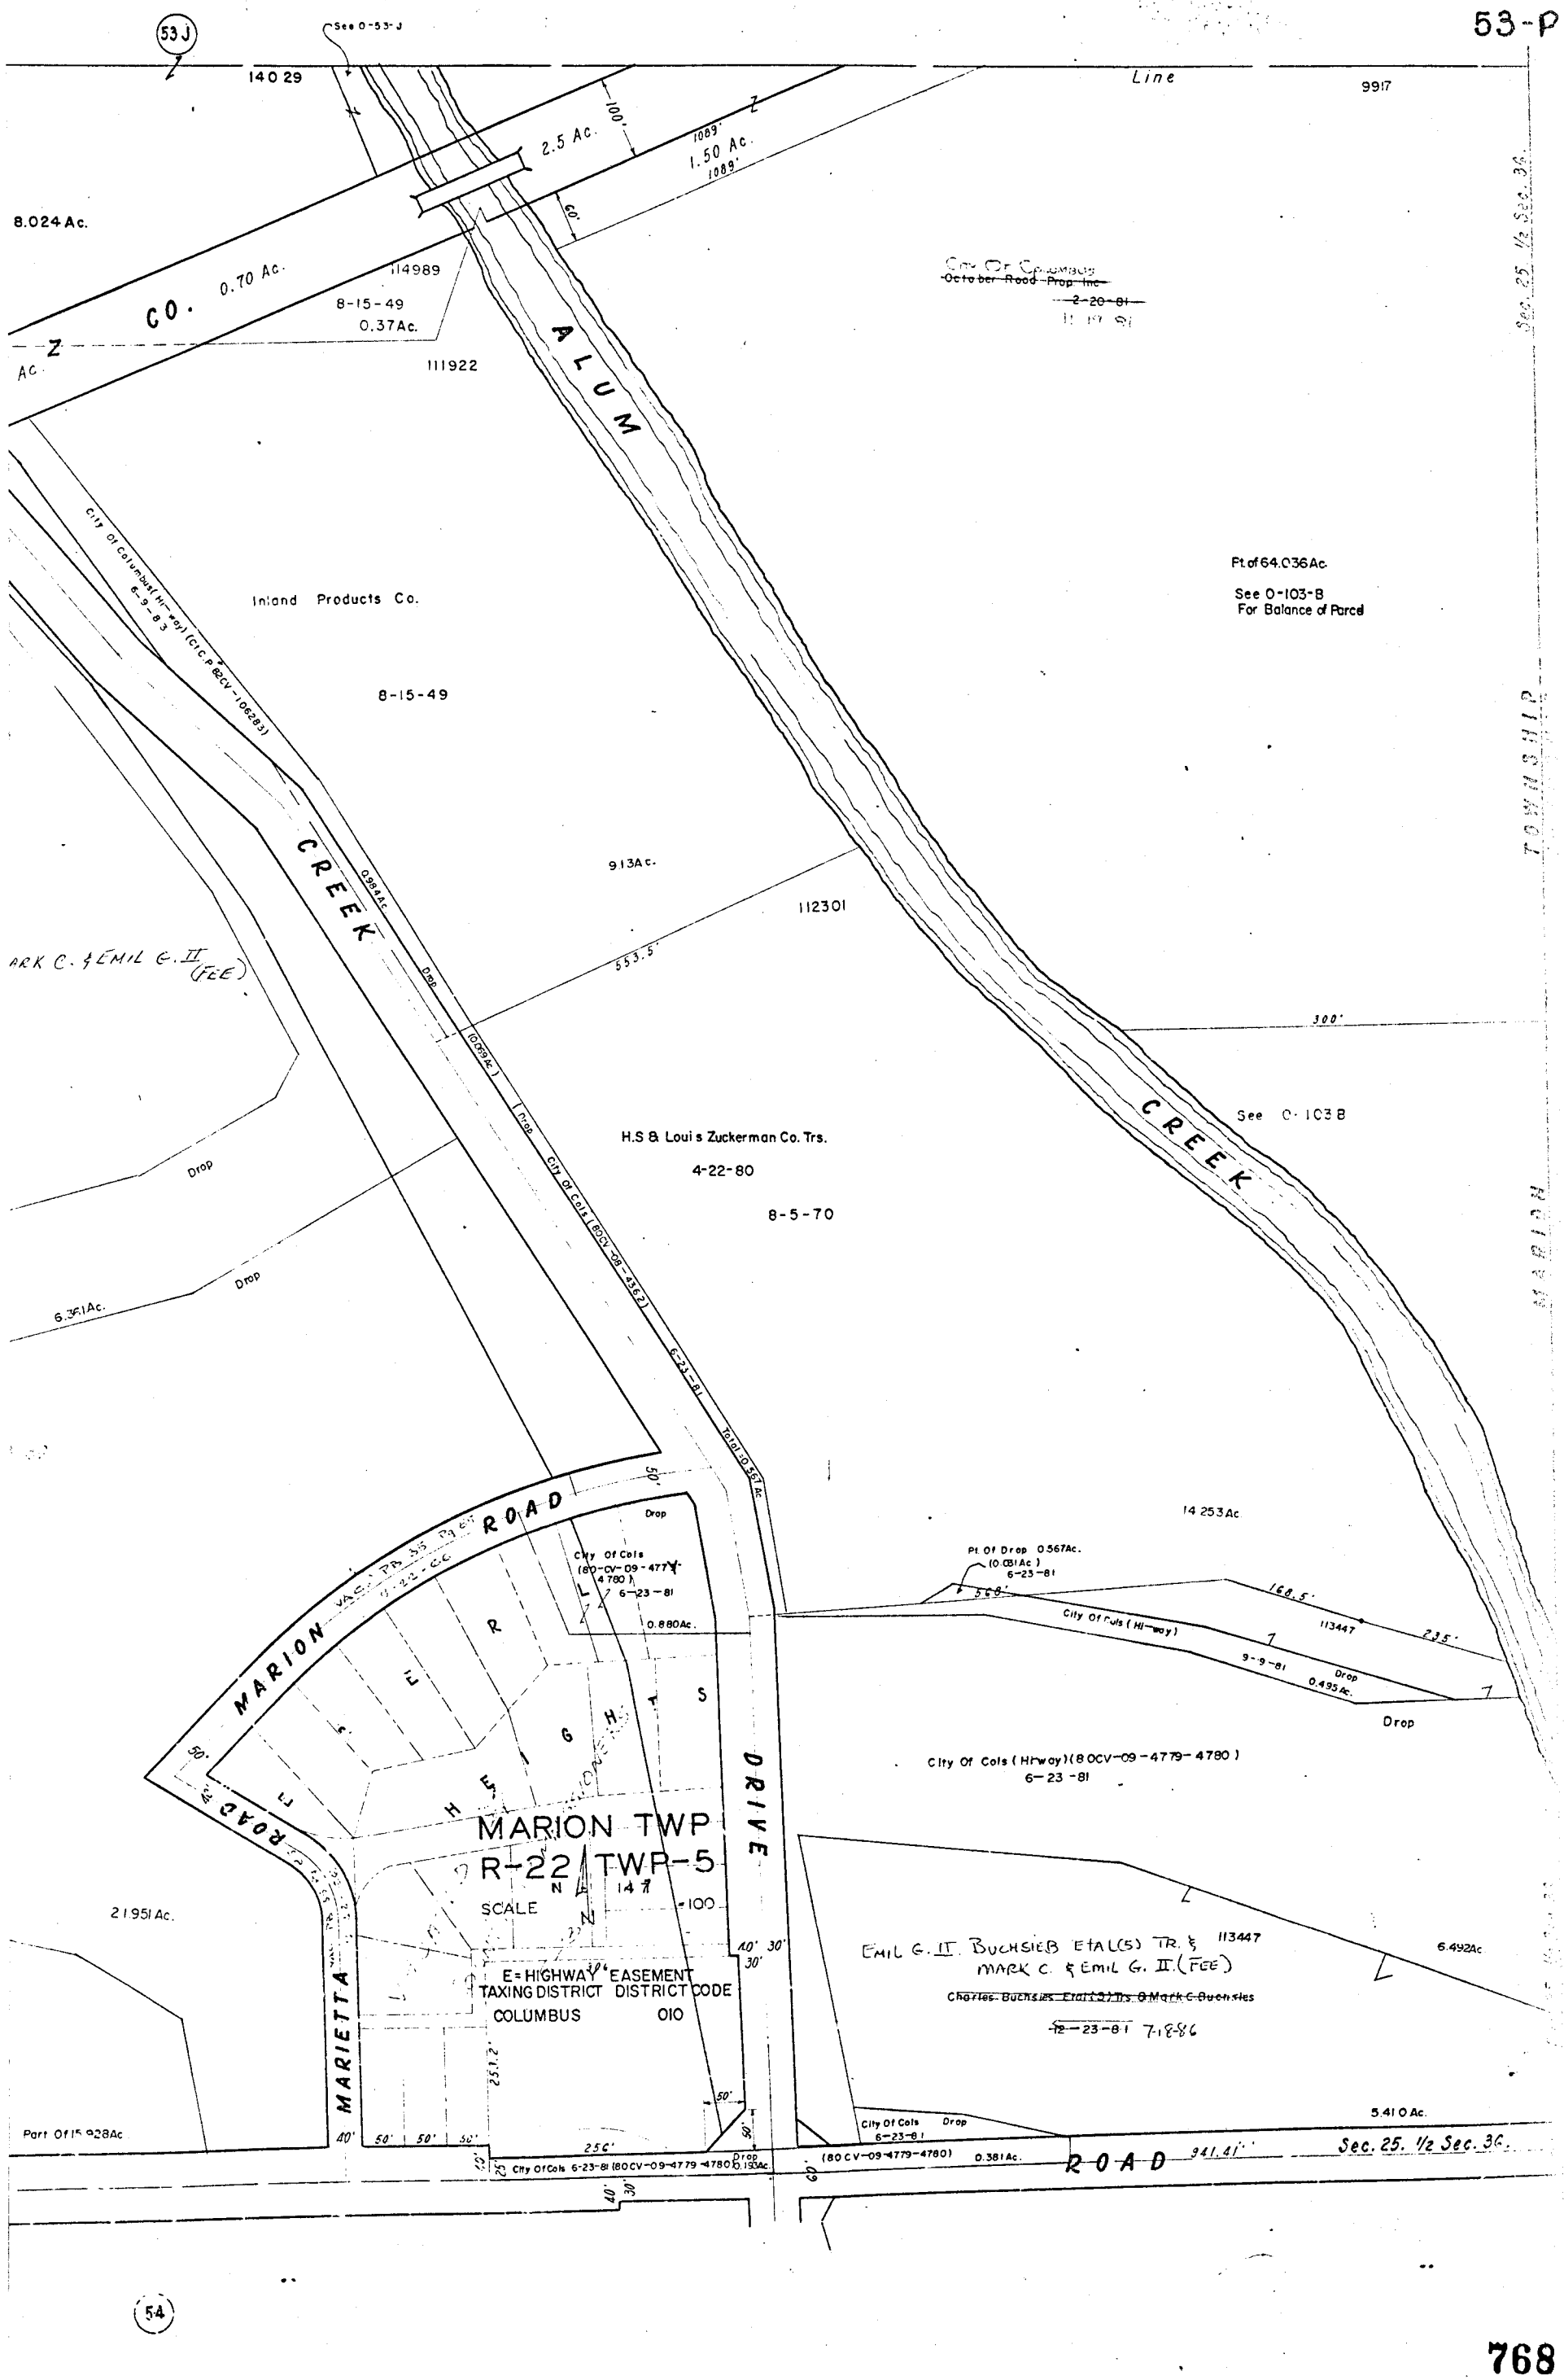
53 J
See 0-53-J
140 29
Line
9917
2.5 Ac.
100'
1089'
1.50 Ac.
1089'
60'
8.024 Ac.
0.70 Ac.
114989
8-15-49
0.37Ac.
111922
CO.
ALUM
CREEK
City Of Columbus
~~October Road Prop. Inc.~~
~~2-20-81~~
Pt of 64.036Ac.
See 0-103-B
For Balance of Parcel
City of Columbus (Hi-way) (C.C.P. 82CV-10628)
8-9-83
Inland Products Co.
8-15-49
9.13Ac.
112301
553.5'
ARK C. & EMIL G. II (FEE)
Drop
6.361Ac.
0.984Ac.
10.059Ac.
City Of Cols (80CV 09-4363)
6-23-81
Total 0.567 Ac.
300'
See 0-103 B
H.S & Louis Zuckerman Co. Trs.
4-22-80
8-5-70
MARION ROAD
50'
City Of Cols
(80-CV-09-4779
4780)
6-23-81
0.880Ac.
MARION TWP
R-22 TWP-5
SCALE 1" = 100'
E = HIGHWAY EASEMENT
TAXING DISTRICT DISTRICT CODE
COLUMBUS 010
MARIETTA ROAD
DRIVE
14.253Ac.
Pt. Of Drop 0.567Ac.
(0.081Ac.)
6-23-81
568'
168.5'
113447
235'
City Of Cols (Hi-way)
9-9-81
Drop
0.495Ac.
City Of Cols (Hi-way) (80CV-09-4779-4780)
6-23-81
21.951Ac.
EMIL G. II. BUCHSIEB ETAL(5) TR. & MARK C. & EMIL G. II. (FEE)
113447
~~Charles Buchsieb Etal(5) Trs. & Mark C. Buchsieb~~
~~12-23-81~~ 7-18-86
6.492Ac.
5.410 Ac.
Part Of 15.928Ac.
City Of Cols 6-23-81 (80CV-09-4779-4780)
0.193Ac.
(80CV-09-4779-4780)
0.381Ac.
941.41'
Sec. 25. 1/2 Sec. 36.
TOWNSHIP
MARION
54