

0  
55  
A

American Aggregates Corp.  
5-29-41

5-29-41

American Aggregates Corp.  
5-29-41

Total = 155.140 Ac.

COMPLETE RECORD 238-3  
5-29-41

State of Ohio  
6-9-71

19.23 Ac.

FRANK

5

American Aggregates Corp.  
12-10-37

P. B. 2-43

112294

12-10-37

RECORDER'S OFFICE

12-10-37

12-10-37

American Aggregates Corp.  
12-10-37

SCIOTO RIVER

112294

12-10-37

12-10-37

112254

12-10-37

Total = 282.4118 Ac.


0  
21  
C

0  
55  
D


0  
55  
A

0-55-B

MARION TWP.  
R.22 TWP.4

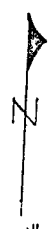

SCALE 1" = 200'  
TAXING DISTRICT DISTRICT CODE  
COLUMBUS OIO  
E=HIGHWAY EASEMENT

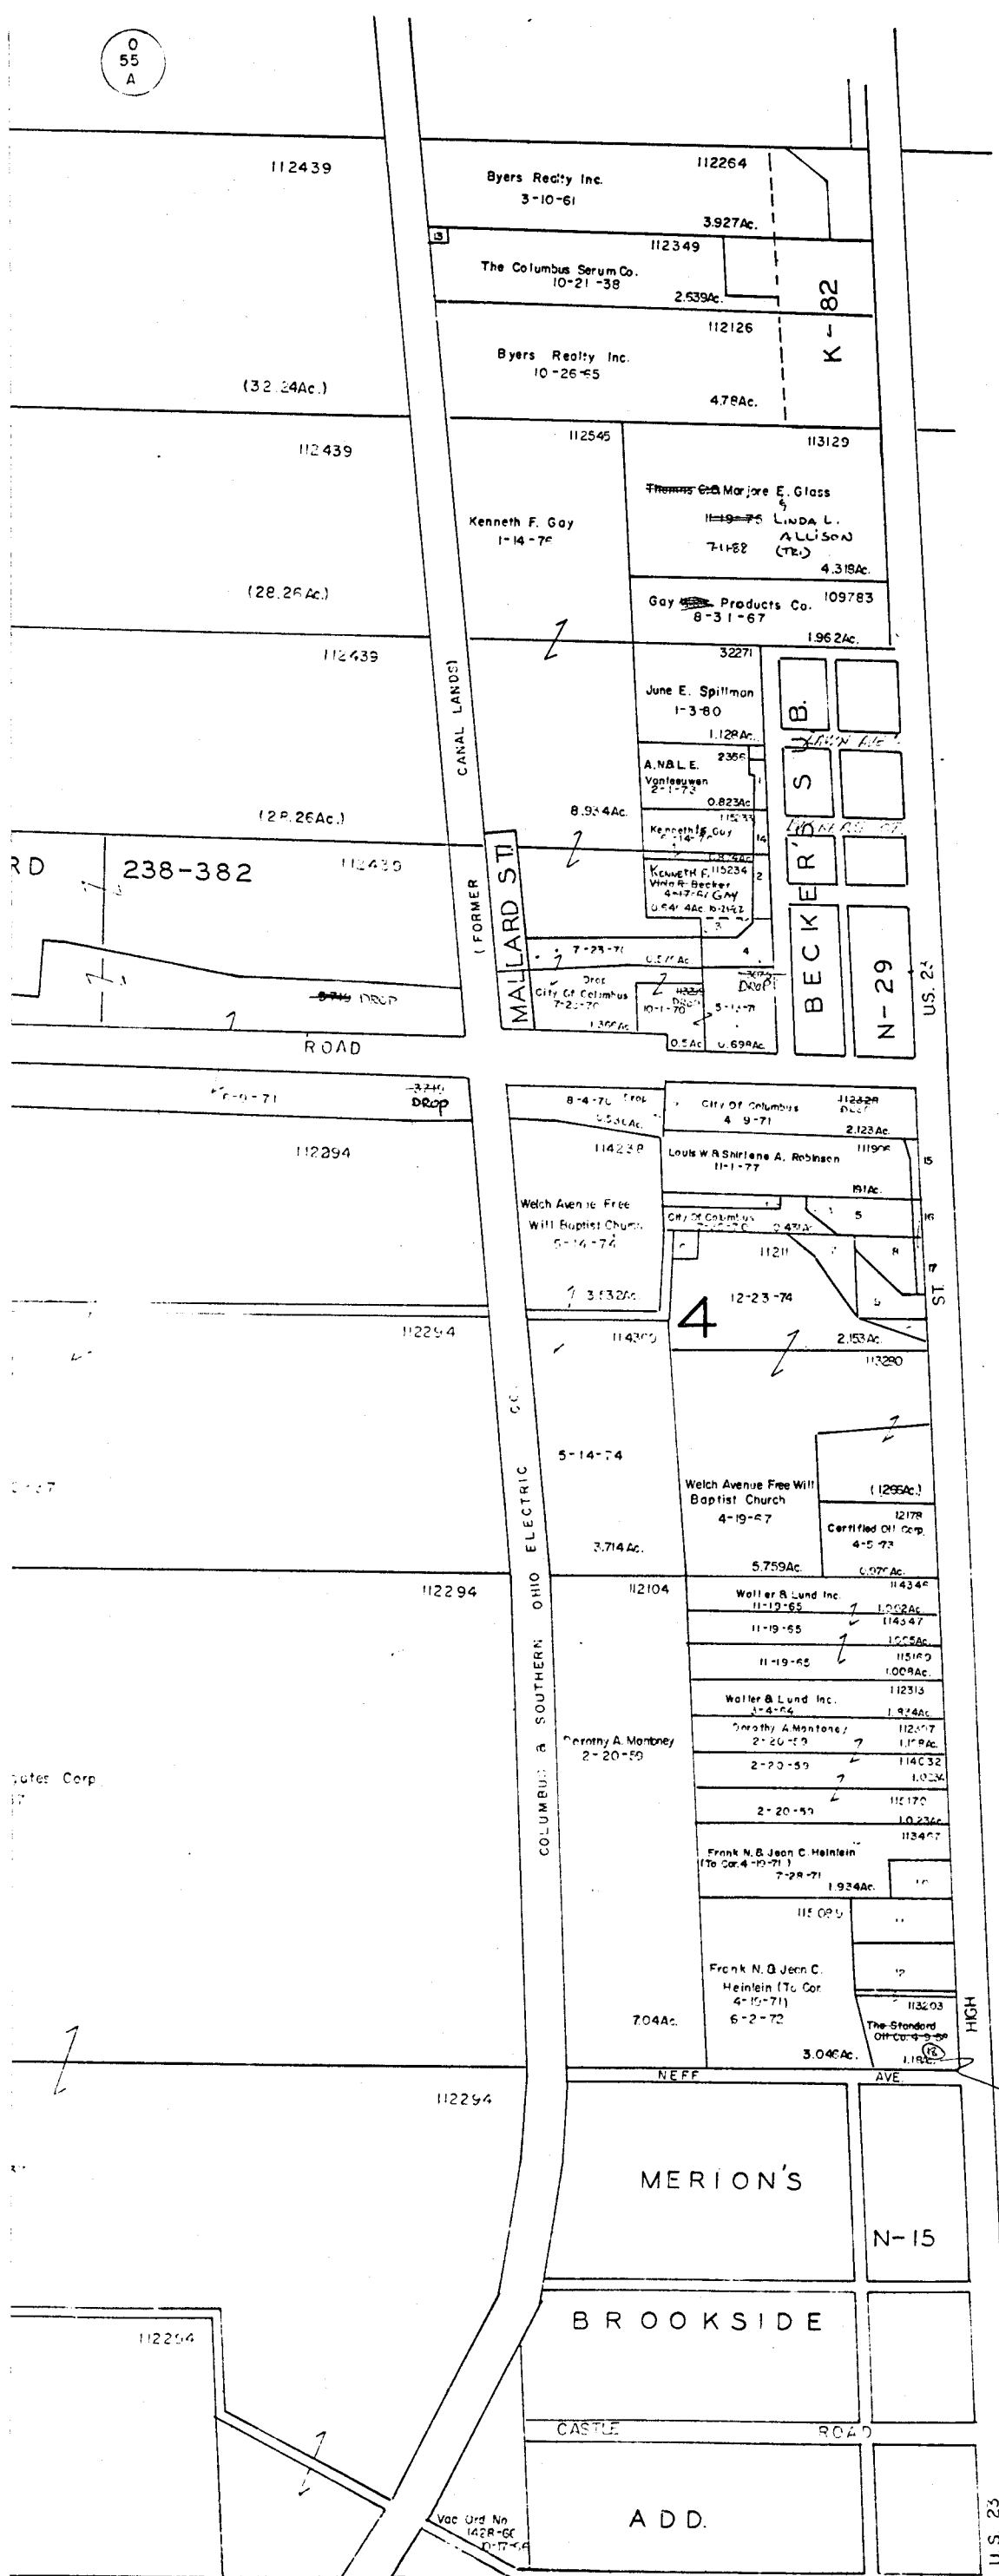

C  
C  
C

- 1 - Drop City of Columbus 3-10-61 0.4771
- 2 - Drop " 10-21-38 1.171Ac
- 3 - Drop " 10-26-65 1.001Ac
- 4 - Drop " 1-3-80 0.271Ac
- 5 - 11229 Louis W. Shirlene A. Robinson 12-14-71 0.544Ac
- 6 - 11719 Columbia Gas of Ohio Inc. 7-13-67 0.057Ac
- 7 - Drop City of Columbus City of Columbus 3-27-72 0.247Ac
- 8 - 41518 M. Cleveland Resin 1-18-77 0.270Ac
- 9 - Drop City of Columbus City of Columbus 6-29-73 0.309Ac
- 10 - 113627 F.N.J.C. Heinlein 3-2-71 0.312Ac
- 11 - 8470E " " " " 0.607Ac
- 12 - 112425 " " " " 3-27-71 0.444Ac
- 13 - 103973 BUCKEYE INTERNATIONAL INC. 1-7-67 40.25 (SEE C-55-B)
- 14 - Drop City of Columbus 6-24-70 0.110Ac
- 15 - Drop " " " " 9-25-76 0.059Ac
- 16 - Drop " " " " 7-30-70 0.110Ac
- 17 - Drop " " " " 6-23-73 0.177Ac
- 18 - 113203 Roy C. & Mary P. Bowling 7-23-73 1.181Ac

0-55-B

796

55  
D