


0
55
B

4

0
55
B

0
55
D

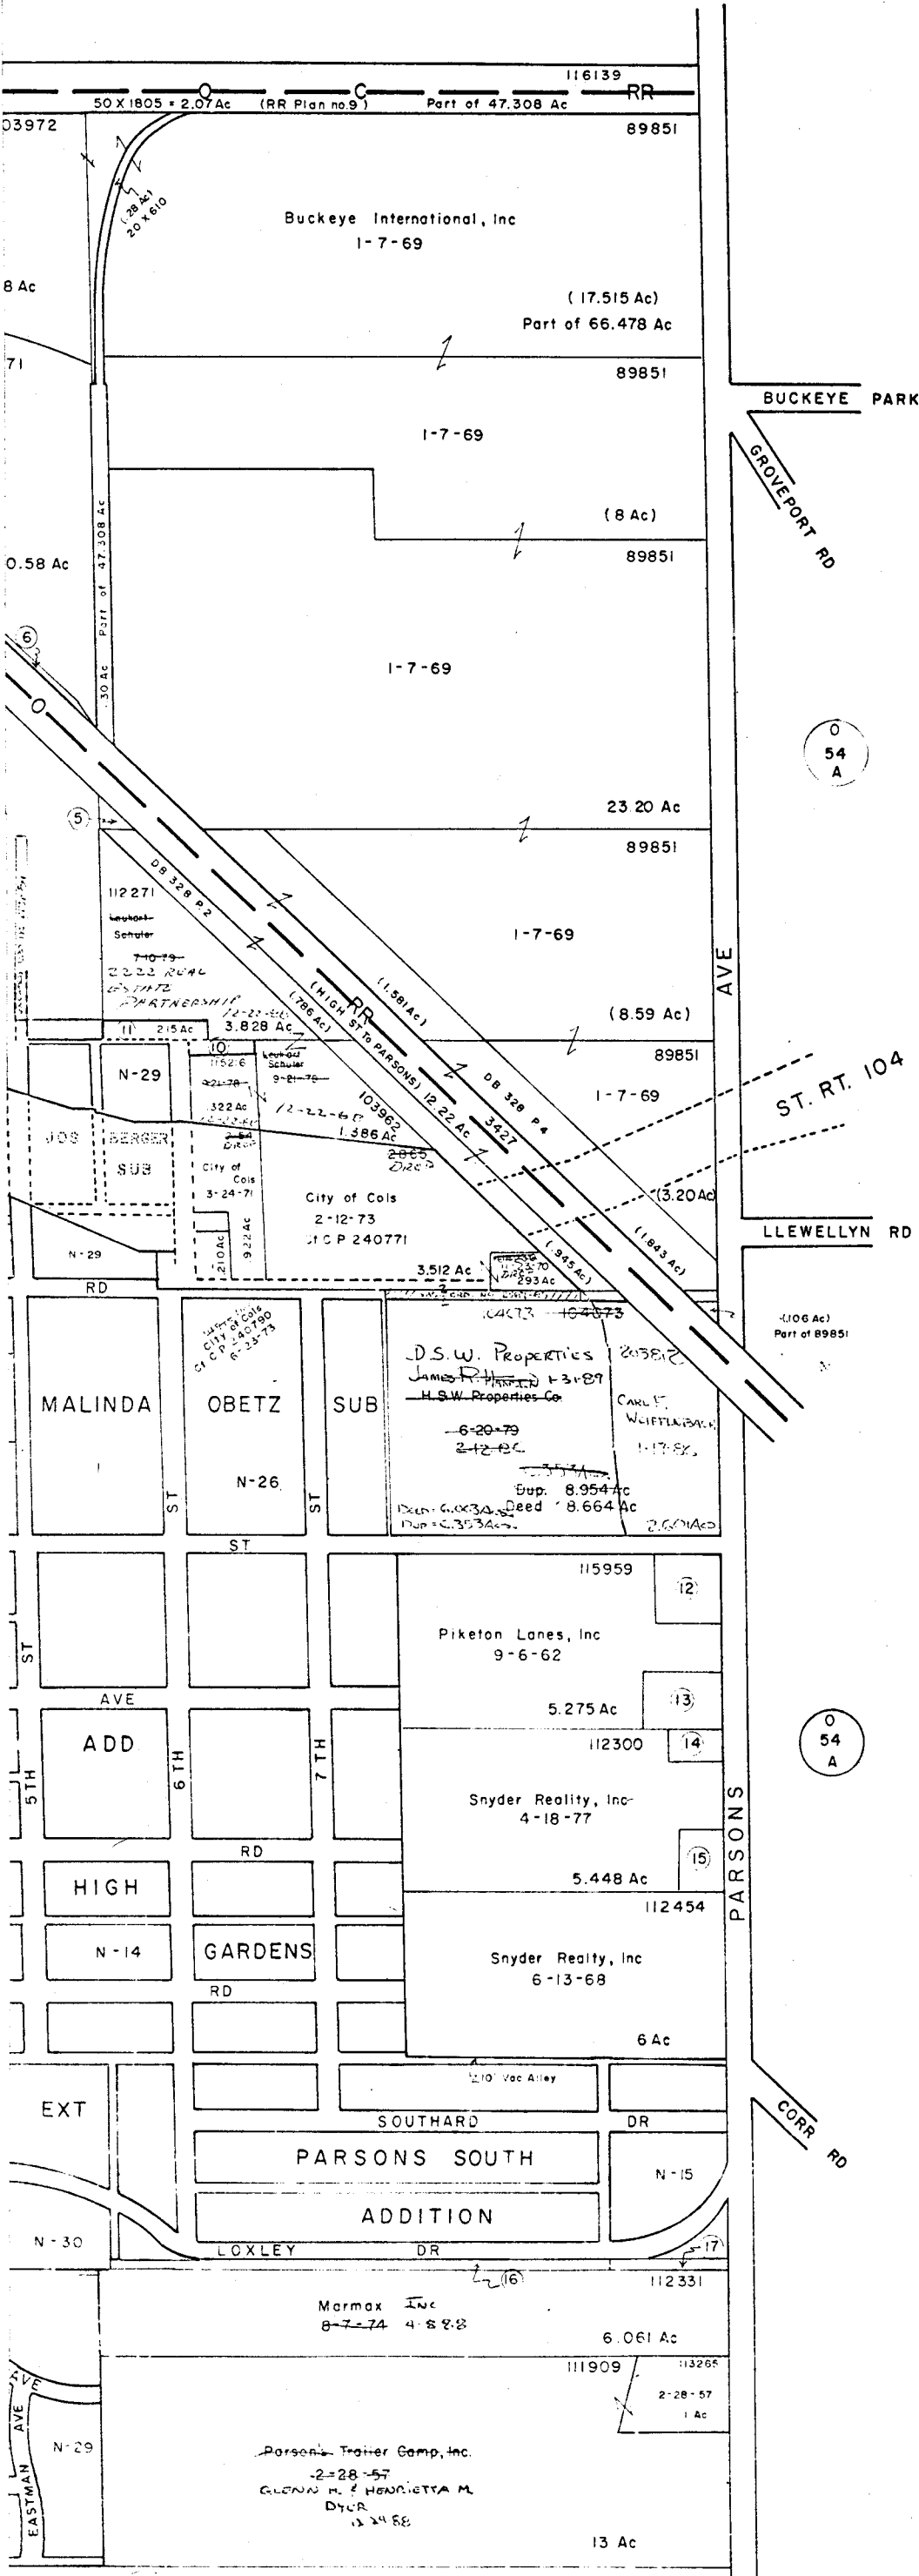

O-55-C
 MARION TWP.
 R.22 TWP.

SCALE 1" = 200'
 E-HIGHWAY EASEMENT
 TAXING DISTRICT CODE
 COLUMBUS 010

Parcel	Name	Date	Ac
① 104088	Bar Properties Weldon Incorporated	3-9-71	116.5 X 82.8 X 83.2
② 104098	" "	3-9-71	.109
③ 2039	" "	3-22-71	.098
④ 104083	" "	3-9-71	.35
⑤ Pt. of 3427	C & O RR	12-21-50	(.038)
⑥ Pt. of 3427	C & O RR	12-21-50	(.152)
⑦ 9026 DROP	City of Cols Ct C P 241239	6-19-73	.391
⑧ 9030 DROP	" "	6-19-73	.319
⑨ 11519	Rita M Watkins	3-14-77	.226
⑩ 2149 DROP	City of Columbus	3-24-71	.117
⑪ Drop	" Ct C P 240789	2-3-76	.215
⑫ 116005	Certified Oil Corp	1-5-73	.568
⑬ 112291	William Boccia	1-20-89	.555
⑭ 112161	M Crabtree	3-12-42	.258
⑮ 114028	Marmax	10-10-78	.387
⑯ 116128	Cols A So Ohio Electric Co	6-14-37	.374
⑰ 1563 W.D.H.	D-B-F Inc BALLENGER	12-30-71	.10
⑱ 102 DROP	City of Cols Ct C P 242086	12-13-71	.195
⑲ 86 DROP	" "	12-13-71	.062
⑳ 104232	R-A-Watch JET CONTAINER CO	3-22-71	.0413
㉑ 104059	Peter Fornoff & Sons Co	12-5-74	.087AC
㉒ 20925	" " " " " "	4-14-78	.0569Ac
㉓ DROP CITY OF COLUMBUS (Highway)	9-4-81	0.1134ac.	

O-55-C
 798