


0
56
E

- ① 147153 Jack E. & Mary A. Harris 3-9-78 0.752 Ac.
- ② DRDP City of Columbus 12-17-75 1.669 Ac.
- ③ 146668 Isiah B.D.J. Gilbert 12-18-75 0.564 Ac.
- ④ 149717 The House of God, Whisps the Church of the Living God, the Pillar and Ground of the Truth and without Controversy 7-15-76 1.668 Ac.
- ⑤ 147139 2-1-77 0.682 Ac.
- ⑥ 195143 DuWayne E. Hobson 2-5-85 0.459 Ac.
- ⑦ 198876 Willie B. Earle Cape 5-31-83 0.396 Ac.
- ⑧ 200908 Charles L. Spiller 1-16-85 0.570 Ac.
- ⑨ 201137 Maxford Construction Corp. 8-28-85 0.334 Ac. *James D. C.S. Page 102888*
- ⑩ 201600 Moses E. & Katherine Butler 3-17-87 0.474 Ac.
- ⑪ 202576 William E. & Margaret Nowlin 5-28-87 0.439 Ac.


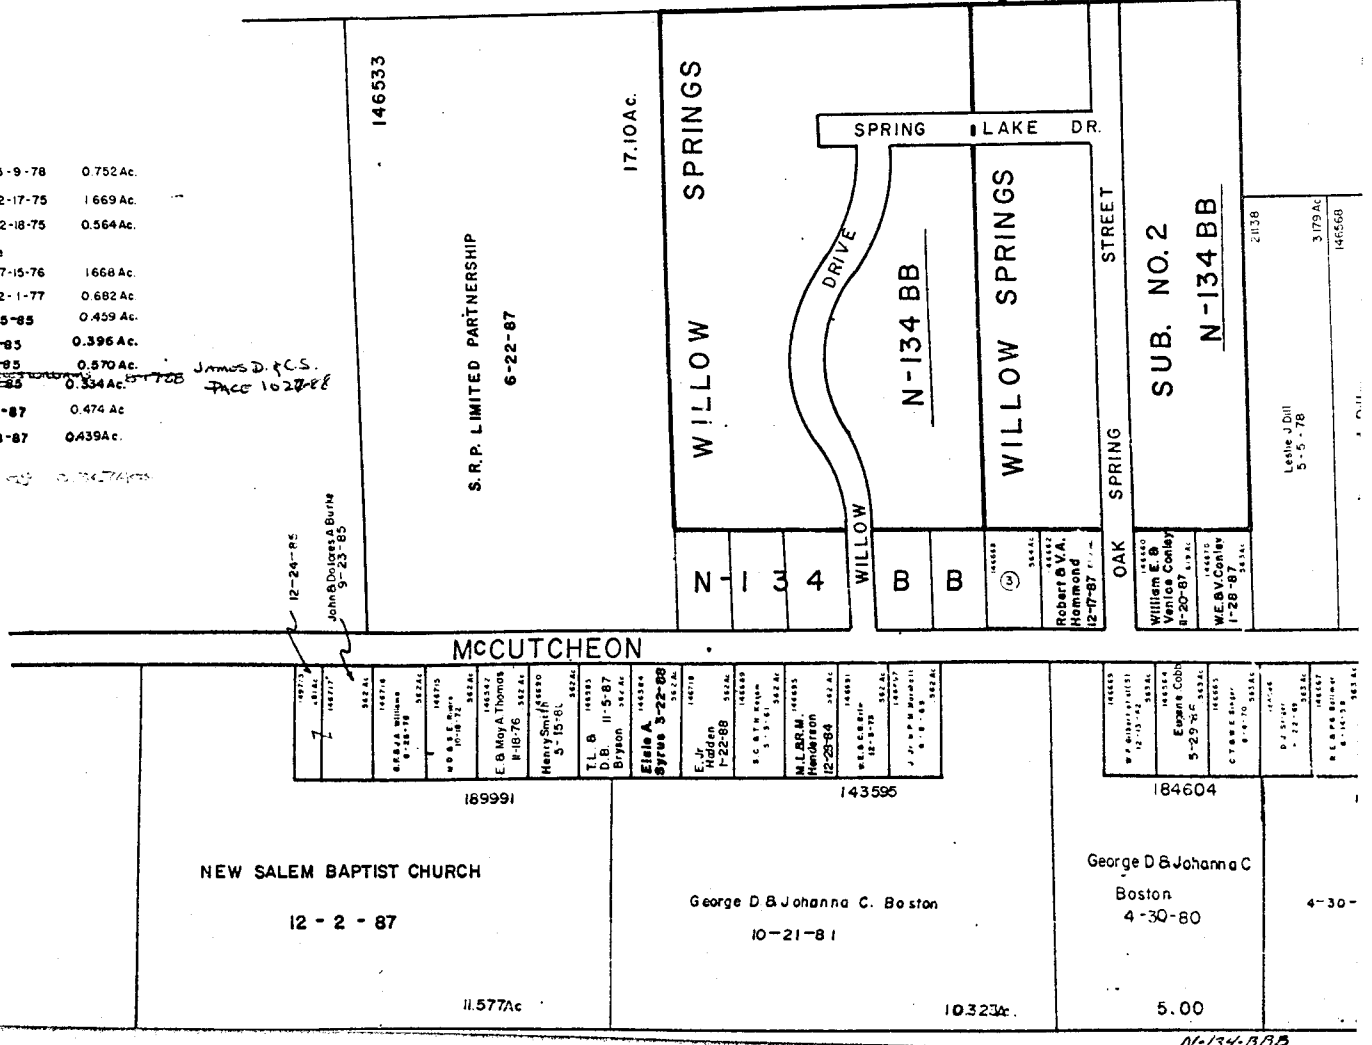


N-134-BBB

O-56-F
MIFFLIN TWP.
R17 TWRI

056
C

TAXING DISTRICTS DISTRICT CODE
COLUMBUS 010
COLS - GAHANNA JEFF SD. 520
H---HOUSE NUMBERS

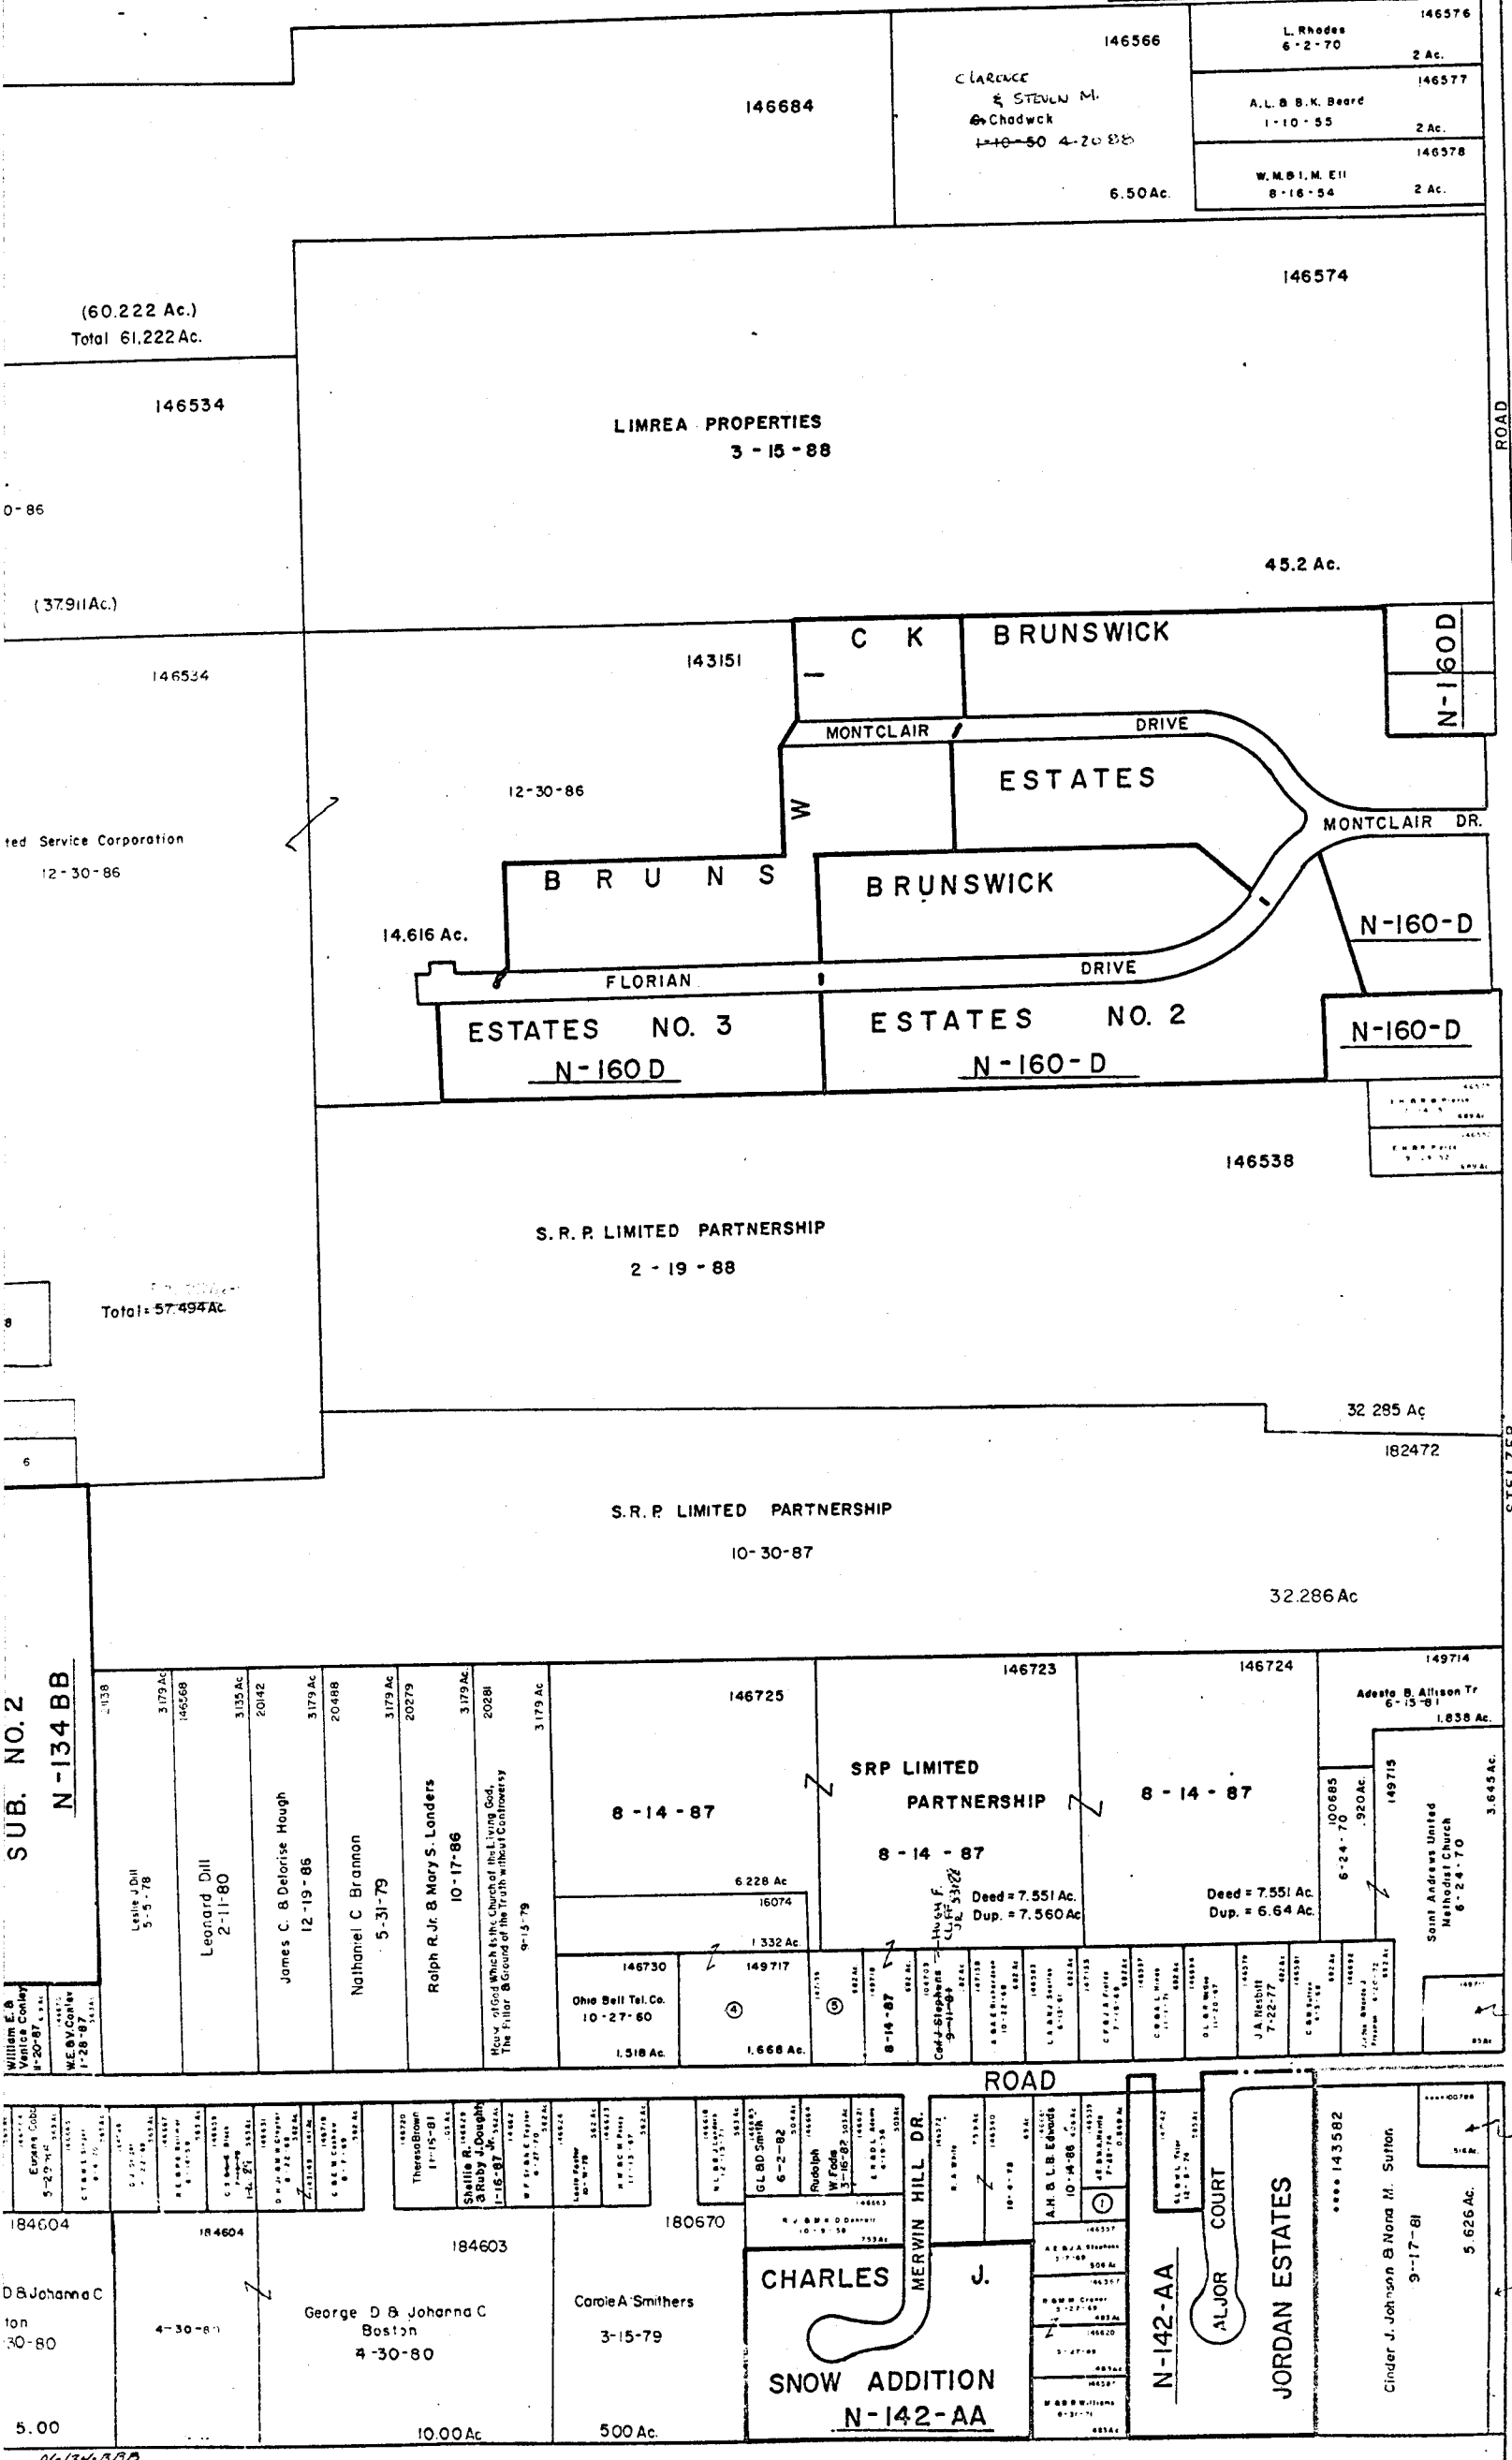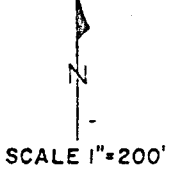

SUB. NO. 2
N-134 BB

184604
D.B. Johanna C
ton
30-80
5.00

184604
George D & Johanna C
Boston
4-30-80
10.00Ac

184603
Carole A Smithers
3-15-79
5.00Ac

180670
CHARLES J.
SNOW ADDITION
N-142-AA

MERWIN HILL DR.

ALJOR COURT
JORDAN ESTATES

Cinder J. Johnson & Norma M. Sutfon
9-17-81
5.626 Ac.

Wayne E Parker
6-2-83
City of Columbus
5-27-68
.858 Ac.

057
D

814
O-56-