

T W P


PLAIN TWP

0-57-C
MIFFIN TWP
R.17 TWPI

SCALE 1"=200'
E-HIGHWAY EASEMENT
TAXING DISTRICT DISTRICT CODE

CITY OF GAHANNA-
GAHANNA JEFF. S.D. 025

- 1-68-2 Linwood P Giddings 2-4-77 0.709 Ac.
- 2-1145 " " " 0.501
- 3-4275 Linwood R & Helen Giddings 7-2-76 0.563 Ac (In Roadway)
- 4-7075 City Of Gahanna 3-4-86 0.390 Ac.

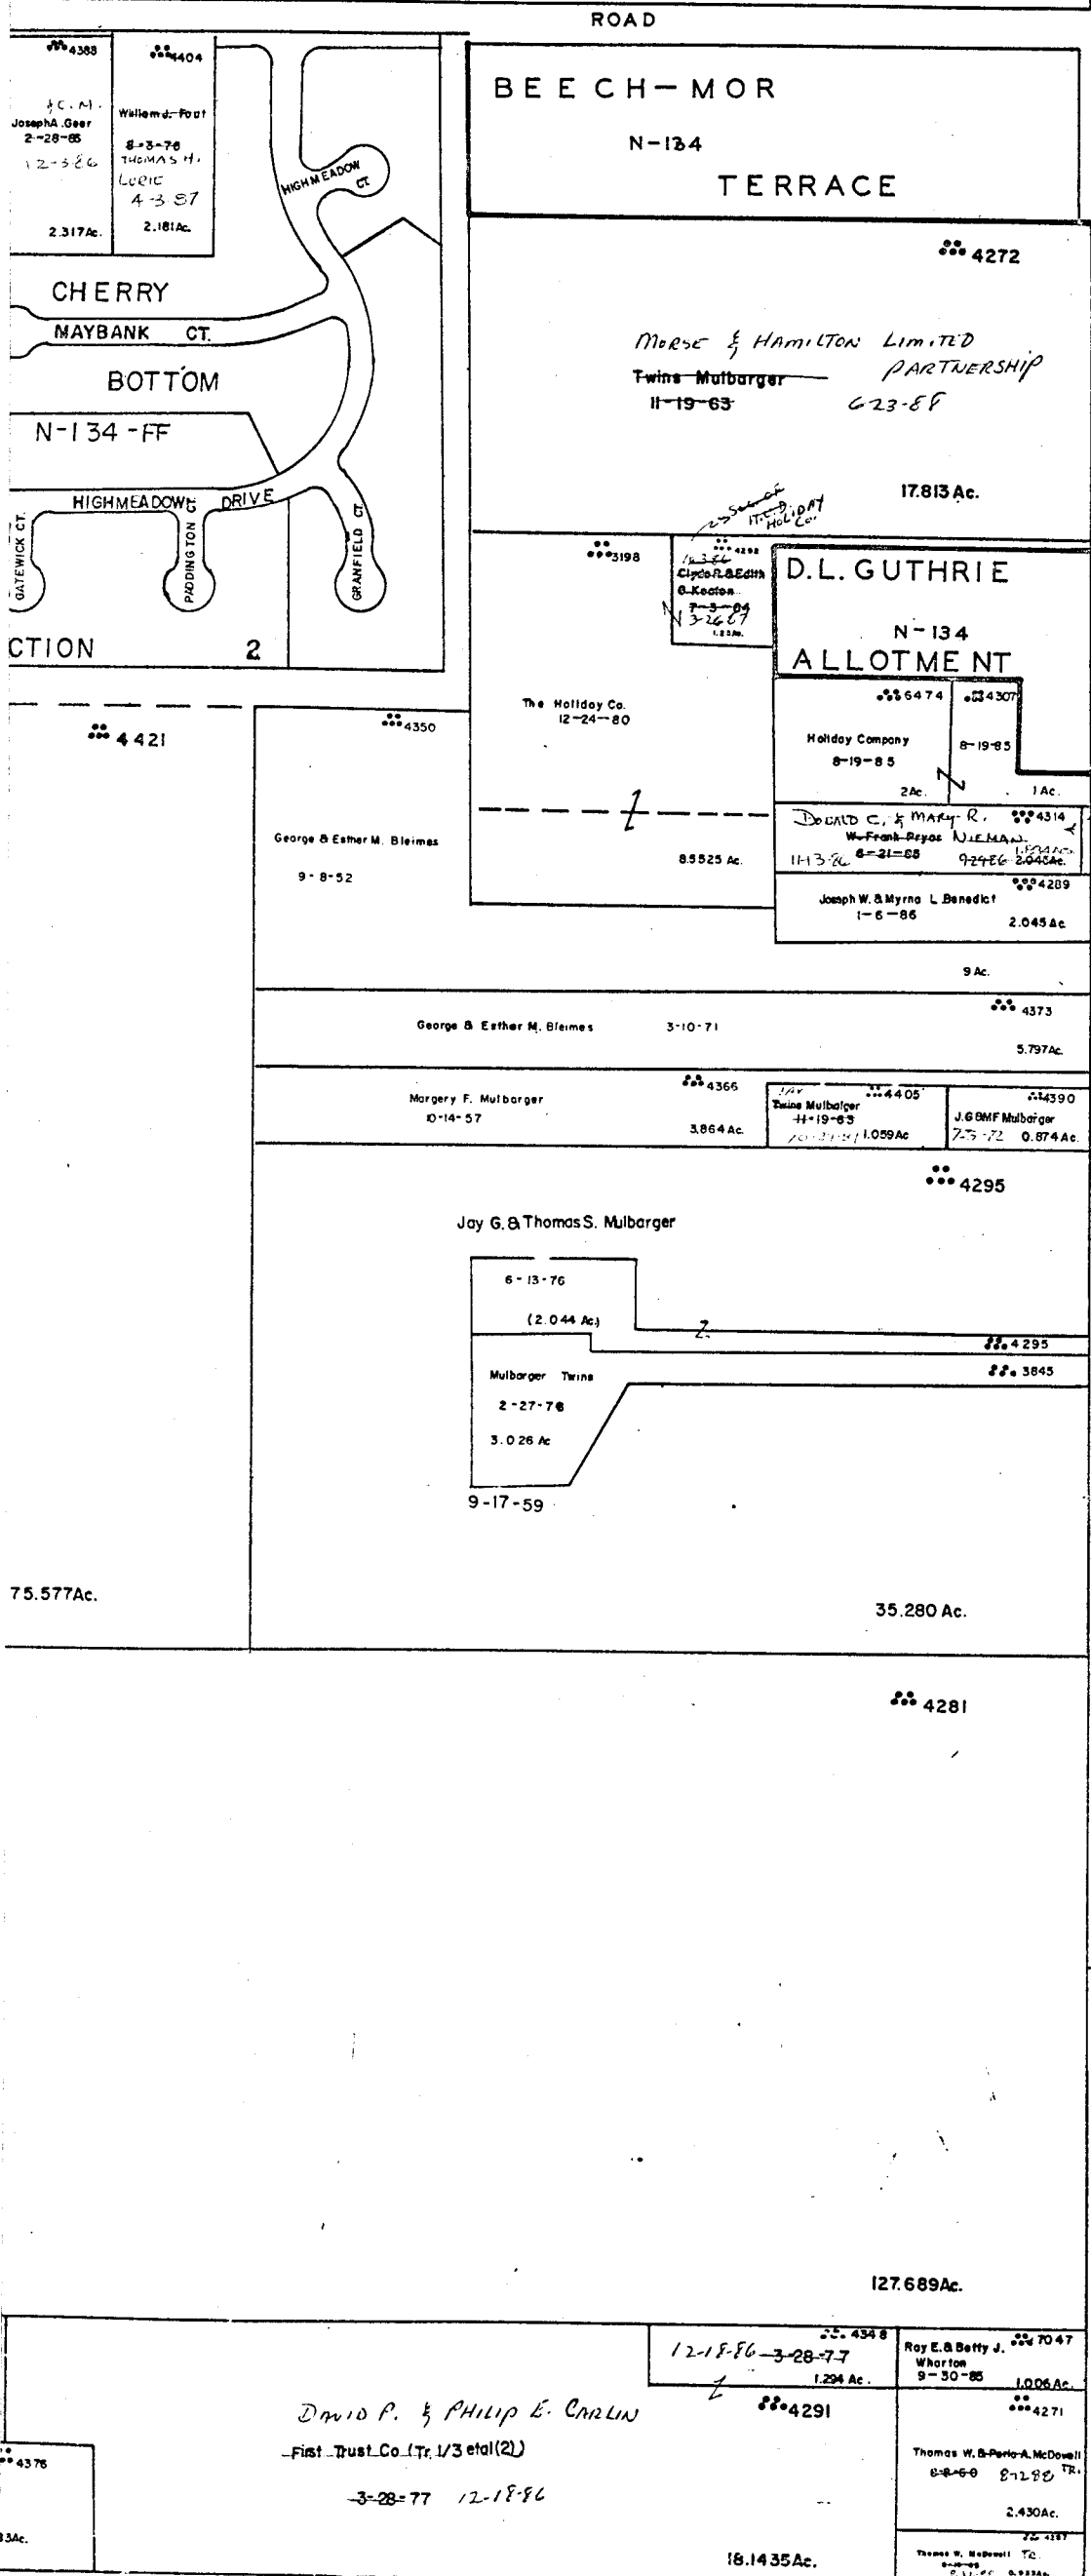

(BEECHAM) ROAD (HAMILTON) ROAD

T W P

0
37

J E F F E R S O N

0
5
F

0-57-C