

0-57-D

MIFFLIN TWP.

R.17 TV/P.1




SCALE 1"=200'
E= HIGHWAY EASEMENT
TAXING DISTRICT DISTRICT CODE

*** COLS - JEFFERSON S.D. 5 20
** CITY OF GAHANNA - GAHANNA JEFFERSON S.D. 0 25
H - HOUSE NUMBERS

0
57
E

0
57
E

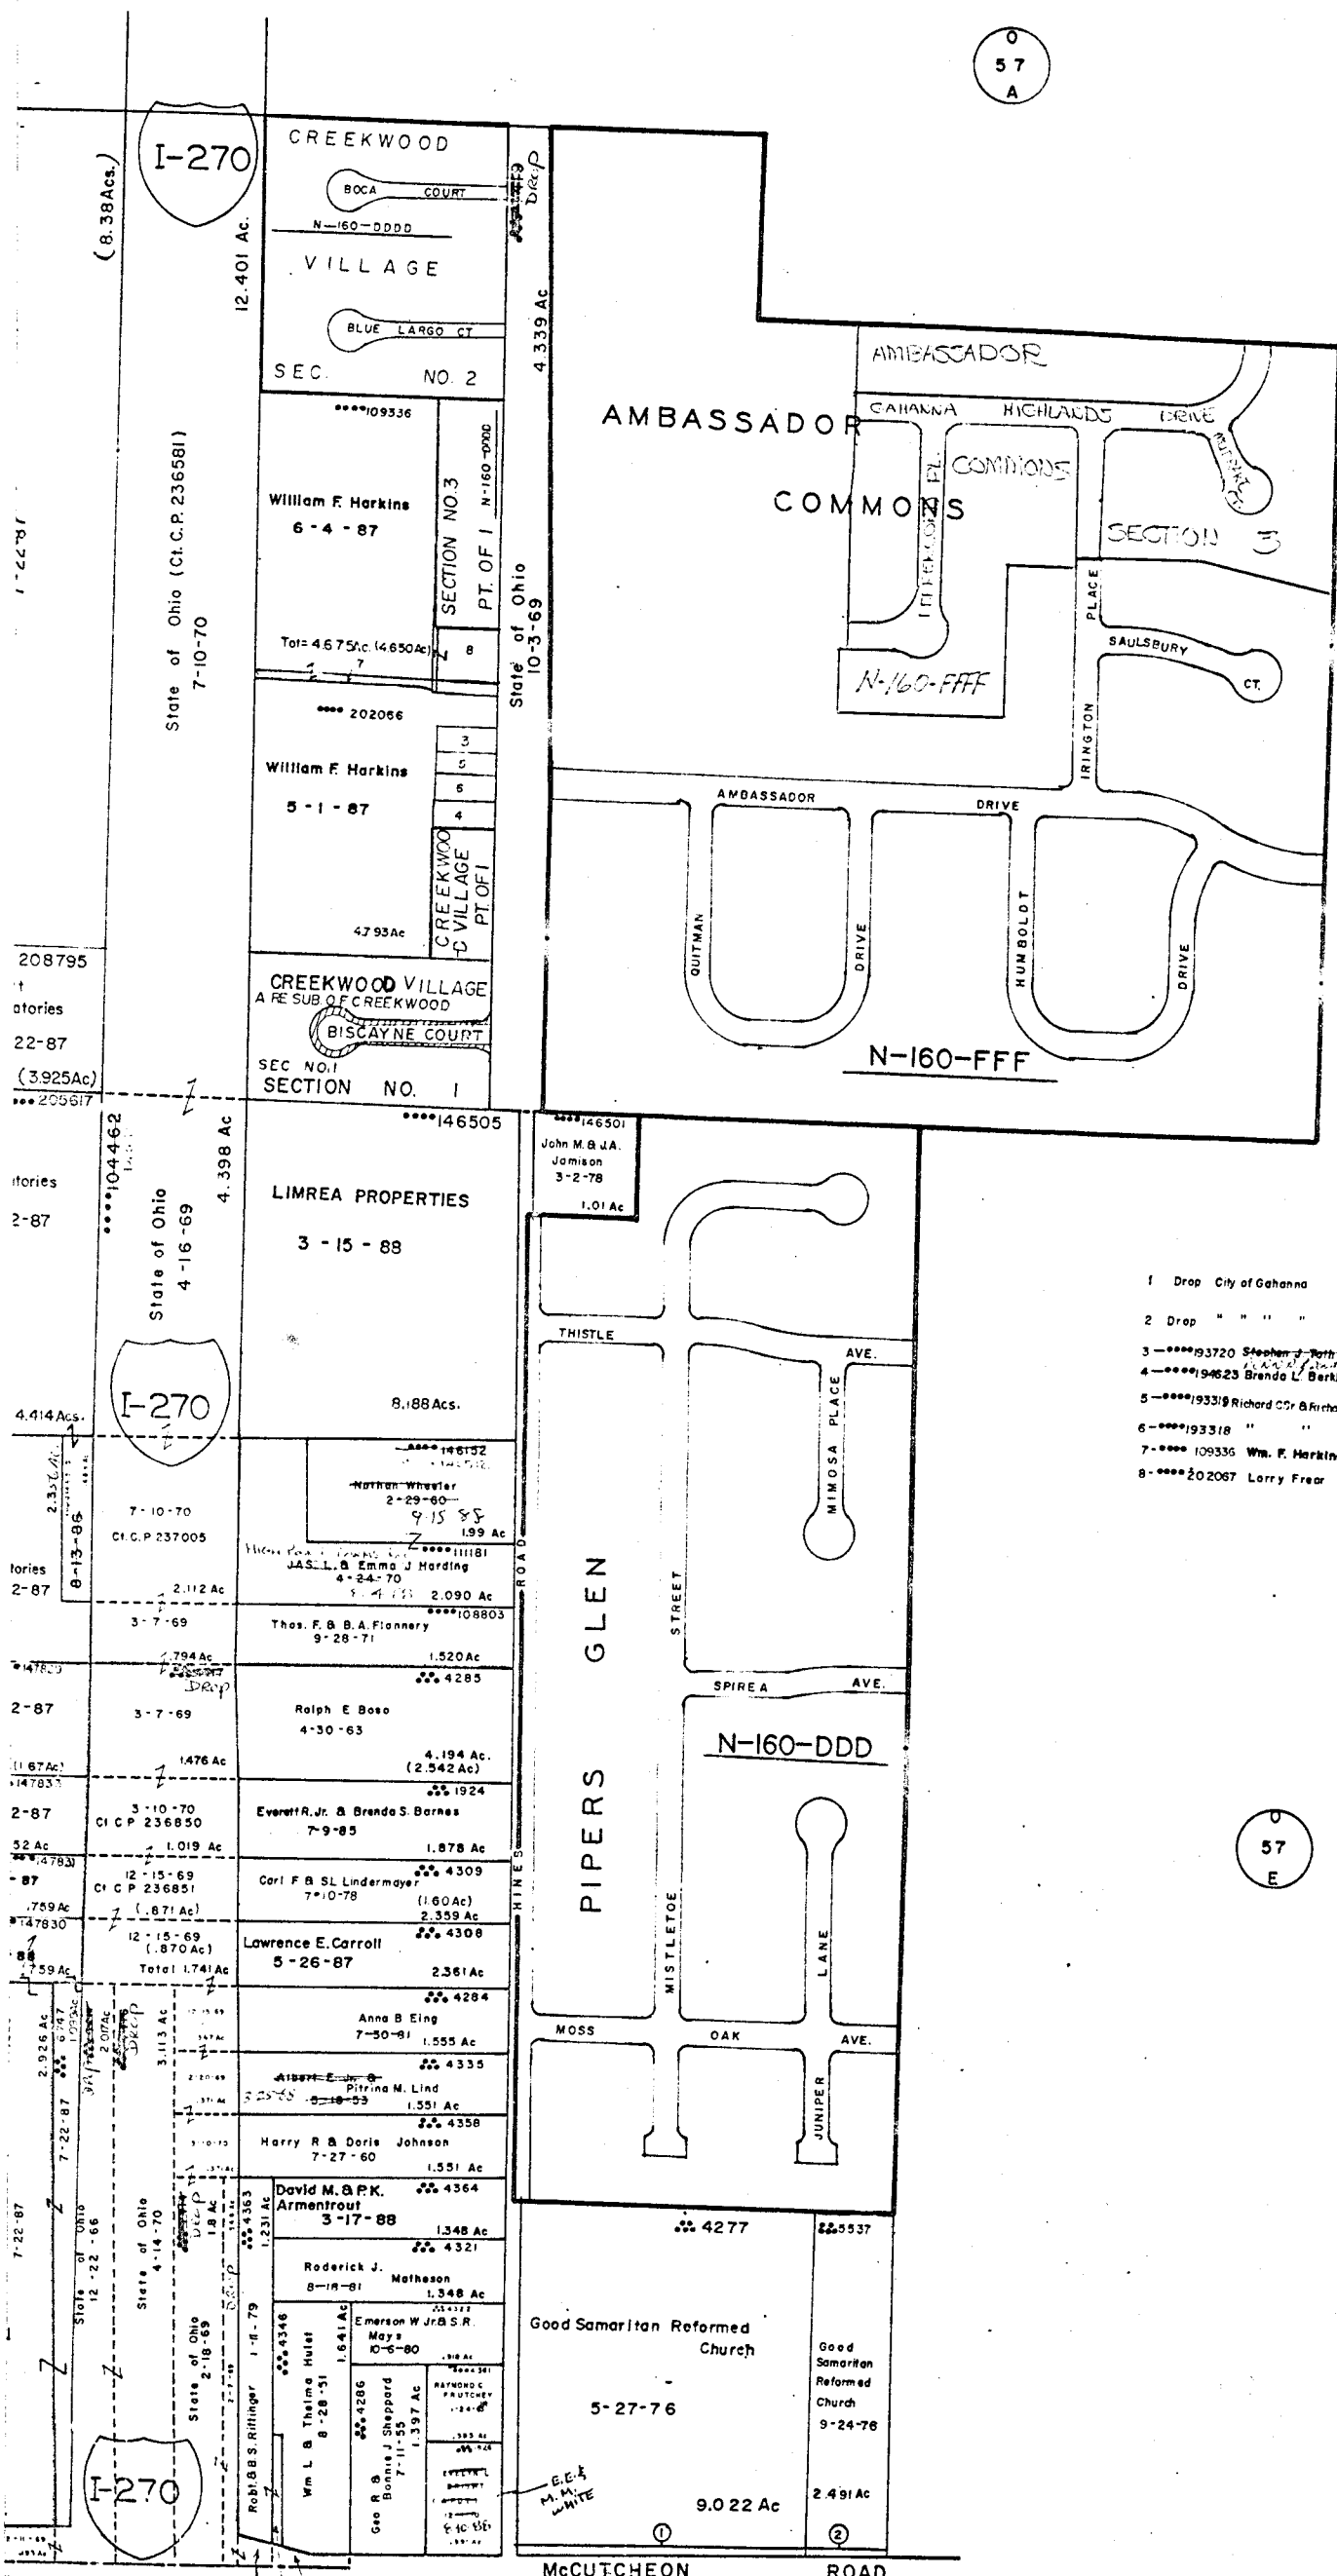

- 1 Drop City of Gahanna 10-22-76 0.540Ac
- 2 Drop " " " " 0.147 Ac
- 3 -***193720 Stephen J. Roth 10-25-83 0.138 Ac
- 4 -***194623 Brenda L. Berkheimer 5-11-85 0.138 Ac
- 5 -***193319 Richard C. & Richard C. Jr. Hannon 4-9-80 0.138 Ac
- 6 -***193318 " " " " 0.158 Ac
- 7 -*** 109336 Wm. F. Harkins 6-4-87 (0.28 Ac)
- 8 -***202067 Larry Frear 9-10-85 0.33 Ac (0.264 Ac.)

N
160
J