


0
57
F

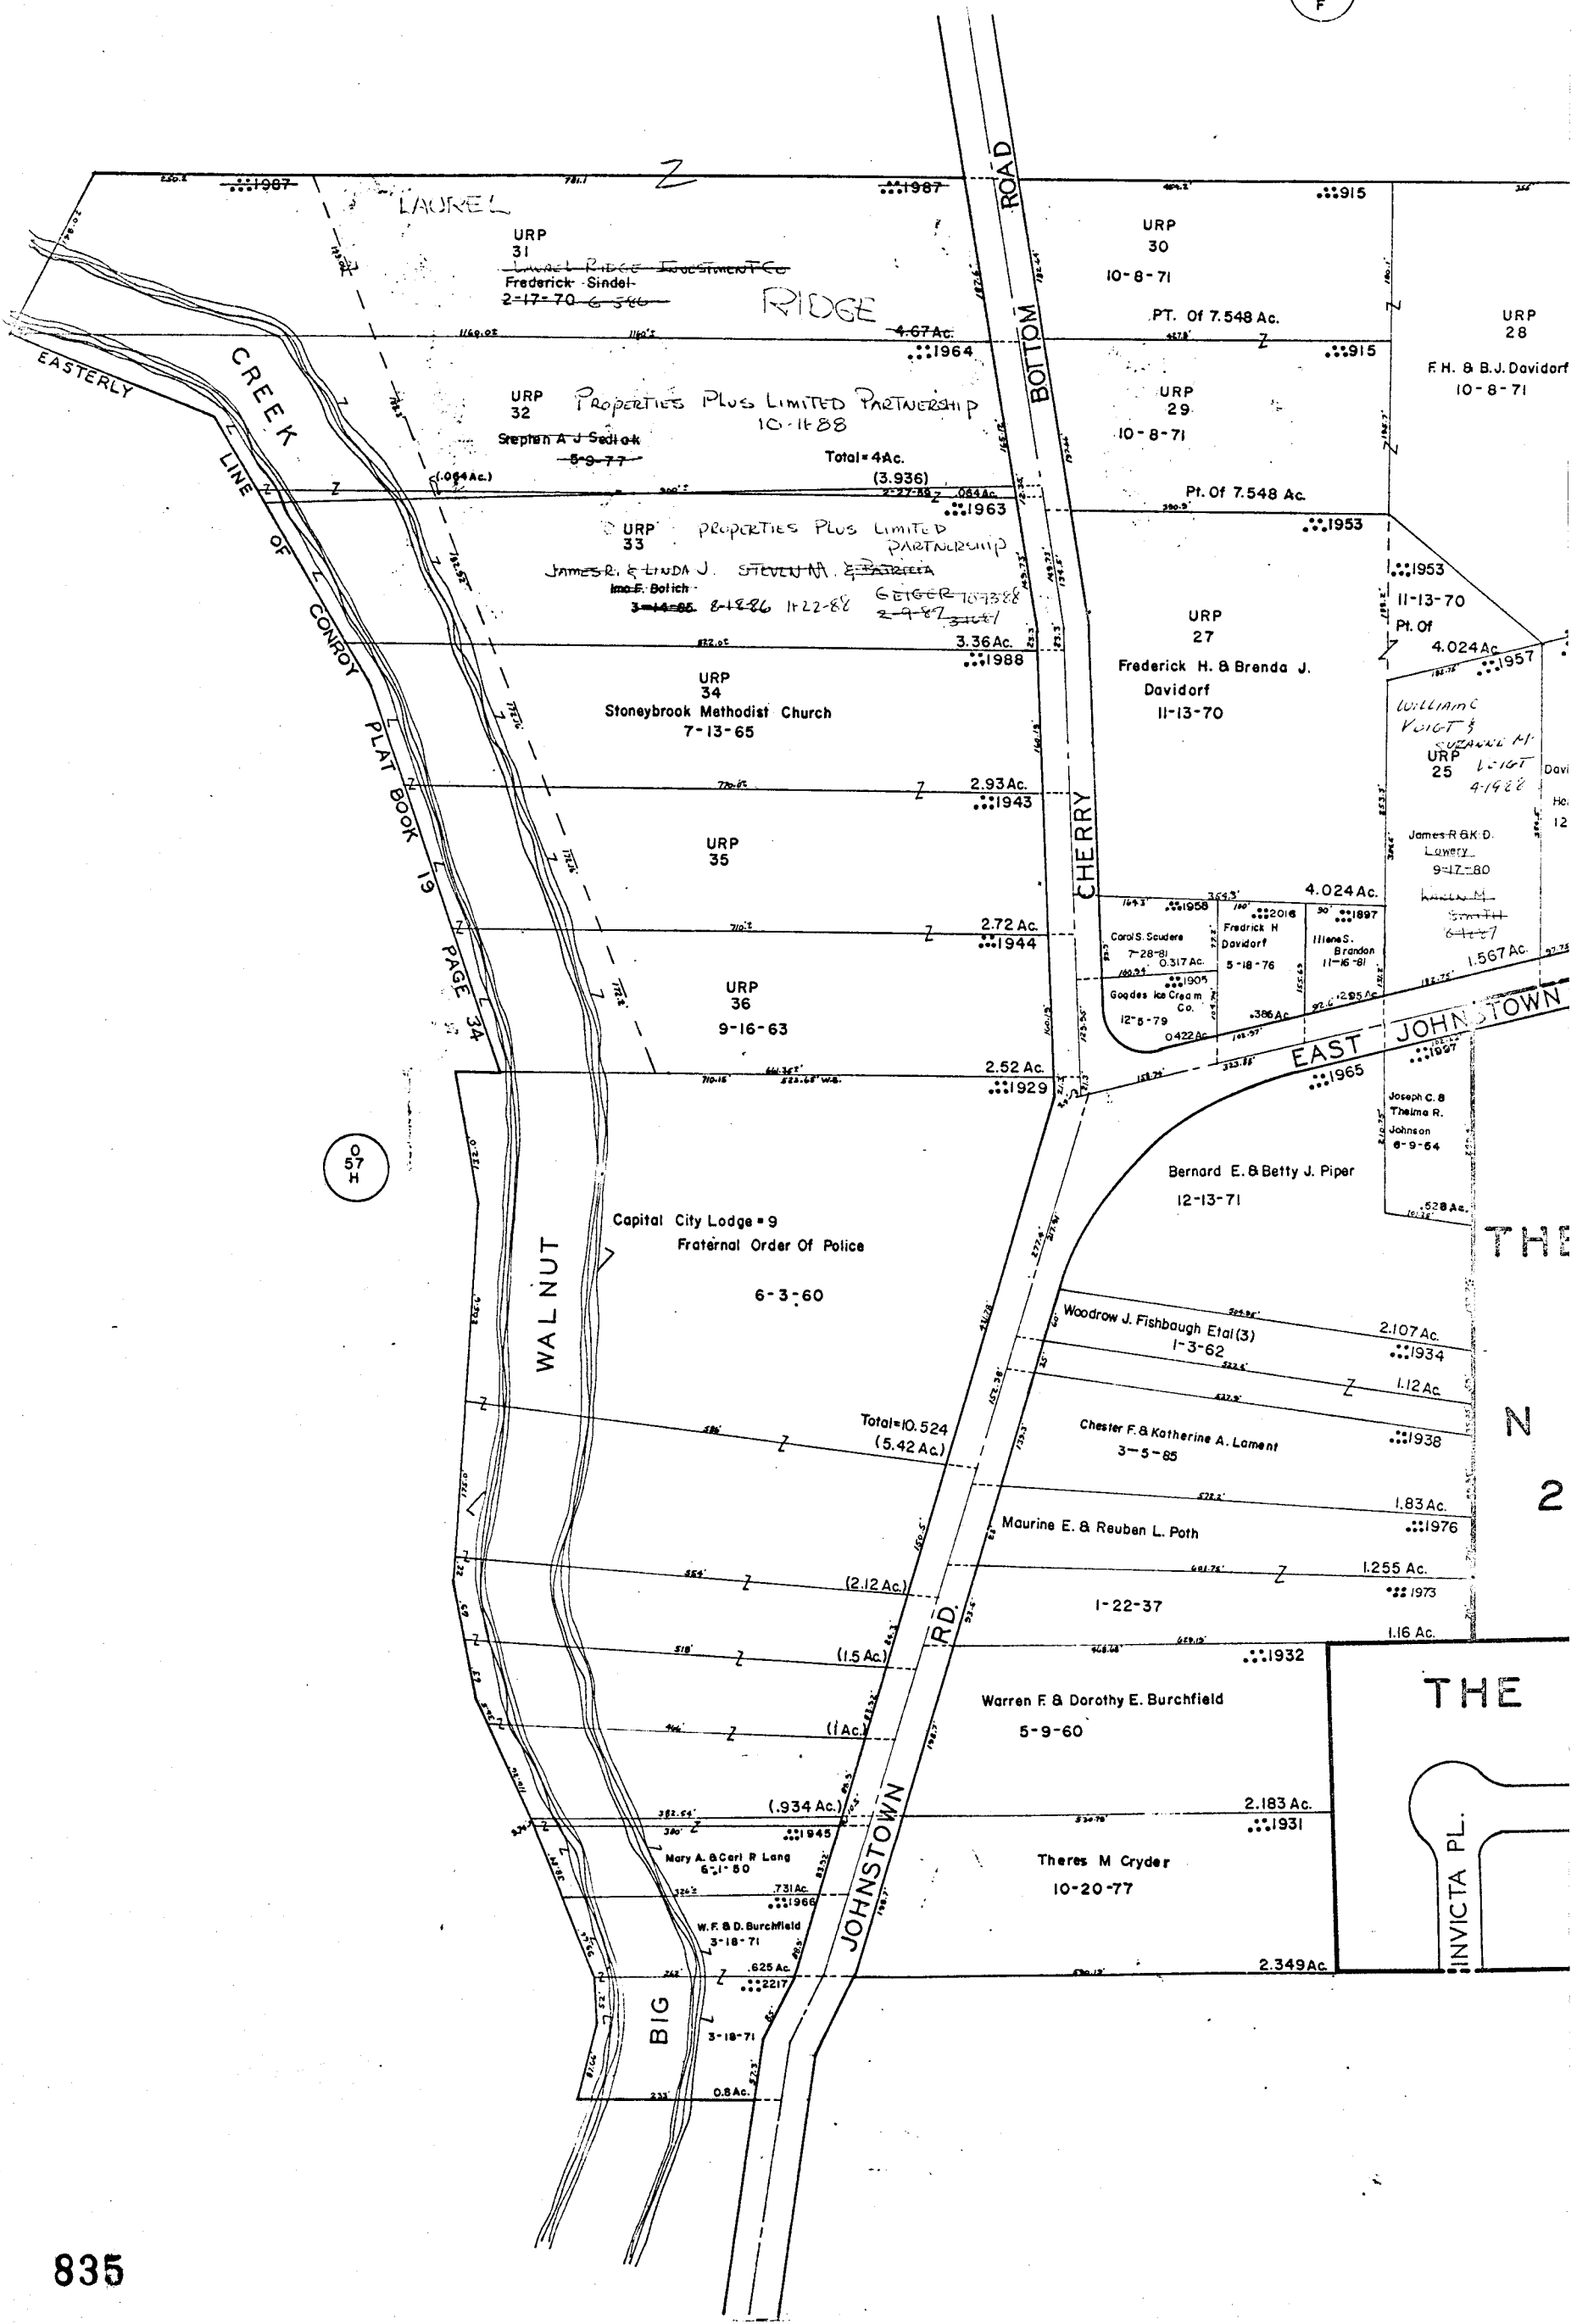


0-57-HH
MIFFLIN TWP

R.17 TWRI



SCALE 1"=100'
E-HIGHWAY EASEMENT
TAXING DISTRICT DISTRICT C
CITY OF GAHANNA
GAHANNA JEFF. S.D. 025

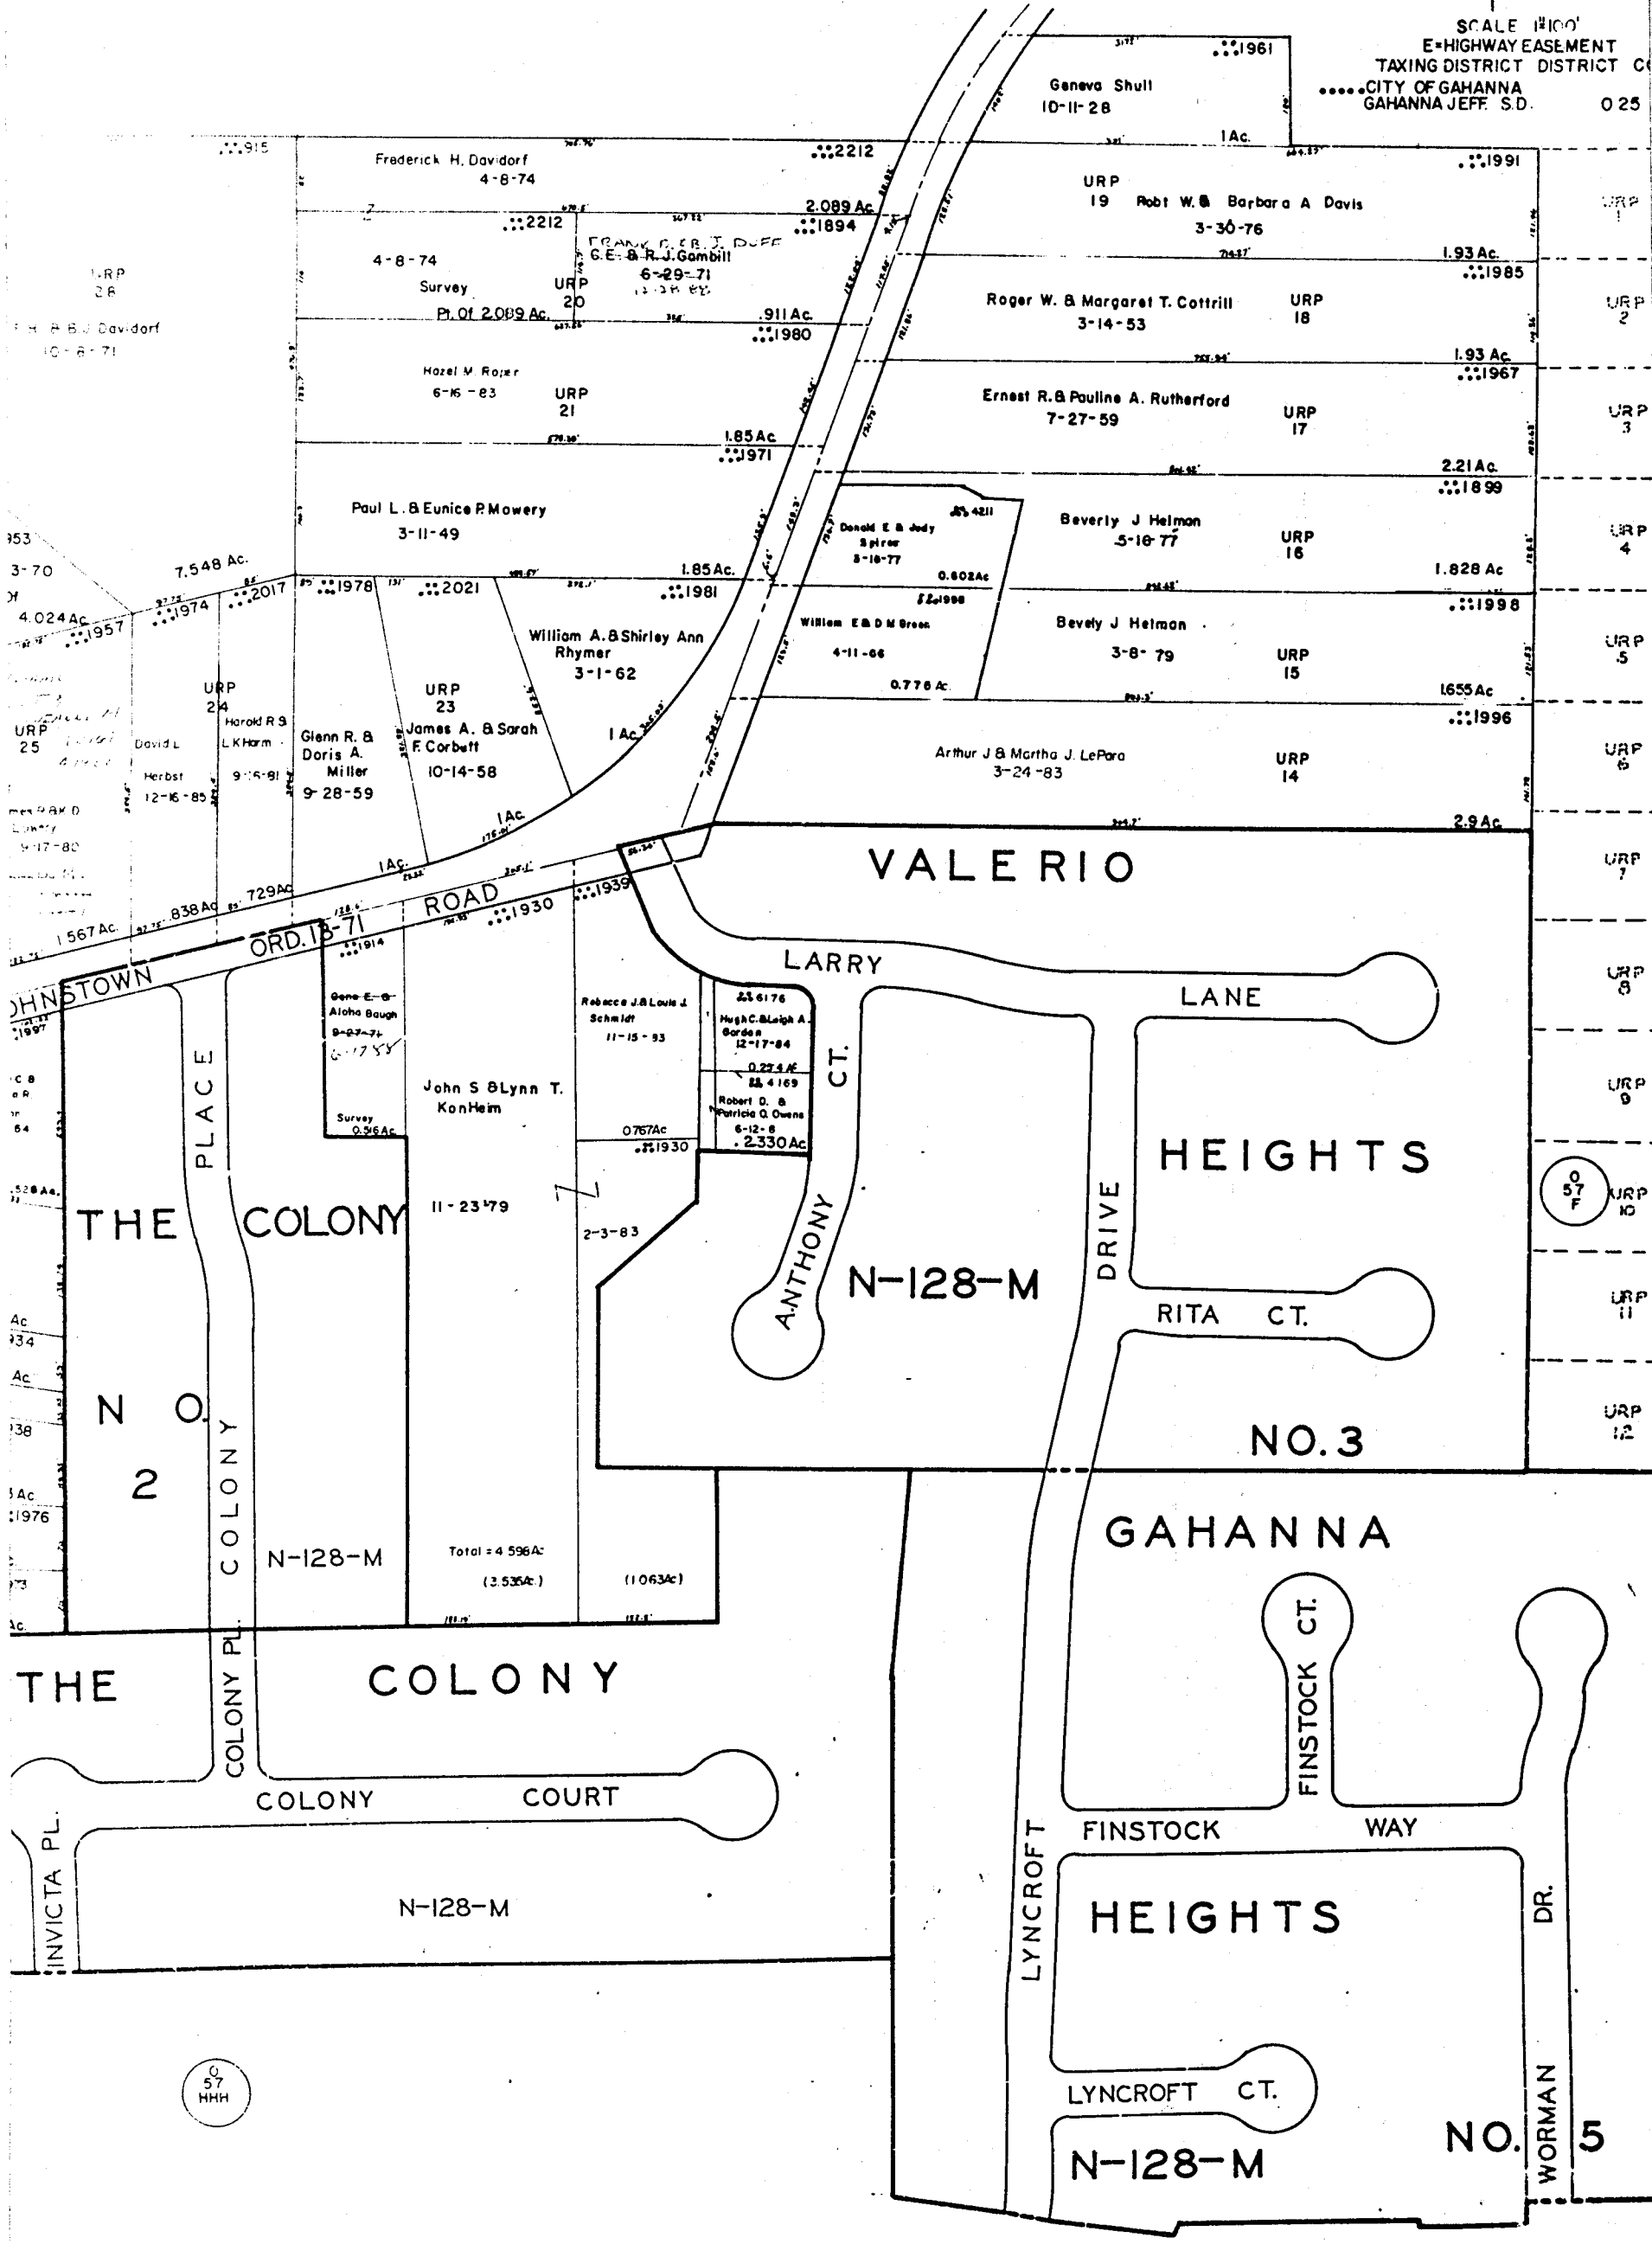

0
57
HHH

0
57
F

0-57-HH