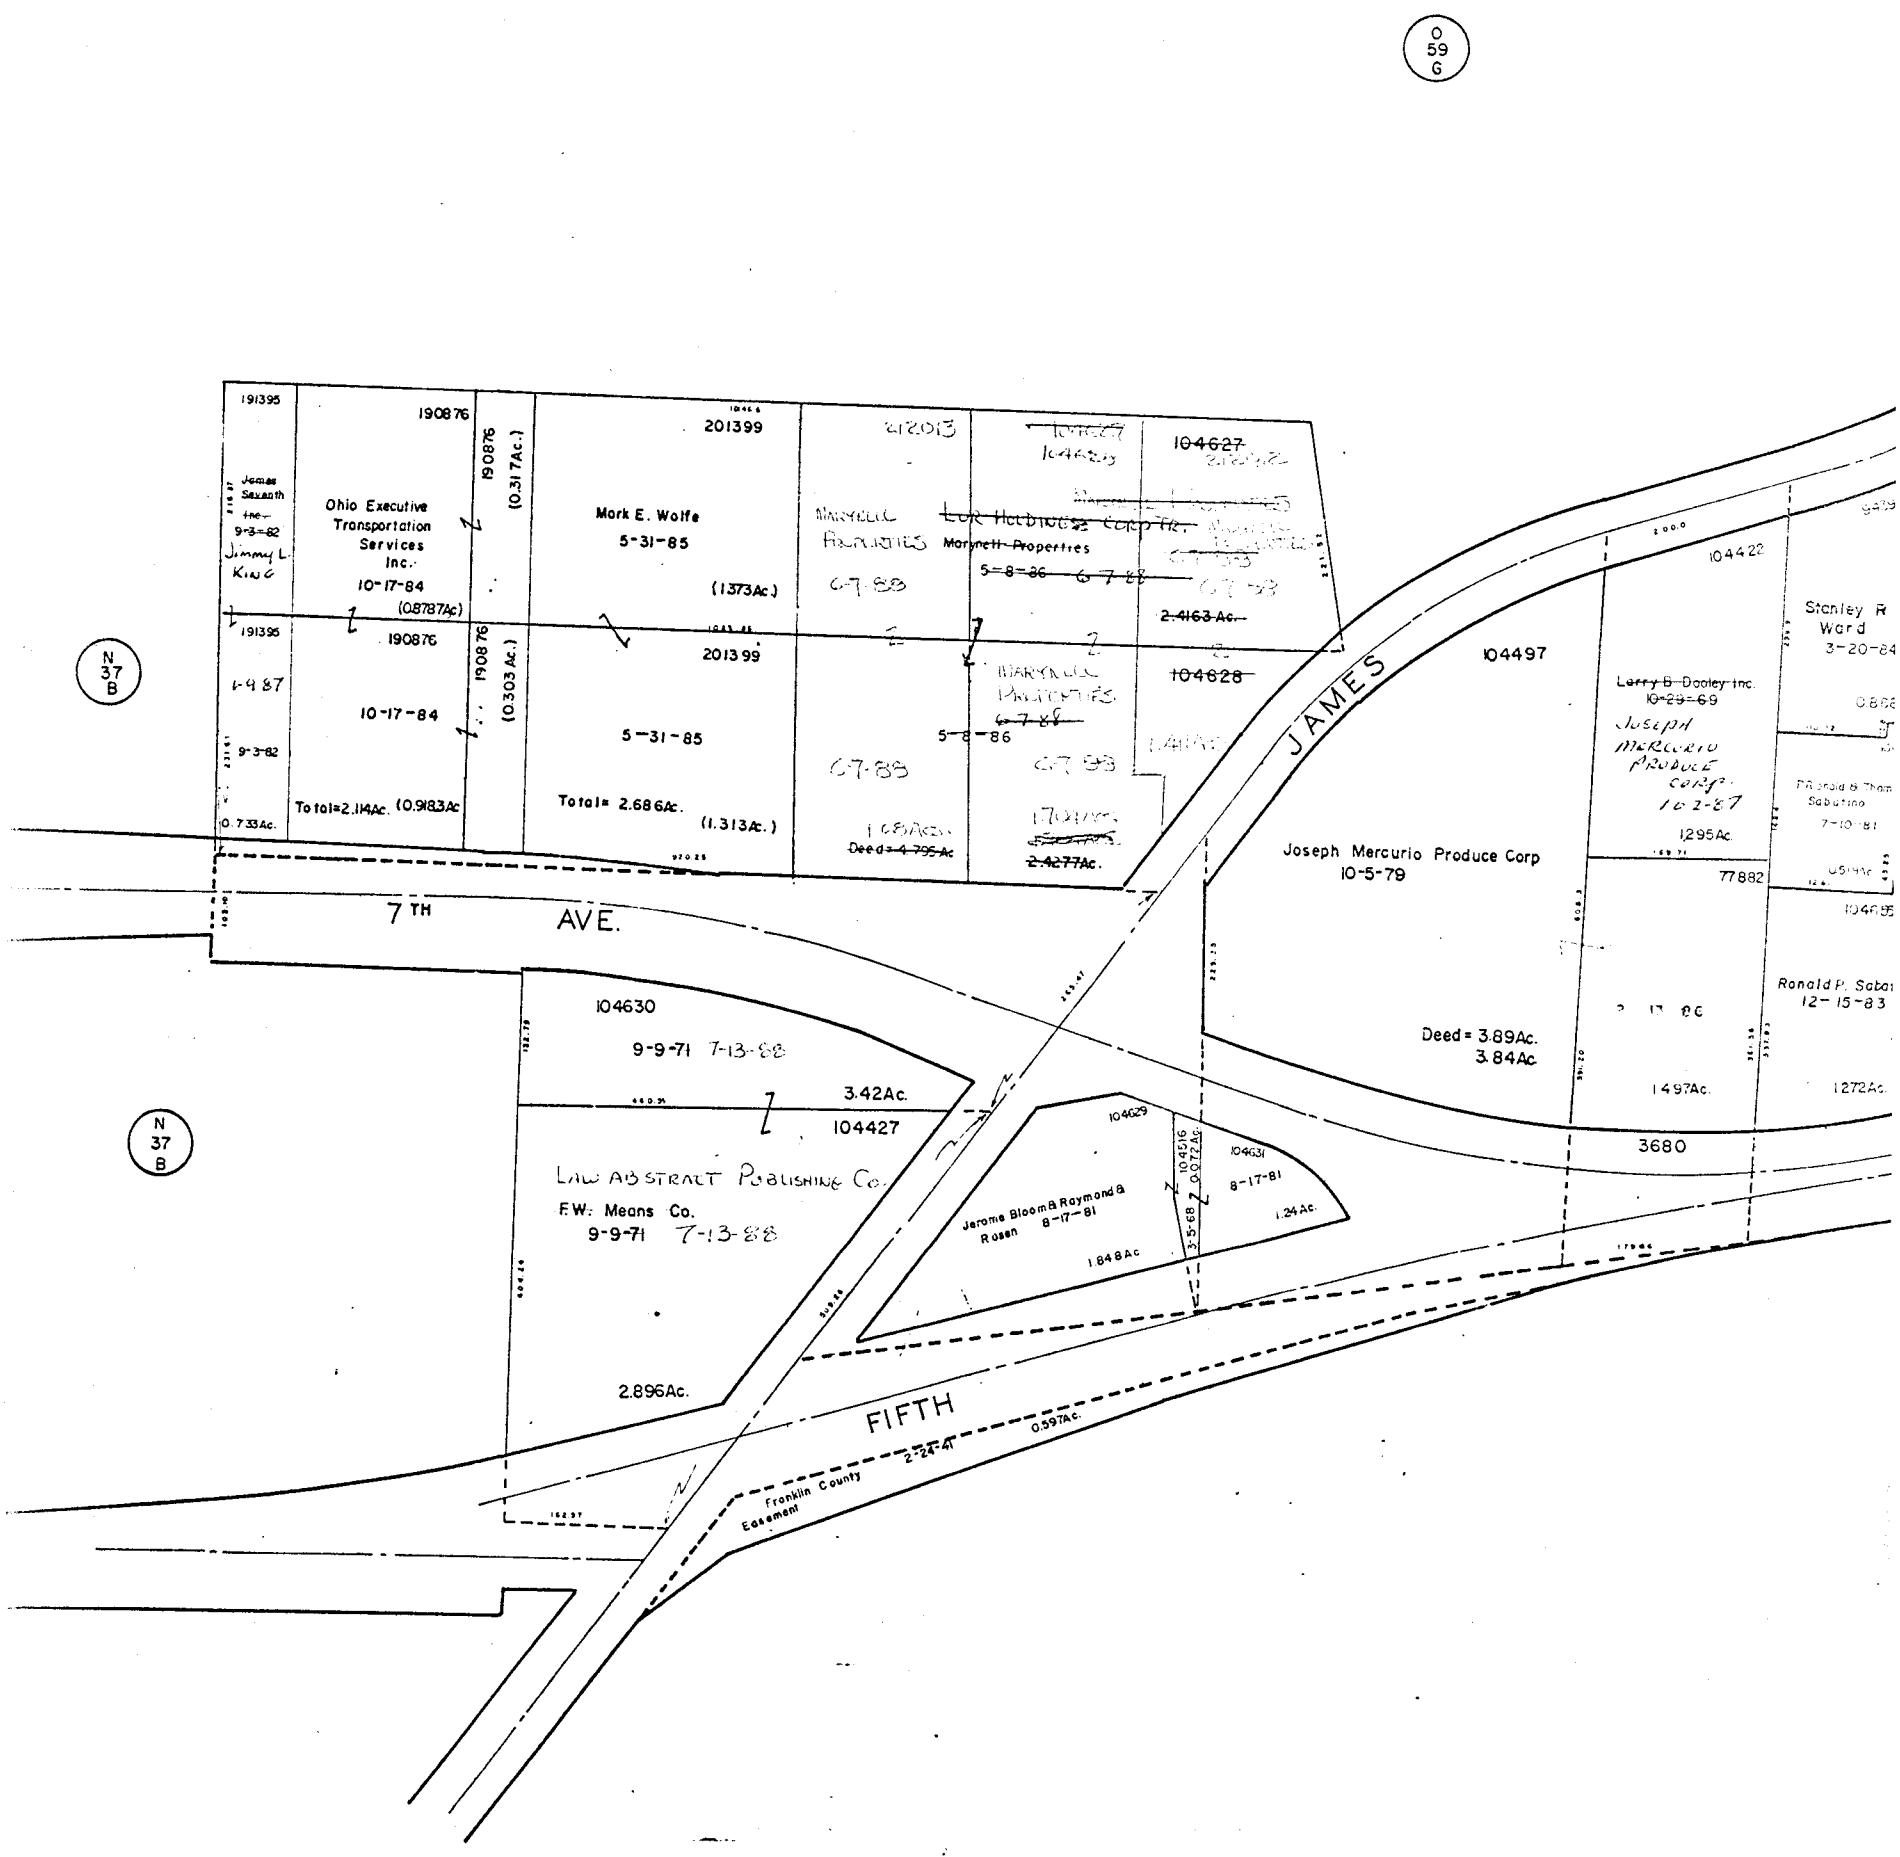
O
59
G
N
37
B
191395
190876
190876
(0.317Ac.)
Ohio Executive
Transportation
Services
Inc.
10-17-84
(0.8787Ac)
Mark E. Wolfe
5-31-85
(1.373Ac.)
201399
Marynell Properties
Marynell Properties
5-8-86
104627
2.4163 Ac.
104628
James Seventh Inc.
9-3-82
Jimmy L. King
190876
(0.303 Ac.)
10-17-84
5-31-85
Total=2.114Ac.
(0.9183Ac
Total= 2.686Ac.
(1.313Ac.)
Deed=4.795Ac
2.4277Ac.
JAMES
104497
104422
Larry B. Dooley Inc.
10-29-69
Joseph Mercurio Produce Corp.
10-2-87
1.295Ac.
77882
Stanley R Ward
3-20-84
Ronald P. Sabatino
12-15-83
Joseph Mercurio Produce Corp
10-5-79
Deed = 3.89Ac.
3.84Ac.
1.497Ac.
1.272Ac.
3680
7 TH
AVE.
104630
9-9-71 7-13-88
3.42Ac.
104427
Law Abstract Publishing Co.
F.W. Means Co.
9-9-71 7-13-88
2.896Ac.
104629
104516
0.072Ac.
104631
8-17-81
1.24Ac.
Jerome Bloom & Raymond B Rosen
8-17-81
1.848Ac
FIFTH
2-24-41
0.597Ac.
Franklin County
Easement

0-59-GG

MIFFLIN TWP.
R.17 TWP.1

N

SCALE 1" = 100'
E = HIGHWAY EASEMENT
TAXING DISTRICT DISTRICT CODE
COLUMBUS 010

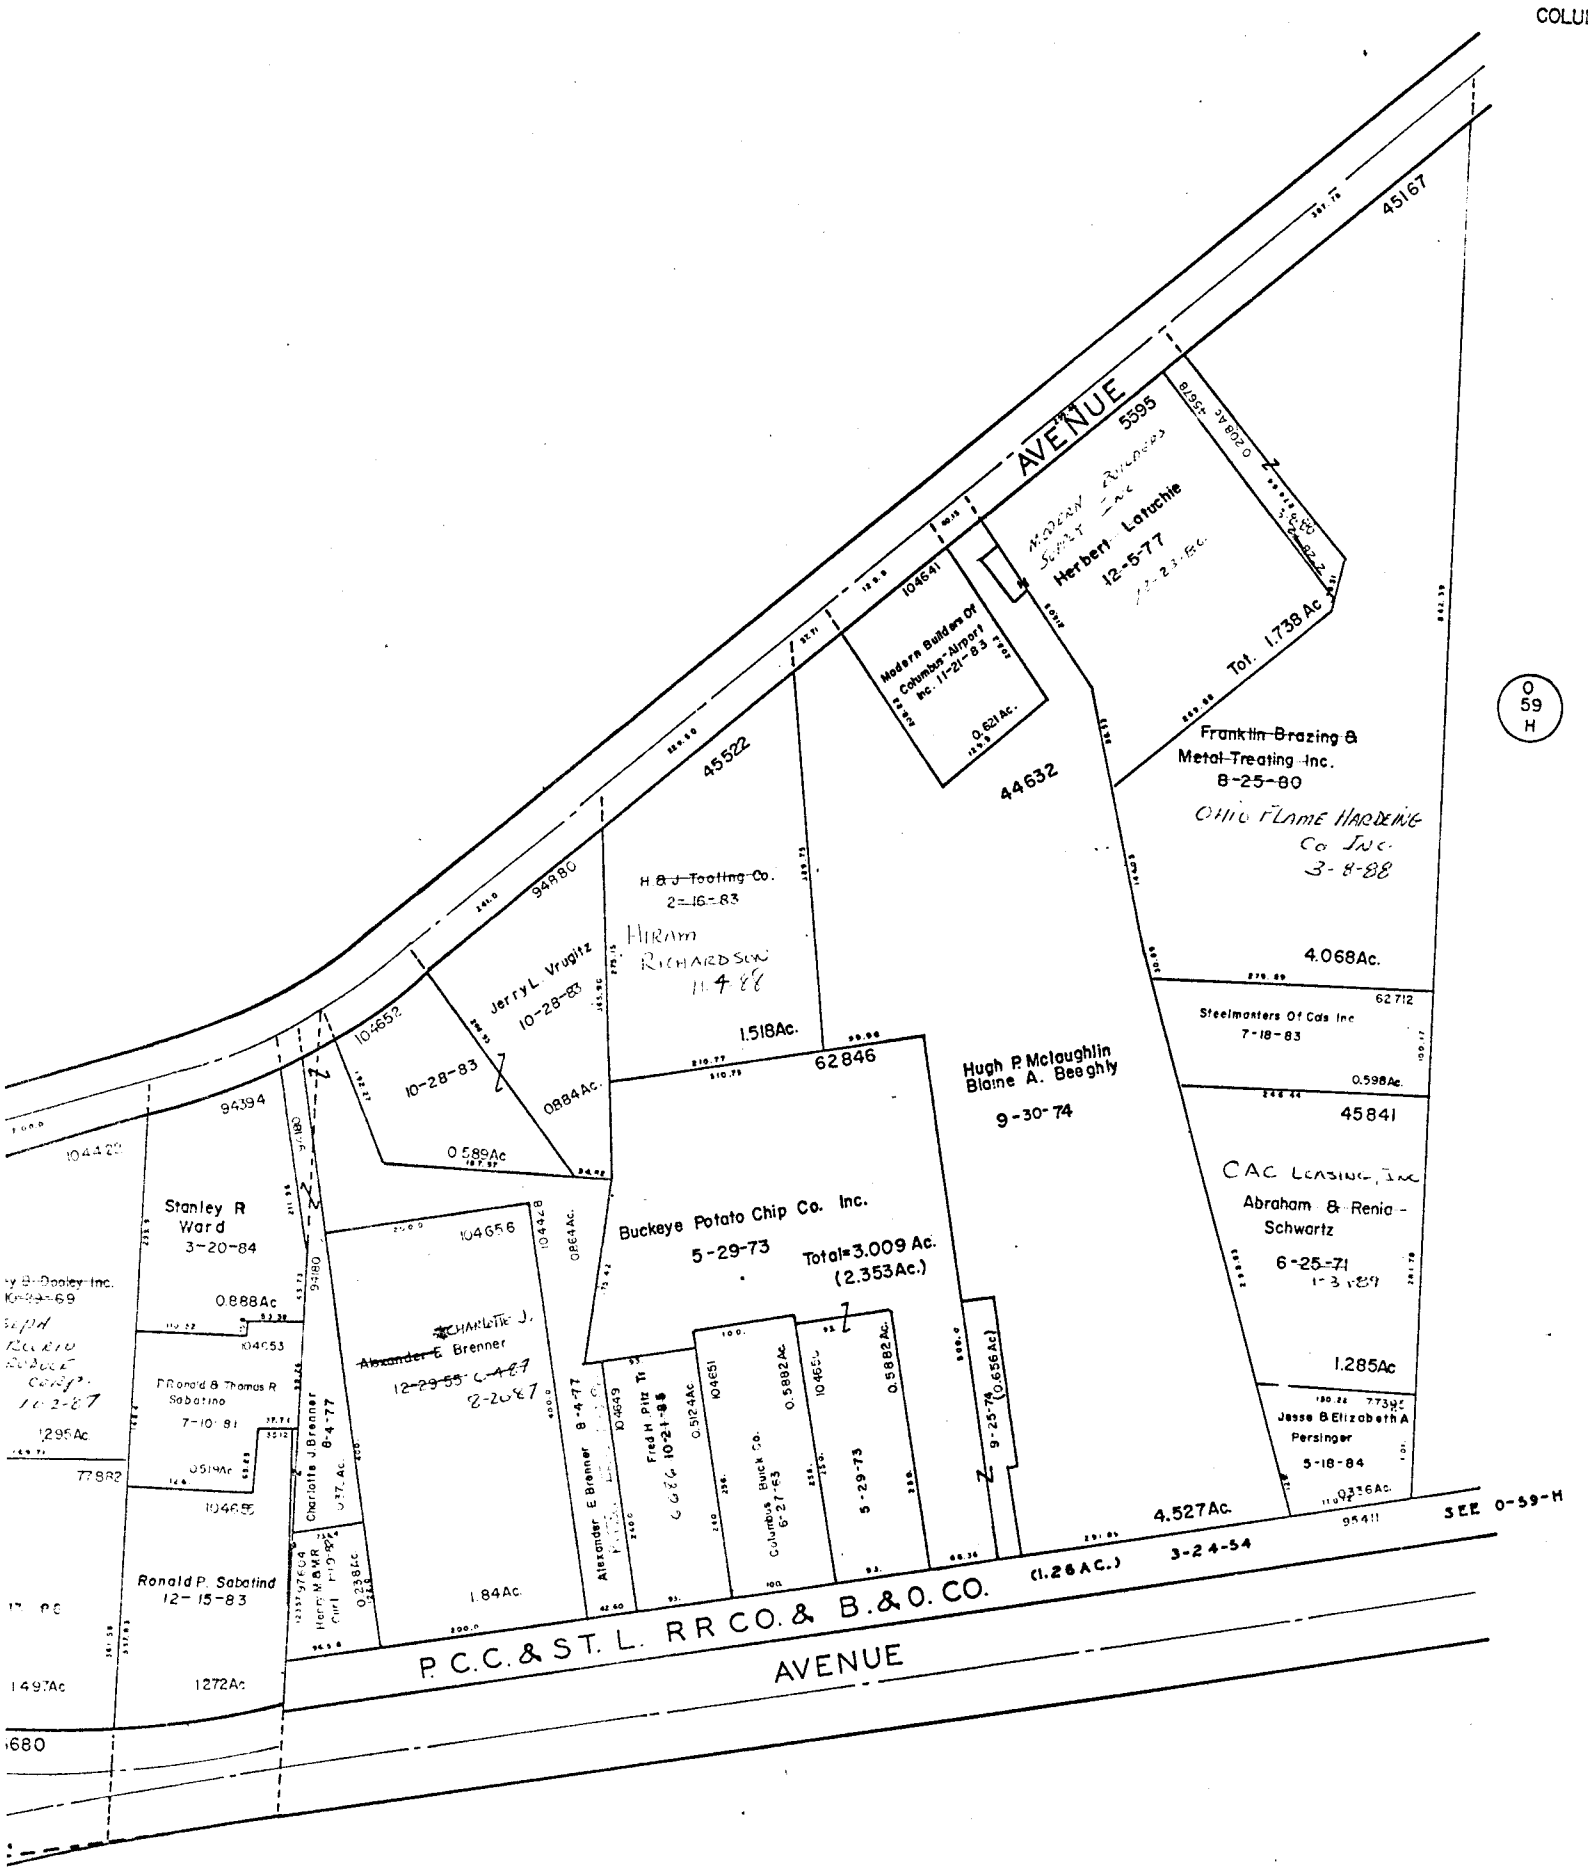

0
59
H

0
59
G

0-59-GG

870