

O-59-H


MIFFLIN TWP
R.17 TWP 1



SCALE 1" = 200'

E=HIGHWAY EASEMENT
TAXING DISTRICT DISTRICT CODE
COLUMBUS 010
WHITEHALL 090

① 96152 B&O RR. 7-22-42 (1.71Ac in Hi-Way) 1.864Ac.

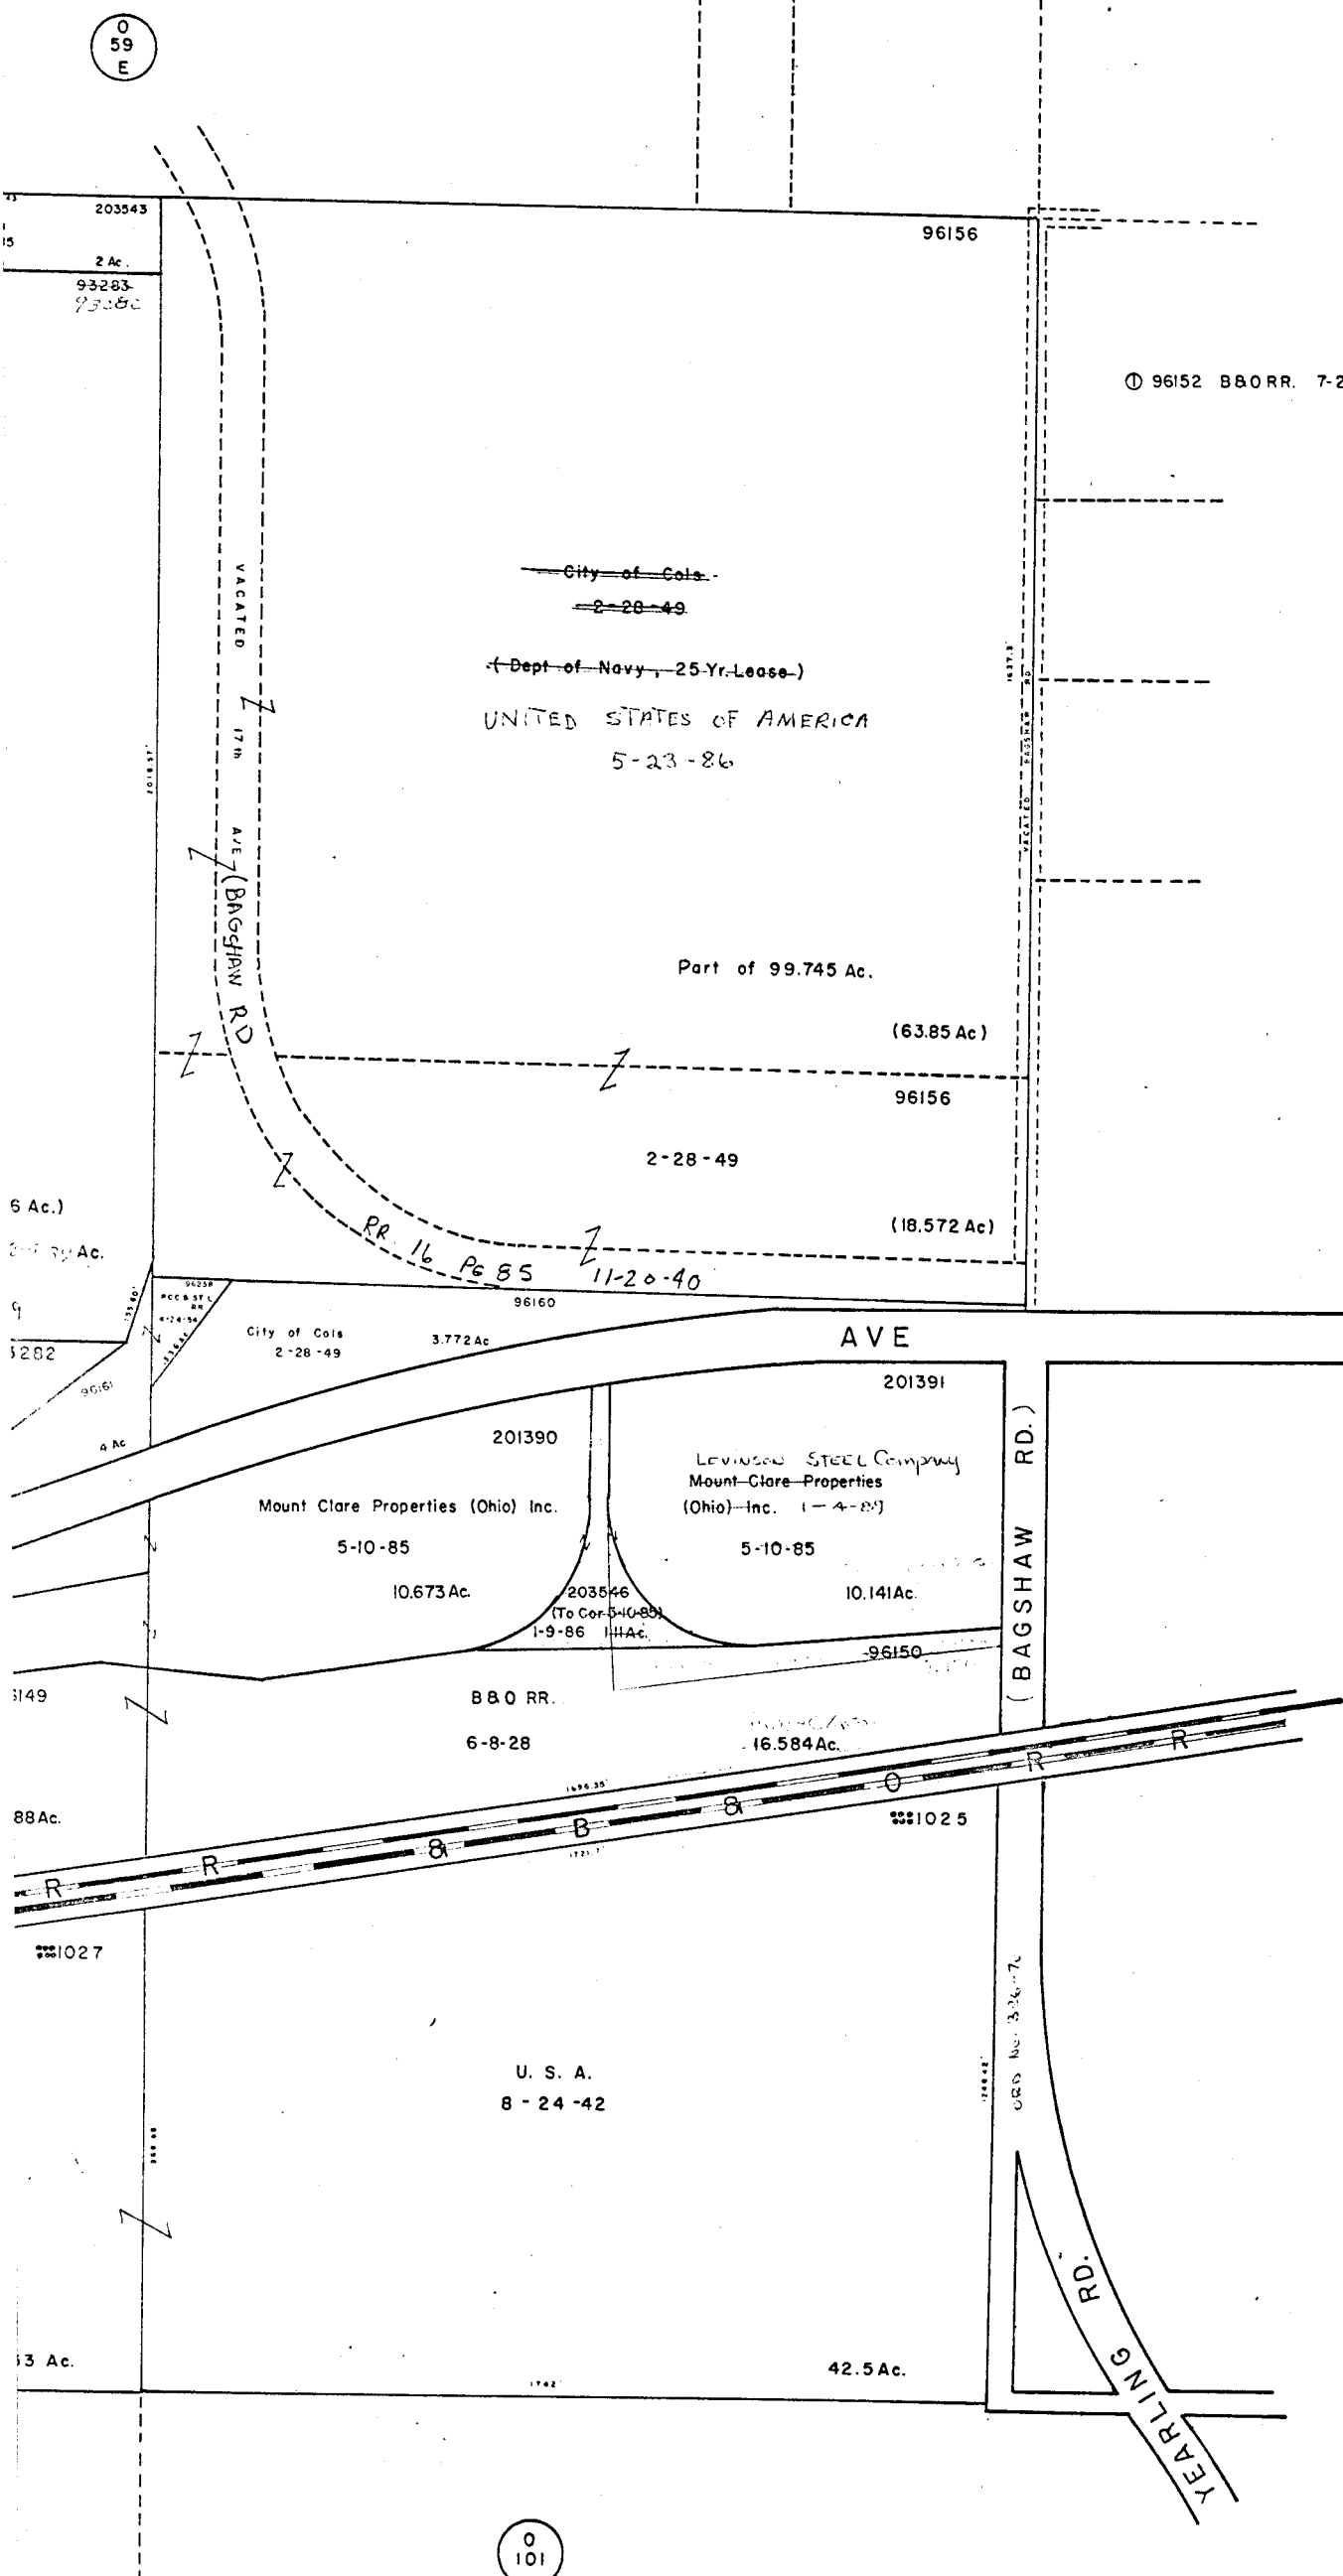

O
59
E

O
59
J

O
101

O-59-H

872