


3012

060
c

0-60-F
NORWICH TWP

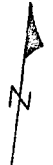


SCALE 1" = 200'
V.M.S.

E = HIGHWAY EASEMENT

TAXING DISTRICTS	DISTRICT CODES
NORWICH TWP	200
HILLIARD	050
H---HOUSE	NUMBERS

● FRANKLIN COUNTY SURVEY MONUMEN

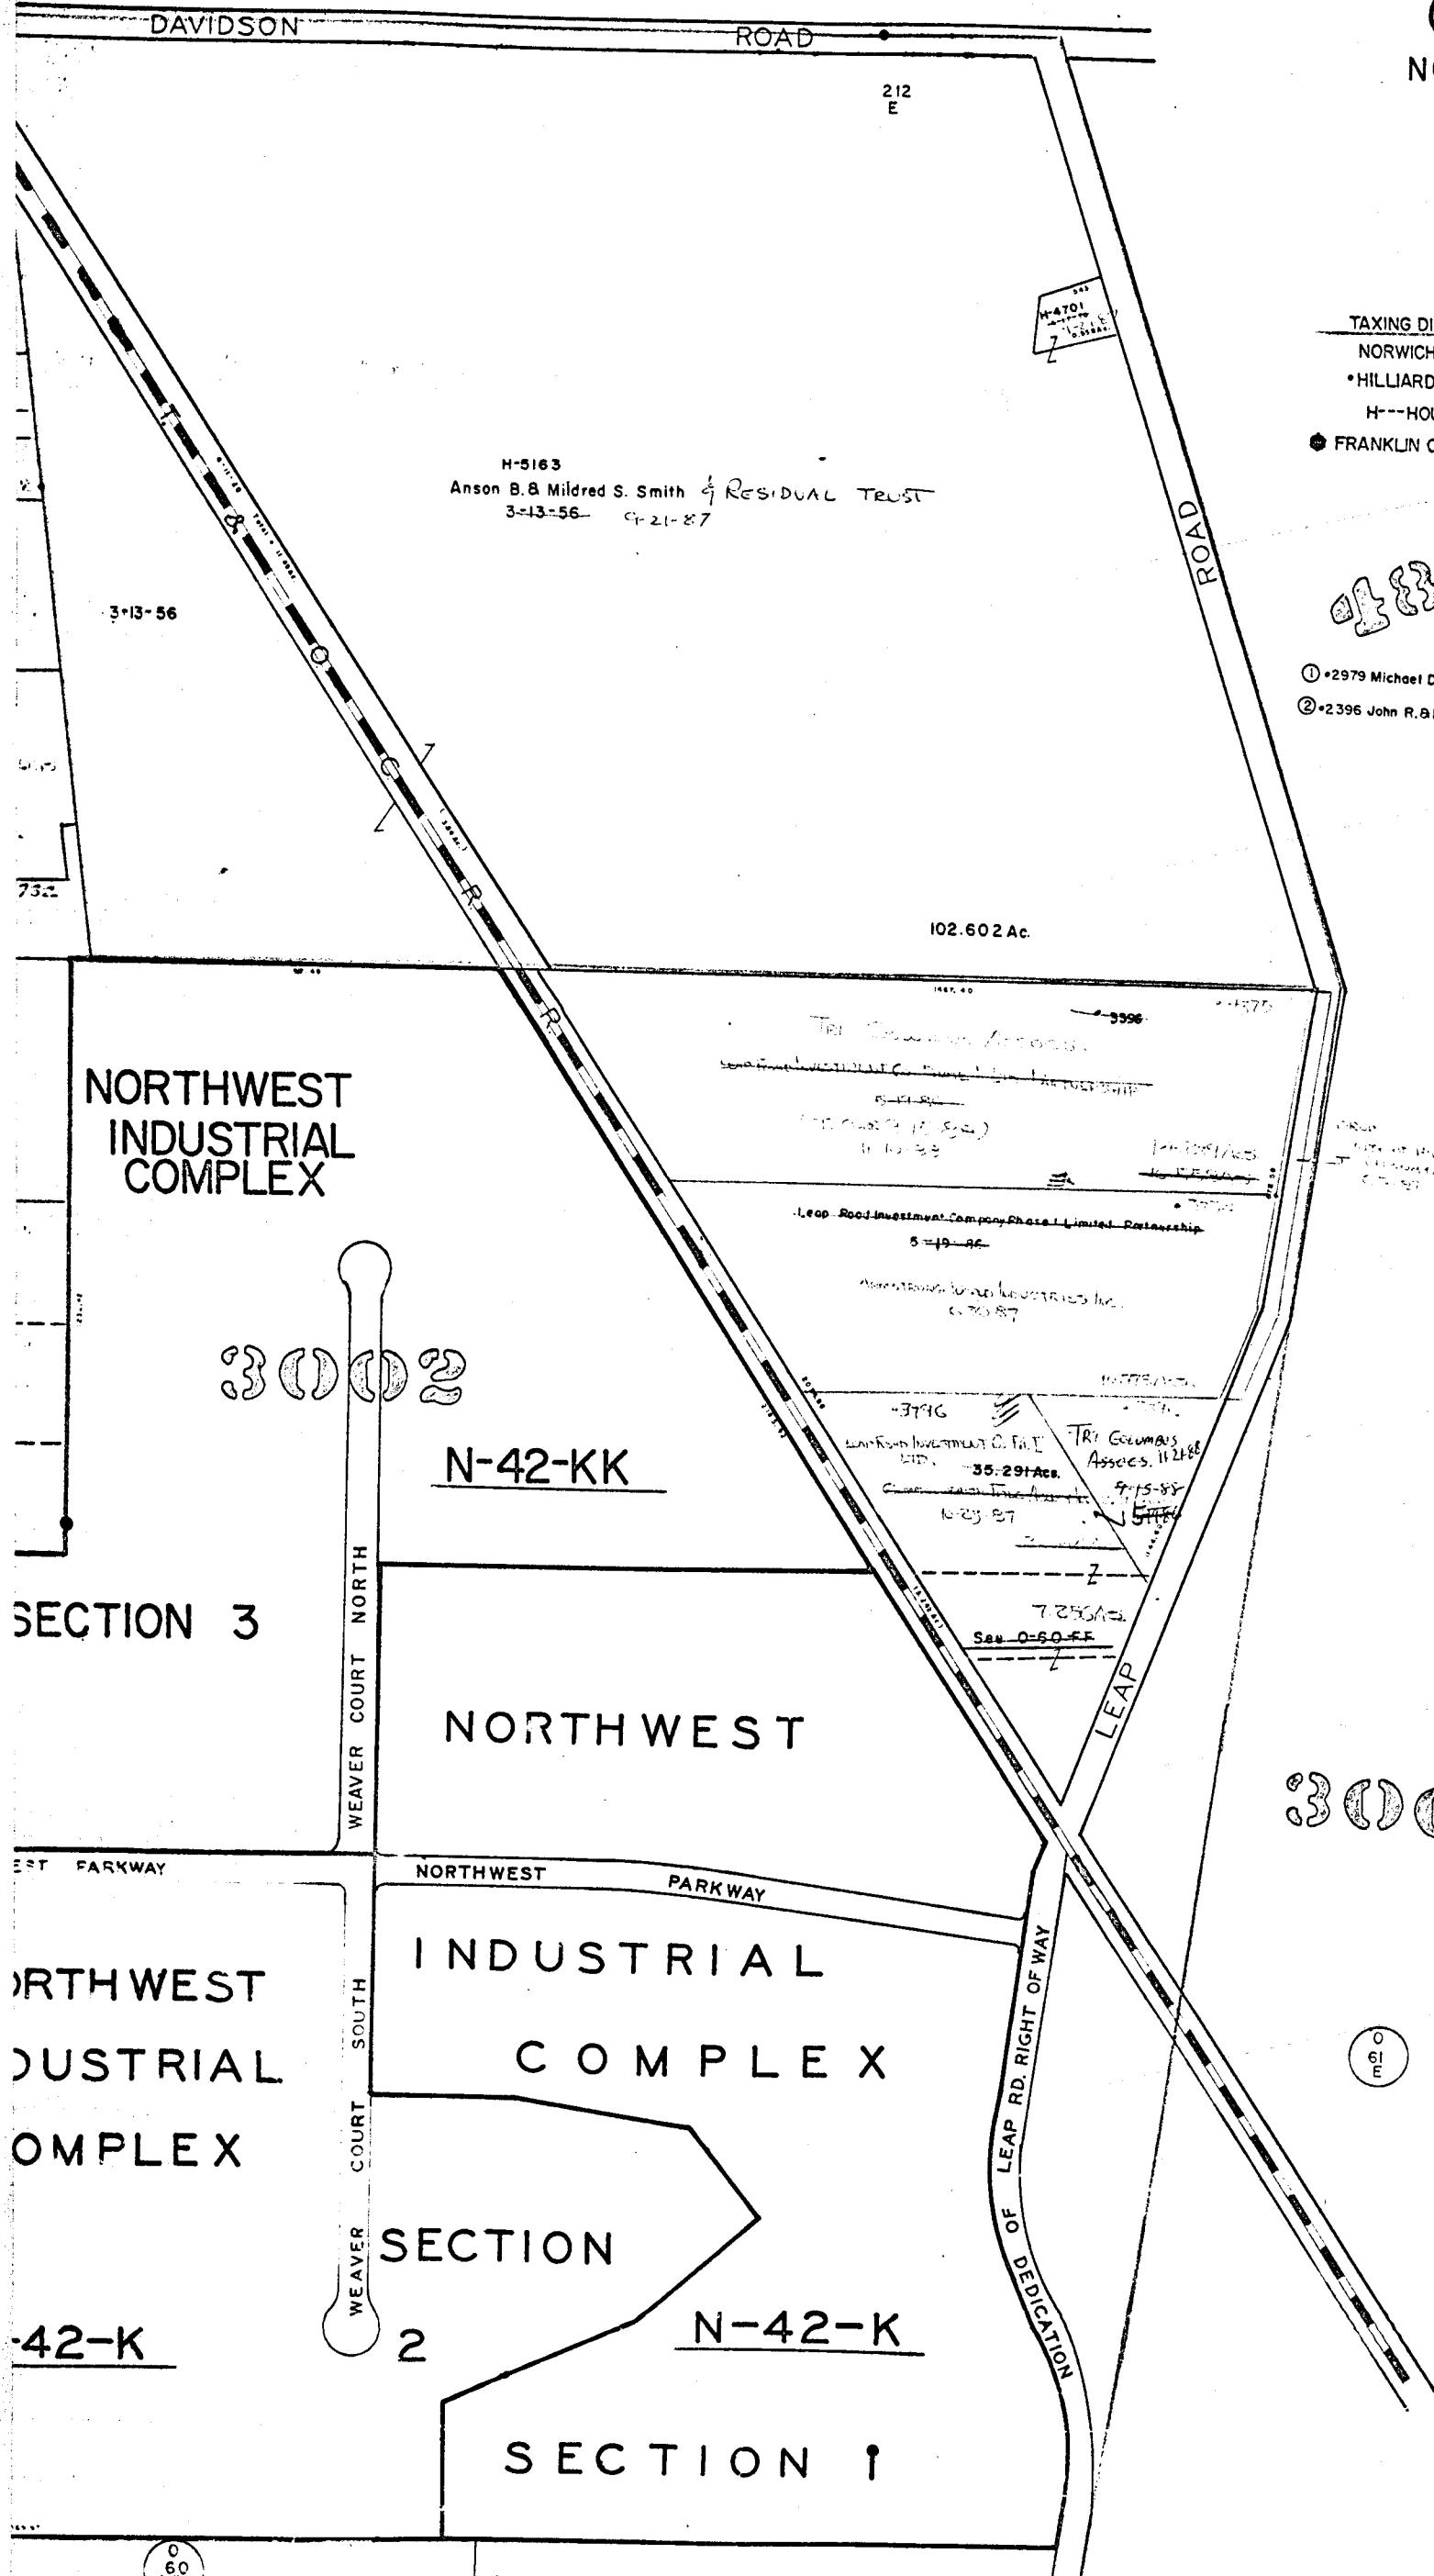

H-5163
Anson B. & Mildred S. Smith & RESIDUAL TRUST
3-13-56 9-21-87

3-13-56

102.602 Ac.

NORTHWEST
INDUSTRIAL
COMPLEX

3002

N-42-KK

SECTION 3

NORTHWEST

NORTHWEST
INDUSTRIAL
COMPLEX

INDUSTRIAL
COMPLEX

SECTION 2

N-42-K

N-42-K

SECTION 1

3000

888

0-60-F

060

061
E

061
c

- ① 2979 Michael D. & J.M. Johnson 5-4-87 .525Ac.
- ② 2396 John R. & Melissa L. Anderson 5-13-87