


0
61
C

30000

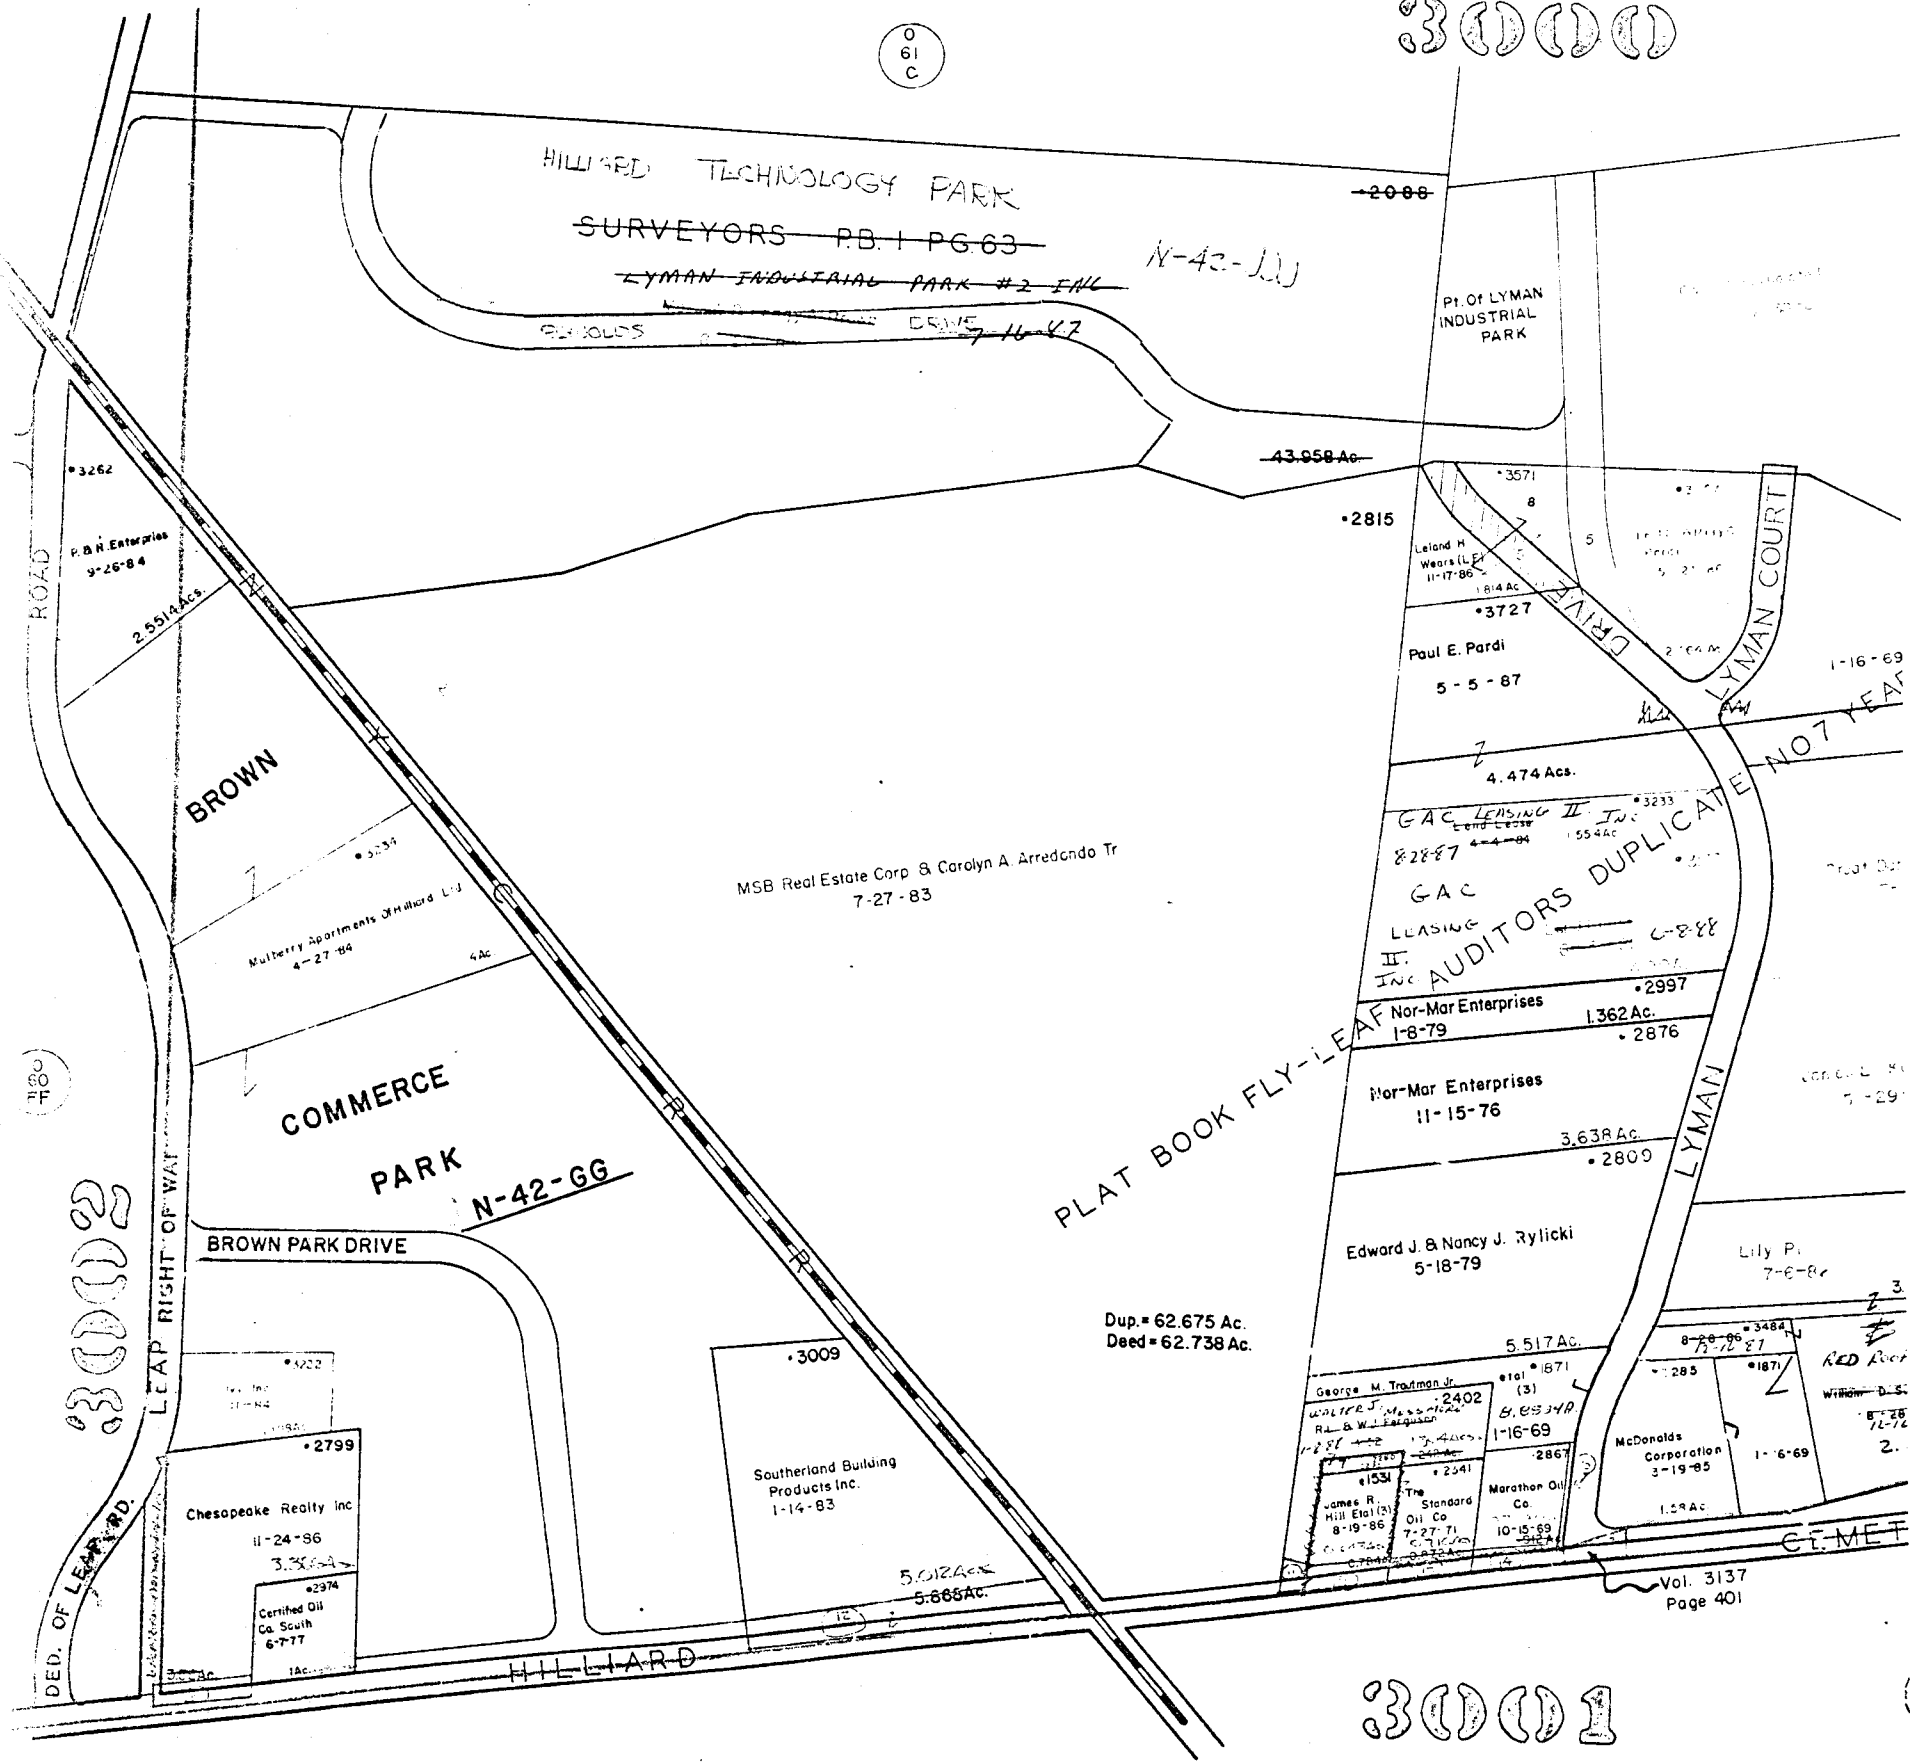


PLAT BOOK FLY-LEAF AUDITORS DUPLICATE NOT VALID

Dup. = 62.675 Ac.
Deed = 62.738 Ac.

Vol. 3137
Page 401

30001



O-61-E
NORWICH TWP.

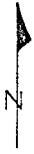

SCALE: 1"=200'
V.M.S.

E= HIGHWAY EASEMENT	
TAXING DISTRICT	DISTRICT CODE
NORWICH TWP	200
CITY OF HILLIARD	050

H---HOUSE NUMBERS

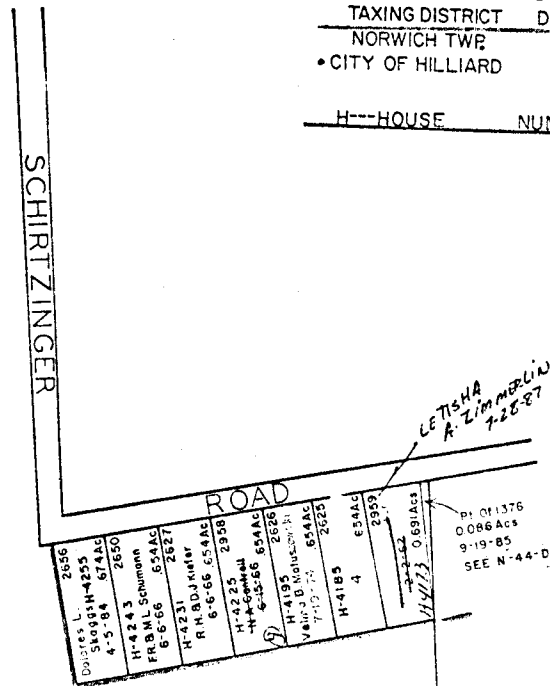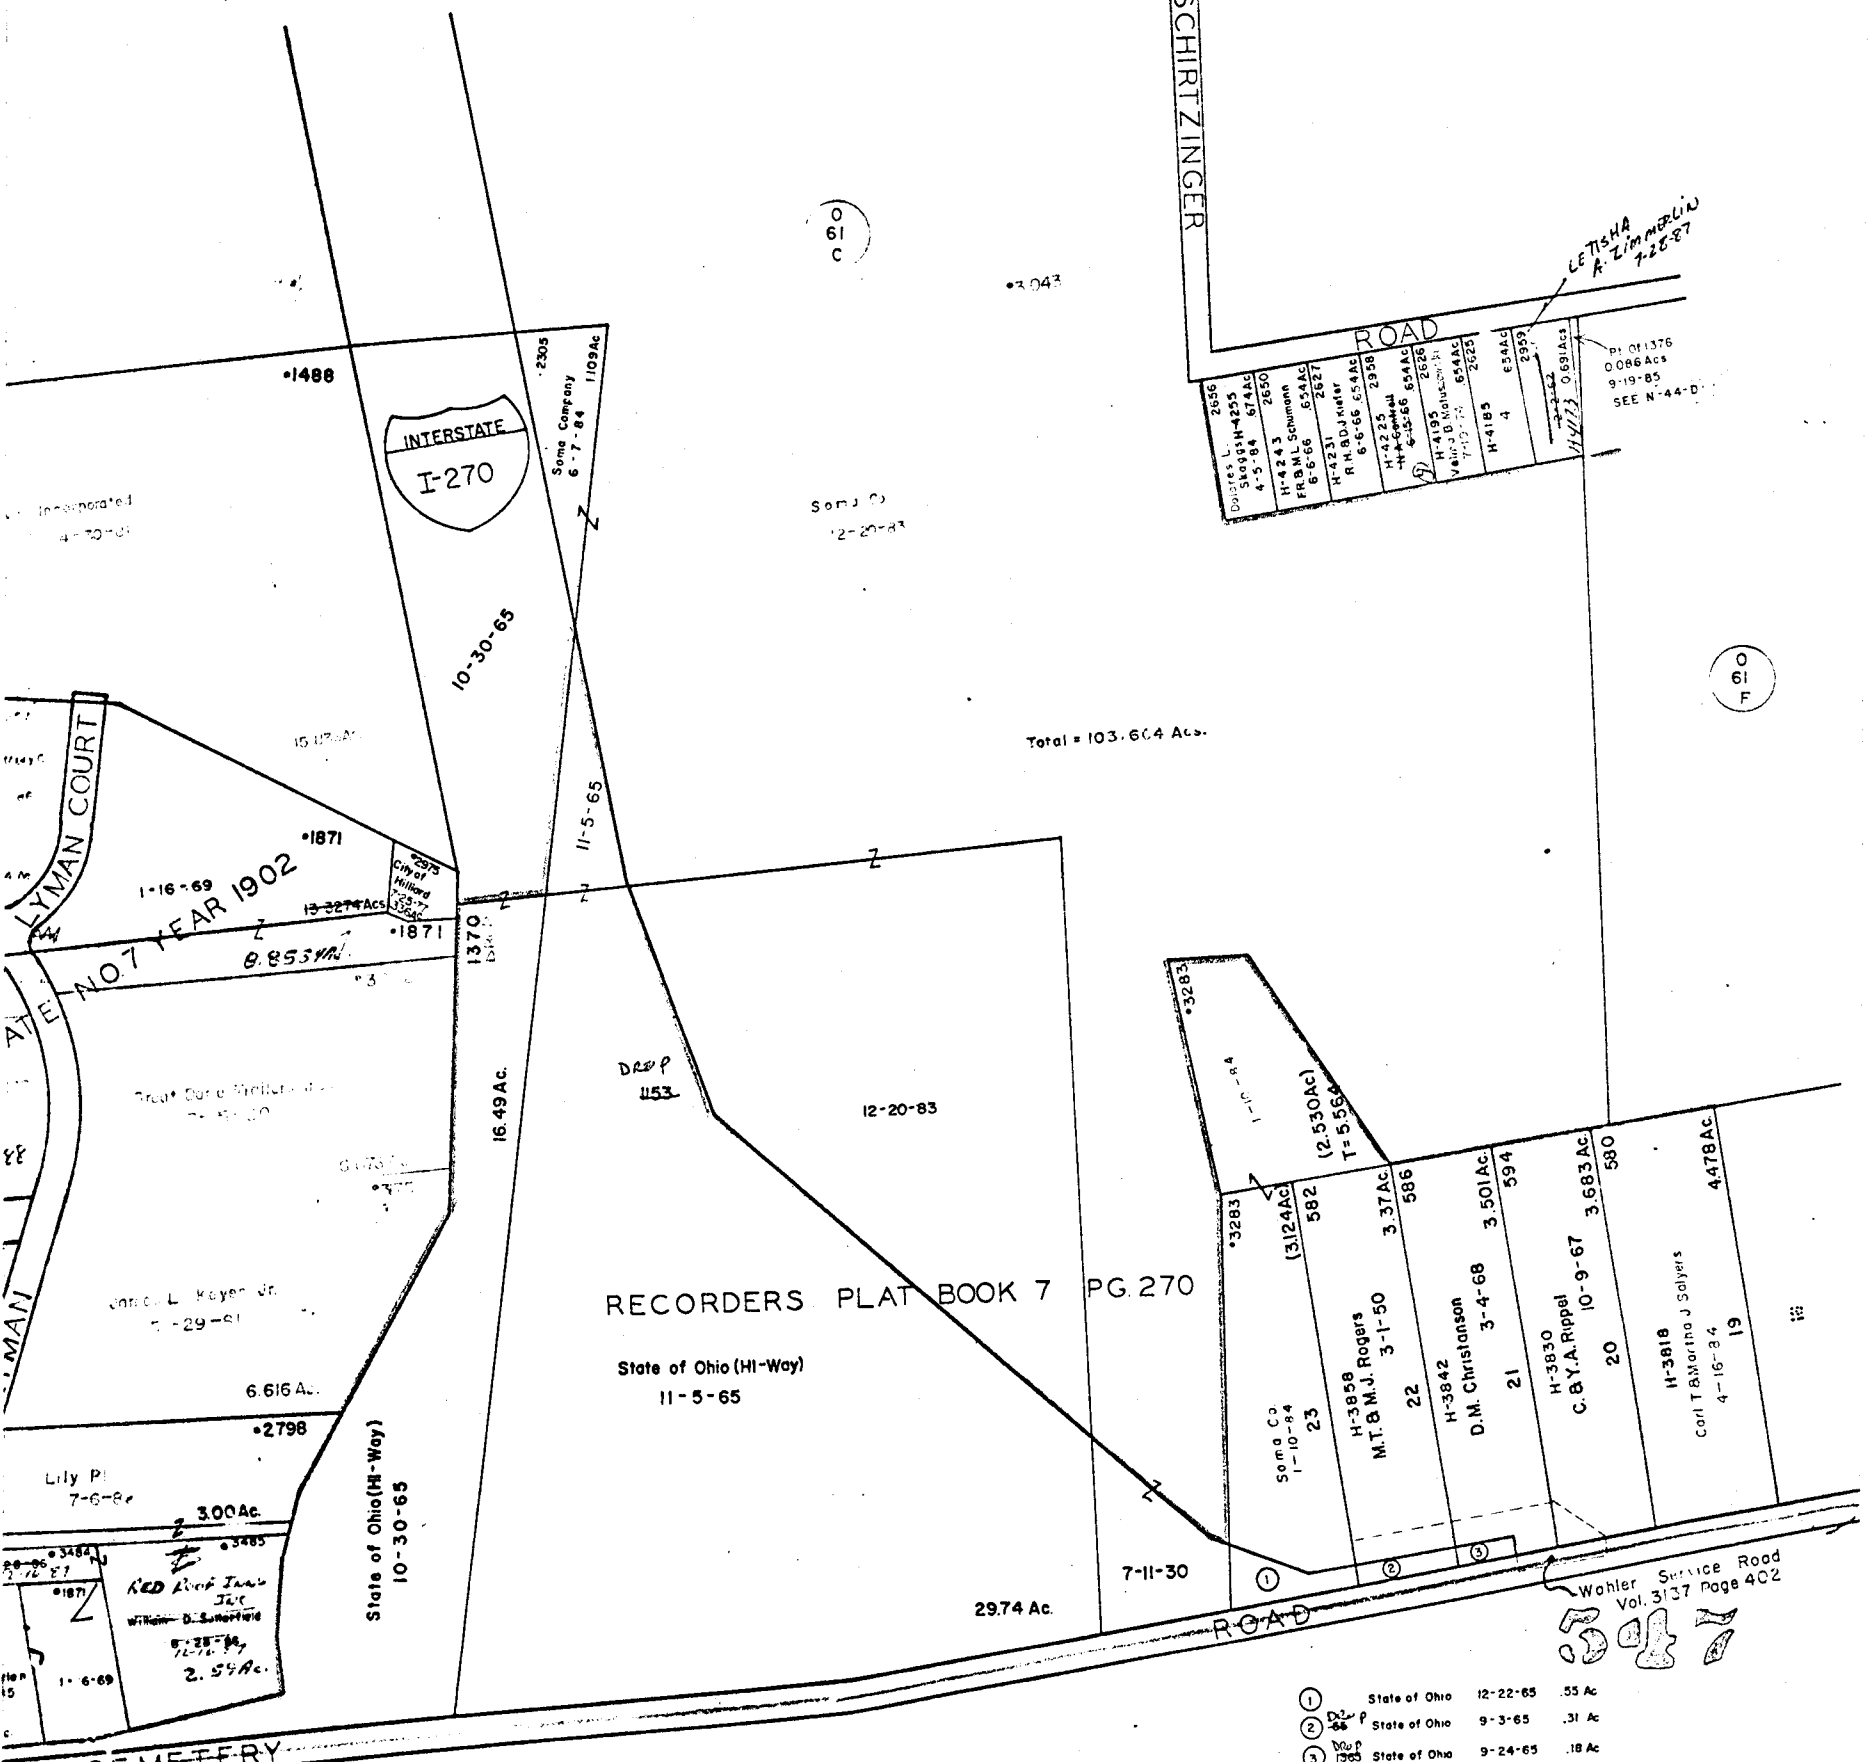

- ① State of Ohio 12-22-65 .55 Ac.
- ② D.E.P. State of Ohio 9-3-65 .31 Ac.
- ③ D.E.P. State of Ohio 9-24-65 .18 Ac.
- ④ 2625 Edward D. Diane C. Schirtzinger 2-27-85 0.534 Ac.
- ⑤ Vacation And Dedication Of Parts Of Lyman Drive
- ⑥ *3338 Marathon Petroleum Co. 12-24-85 0.0046 Ac.
- ⑦ *2280 Russell L. & W.J. Ferguson 4-14-86 0.102 Ac.
- ⑧ *3571 Leland H. Weare L.E. 11-17-86 1.814 Ac.
- ⑨ 2454 DAVID + BETH A. HOLZER 6-14-87 .654 Ac.
- ⑩ DEPT. CITY OF HILLIARD (HI-WAY) 10-15-87 0.184 Ac.
- ⑪ DEPT. CITY OF HILLIARD (HI-WAY) 10-15-87 0.455 Ac.
- ⑫ DEPT. CITY OF HILLIARD (HI-WAY) 10-15-87 0.256 Ac.
- ⑬ DEPT. CITY OF HILLIARD (HI-WAY) 10-15-87 0.156 Ac.
- ⑭ DEPT. CITY OF HILLIARD (HI-WAY) 11-3-87 0.142 Ac.
- ⑮ DEPT. CITY OF HILLIARD (HI-WAY) 11-3-87 0.142 Ac.