


0-63-B
NORWICH TWP.

SCALE 1" = 200'
V.M.S.

TAXING DISTRICT	DISTRICT CODE
NORWICH TWP.	200
COLS-HILLIARD S.D.	560
HILLIARD	050

FRANKLIN COUNTY SURVEY MONUMENT
H---HOUSE NUMBERS

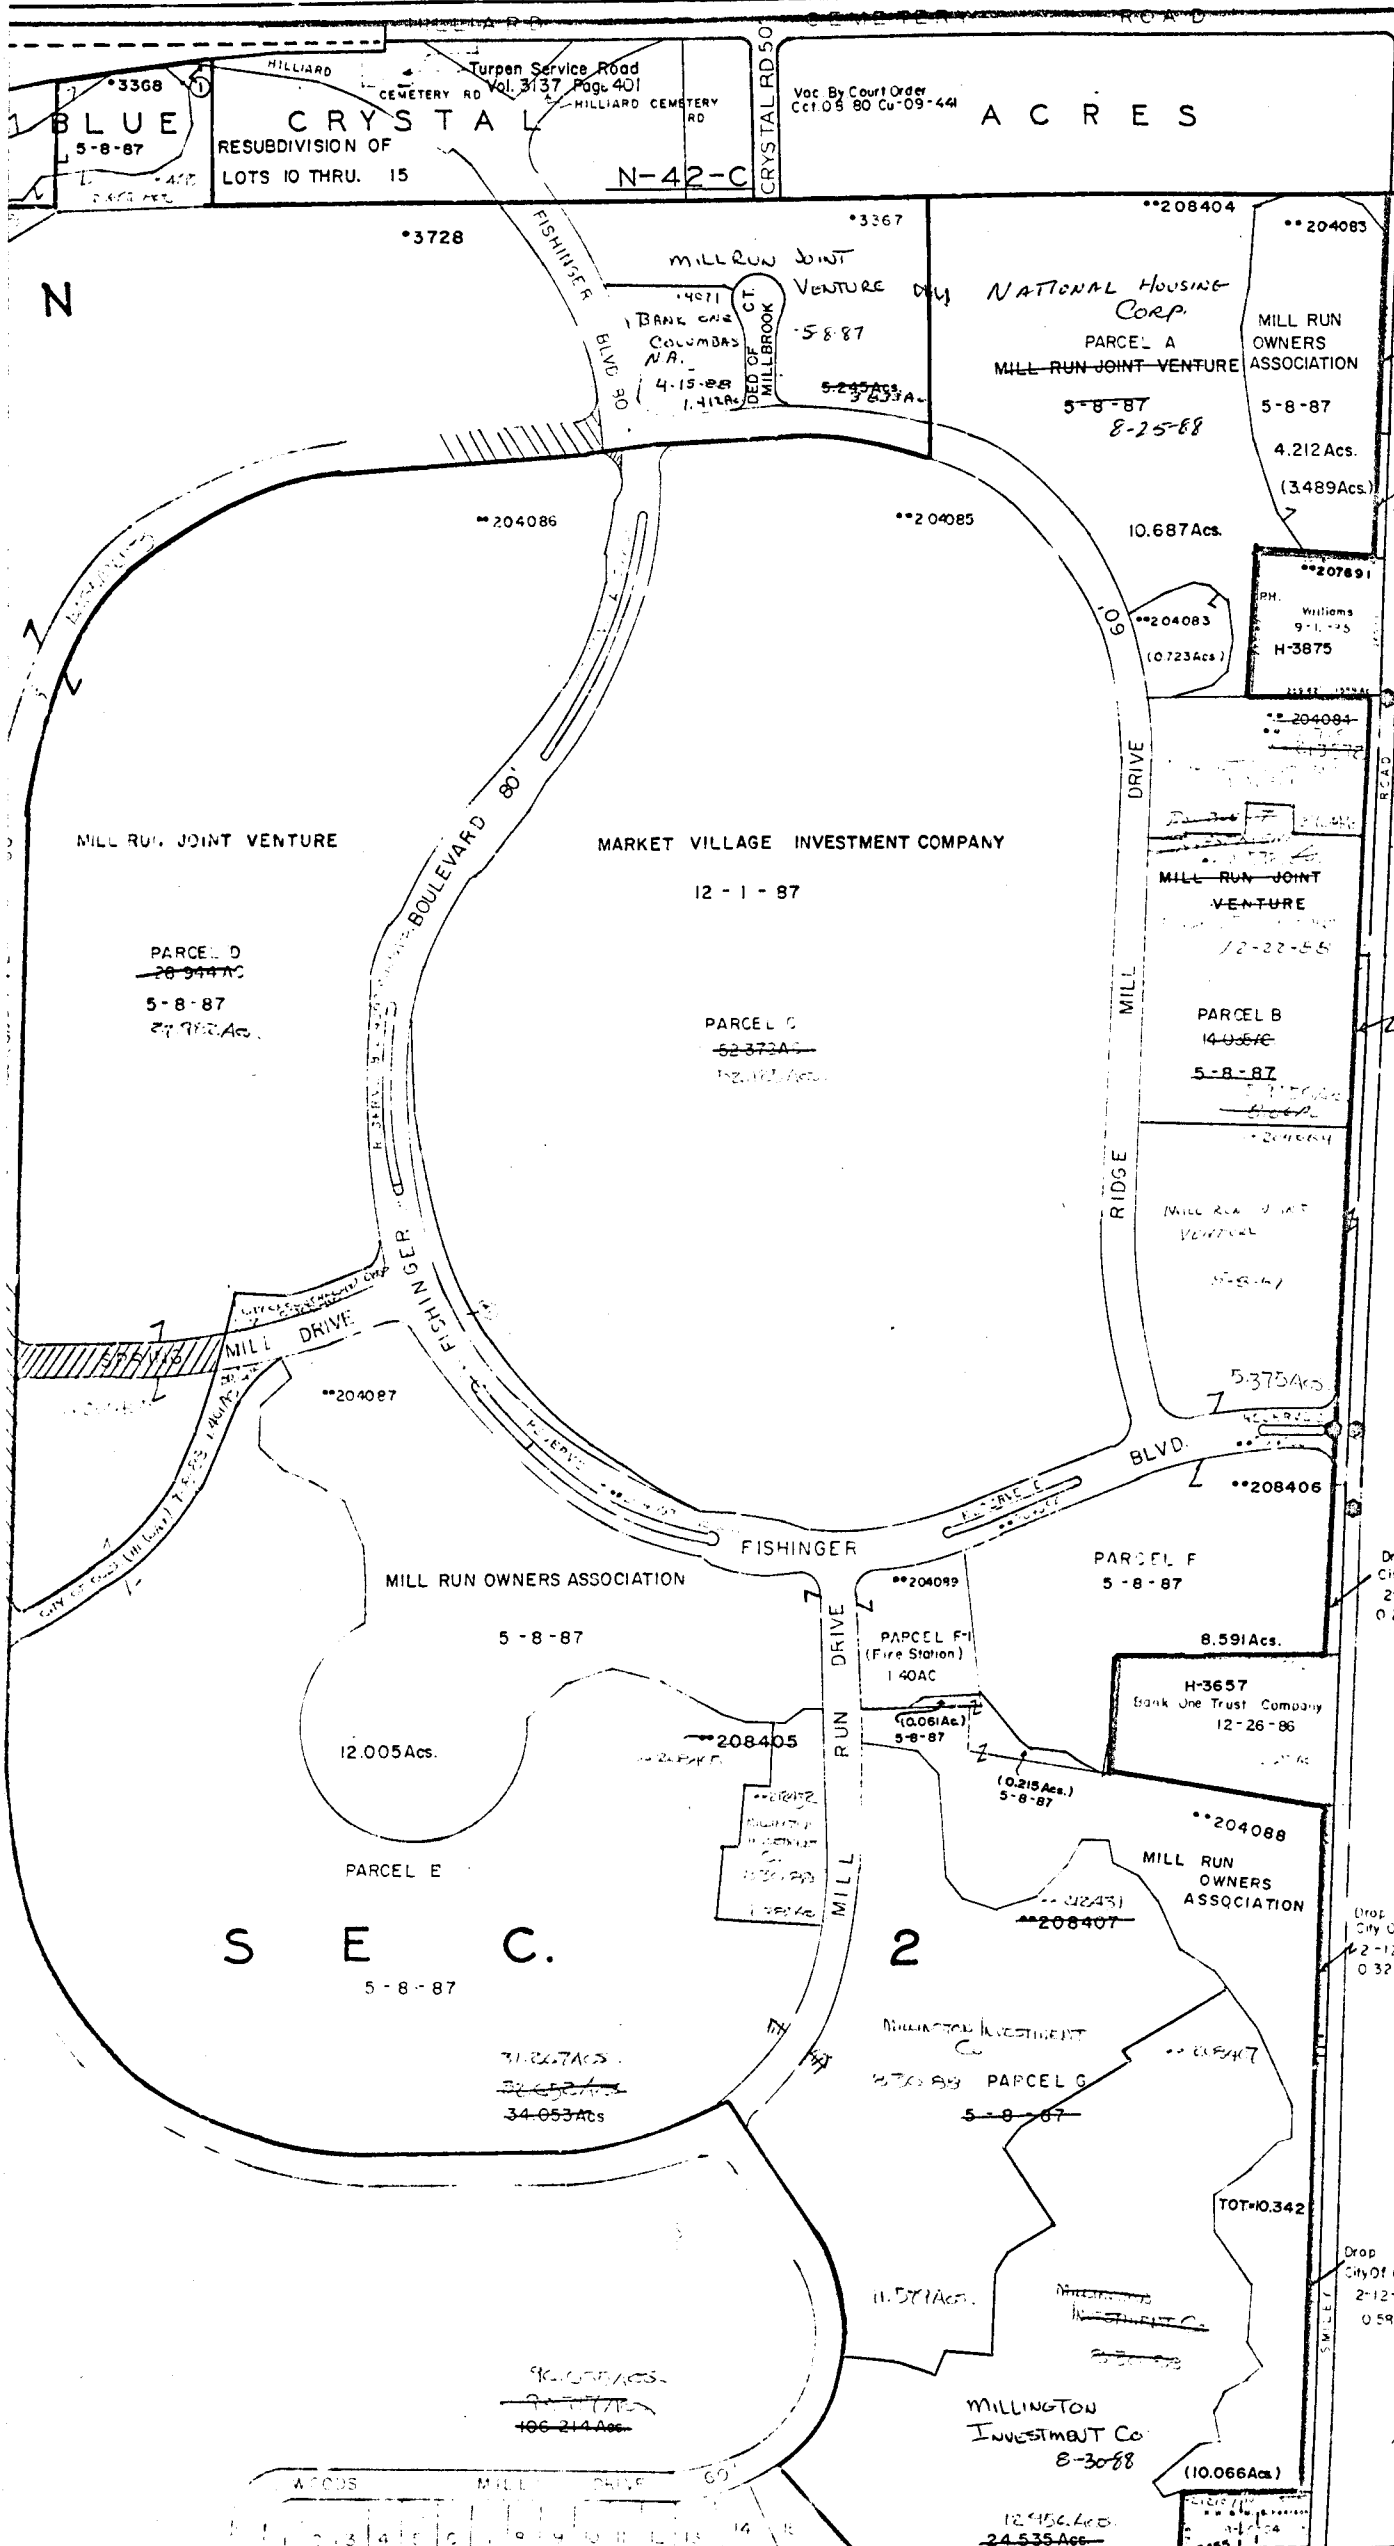

SEE LEFT PAGE MAP FOR DETAIL OF LOTS 1 THRU 5

547