

- 1-\*\*\*\*3758 Roger L. & Paula D. White 10-18-75 0.0676
- 2-\*\*\*\*1196 Leroy E. & Louise Johnson 8-2-77 0.159 Ac.
- 3-\*\*\*\*2031 J. H. DeWitt & S. V. Z... 7-1-77 0.4217
- 4-\*\*\*\*2028 Patricia D. Nye 11-23-77 04.24
- 5-\*\*\*\*1106 STANLEY A. MALATESTA 12-7-88 0.549 Ac.

0-68-D

PERRY TWP  
R.19 TWP.2




SCALE 1"=100'  
E=HIGHWAY EASEMENT  
TAXING DISTRICTS DIST. HOTO. CO. 070  
CITY OF UPPER ARLINGTON

H = HOUSE NUMBERS

N  
232  
E

0  
67  
B

DPICL B  
MUTUAL INVESTMENT (S) MARY E HORNE & 9-26-84  
EDNA M. Young

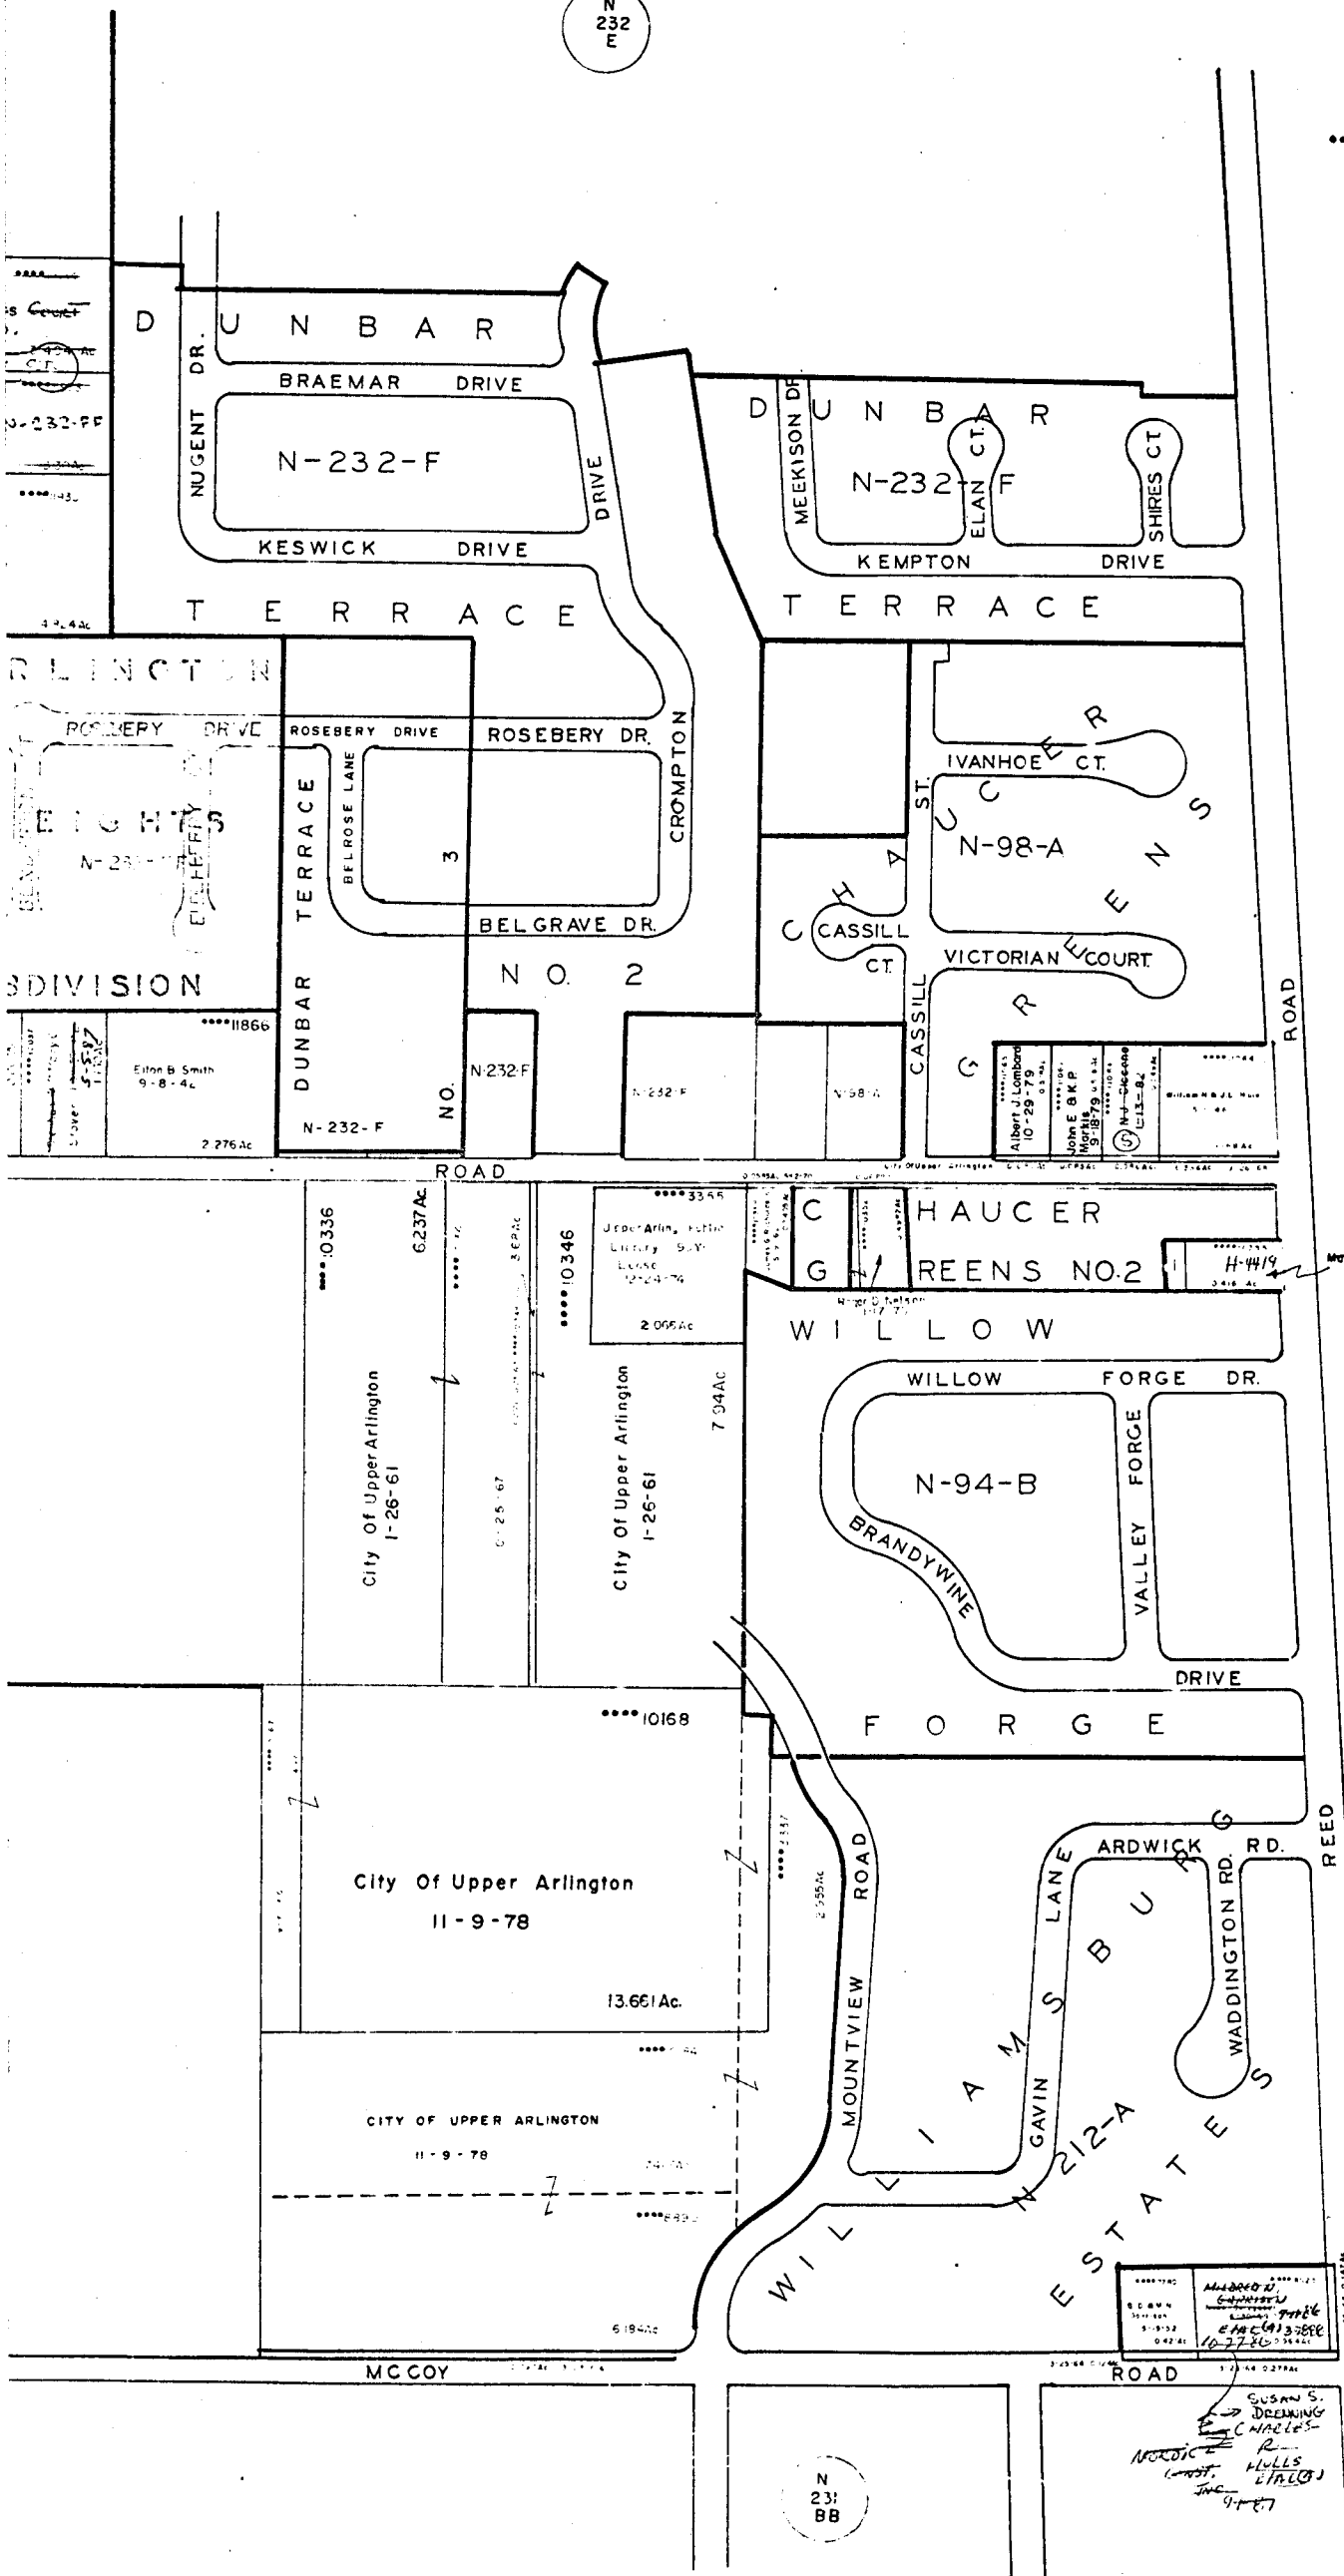

N  
231  
BB

0-68-D