



DELAWARE

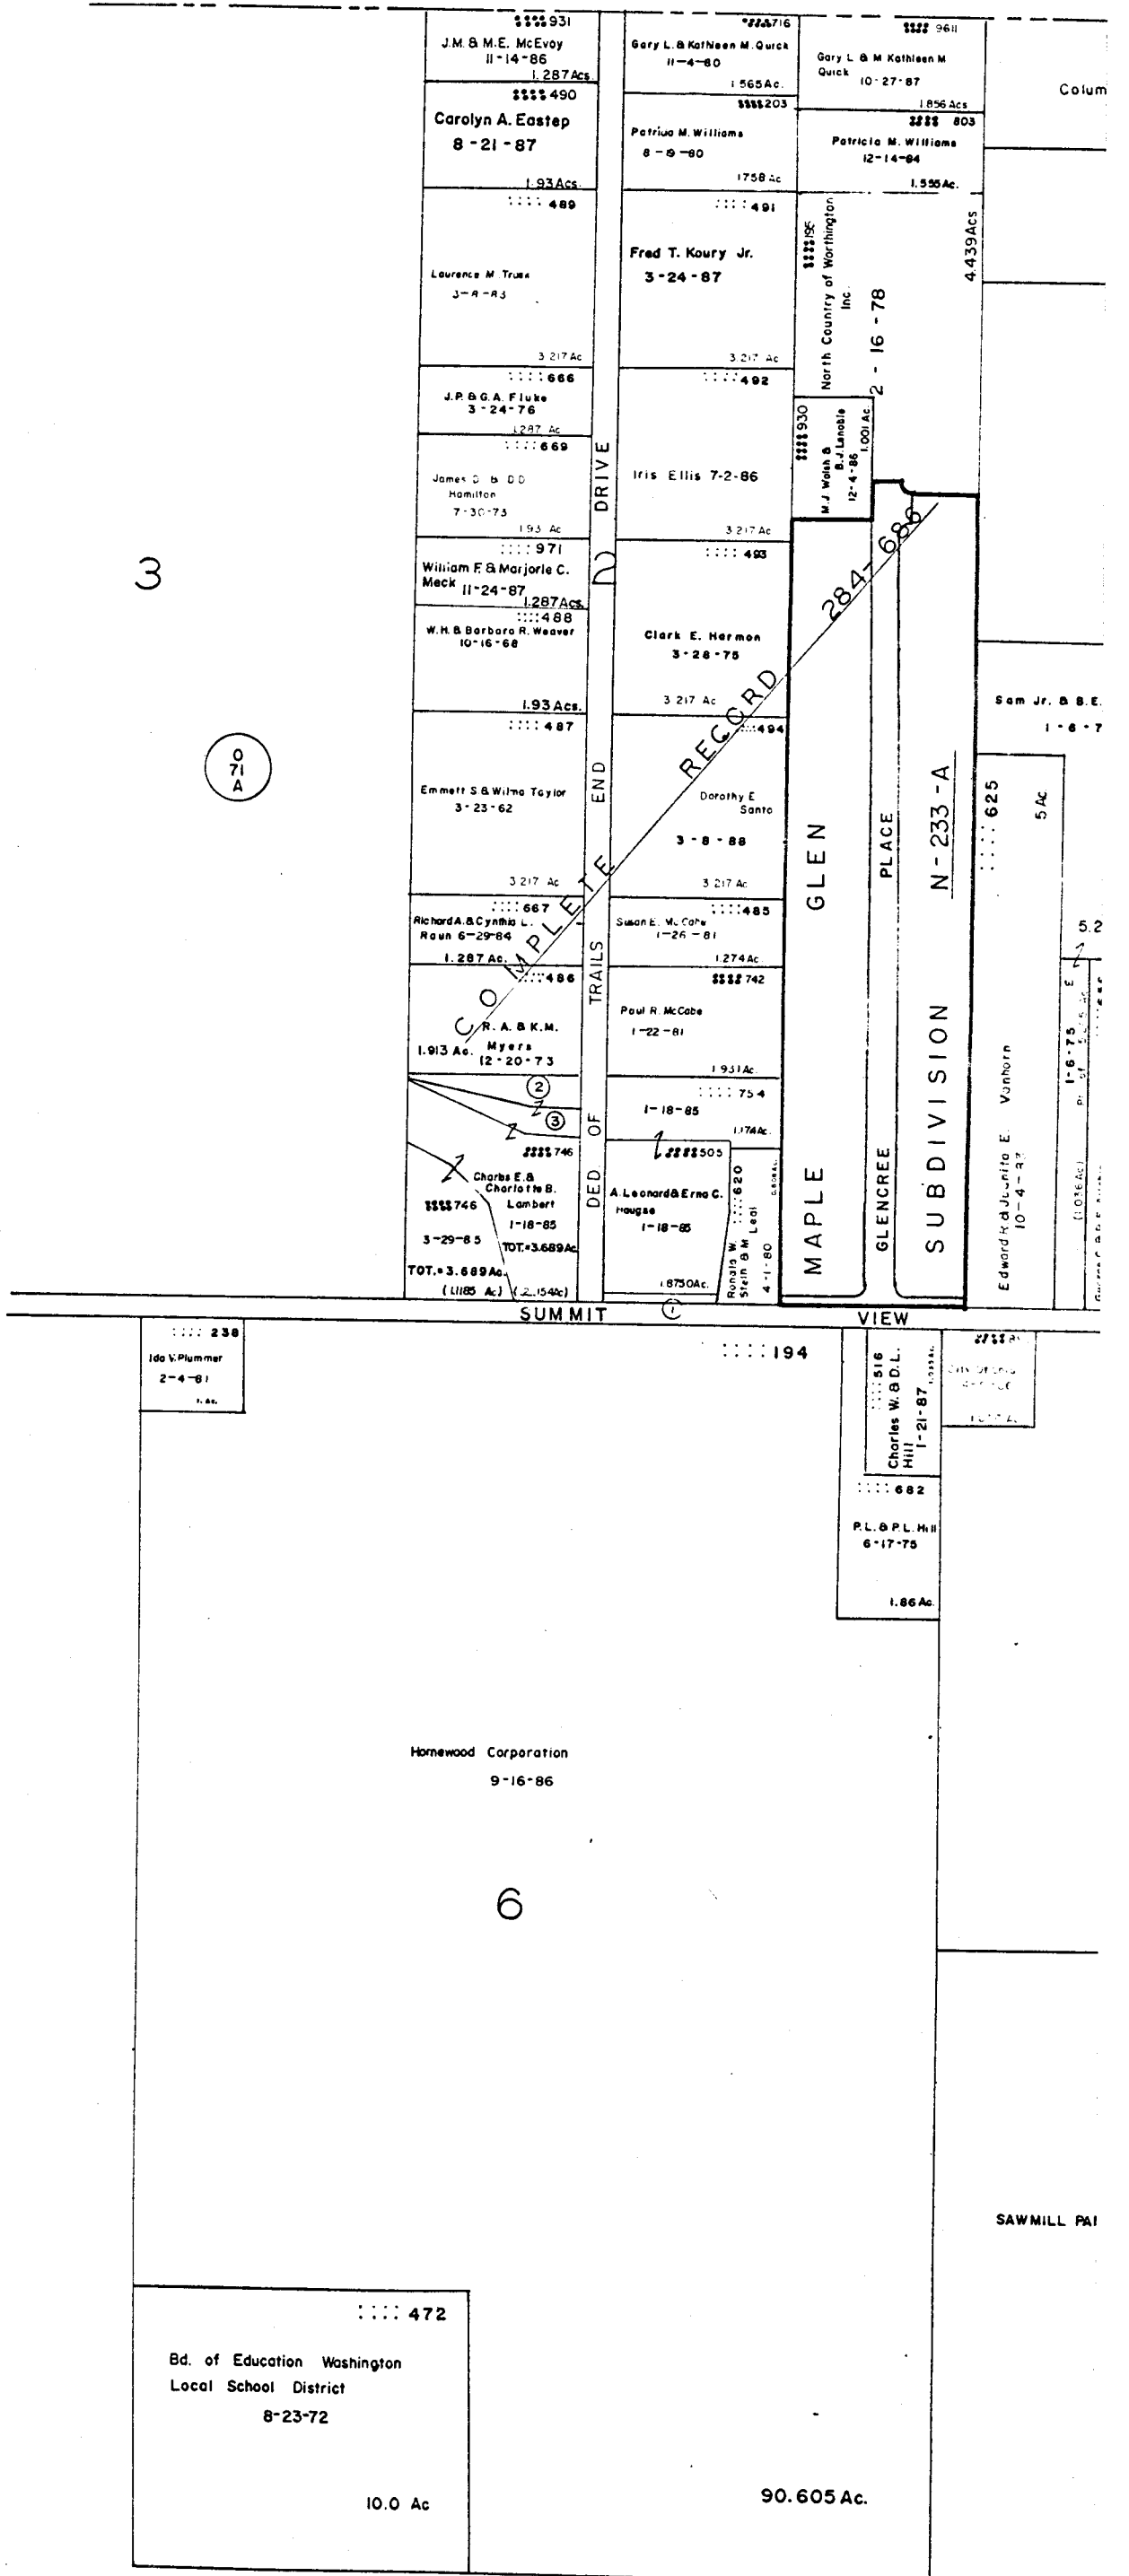

C O U N T Y

0-71-B

PERRY TWP
R. 19 TWP 2

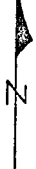


SCALE 1" = 200'

E = HIGHWAY EASEMENT
TAXING DISTRICTS DISTRICTS CODE

PERY-LUBLIN CORP. 215

FRANKLIN COUNTY SURVEY MONUMENTS

H---HOUSE NUMBERS

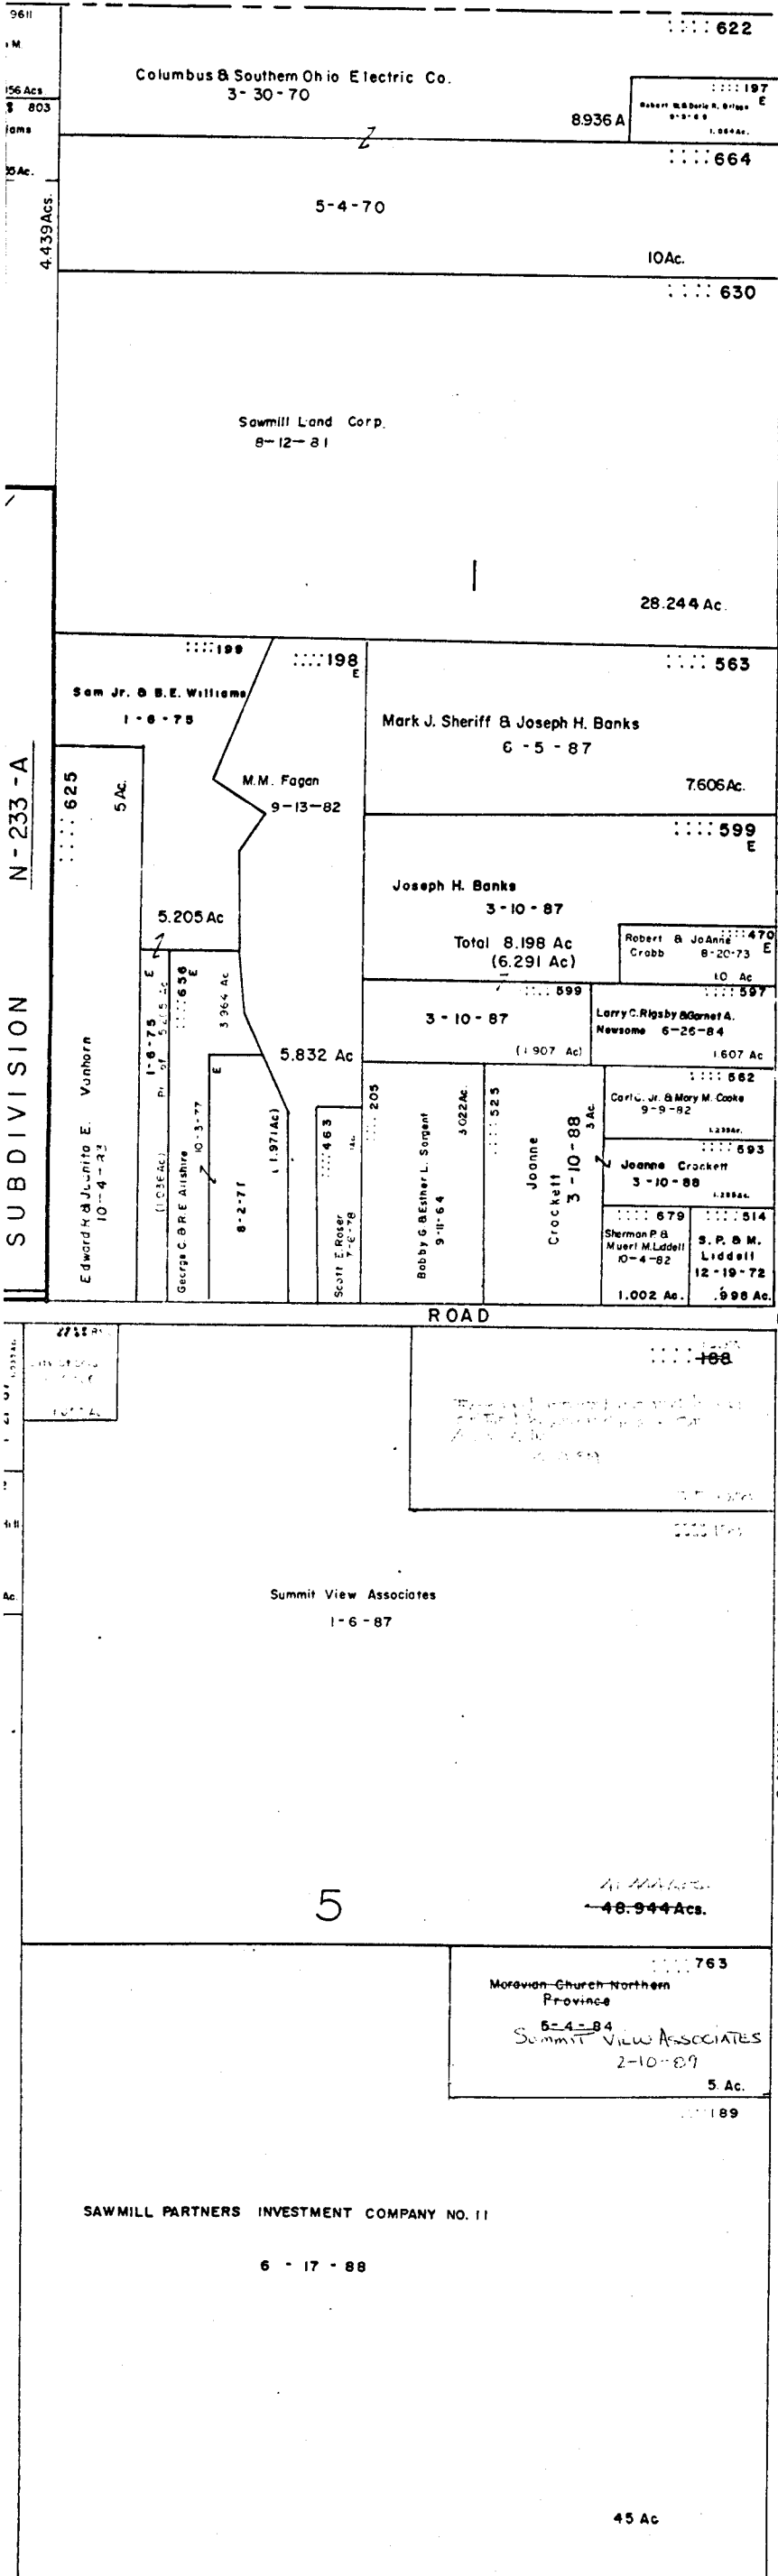

0
72

0
72

1-Drop Village Of Dublin (Hi-way) 4-27-82 0.231 Ac.

2-998 Charles E. & Charlotte B. Lambert 12-13-88 0.416 Ac.

PT. OF 746 Charles E. & Charlotte B. Lambert 2-6-87 (0.416 Ac.)

0-71-B

