


0
2
B

0
2
D

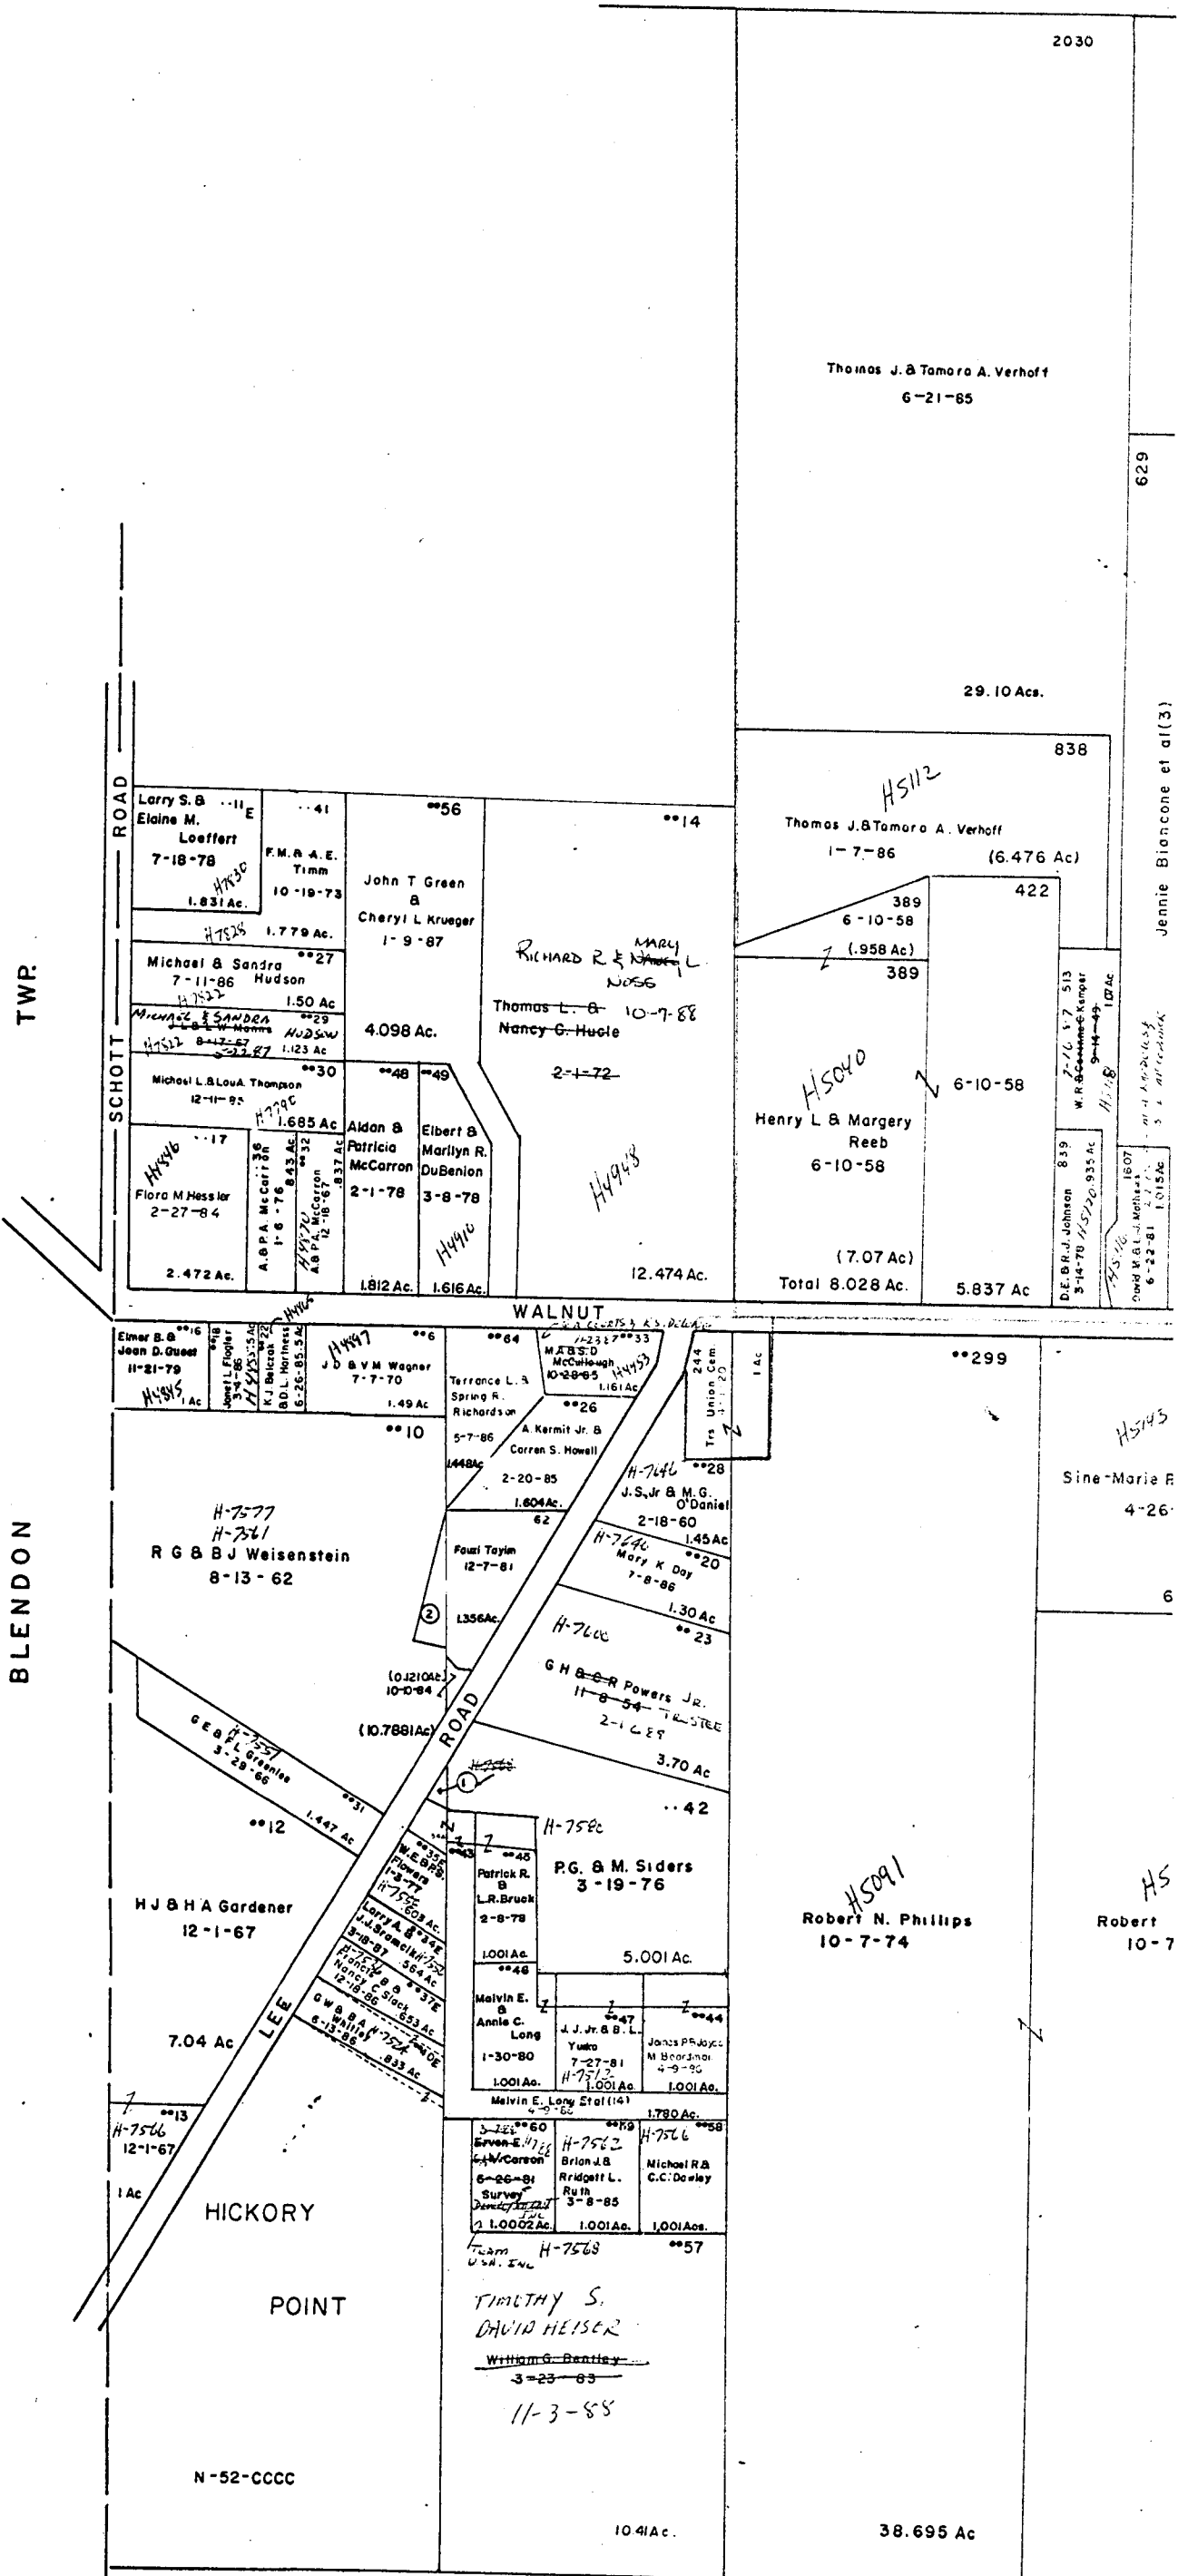

TWP.


BLENDON

SCHOTT ROAD

WALNUT ROAD


HICKORY POINT

Jennie Biancone et al(3)

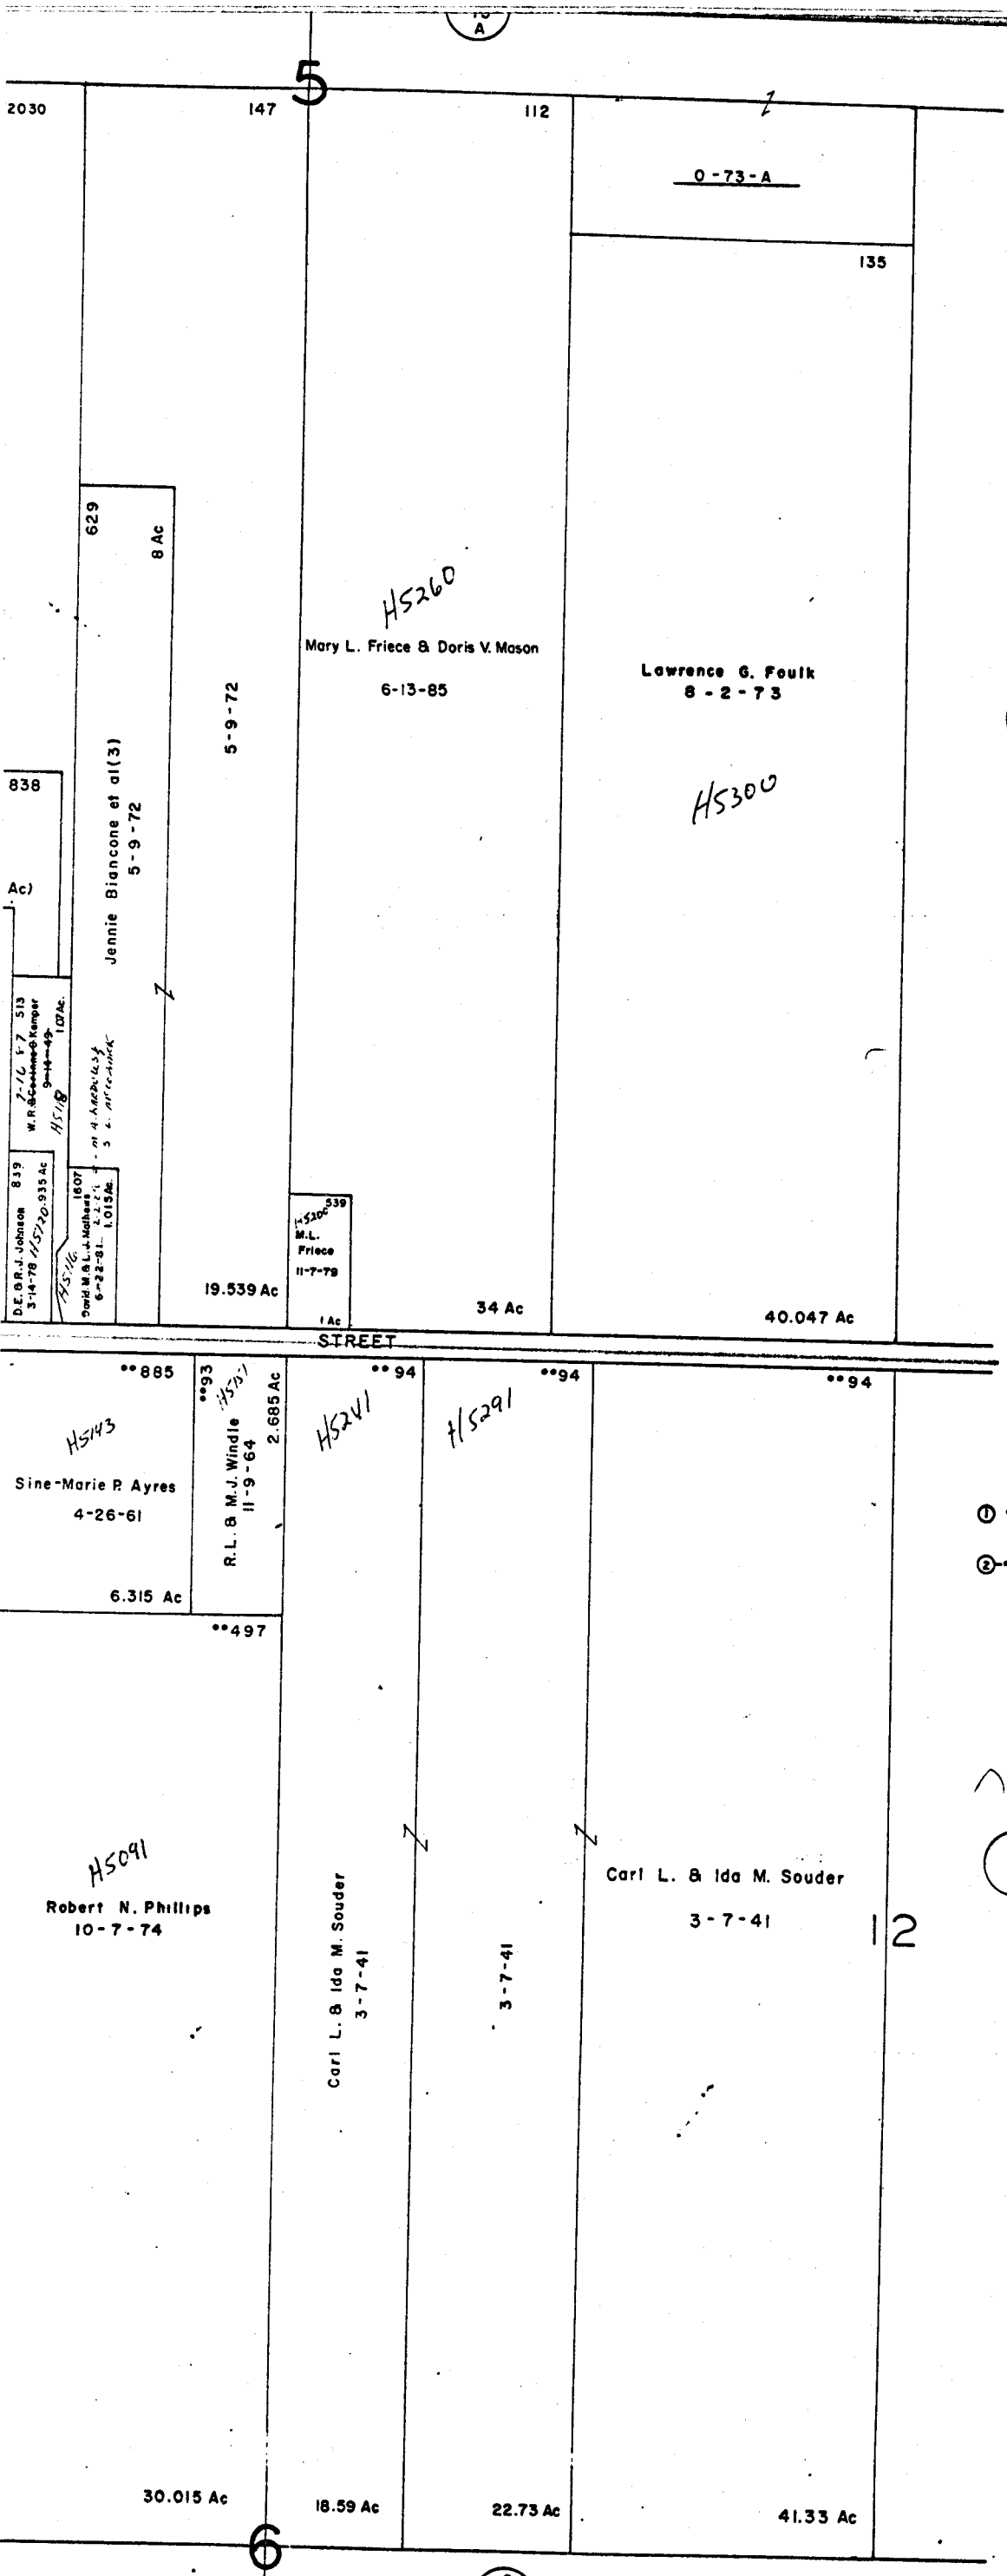

0-73-D

PLAIN TWP.
R.16 TWP.2

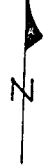

SCALE 1" = 200'
E=HIGHWAY EASEMENT
TAXING DISTRICTS DISTRICT CODE
PLAIN TWP 220
**PLAIN-WESTERVILLE S.D. 221

H---HOUSE NUMBERS

0
73
E

- ① **8 Erven E. & Darleen M. Carson 8-8-66 0.2998 Ac.
- ② **63 Fouzi A. & Clelissa M. Toyin 10-10-84 0.2159 Ac.

0
73
E

0-73-D 1060

0
73
E