



O-74-H
PLAIN TWP.
R16 TWP.2

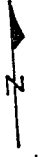

SCALE 1"=200'
E=HIGHWAY EASEMENT
TAXING DISTRICTS, DISTRICT CODE
PLAIN TWP 220

FRANKLIN COUNTY SURVEY MONUMENT

H--- HOUSE NUMBER

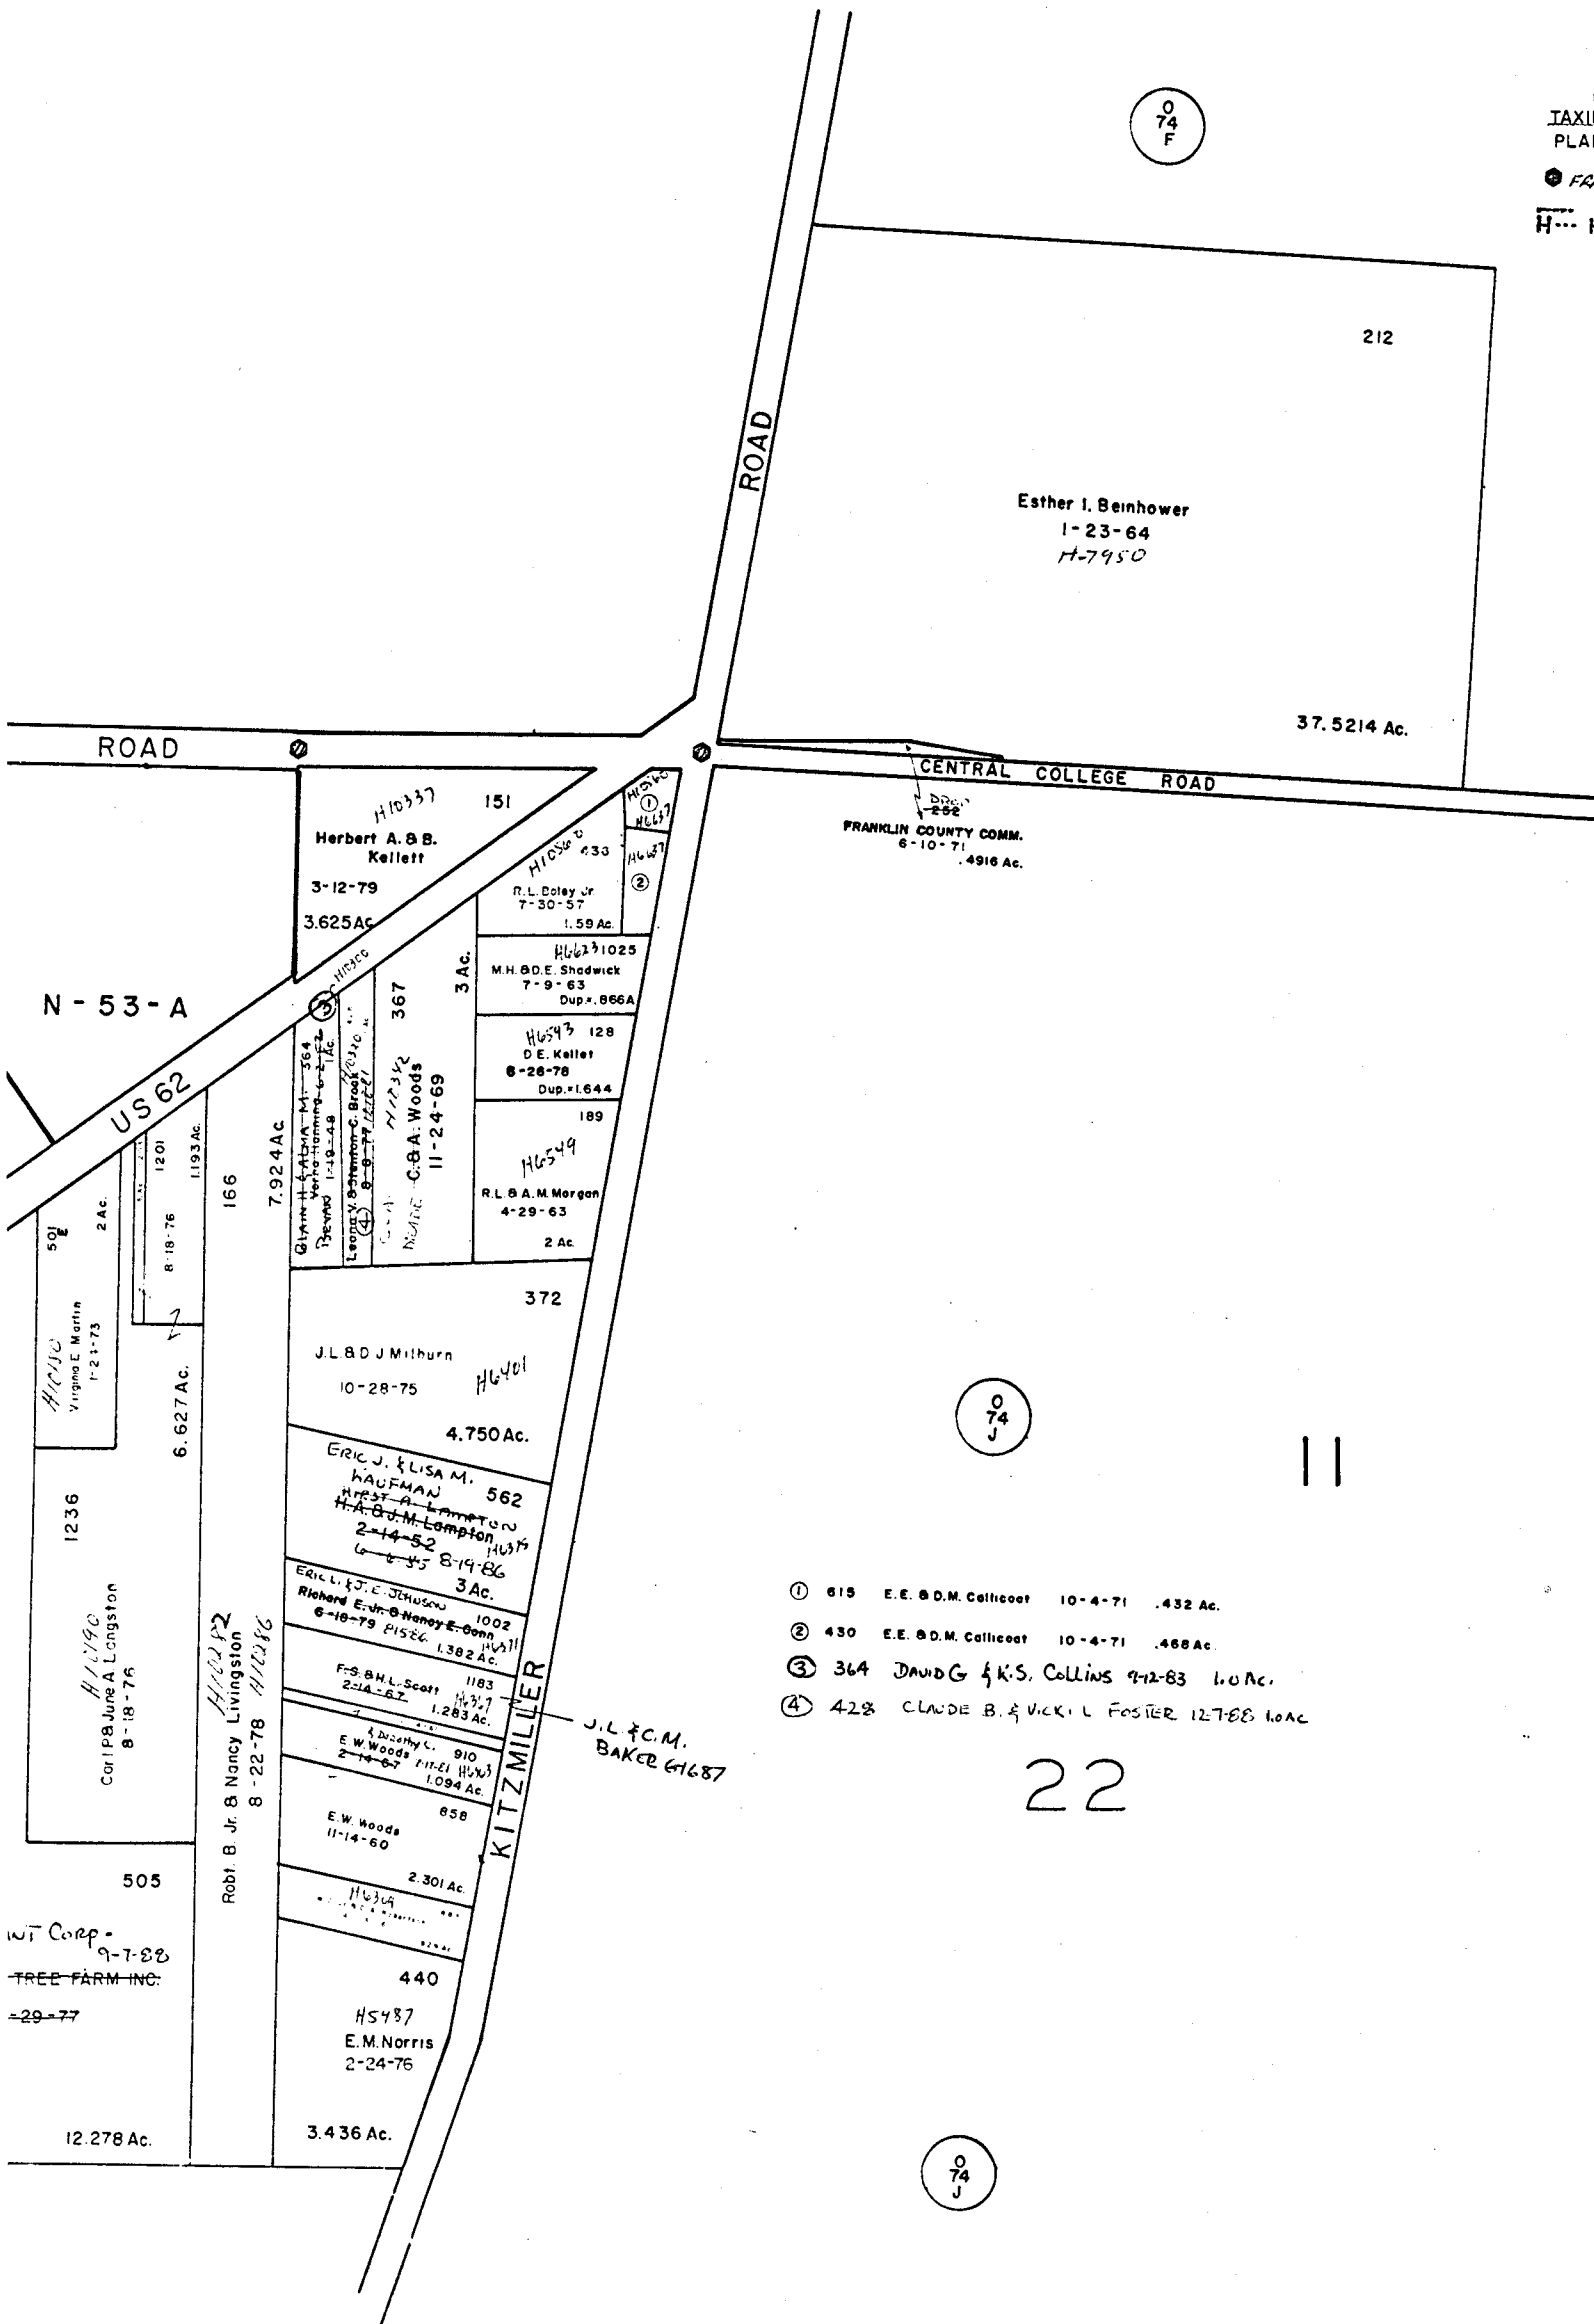

- ① 615 E.E. & D.M. Collicott 10-4-71 .432 Ac.
- ② 430 E.E. & D.M. Collicott 10-4-71 .468 Ac.
- ③ 364 DAVID G. & K.S. COLLINS 9-12-83 1.0 Ac.
- ④ 428 CLAUDE B. & VICKI L. FOSTER 12-7-88 1.0 AC

22