

0
75
E

O-75-H


PLAIN TWP
R.16 TWP. 2



SCALE 1"=200'
E=HIGHWAY EASEMENT
TAXING DISTRICTS DISTRICT CODE
PLAIN TWP 220
COLS.-PLAIN S.D. 545
H--- HOUSE NUMBERS
FRANKLIN COUNTY SURVEY MONUMENT

and Tracking Inc.
ALBANY COMPANY
12-31-86
12-27-89

0
75
J

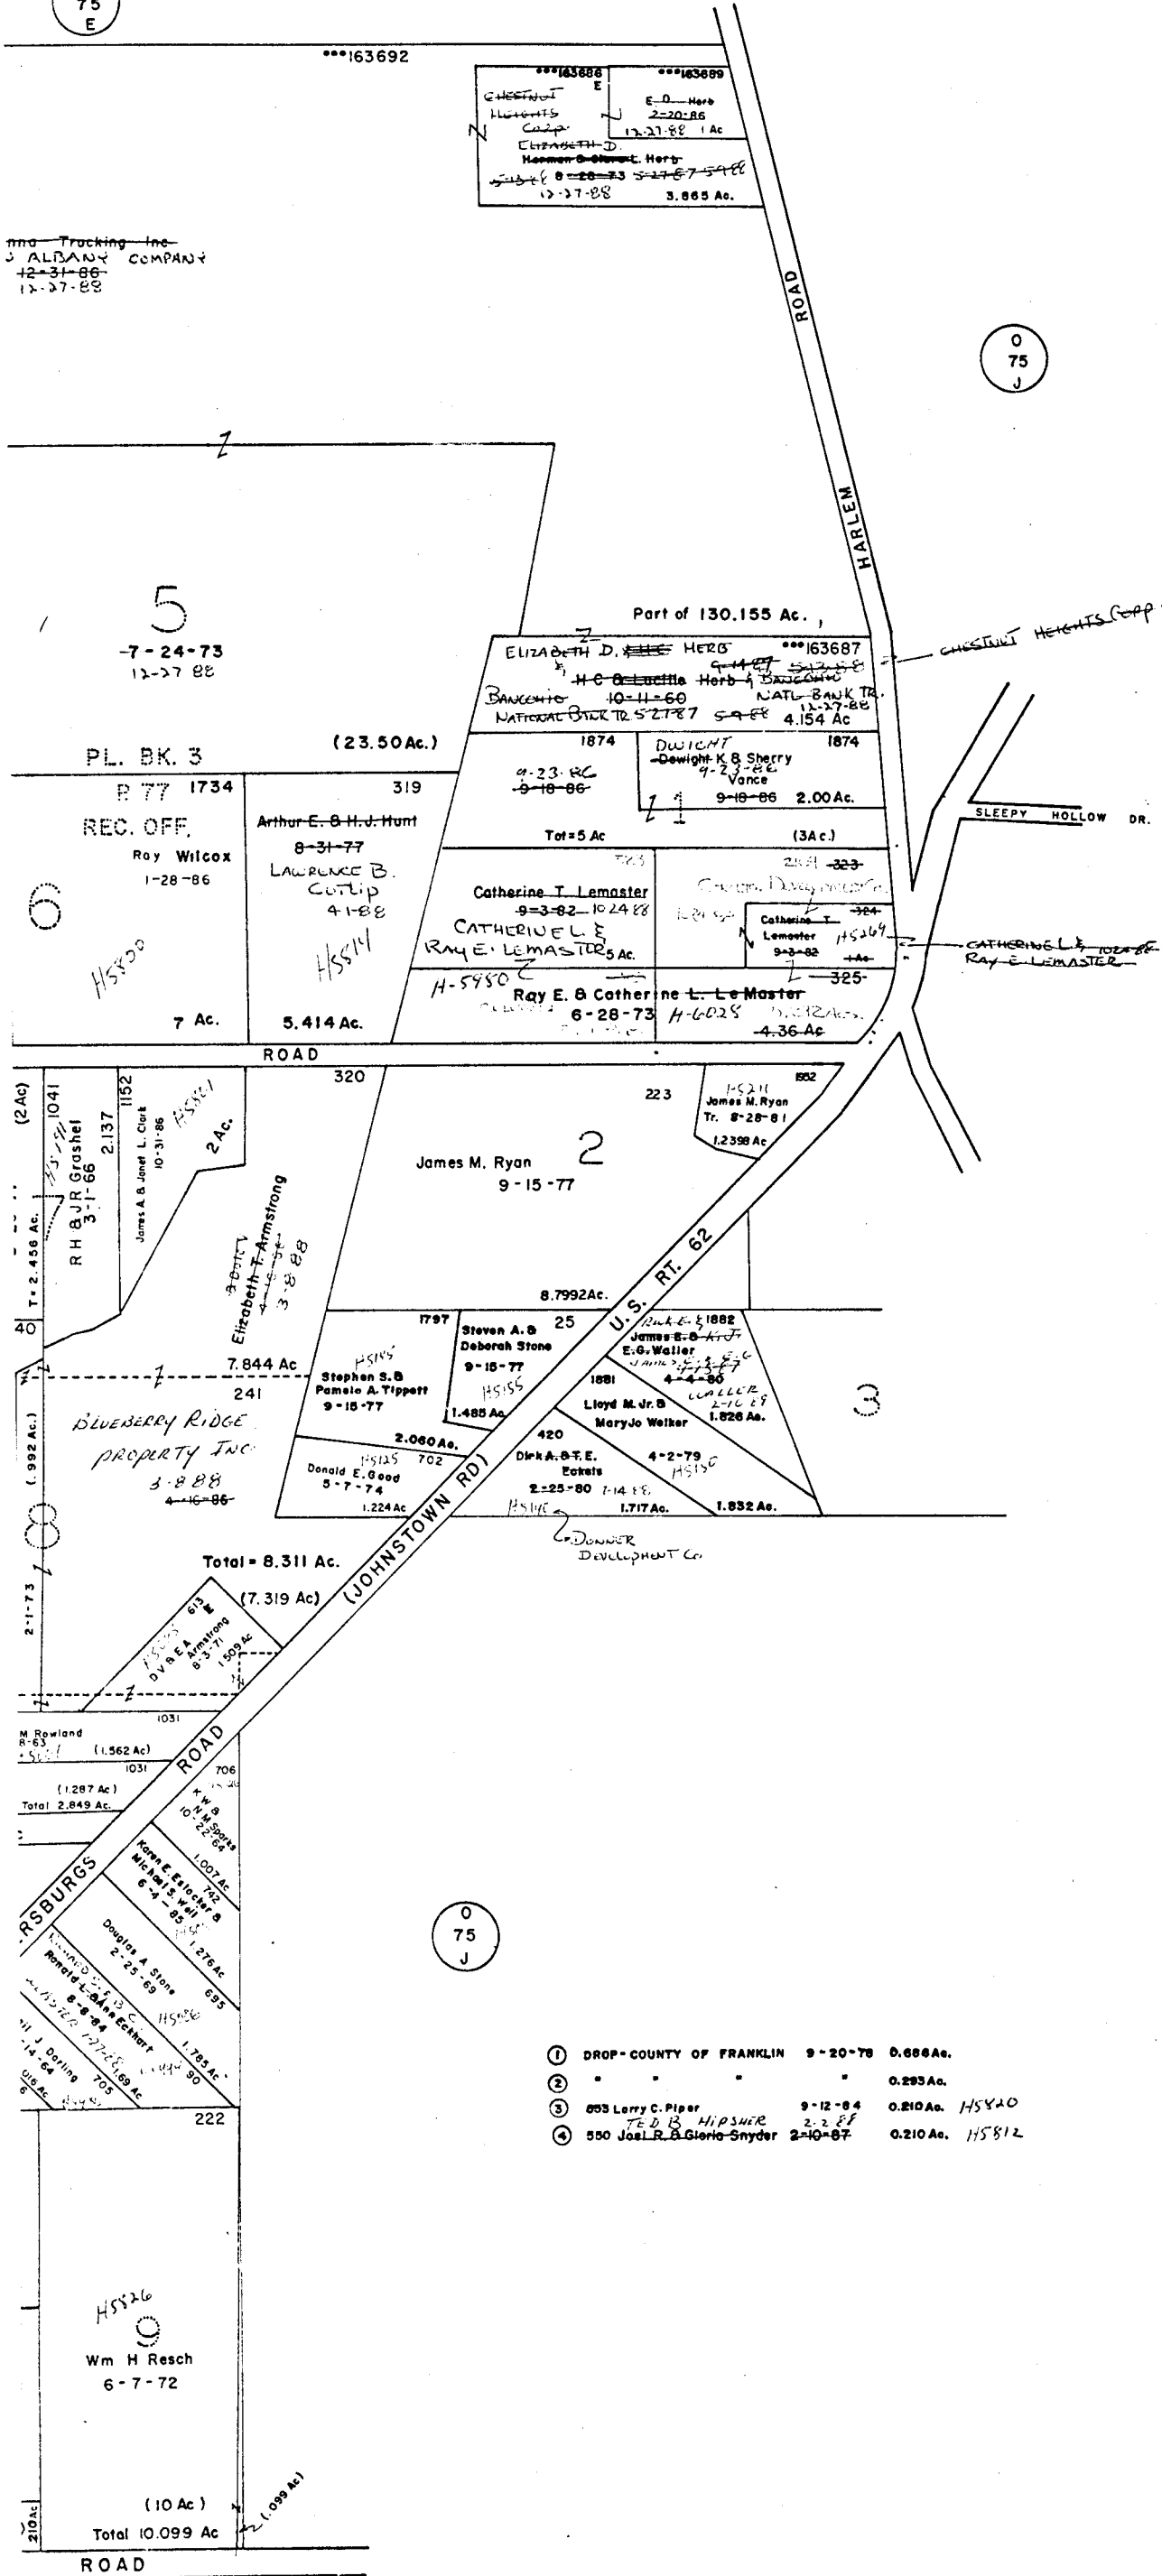

- ① DROP-COUNTY OF FRANKLIN 9-20-78 0.686Ac.
- ② " " " " 0.293Ac.
- ③ 853 Lerry C. Piper 9-12-84 0.210Ac. H5840
- ④ 550 Joes. R. & Gloria Snyder 2-10-87 0.210Ac. H5812