


0  
73  
C

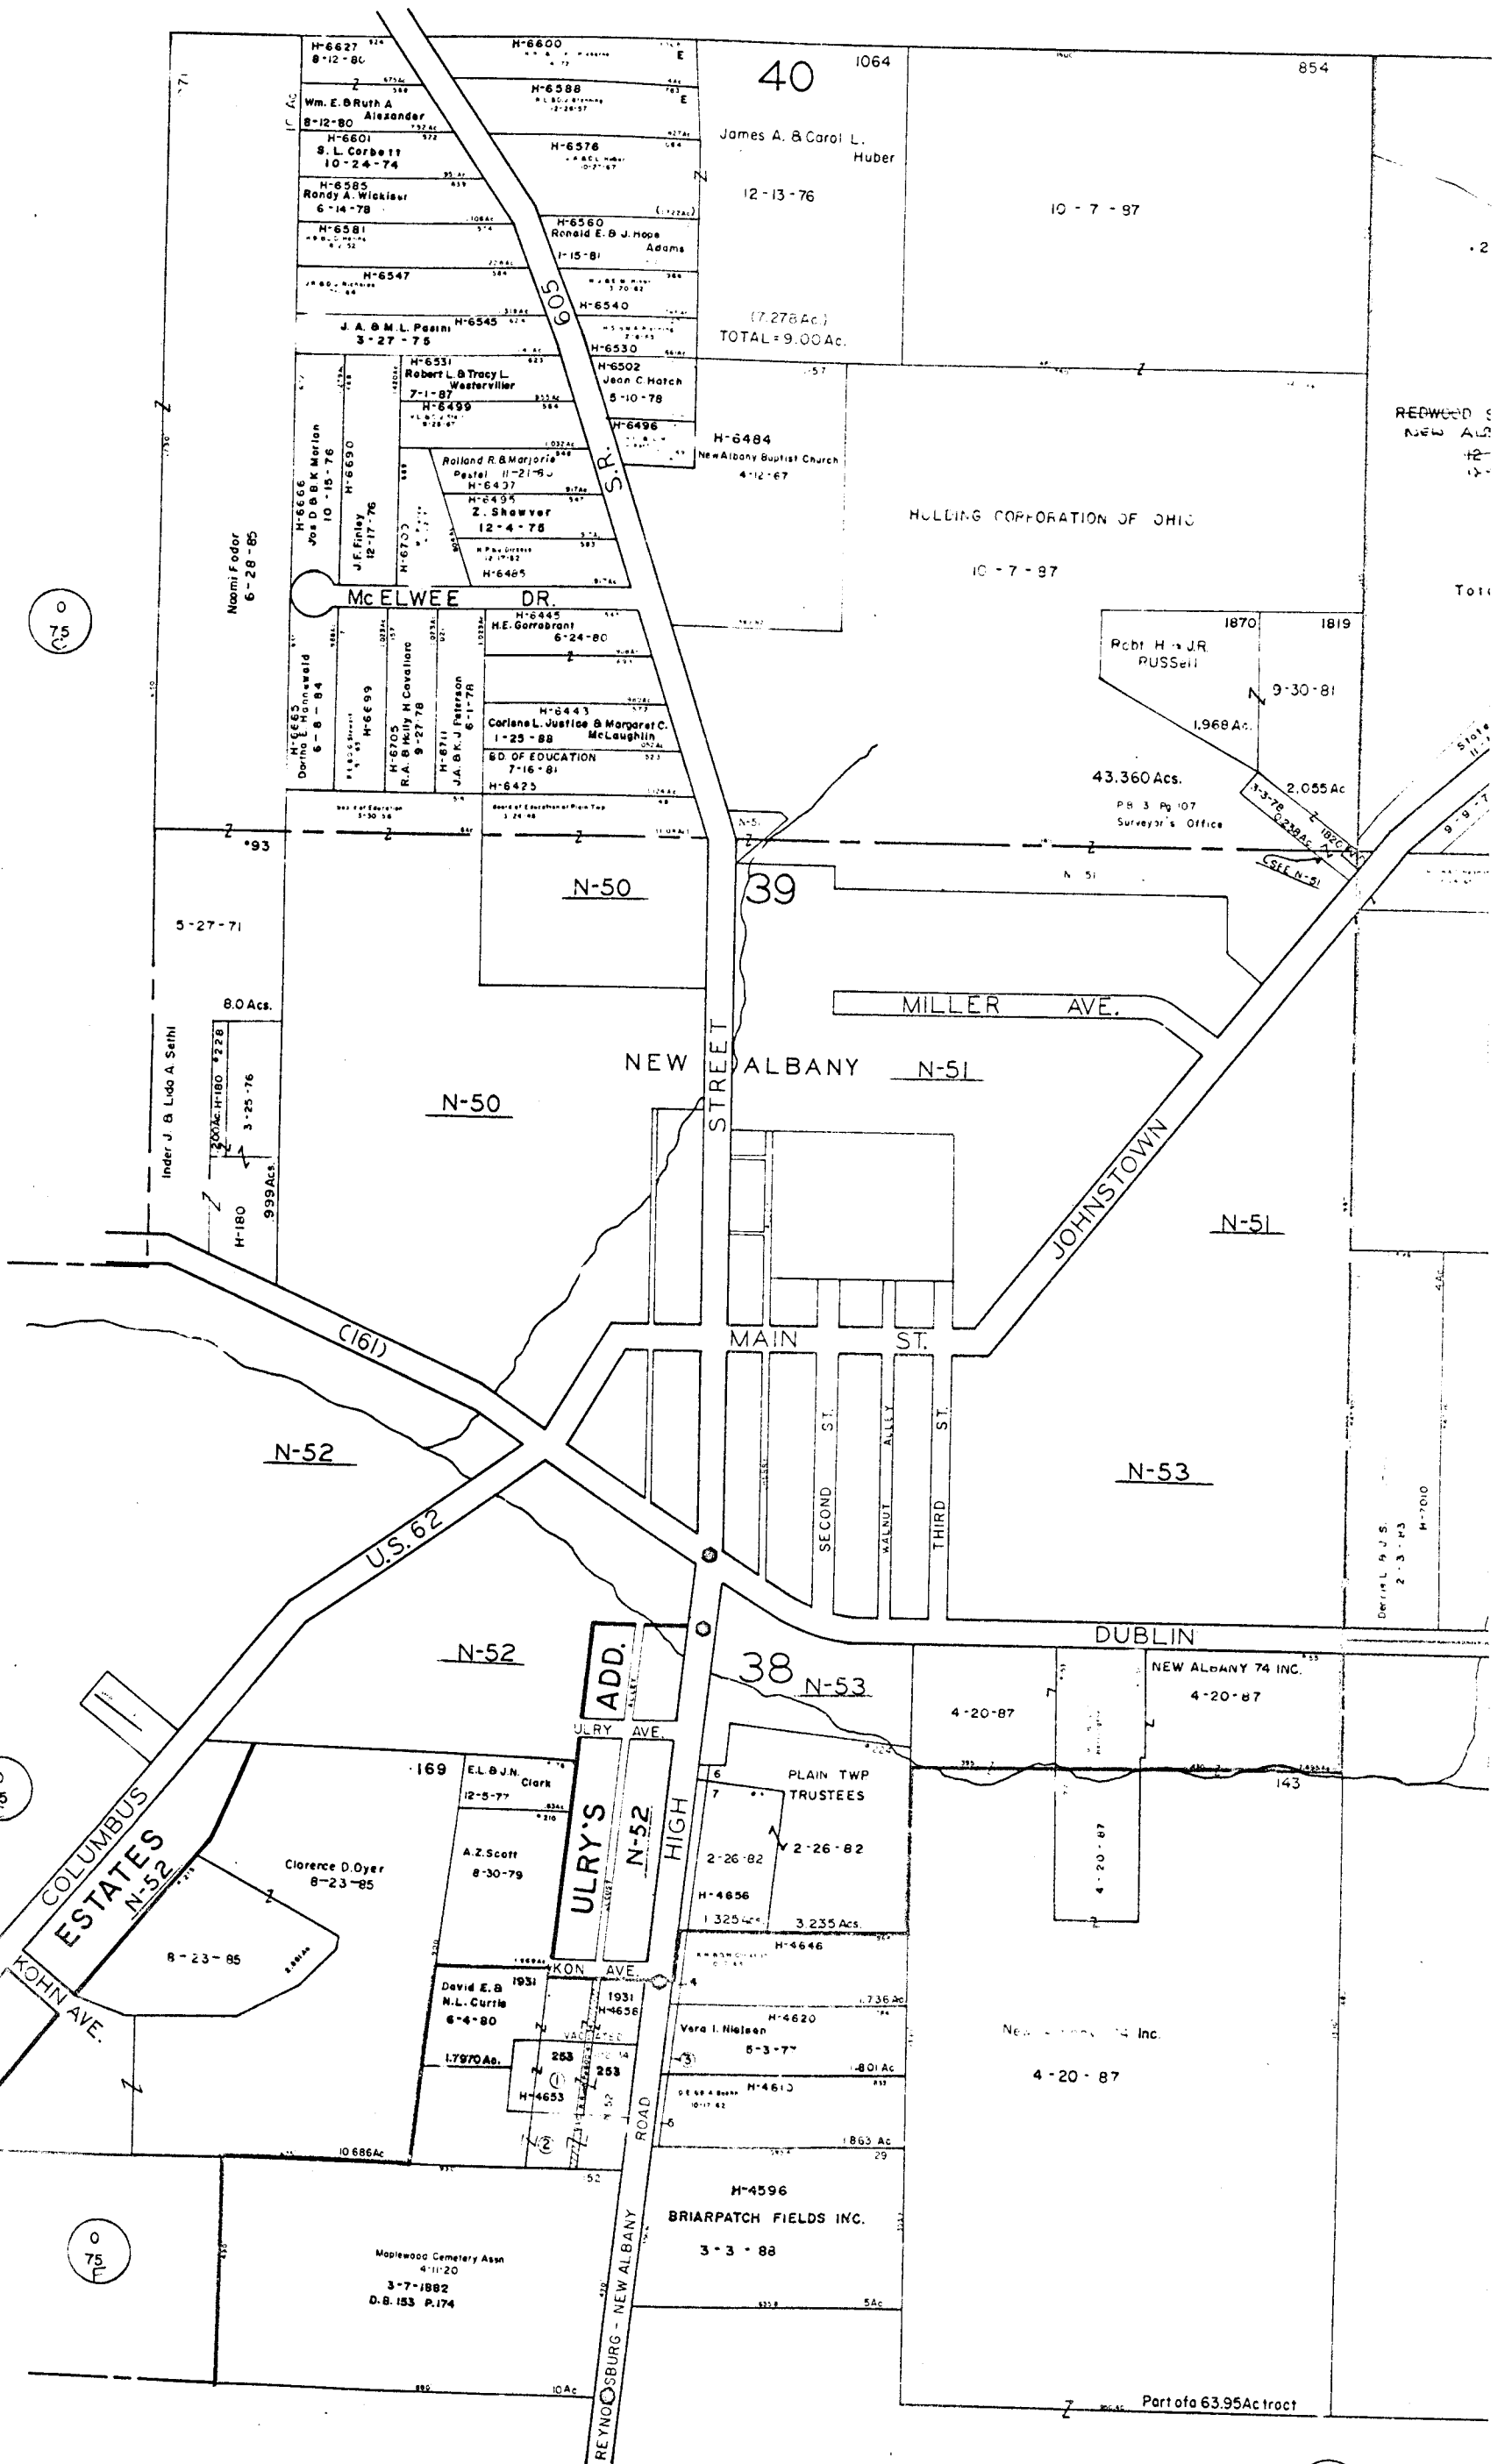


0  
75  
C

0  
75  
C

0  
75  
C

0  
76  
C

0  
74  
B

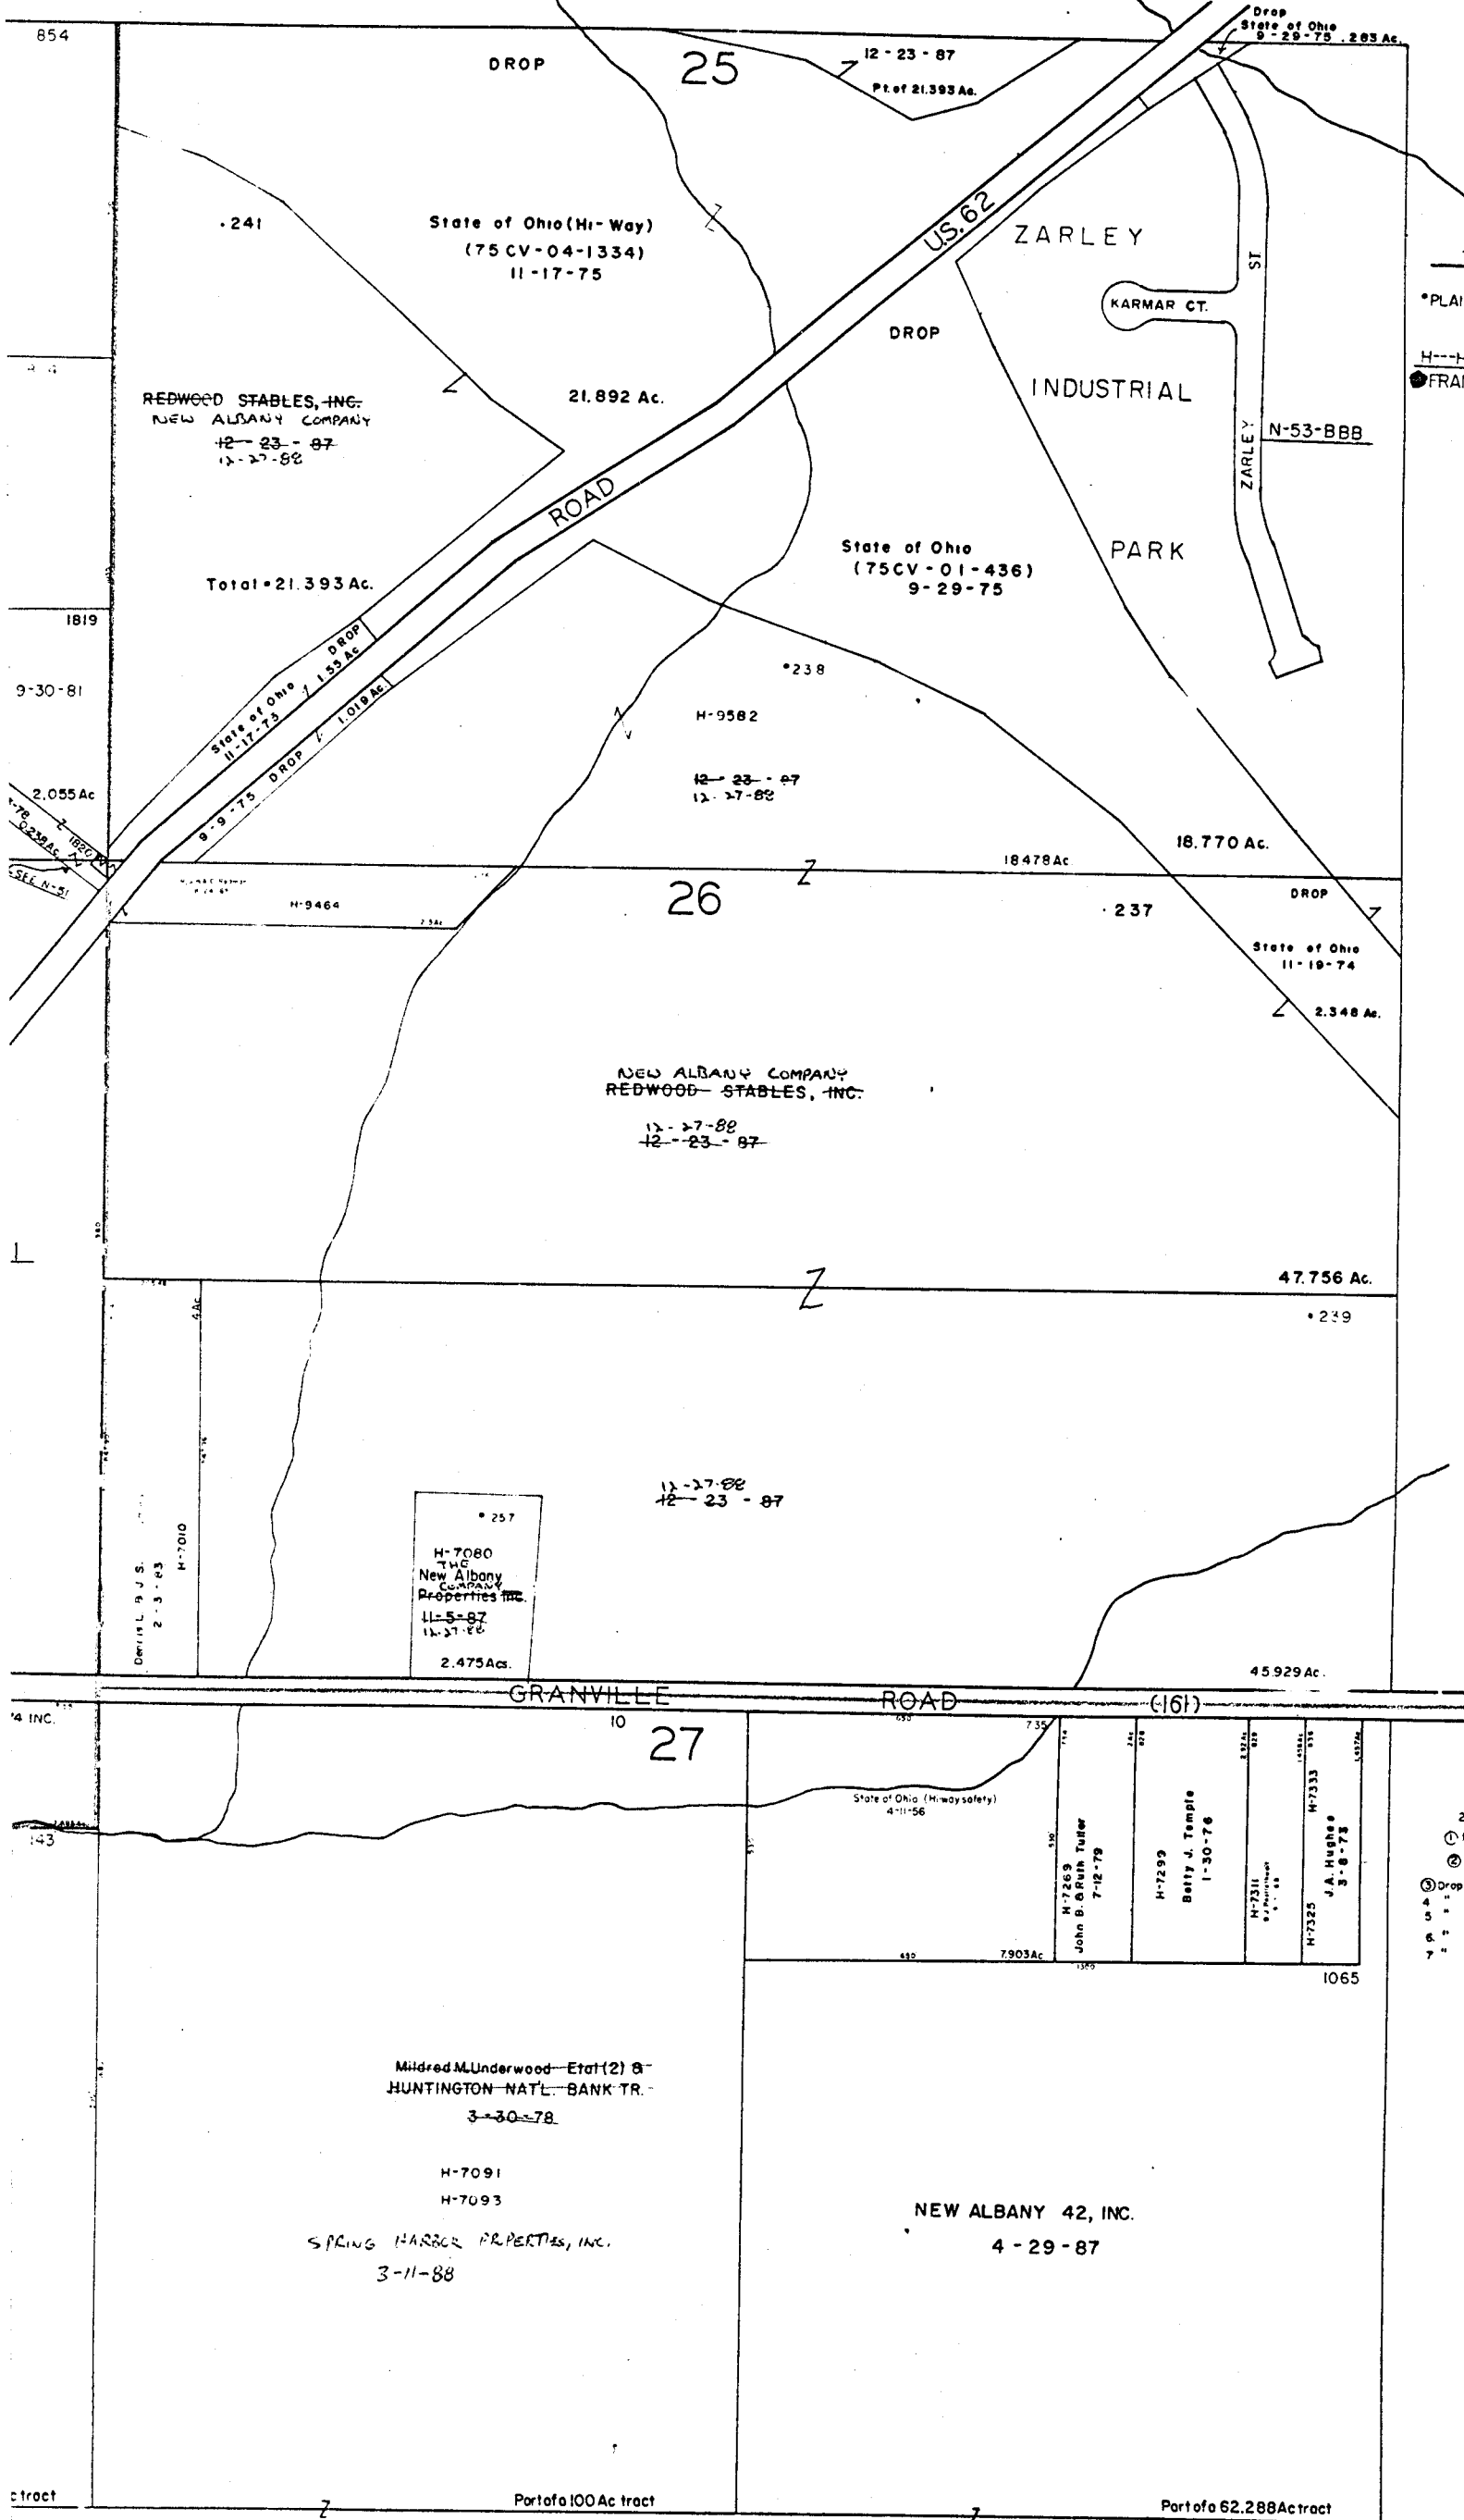

SCALE 1" = 200'  
 HIGHWAY EASEMENT  
 TAXING DISTRICTS DISTRICT CODE  
 PLAIN TWP 220  
 PLAIN-NEW ALBANY 222

H---HOUSE NUMBERS  
 FRANKLIN COUNTY SURVEY MONUMENT

0  
76  
B

- 253
- ① Neil A. Kirby & Thermo A. Kemper 11-12-85 0.9249
  - ② 1954 David E. & Nancy L. Curtis 11-2-81 1.7201
  - ③ Drop-Franklin County Comm (H-Way) 5-1-84 0.156 A
  - 4 " " " " 5-7-84 "
  - 5 " " " " 5-14-84 "
  - 6 " " " " 7-10-84 D.C.31
  - 7 " " " " 7-10-84 0.355

0  
76  
B