


0  
76  
D

0  
76  
H

0  
76  
B

O-76-E


PLAIN TWP.  
R.16 TWP.2

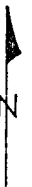

SCALE 1" = 200'  
E=HIGHWAY EASEMENT  
TAXING DISTRICTS DISTRICT CODE  
PLAIN 220

H--- HOUSE NUMBERS

FRANKLIN COUNTY  
SURVEY MONUMENT

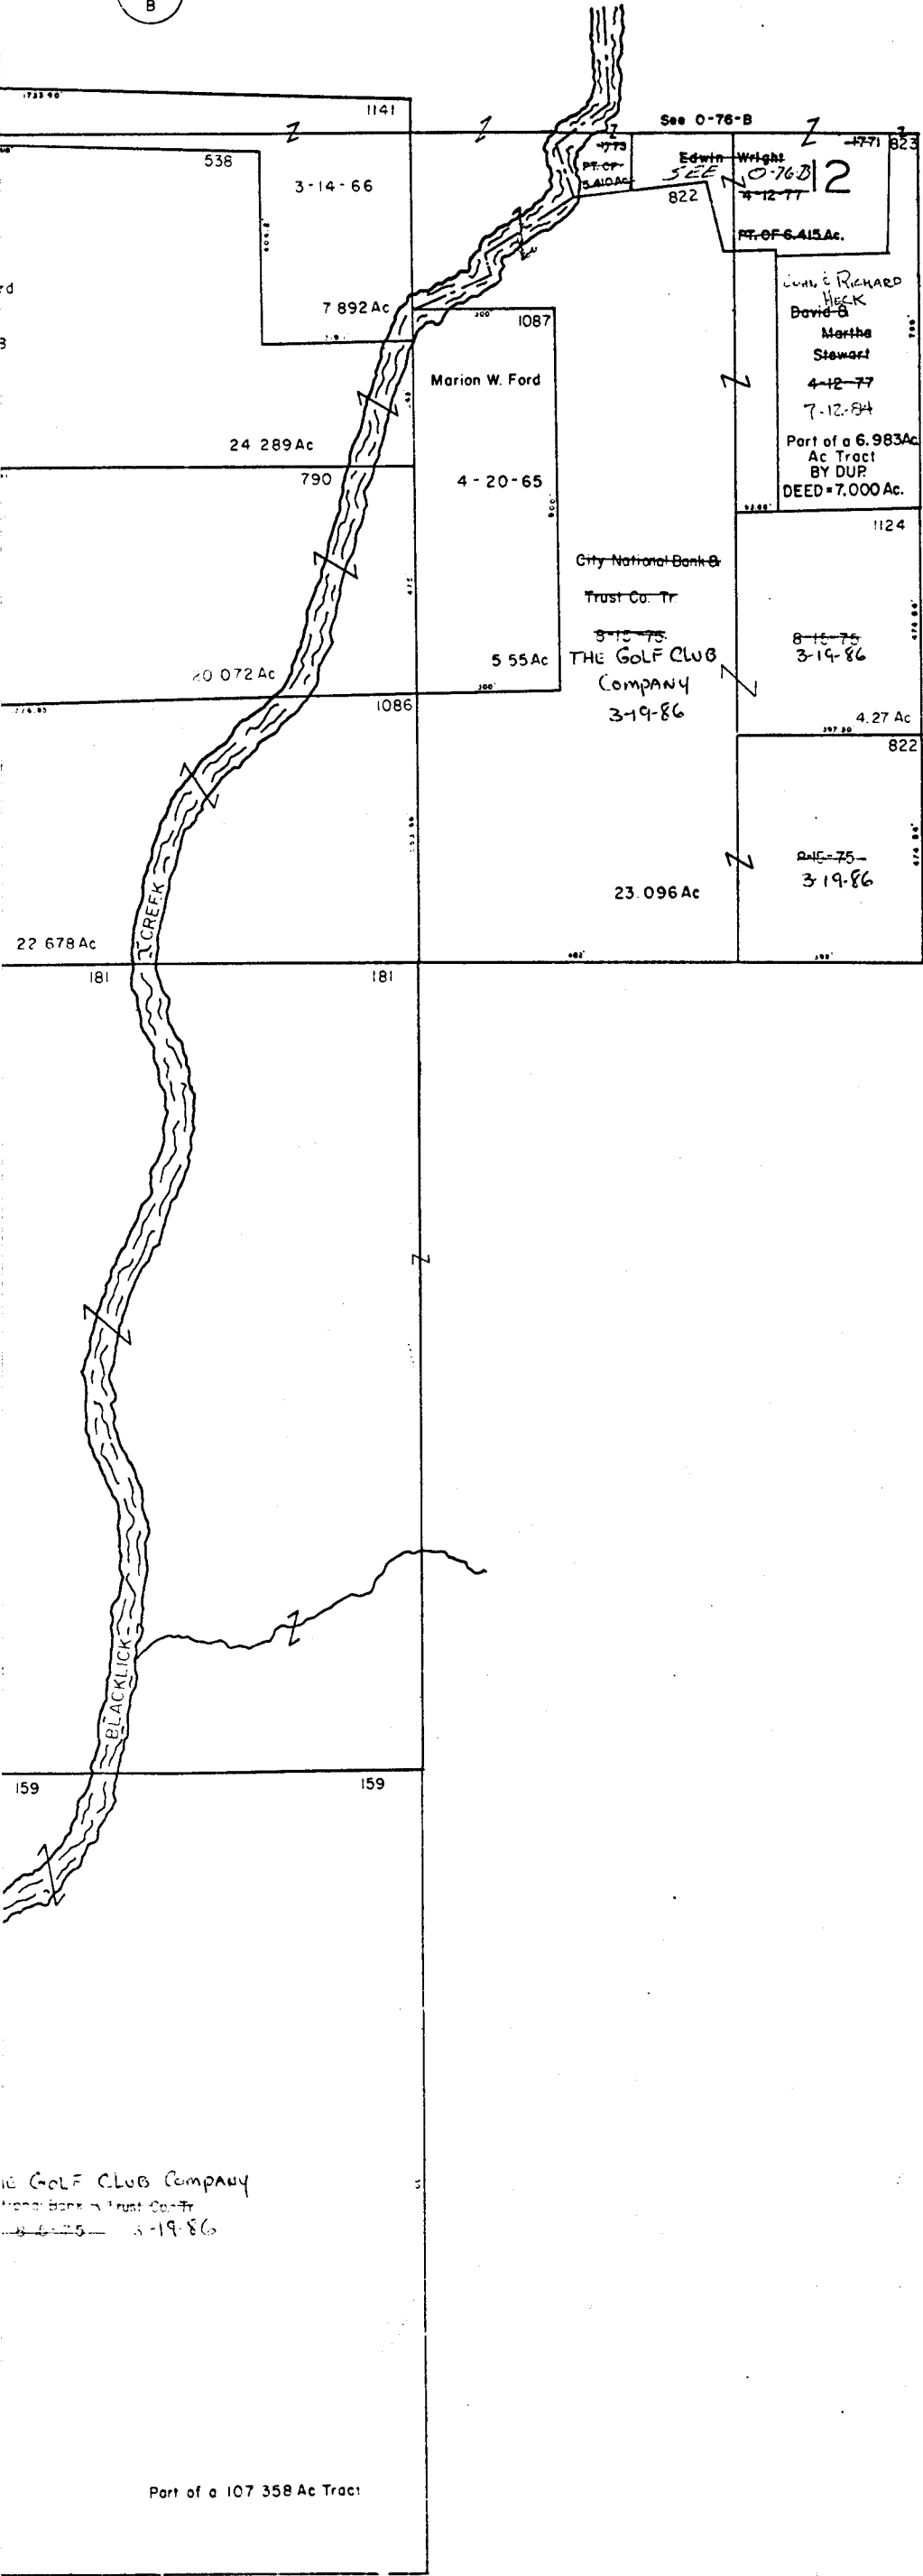


10 GOLF CLUB COMPANY  
3-19-86

Part of a 107.358 Ac Tract

0  
76  
F

O-76-E

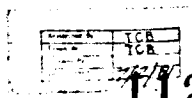

1122