

0
94
A

Joseph W & Rose I Murnane
10-16-52
H1838

0
77
G

John E & Mary J
Bertha K. Emmelhanz
8-28-81
7-22-81 10-20
H1932

2160 Ohio Bell Telephone Co. 10-5-81 0.086Ac.


John E & Mary J.
Bertha K. Emmelhanz
8-28-81 10-20-86
7-22-81

49.516A
56.411Ac
64.997Ac
54.807A
(Deed 50.69 Ac)

0
77
G

J.E.M. & M.J.
5-1-86

ROSE, E.B.M.
CONVEY
5-12-84

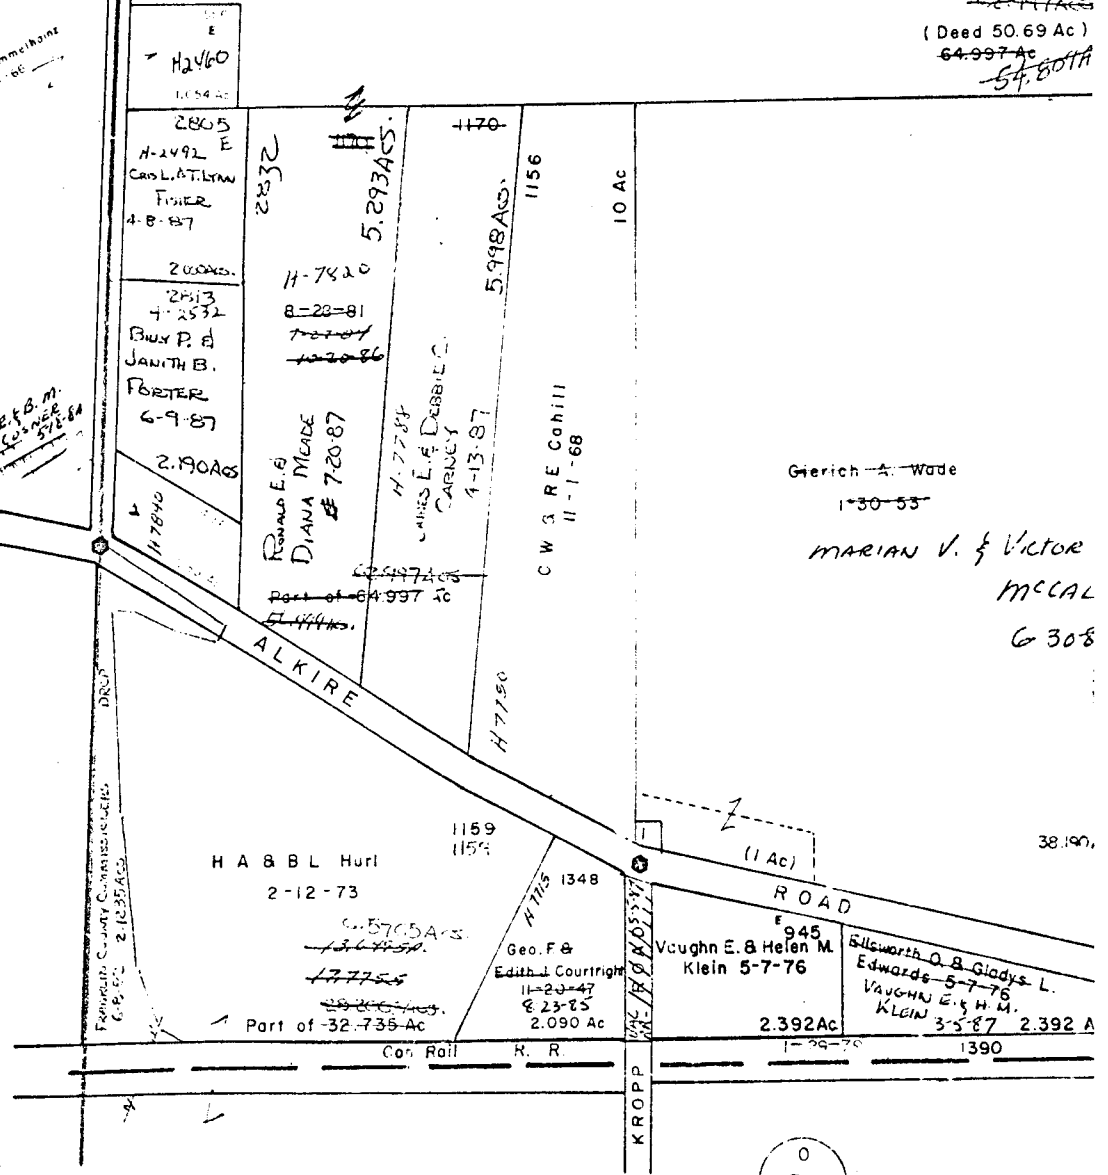


0
78
B

O-78-A
PLEASANT TWP.



SCALE 1"=200'
V.T.S.
E=HIGHWAY EASEMENT

TAXING DISTRICTS DISTRICT CODE
PLEASANT TWP 230
O FORD RIVER COUNTY SURVEY ADJUSTMENT
H... HOUSE NUMBERS

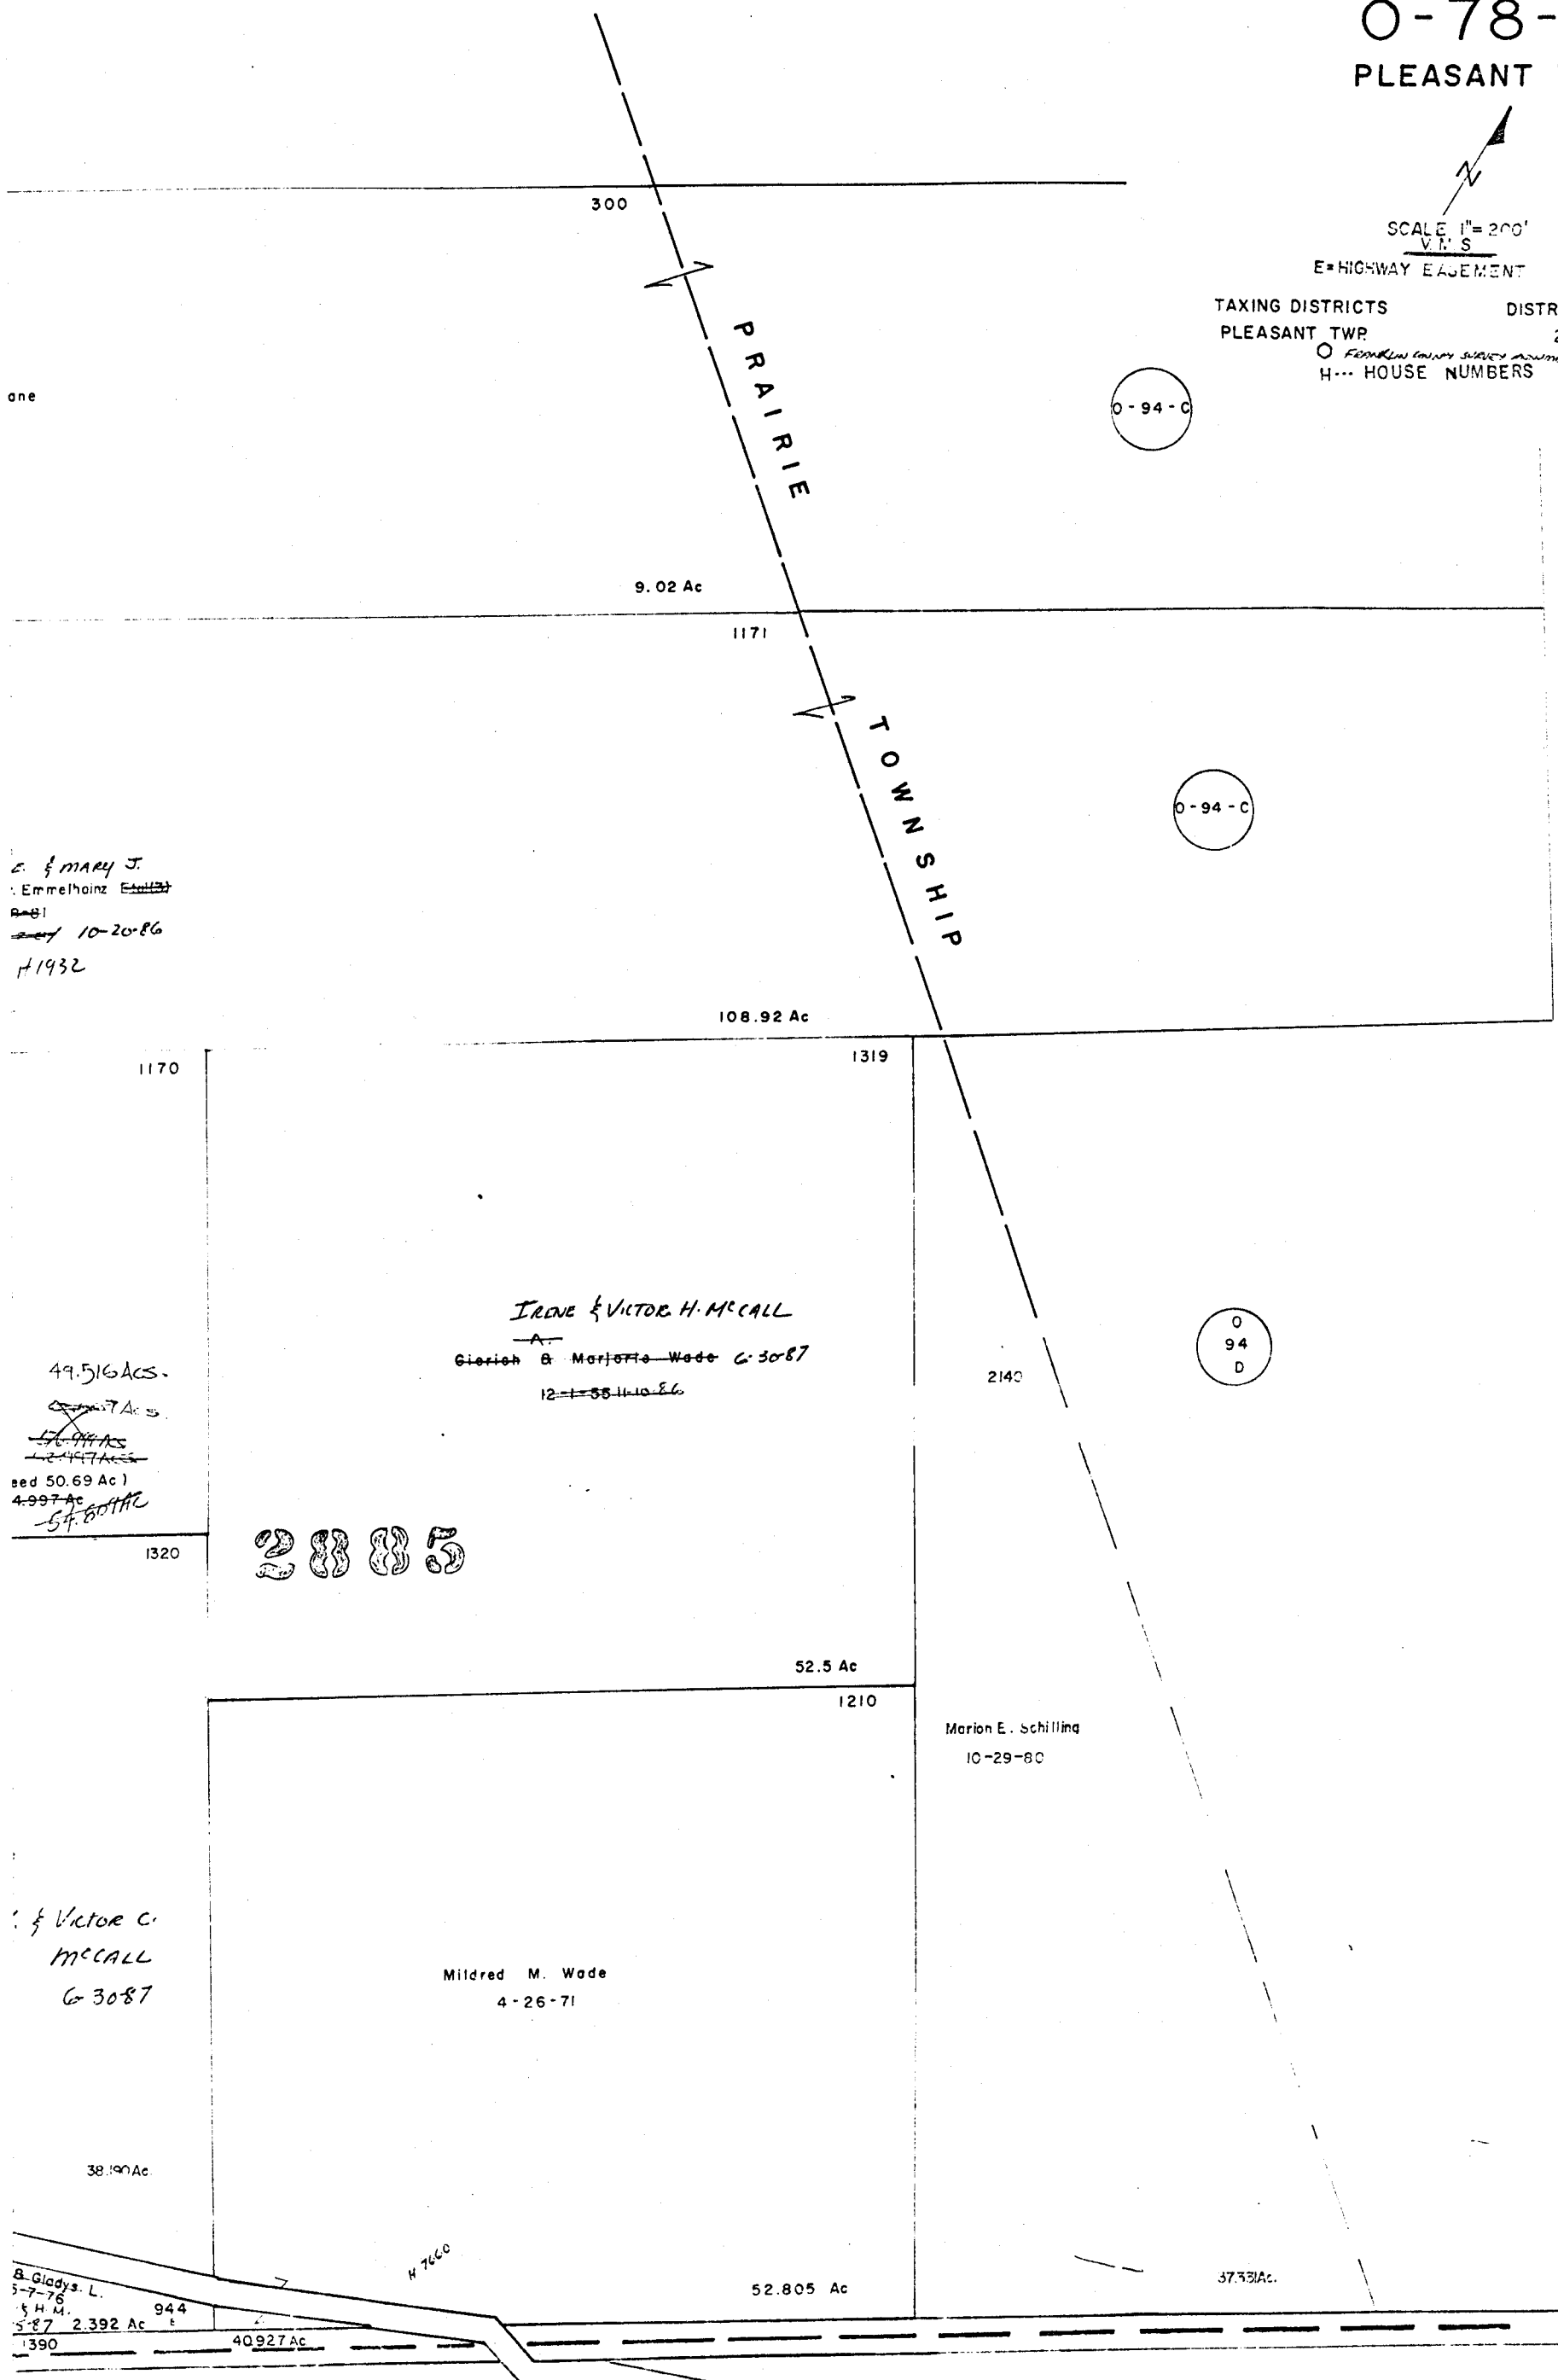

one

C. & MARY J.
Emmelhoiz
19-81
10-20-86
1932

49.516 ACS.
7 Ac
56.94 ACS
2.44 ACS
50.69 Ac
4.997 Ac
54.804 AC

Victor C.
McCALL
6-30-87

B. Gladys L.
5-7-76
H.M.
5-87 2.392 Ac
1390

O-78-A

318
5/1/82