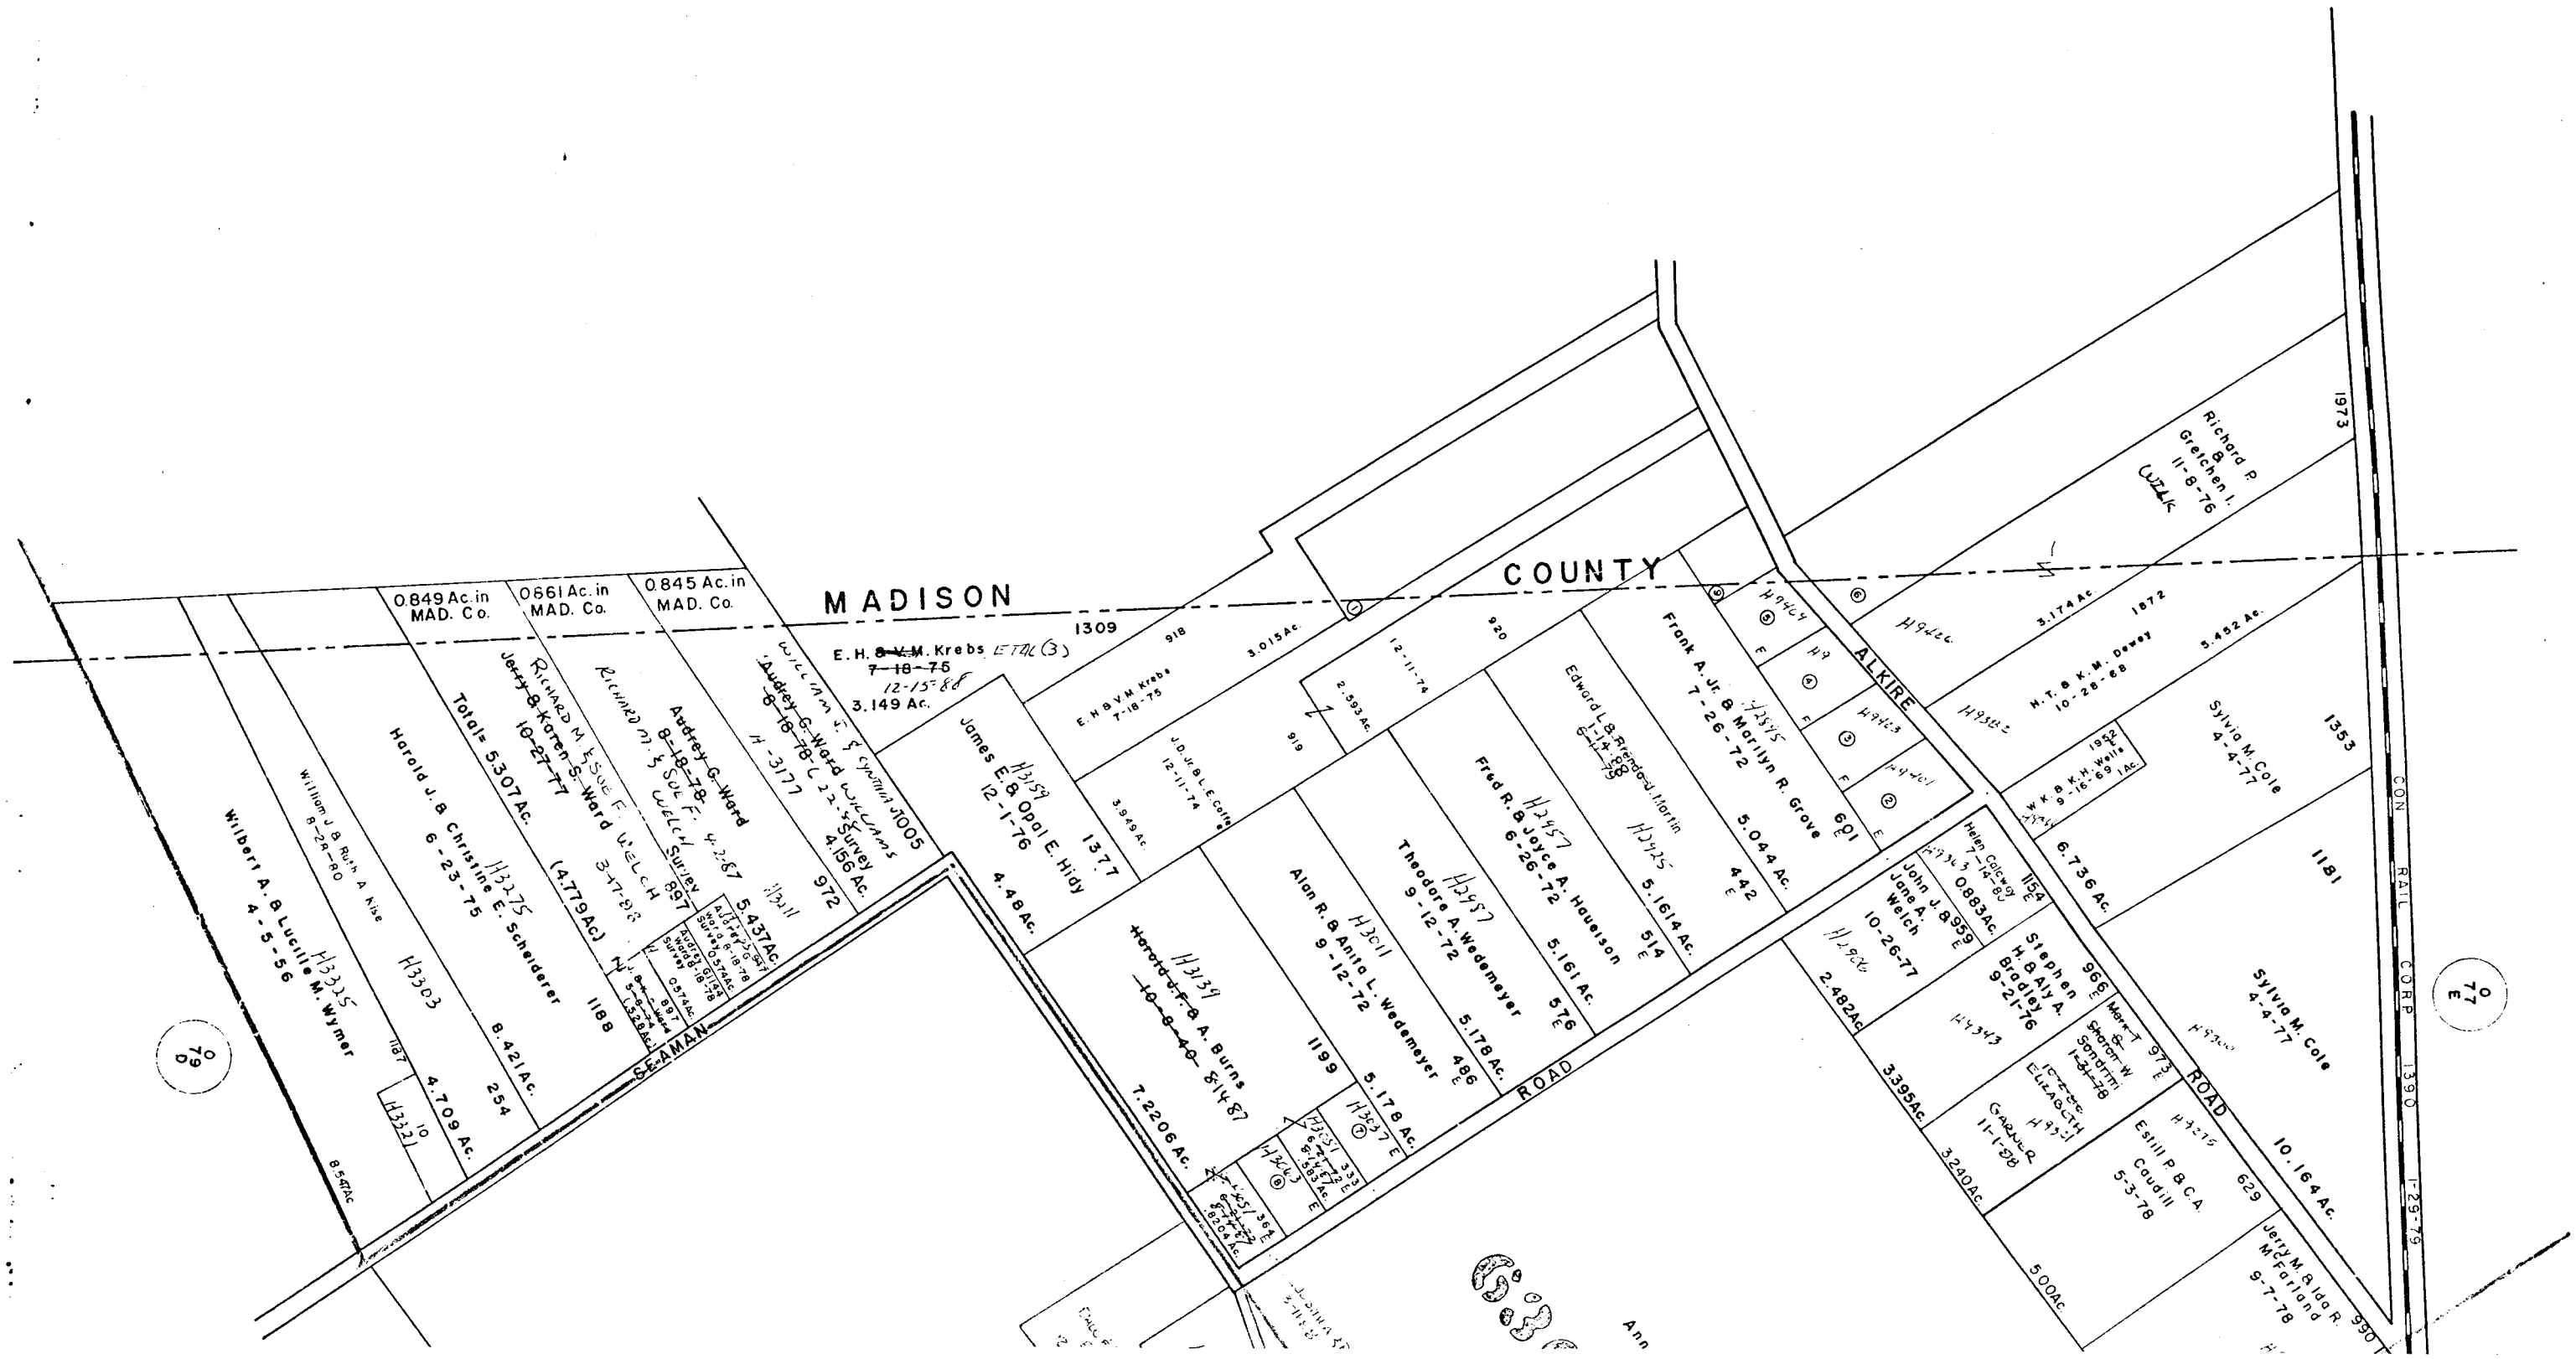
MADISON
COUNTY
0.849 Ac. in MAD. Co.
0.661 Ac. in MAD. Co.
0.845 Ac. in MAD. Co.
1309
E. H. & V. M. Krebs ET AL (3)
7-18-75
12-15-88
3.149 Ac.
Audrey G. Ward
8-18-78
Richard M. & Sue F. Welch
3-17-88
Harold J. & Christine E. Schneider
6-23-75
Total = 5.307 Ac.
Jerry & Karen S. Ward
10-27-77
(4.779 Ac)
Wilbert A. & Lucille M. Wymer
4-5-56
William J. & Ruth A. Nise
8-29-80
8.421 Ac.
4.709 Ac.
8.541 Ac.
James E. & Opal E. Hidy
12-1-76
4.48 Ac.
Harold J. & A. Burns
7.2206 Ac.
Alan R. & Anita L. Wedemeyer
9-12-72
Theodore A. Wedemeyer
9-12-72
Fred R. & Joyce A. Haueison
6-26-72
Edward L. & Brenda J. Martin
Frank A. Jr. & Marilyn R. Grove
7-26-72
5.044 Ac.
Richard P. & Gretchen I. Grotchen
11-8-76
1973
1972
H. T. & K. M. Dewey
10-28-68
3.174 Ac.
5.452 Ac.
Sylvia M. Cole
4-4-77
6.736 Ac.
10.164 Ac.
Helen Colcey
John J. & Jane A. Welch
10-26-77
2.482 Ac.
Stephen H. & Aly A. Bradley
9-21-76
Martin & Sharon W. Semonin
Gardner
11-1-78
3.240 Ac.
Estill P. & C. A. Caudill
5-3-78
Jerry M. & Ida R. McFarland
9-7-78
SEAMAN ROAD
ALKIRE ROAD
CON RAIL CORP
1390
1-29-79
0 79 D
0 77 E

O-79-A

PLEASANT TWP.

N

SCALE 1"=200'

VMS

E=HIGHWAY EASEMENT

TAXING DISTRICT	DISTRICT CODE
PLEASANT	230

H--- HOUSE NUMBERS

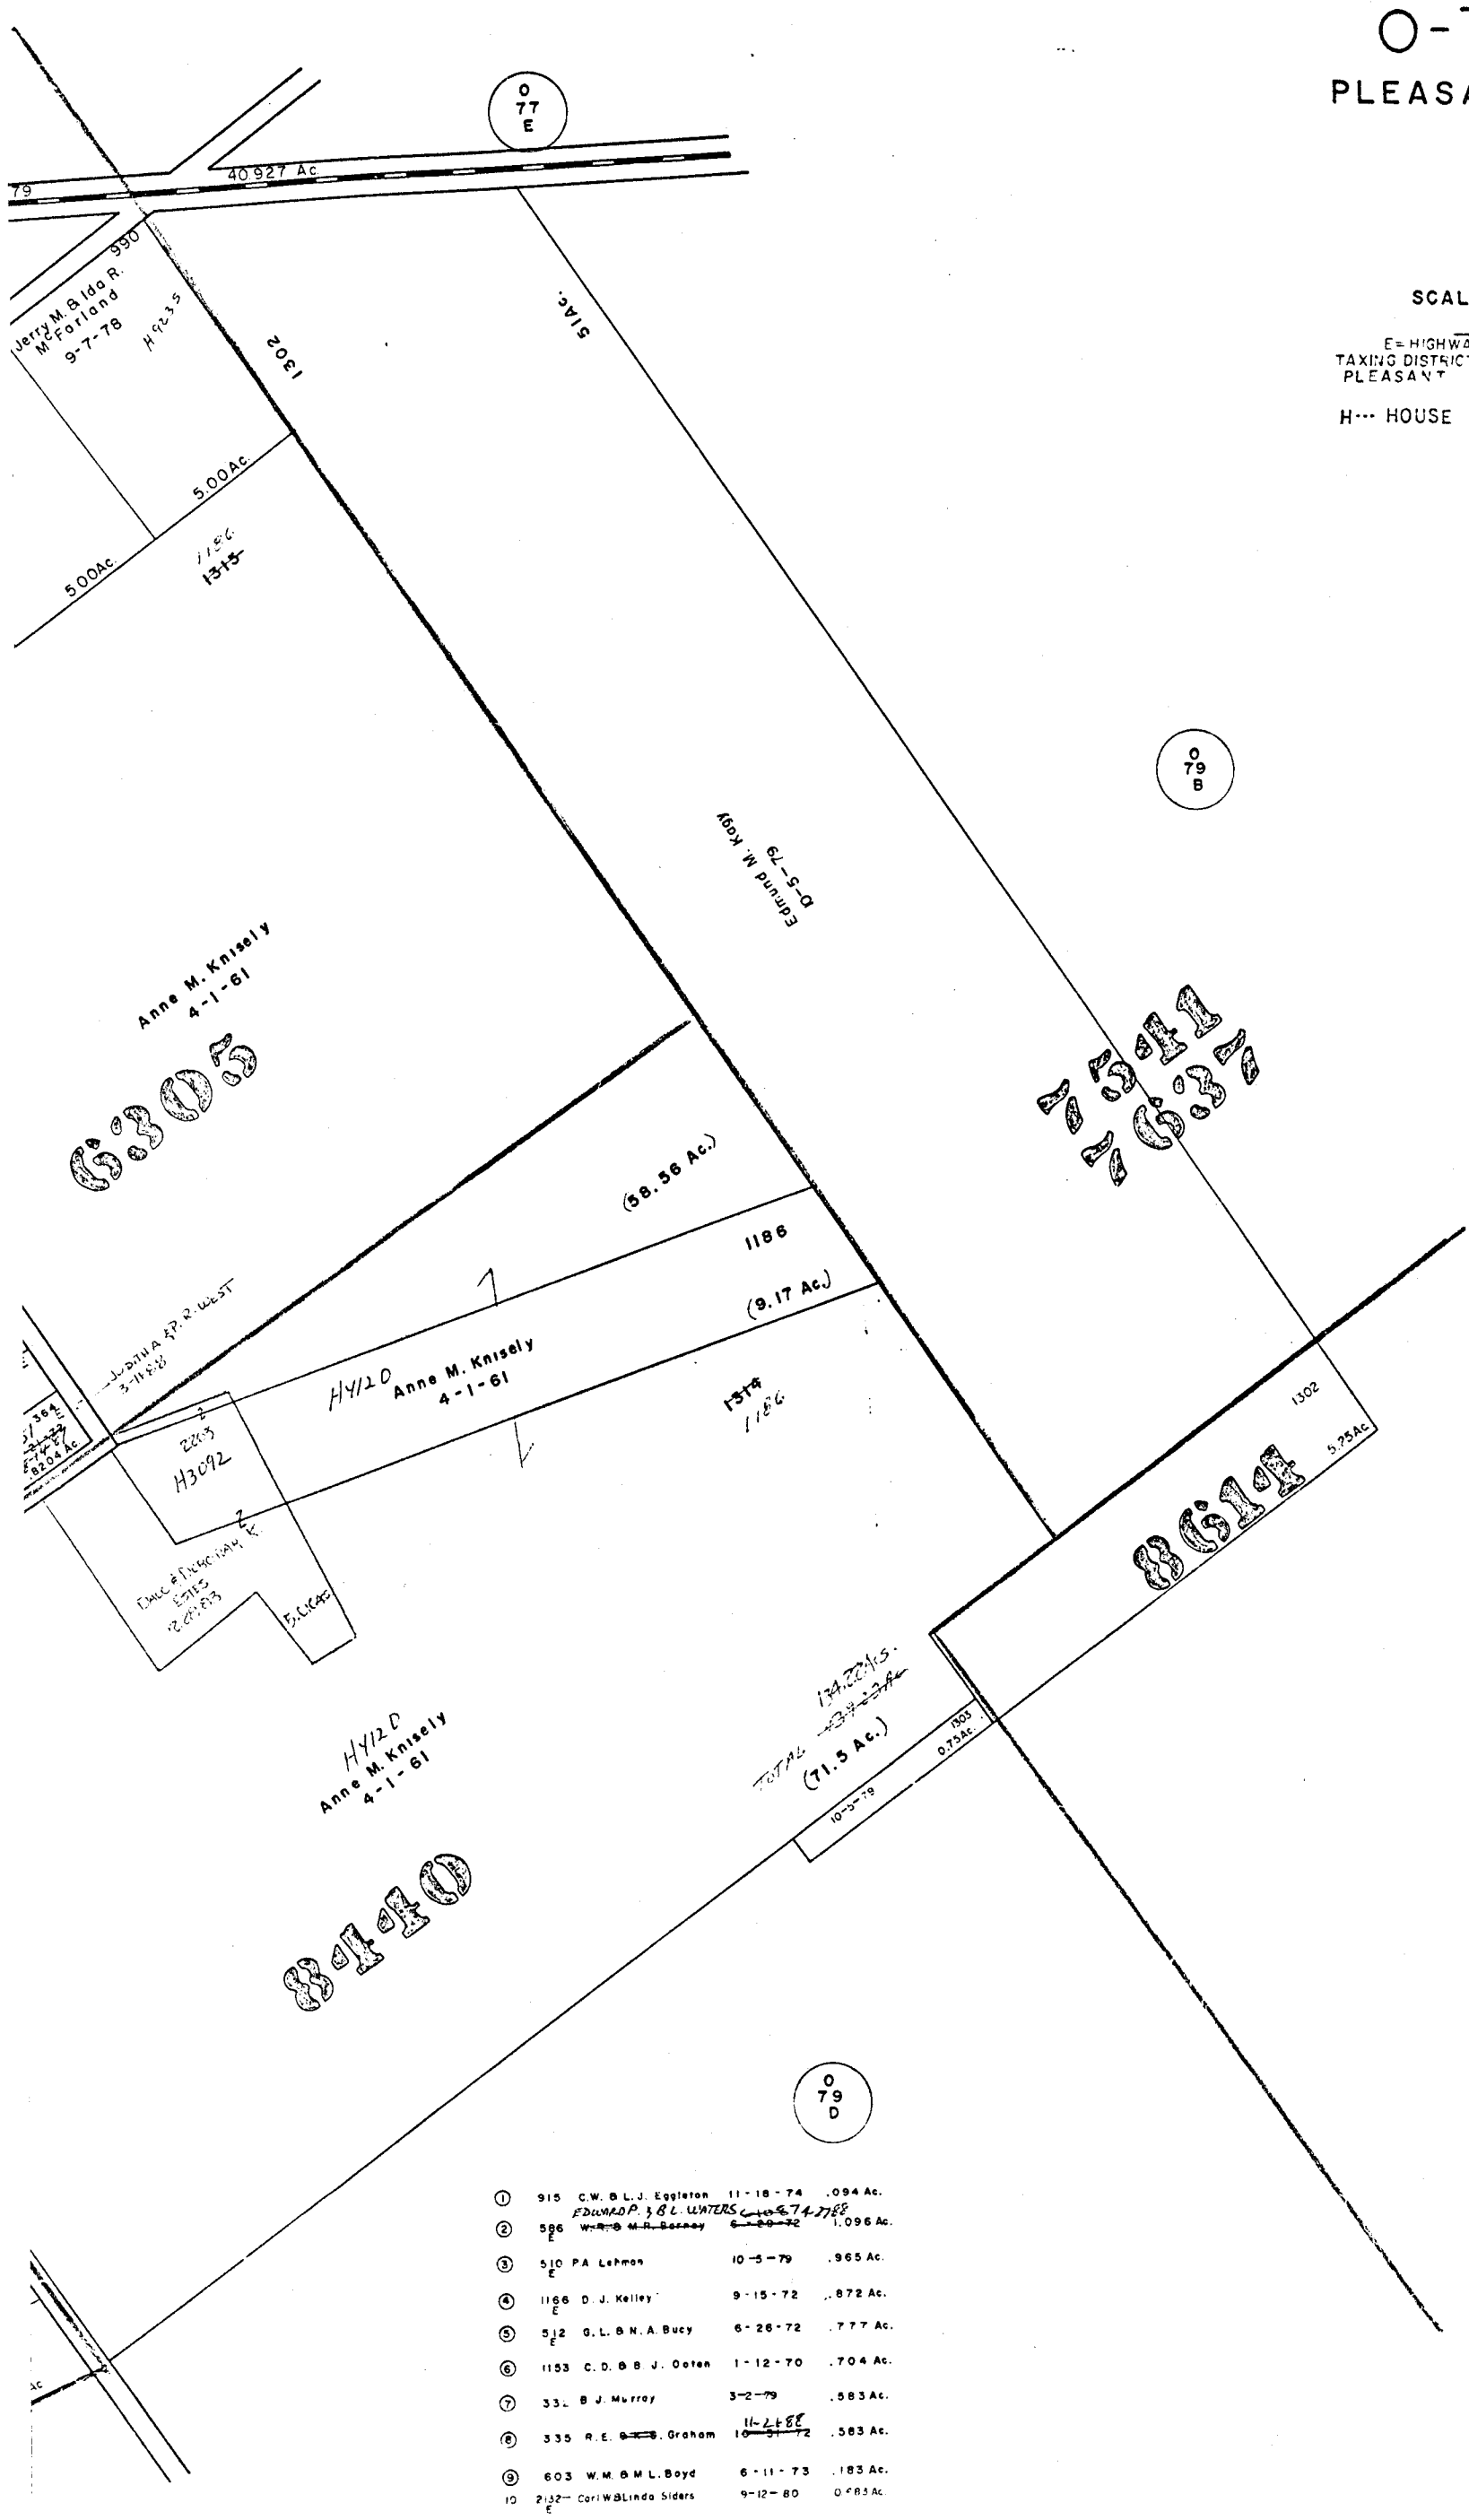

1	915	C.W. & L.J. Eggleton	11-18-74	.094 Ac.
		EDWARD P. & L. WATERS 10-6-74		
2	586 E	~~W.R. & M.R. Barney~~	~~6-20-72~~	1.096 Ac.
3	510 E	P.A. Lehman	10-5-79	.965 Ac.
4	1166 E	D.J. Kelley	9-15-72	.872 Ac.
5	512 E	G.L. & N.A. Bucy	6-26-72	.777 Ac.
6	1153	C.D. & B.J. Oeten	1-12-70	.704 Ac.
7	33[illegible]	B.J. Murray	3-2-79	.583 Ac.
8	335	R.E. ~~& K.B.~~ Graham	11-2-88 ~~10-31-72~~	.583 Ac.
9	603	W.M. & M.L. Boyd	6-11-73	.183 Ac.
10	2152 E	Carl W. & Linda Siders	9-12-80	0.[illegible]83 Ac.