

O
85
E

O-86-A
PLEASANT TWP

ROAD

1405

331

Cemetery
D 801 AC



SCALE 1"=200'
V.M.S.
E=HIGHWAY EASEMENT
TAXING DISTRICTS DISTRICT CODE
PLEASANT TWP 230
H... HOUSE NUMBERS


FRANKLIN COUNTY EASEMENT

Samuel J. Kiehl III & Terry Kiehl
7-12-77

151.384 Ac.

O
86
B

2595

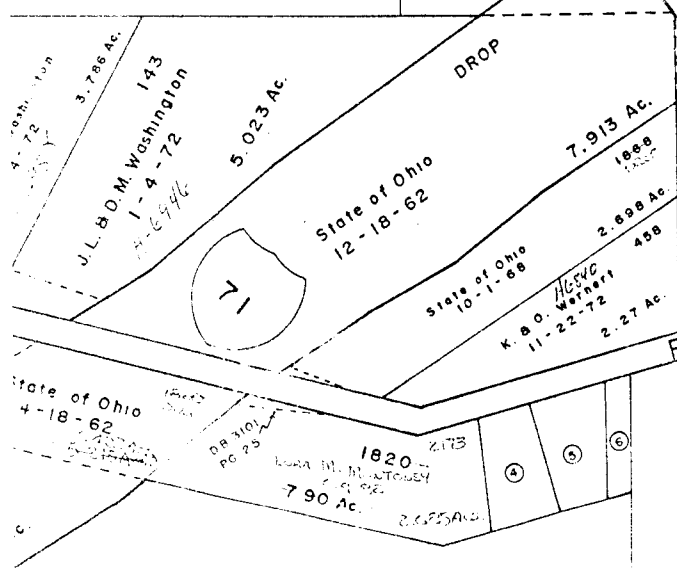

- ① 378 J.E. B. J. Downs 3-12-69 .551 Ac.
- ② 1809 ~~FOR IN ONE THIS 84~~ 5-13-69 .4844 Ac. REBECCA A. MILLER 4-4-85
- ③ 1821 CHARLES L. S. E. HARRIS 7-16-86
James P. B.S.M. Edwards 10-24-78 1.104 Ac. To Corr. 5-11-87
- ④ 1808 EDWARD L. K.S. L. GULDHARDT 11-26-85
L.F. Horboge 11-2-75 .66 Ac.
- ⑤ 1865 W.S. B.E.T. Montoney 10-11-68 .7076 Ac.
- ⑥ 1822 W.S. B.E.T. Montoney 12-21-72 .275 Ac.

O
86
B

1405

William S. & Eileen T. Montoney
10-11-68

35.960 Ac.

C O U N T Y