


O
85
E

14105

O-86-A

O
86
A

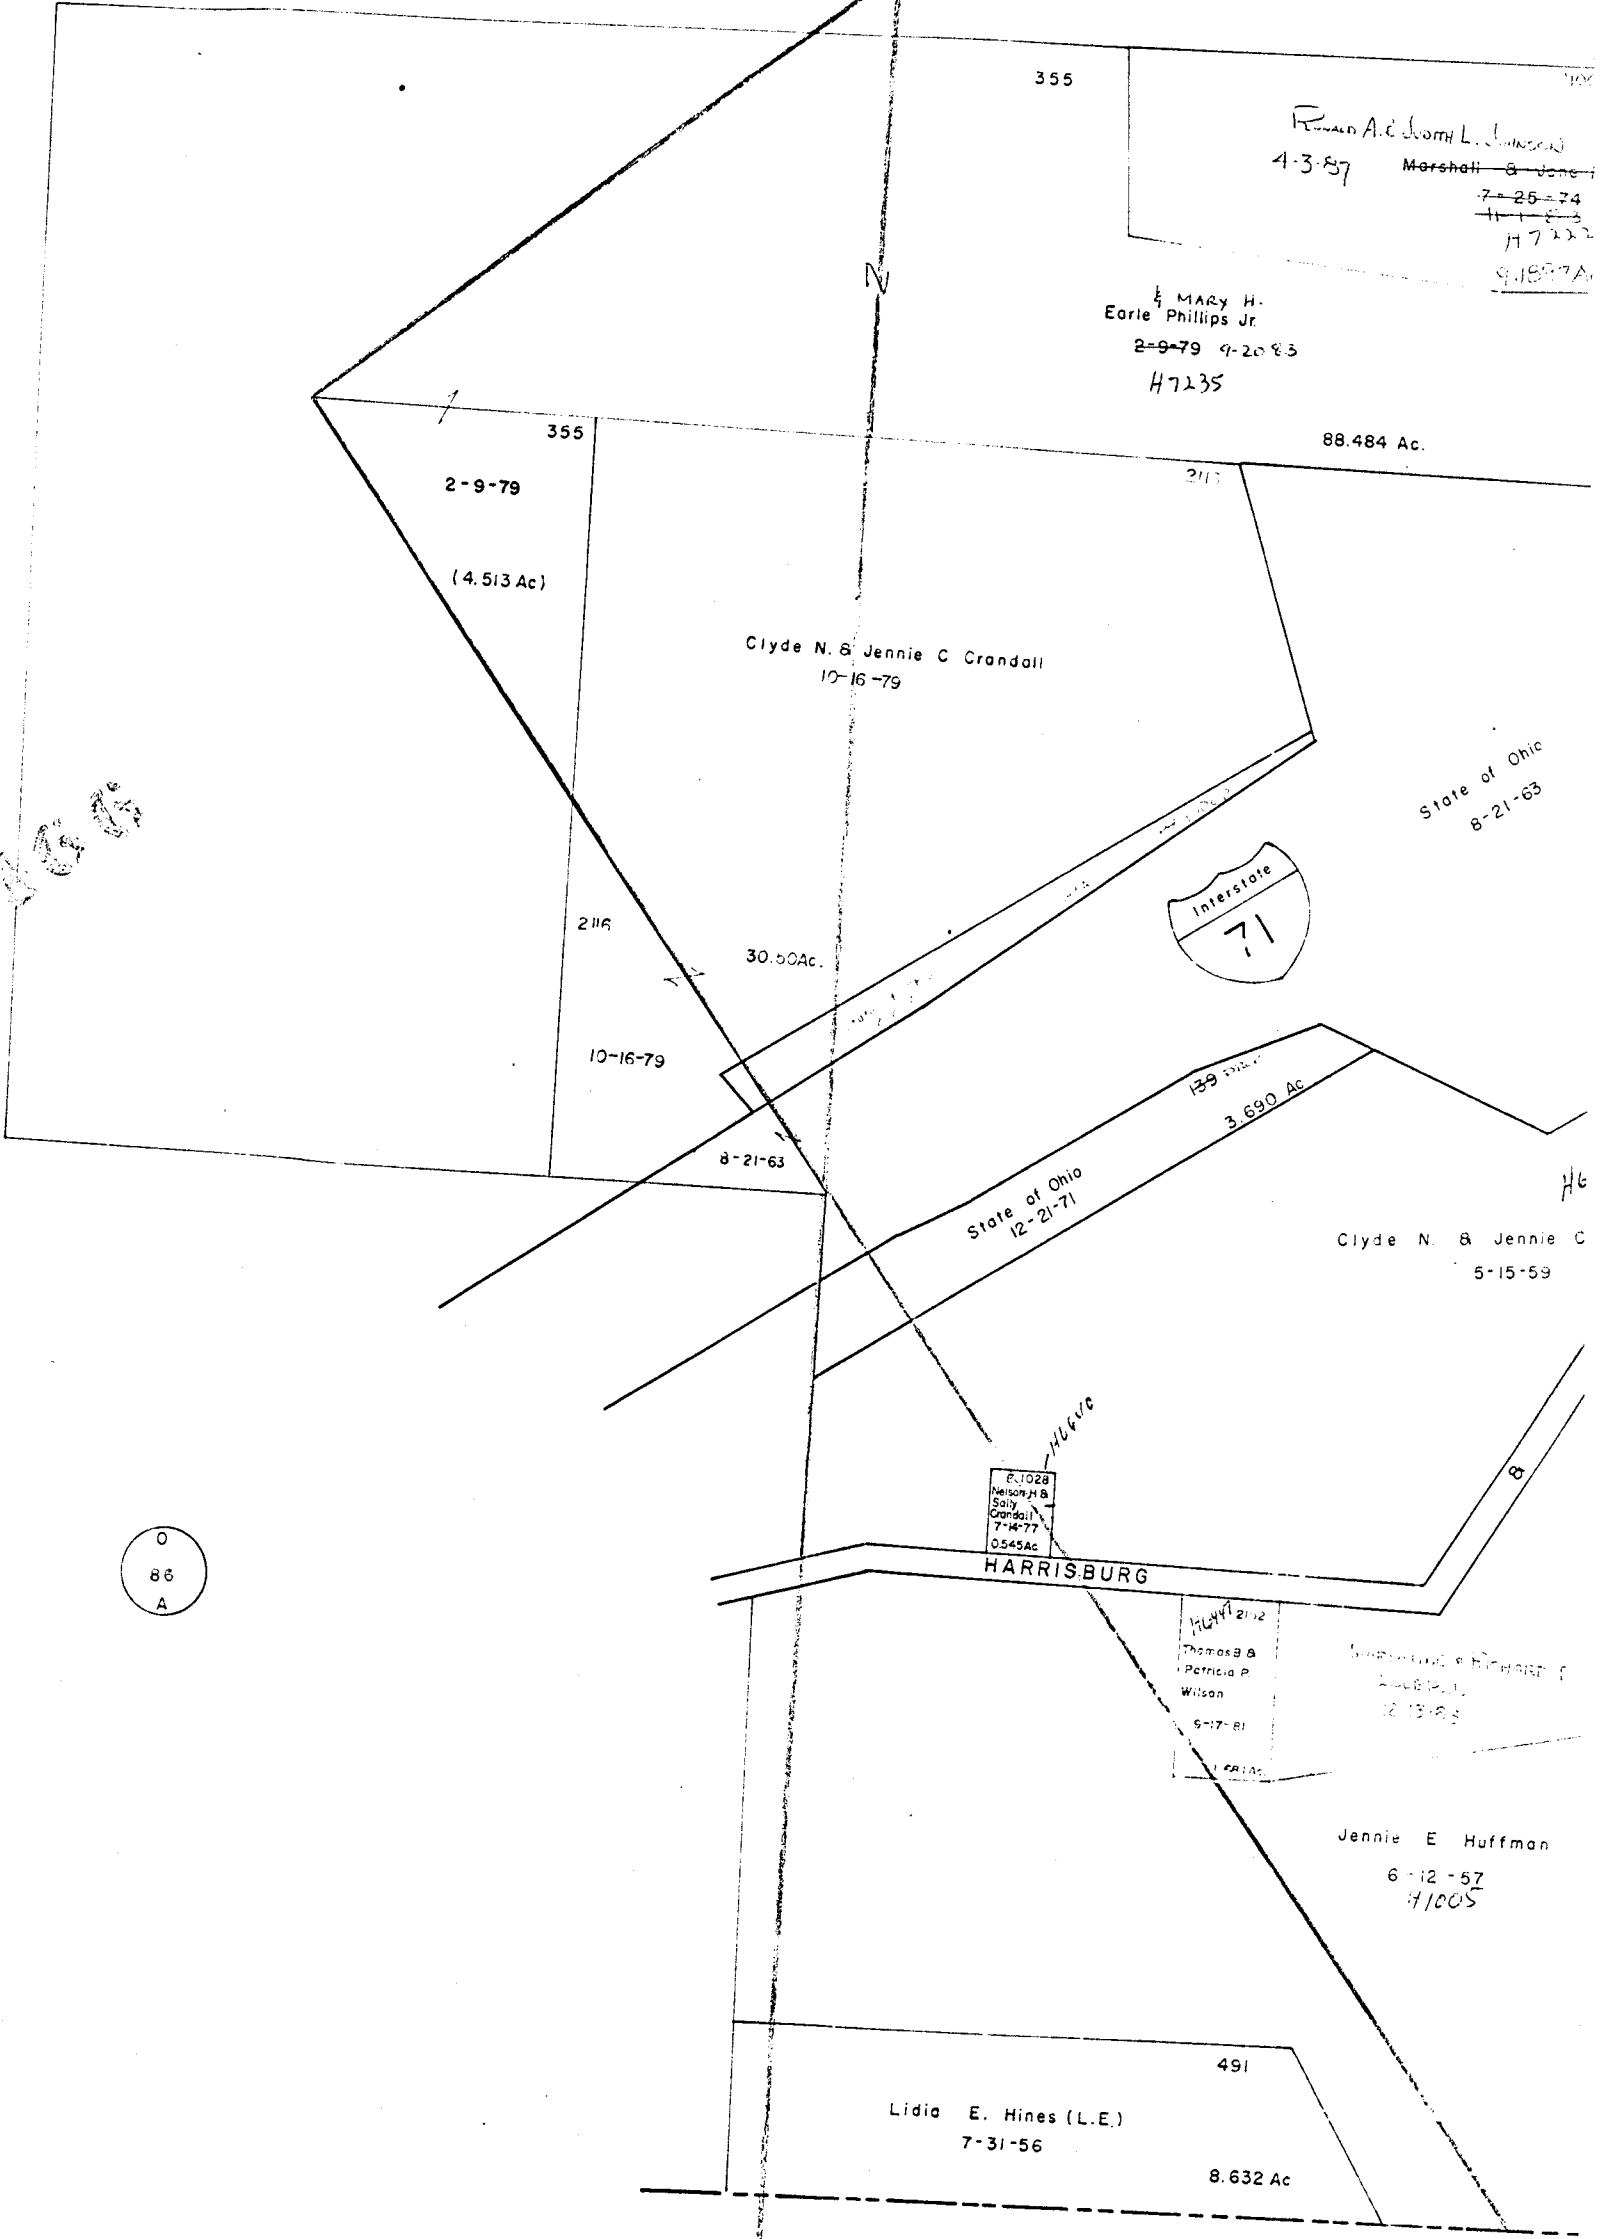

14105

O
86
A

14105

PICKAWAY

0
85
F

O-86-B
PLEASANT TWP.




SCALE 1" = 200'
V.M.S.
E = HIGHWAY EASEMENT

TAXING DISTRICTS DISTRICT CODE
PLEASANT TWP 230
H--- HOUSE NUMBERS

0
86
C

0
86
C

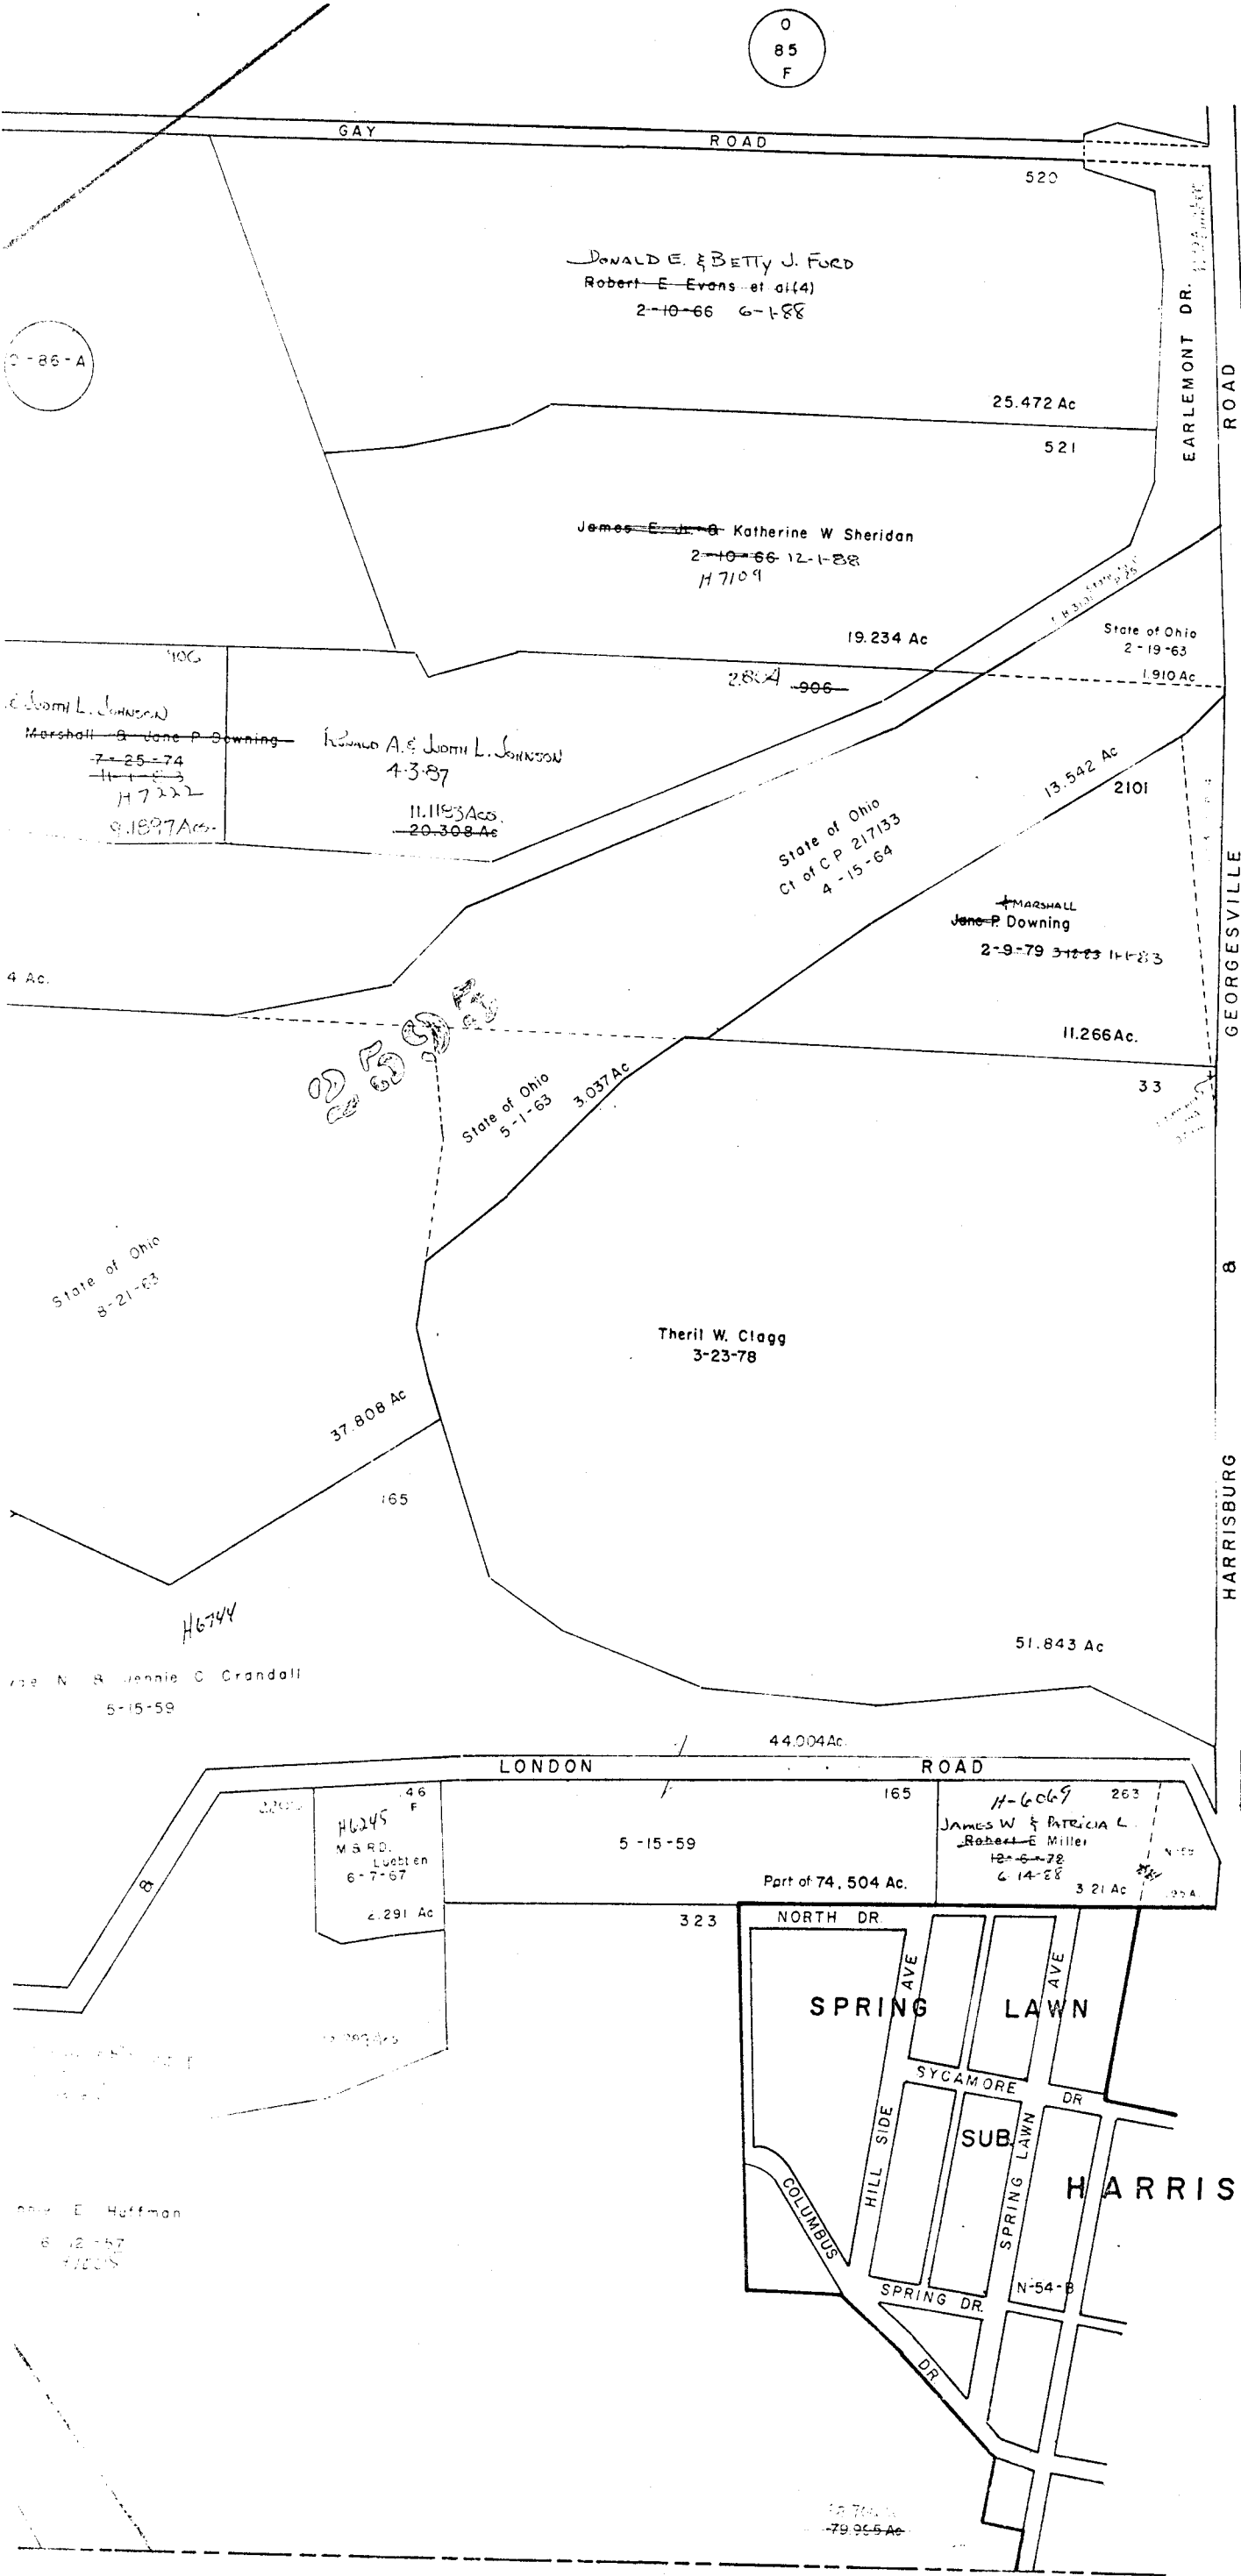

CKAWAY COUNTY

O-86-B

JLR
6/11/52
1270