


0
88
A

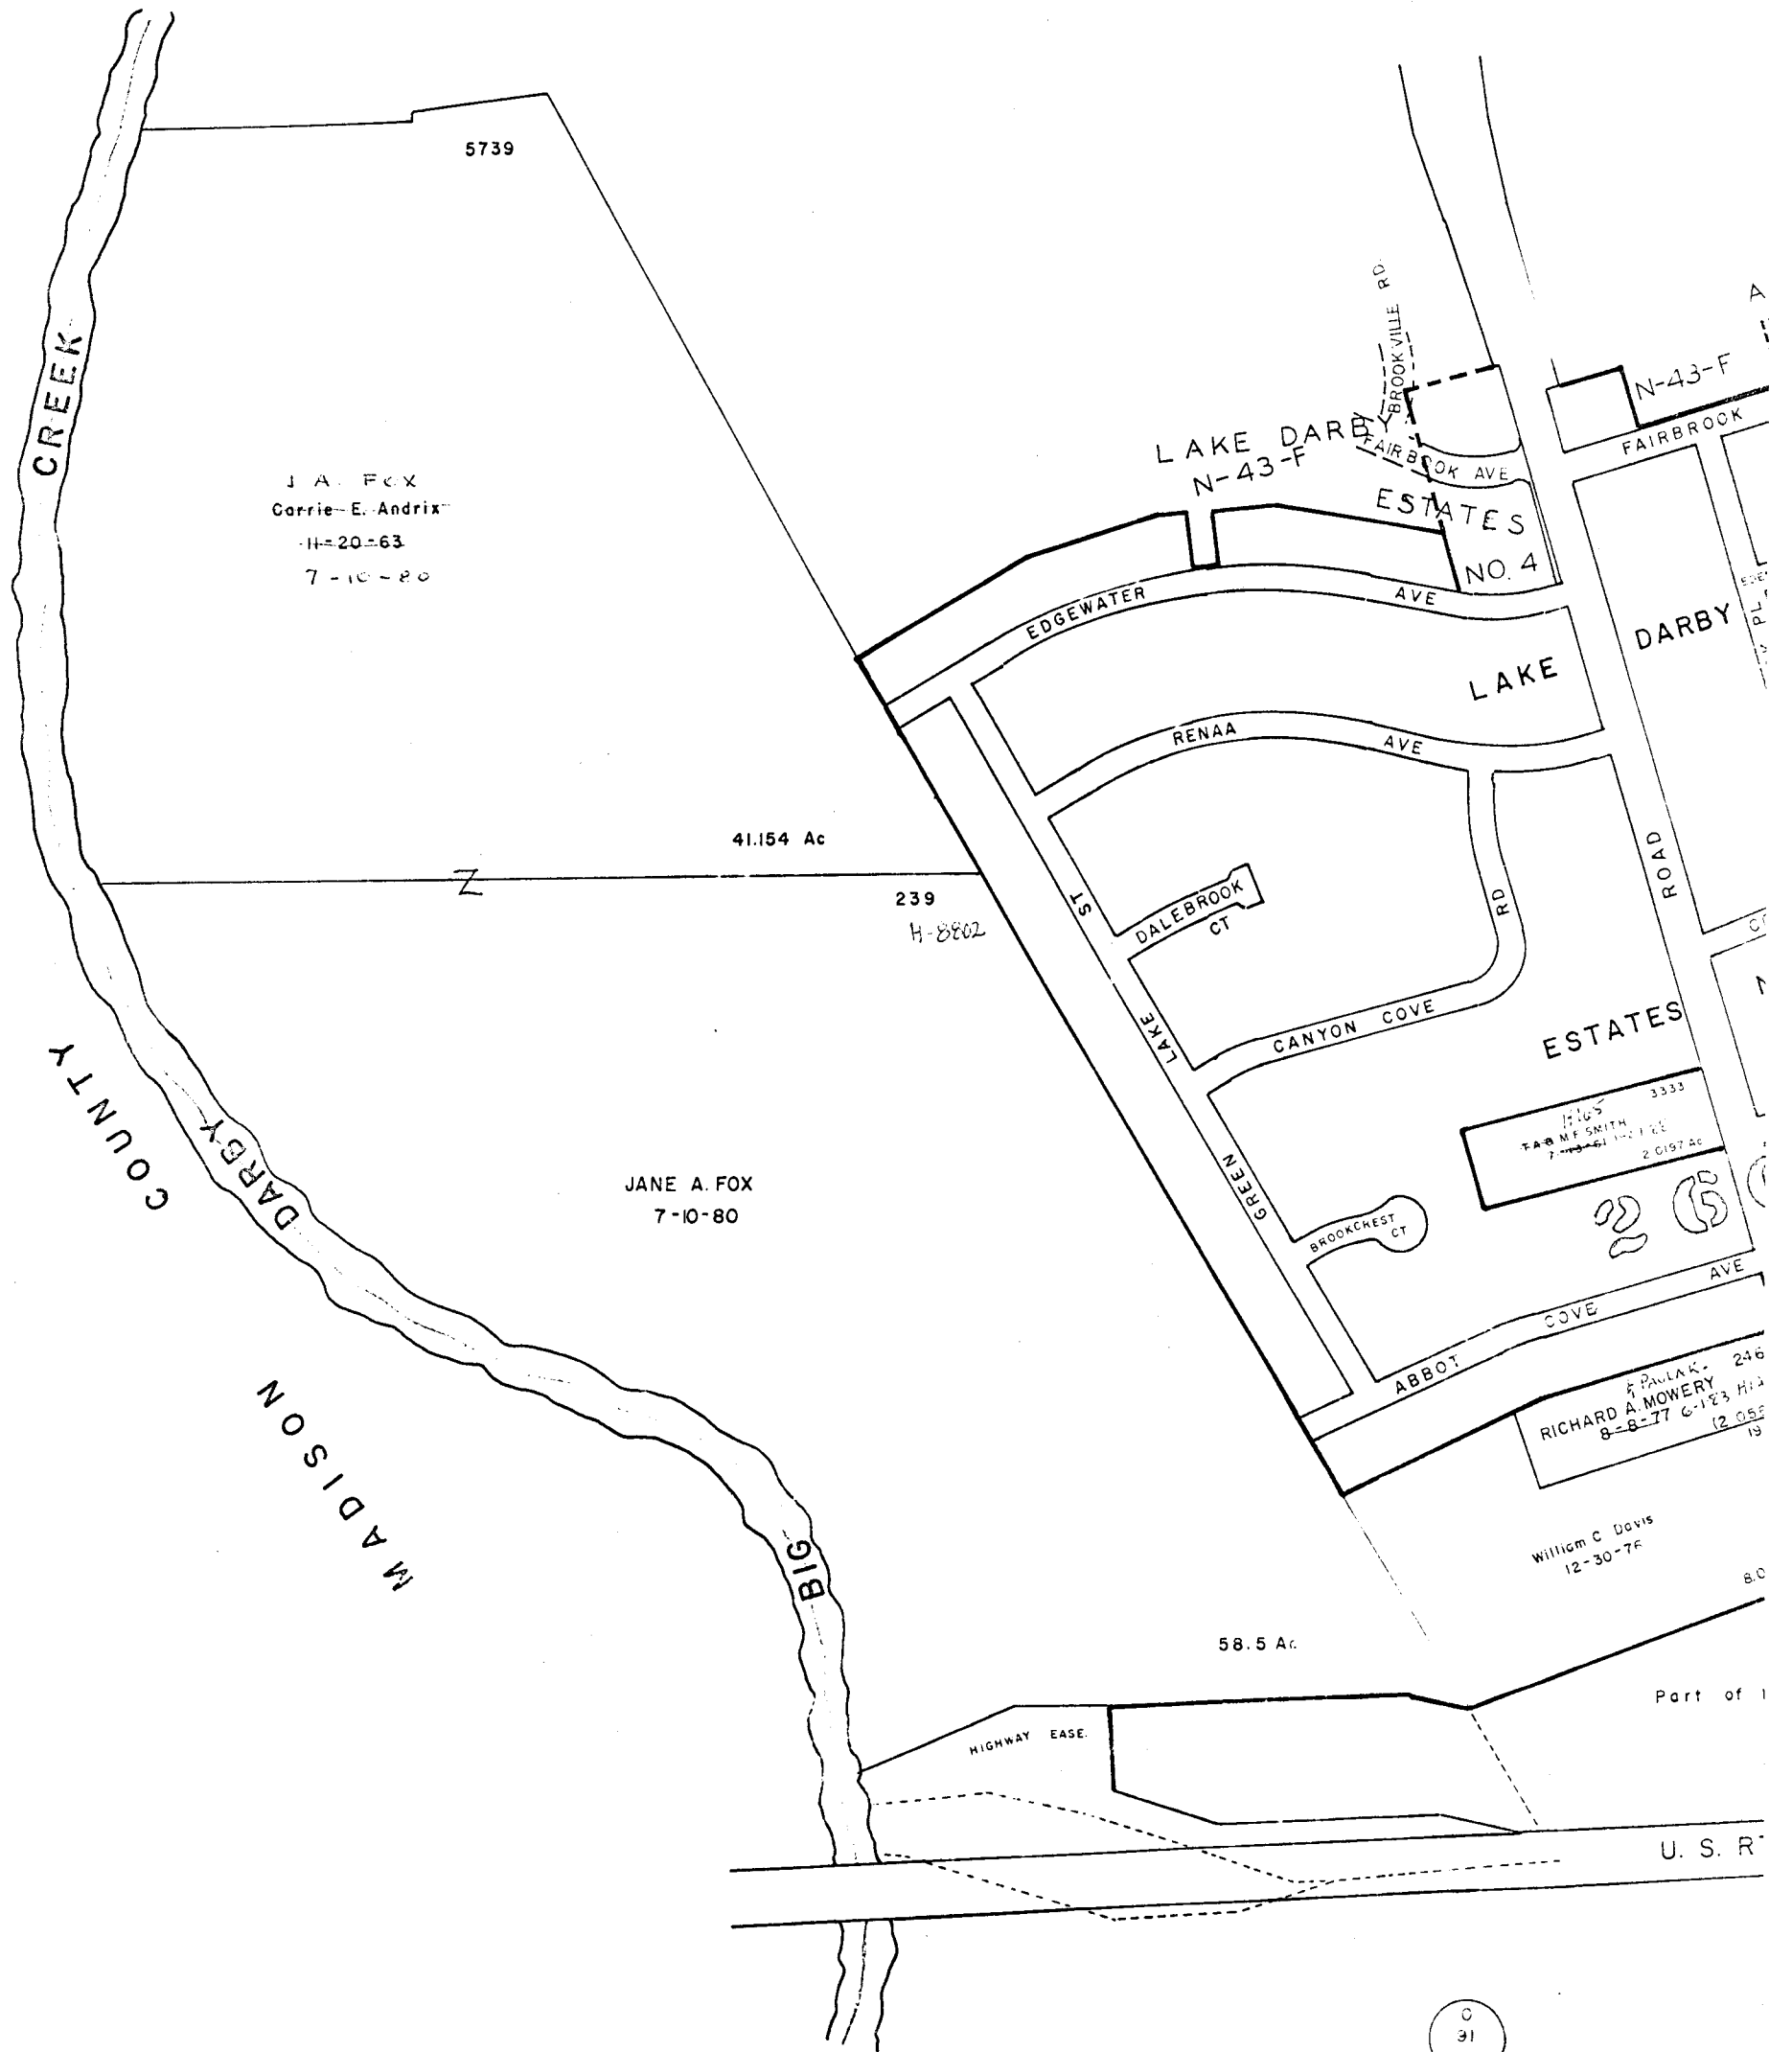


O-88-B
PRAIRIE TWP.

O
88
A



SCALE 1"=200'

V.M.S.
E=HIGHWAY EASEMENT
TAXING DISTRICTS DISTRICT CODE
PRAIRIE TWP 240
H--- HOUSE NUMBER

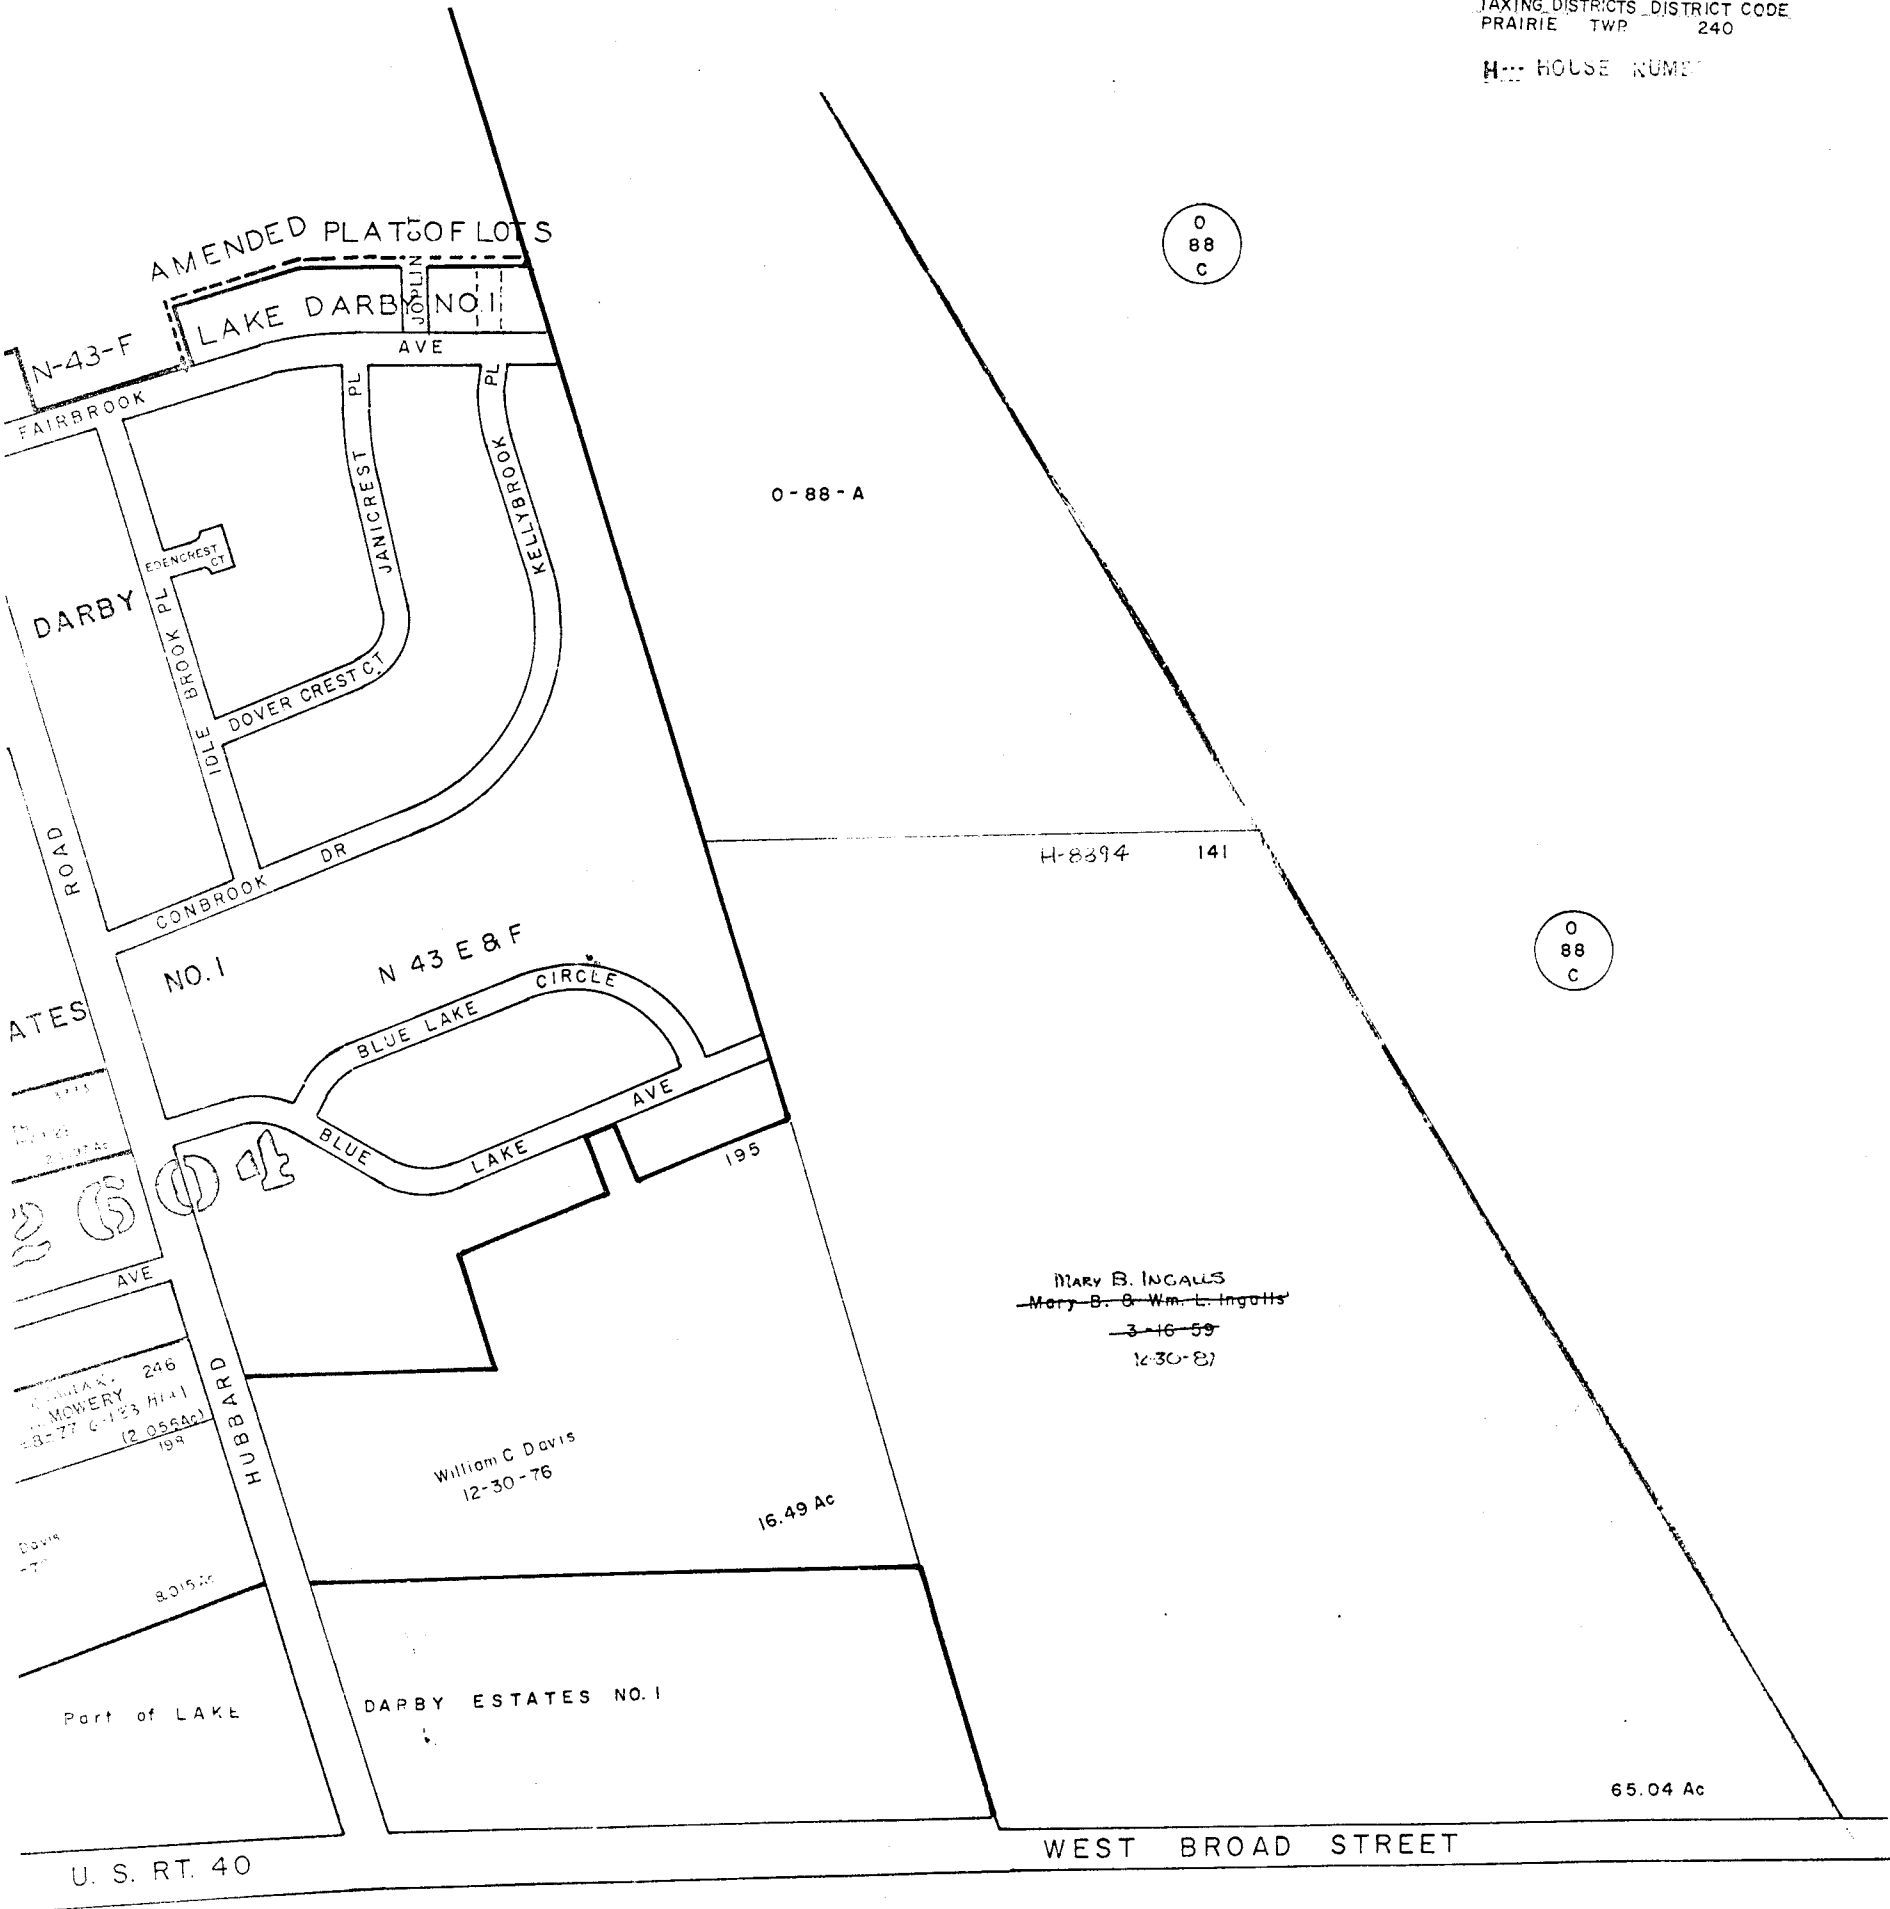

O
88
C

O
88
C

O
91
A

O-88-B

1290

