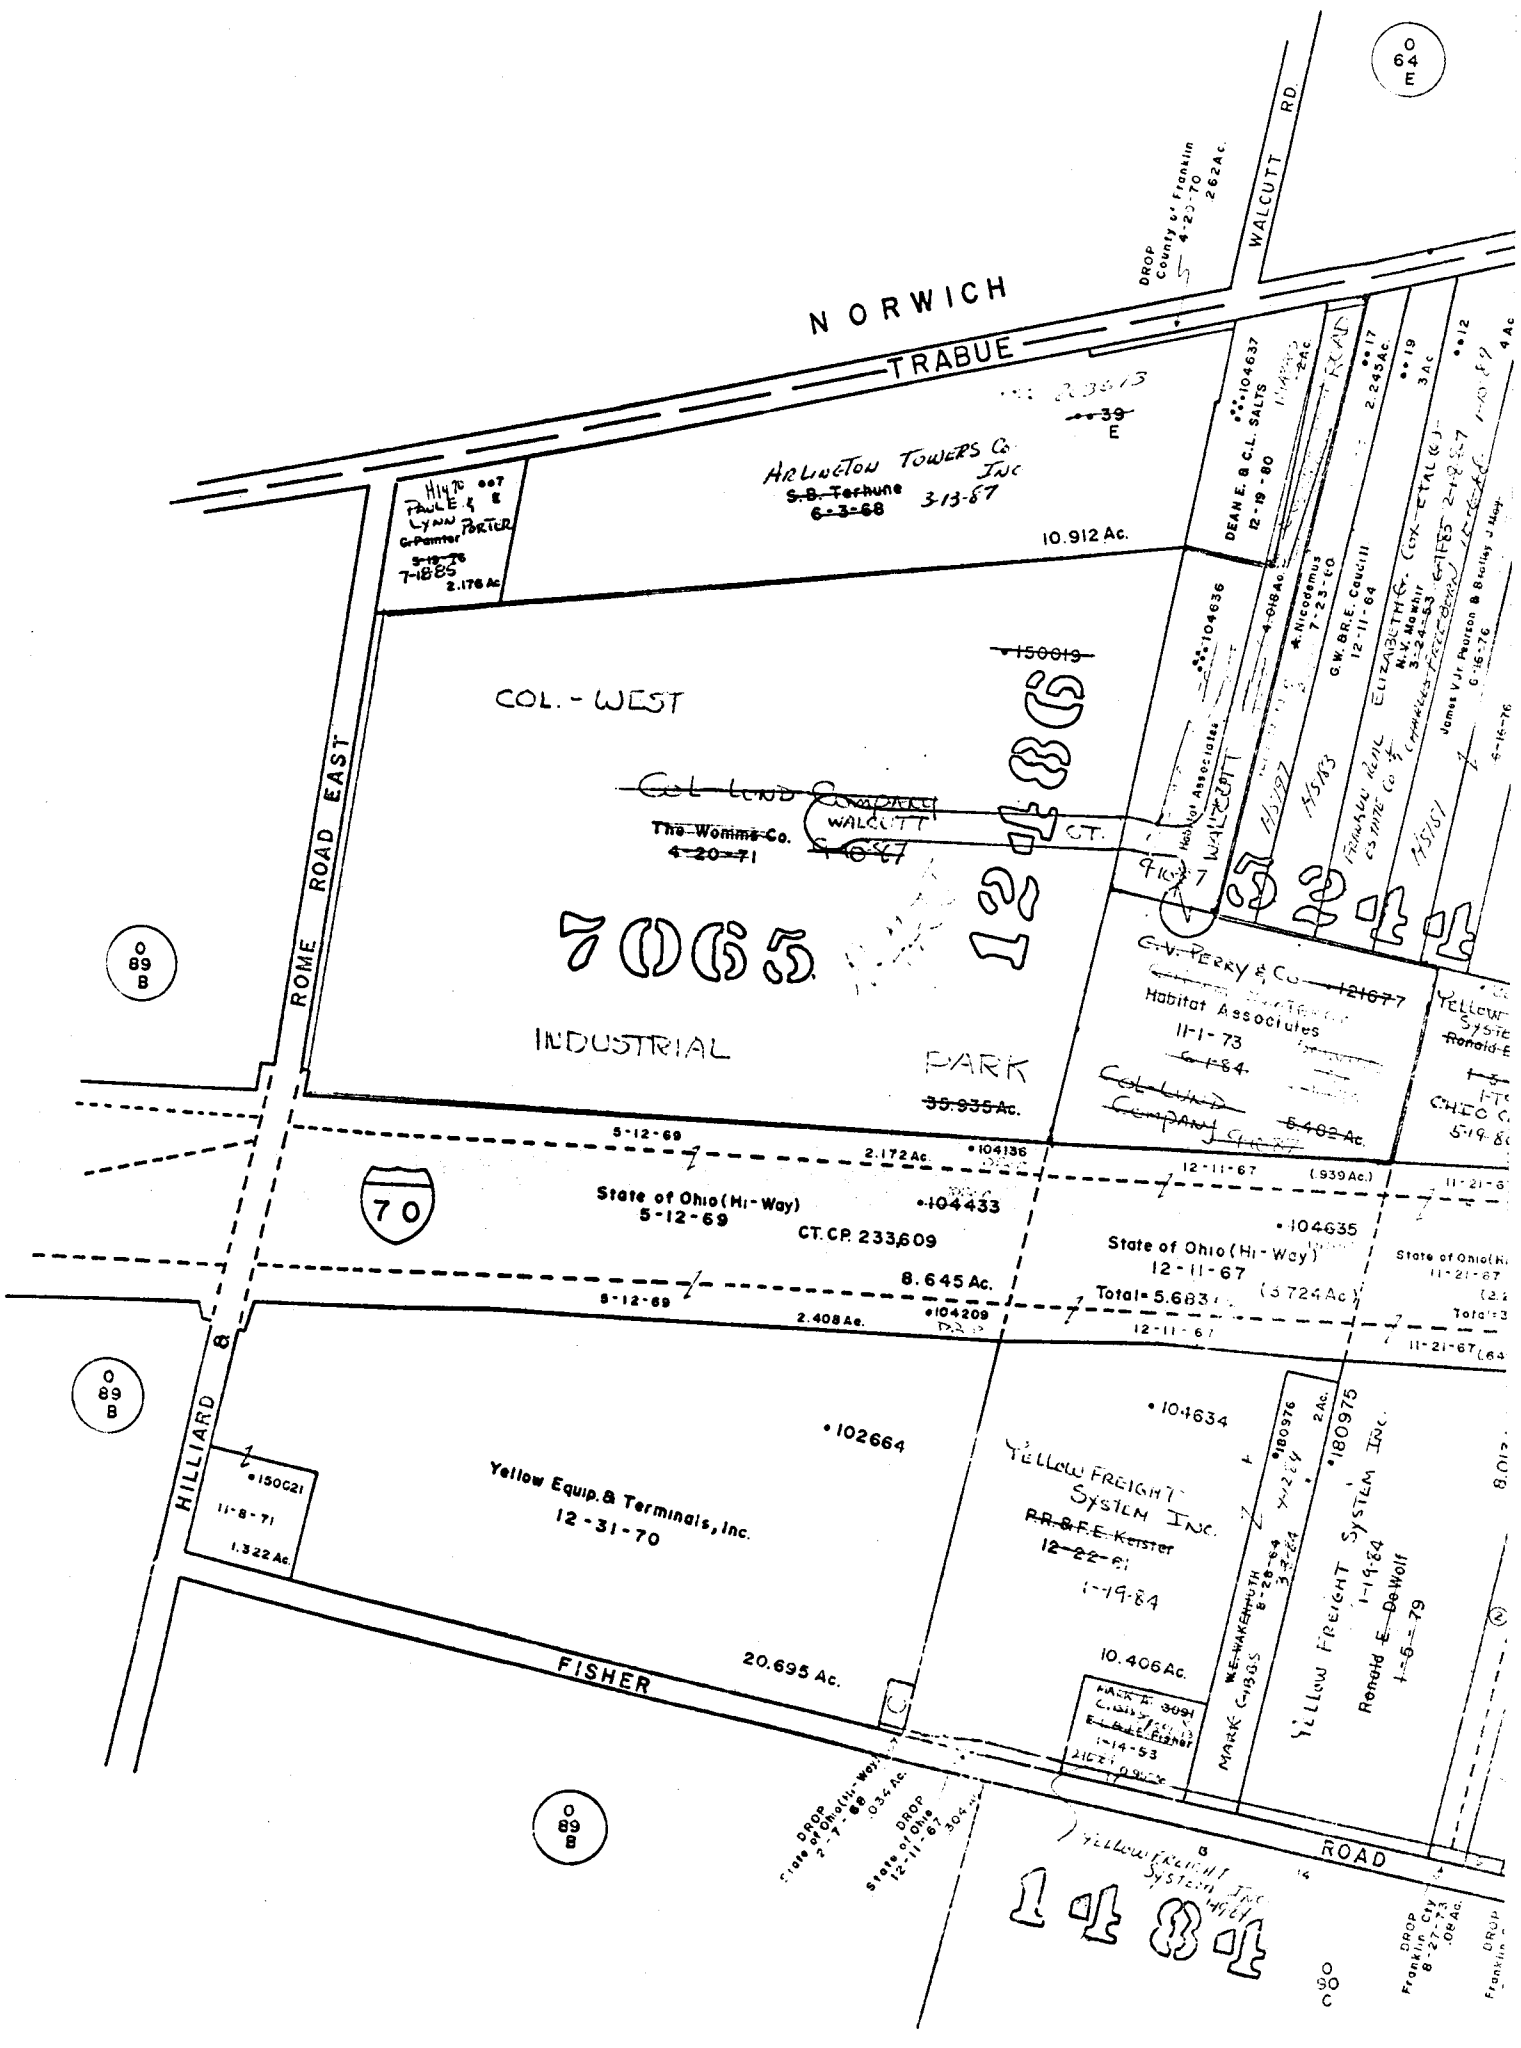
NORWICH
TRABUE
WALCUTT
RD.
ROME ROAD EAST
HILLIARD
FISHER
ROAD
COL. - WEST
INDUSTRIAL
PARK
7065
Arlington Towers Co. Inc
10.912 Ac.
Paul E. & Lynn Porter
2.176 Ac.
Dean E. & C.L. Salts
Nicodemus
G.W. B.R.E. Caudill
Elizabeth Cox - Et Al
N.V. Mawhir
James V. Jr. Pearson & Bailey J. May
Habitat Associates
G.V. Perry & Co.
Yellow
State of Ohio (Hi-Way)
5-12-69
CT. CP. 233,609
8.645 Ac.
2.172 Ac.
2.408 Ac.
State of Ohio (Hi-Way)
12-11-67
Total = 5.683
Yellow Equip. & Terminals, Inc.
12-31-70
1.322 Ac.
20.695 Ac.
Yellow Freight System Inc.
10.406 Ac.
Mark Gibbs
Yellow Freight System Inc.
Ronald E. DeWolf
1-5-79
DROP
Franklin Cty
8-27-73
.08 Ac.
70

O-90-A

PRAIRIE TWP.

N

SCALE 1" = 200'

V.M.S.

E = HIGHWAY EASEMENT

TAXING DISTRICTS	DISTRICT CODE
PRAIRIE TWP.	240
•COLS.-SOUTHWESTERN S.D.	570
••PRAIRIE TWP. ~~SCIOTO~~ DARBY S.D. HILLIARD CITY SD	241
••COLS.-~~SCIOTO~~ DARBY S.D.	560

HILLIARD CITY SCHOOL DIST.

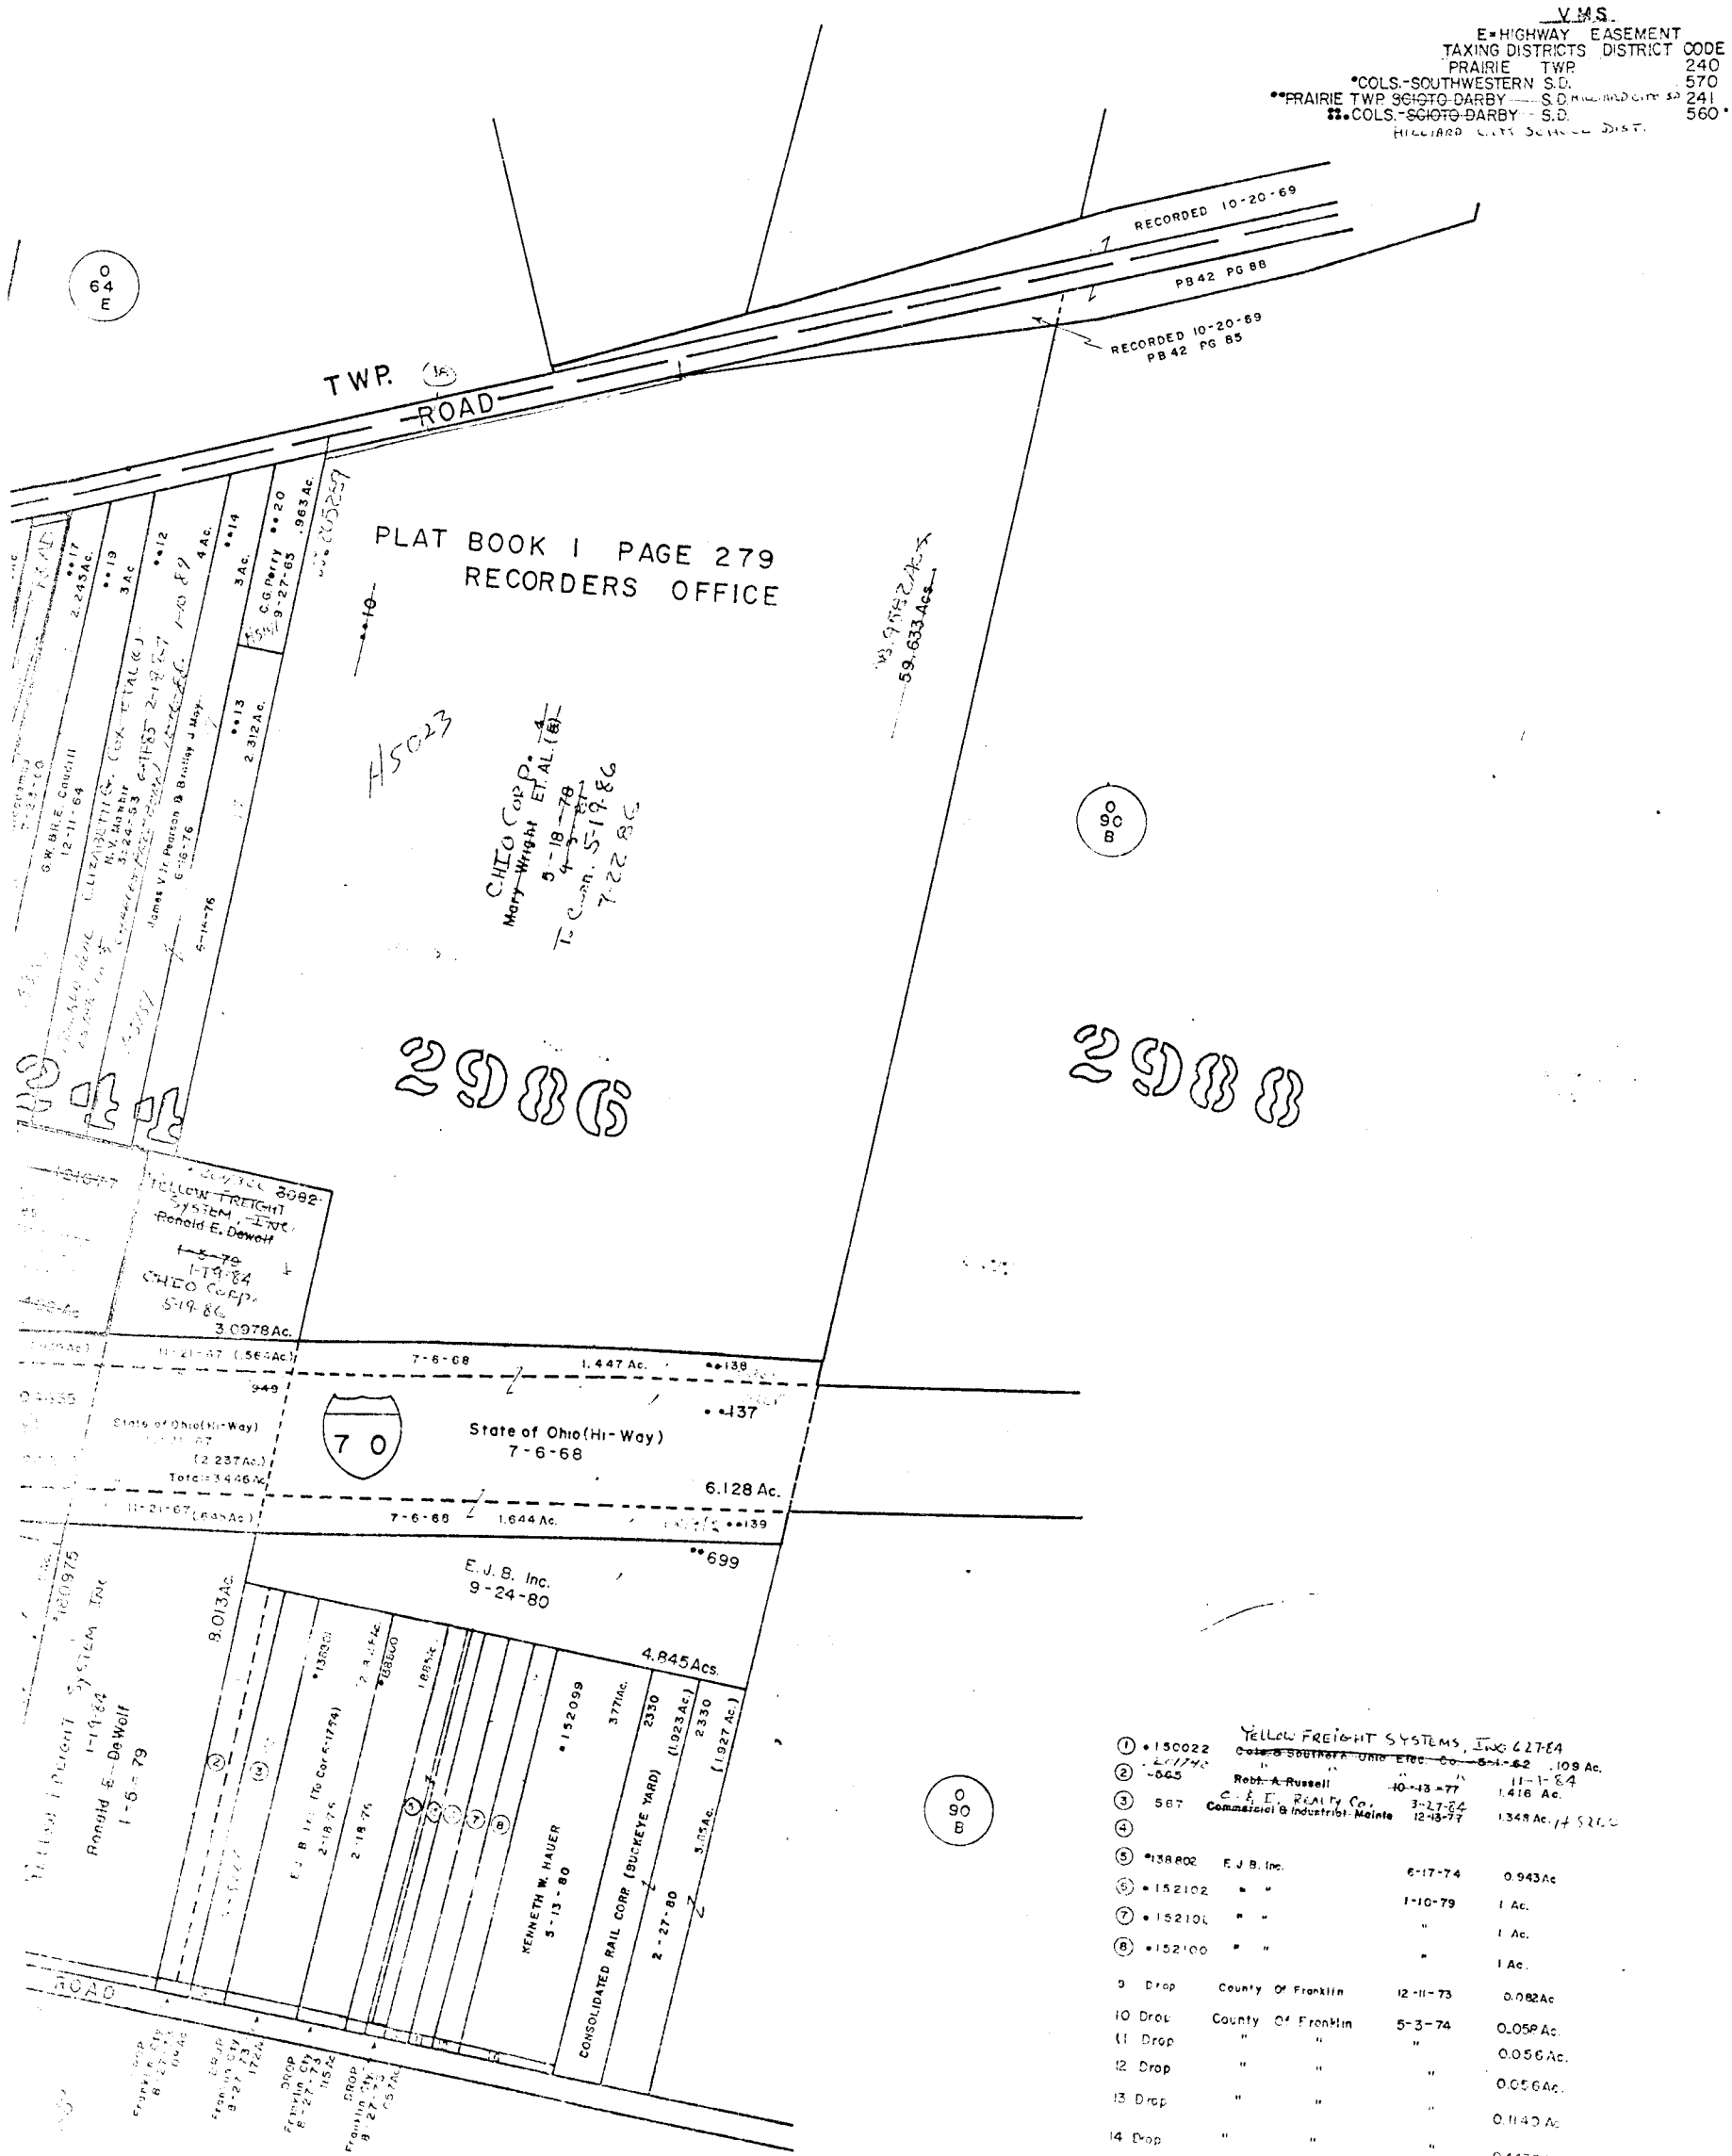

1	•150022	YELLOW FREIGHT SYSTEMS, INC.	6-27-84	
2	~~•138802~~	~~Cole & Southern Ohio Elec. Co.~~	~~5-1-62~~	.108 Ac.
	~~•665~~	" " " "		11-1-84
3	567	Robt. A. Russell	~~10-13-77~~	1.416 Ac.
4		C. B. I. Realty Co. Commercial & Industrial Mainte	3-27-84 12-13-77	1.348 Ac.
5	•138802	E.J.B. Inc.	6-17-74	0.943 Ac
6	•152102	" "	1-10-79	1 Ac.
7	•152101	" "	"	1 Ac.
8	•152100	" "	"	1 Ac.
9	Drop	County Of Franklin	12-11-73	0.082 Ac
10	Drop	County Of Franklin	5-3-74	0.058 Ac.
11	Drop	" "	"	0.056 Ac.
12	Drop	" "	"	0.056 Ac.
13	Drop	" "	"	0.1140 Ac
14	Drop	" "	"	0.4432 Ac
15	Drop	City Of Columbus	5-13-74	0.755 Ac
16	Drop	City Of Columbus	8-27-74	0.229 Ac
17	Drop	Franklin County Bd Of Comms	10-10-74	0.29 Ac.

O-90-A

1318