


0
65
A

0
64
E

0
90
A

0
90
A

0
90
C

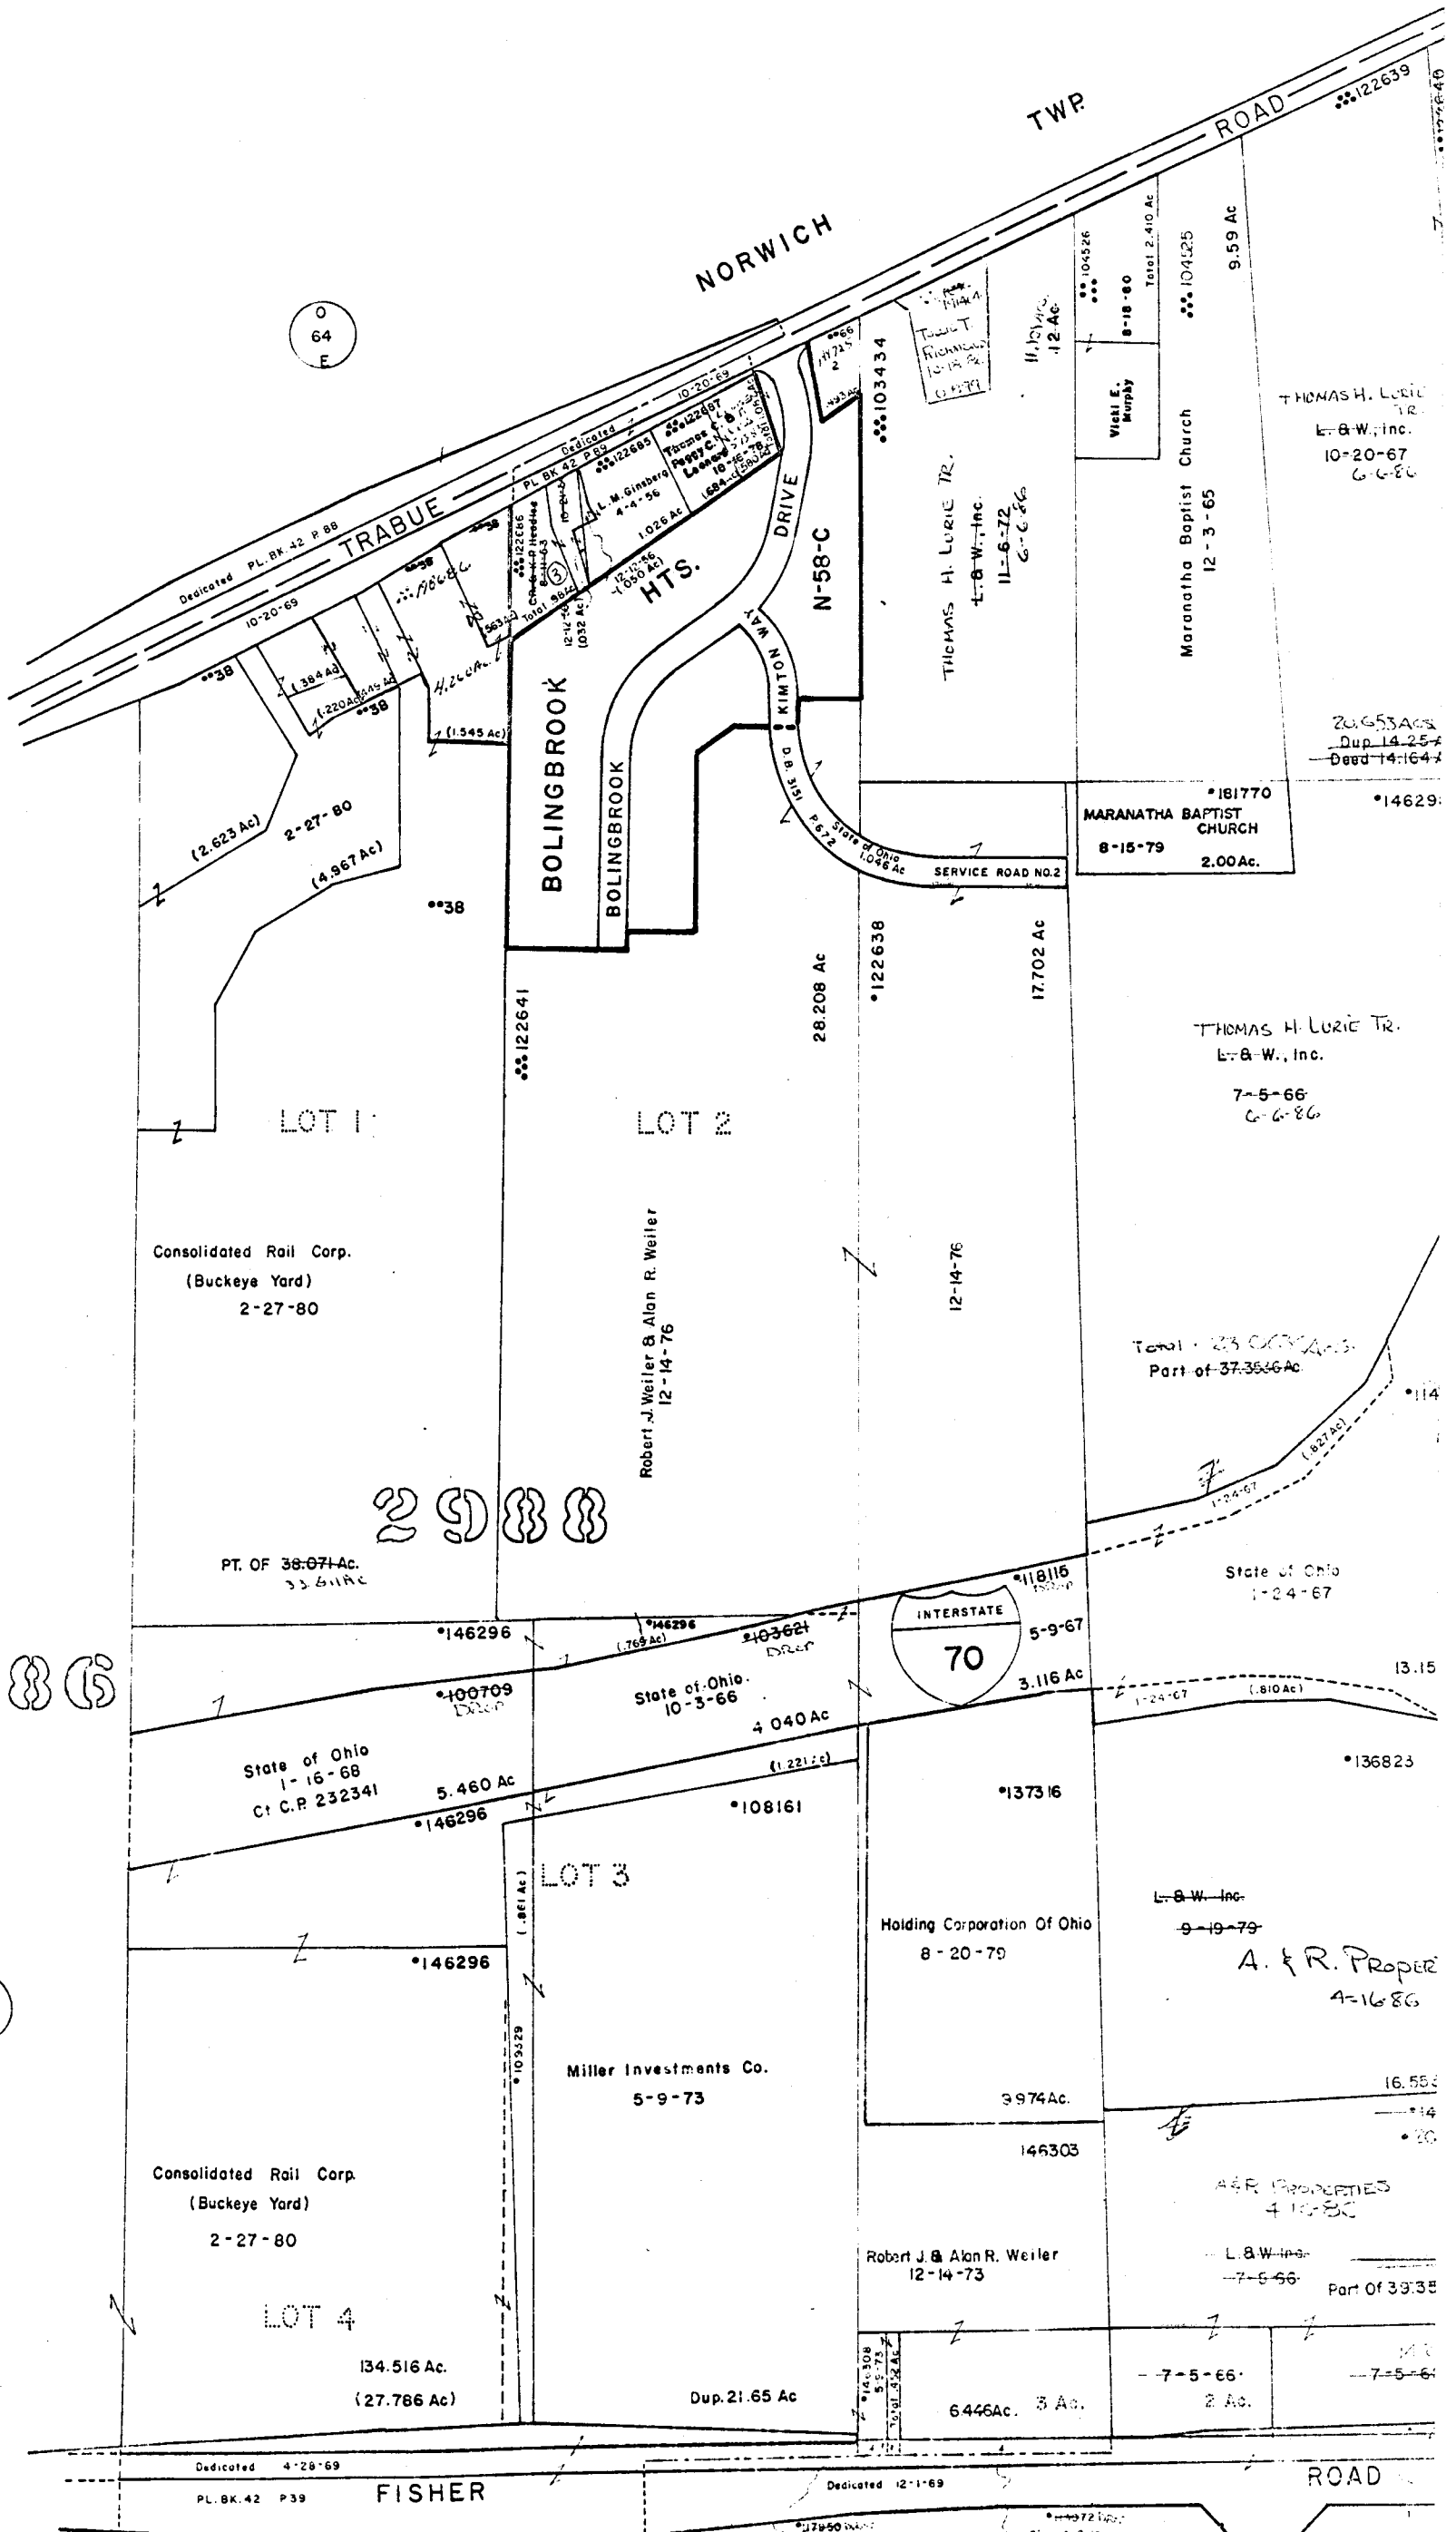

2986

2988

