


12183
2183
2983

0
90
A

0
89
B

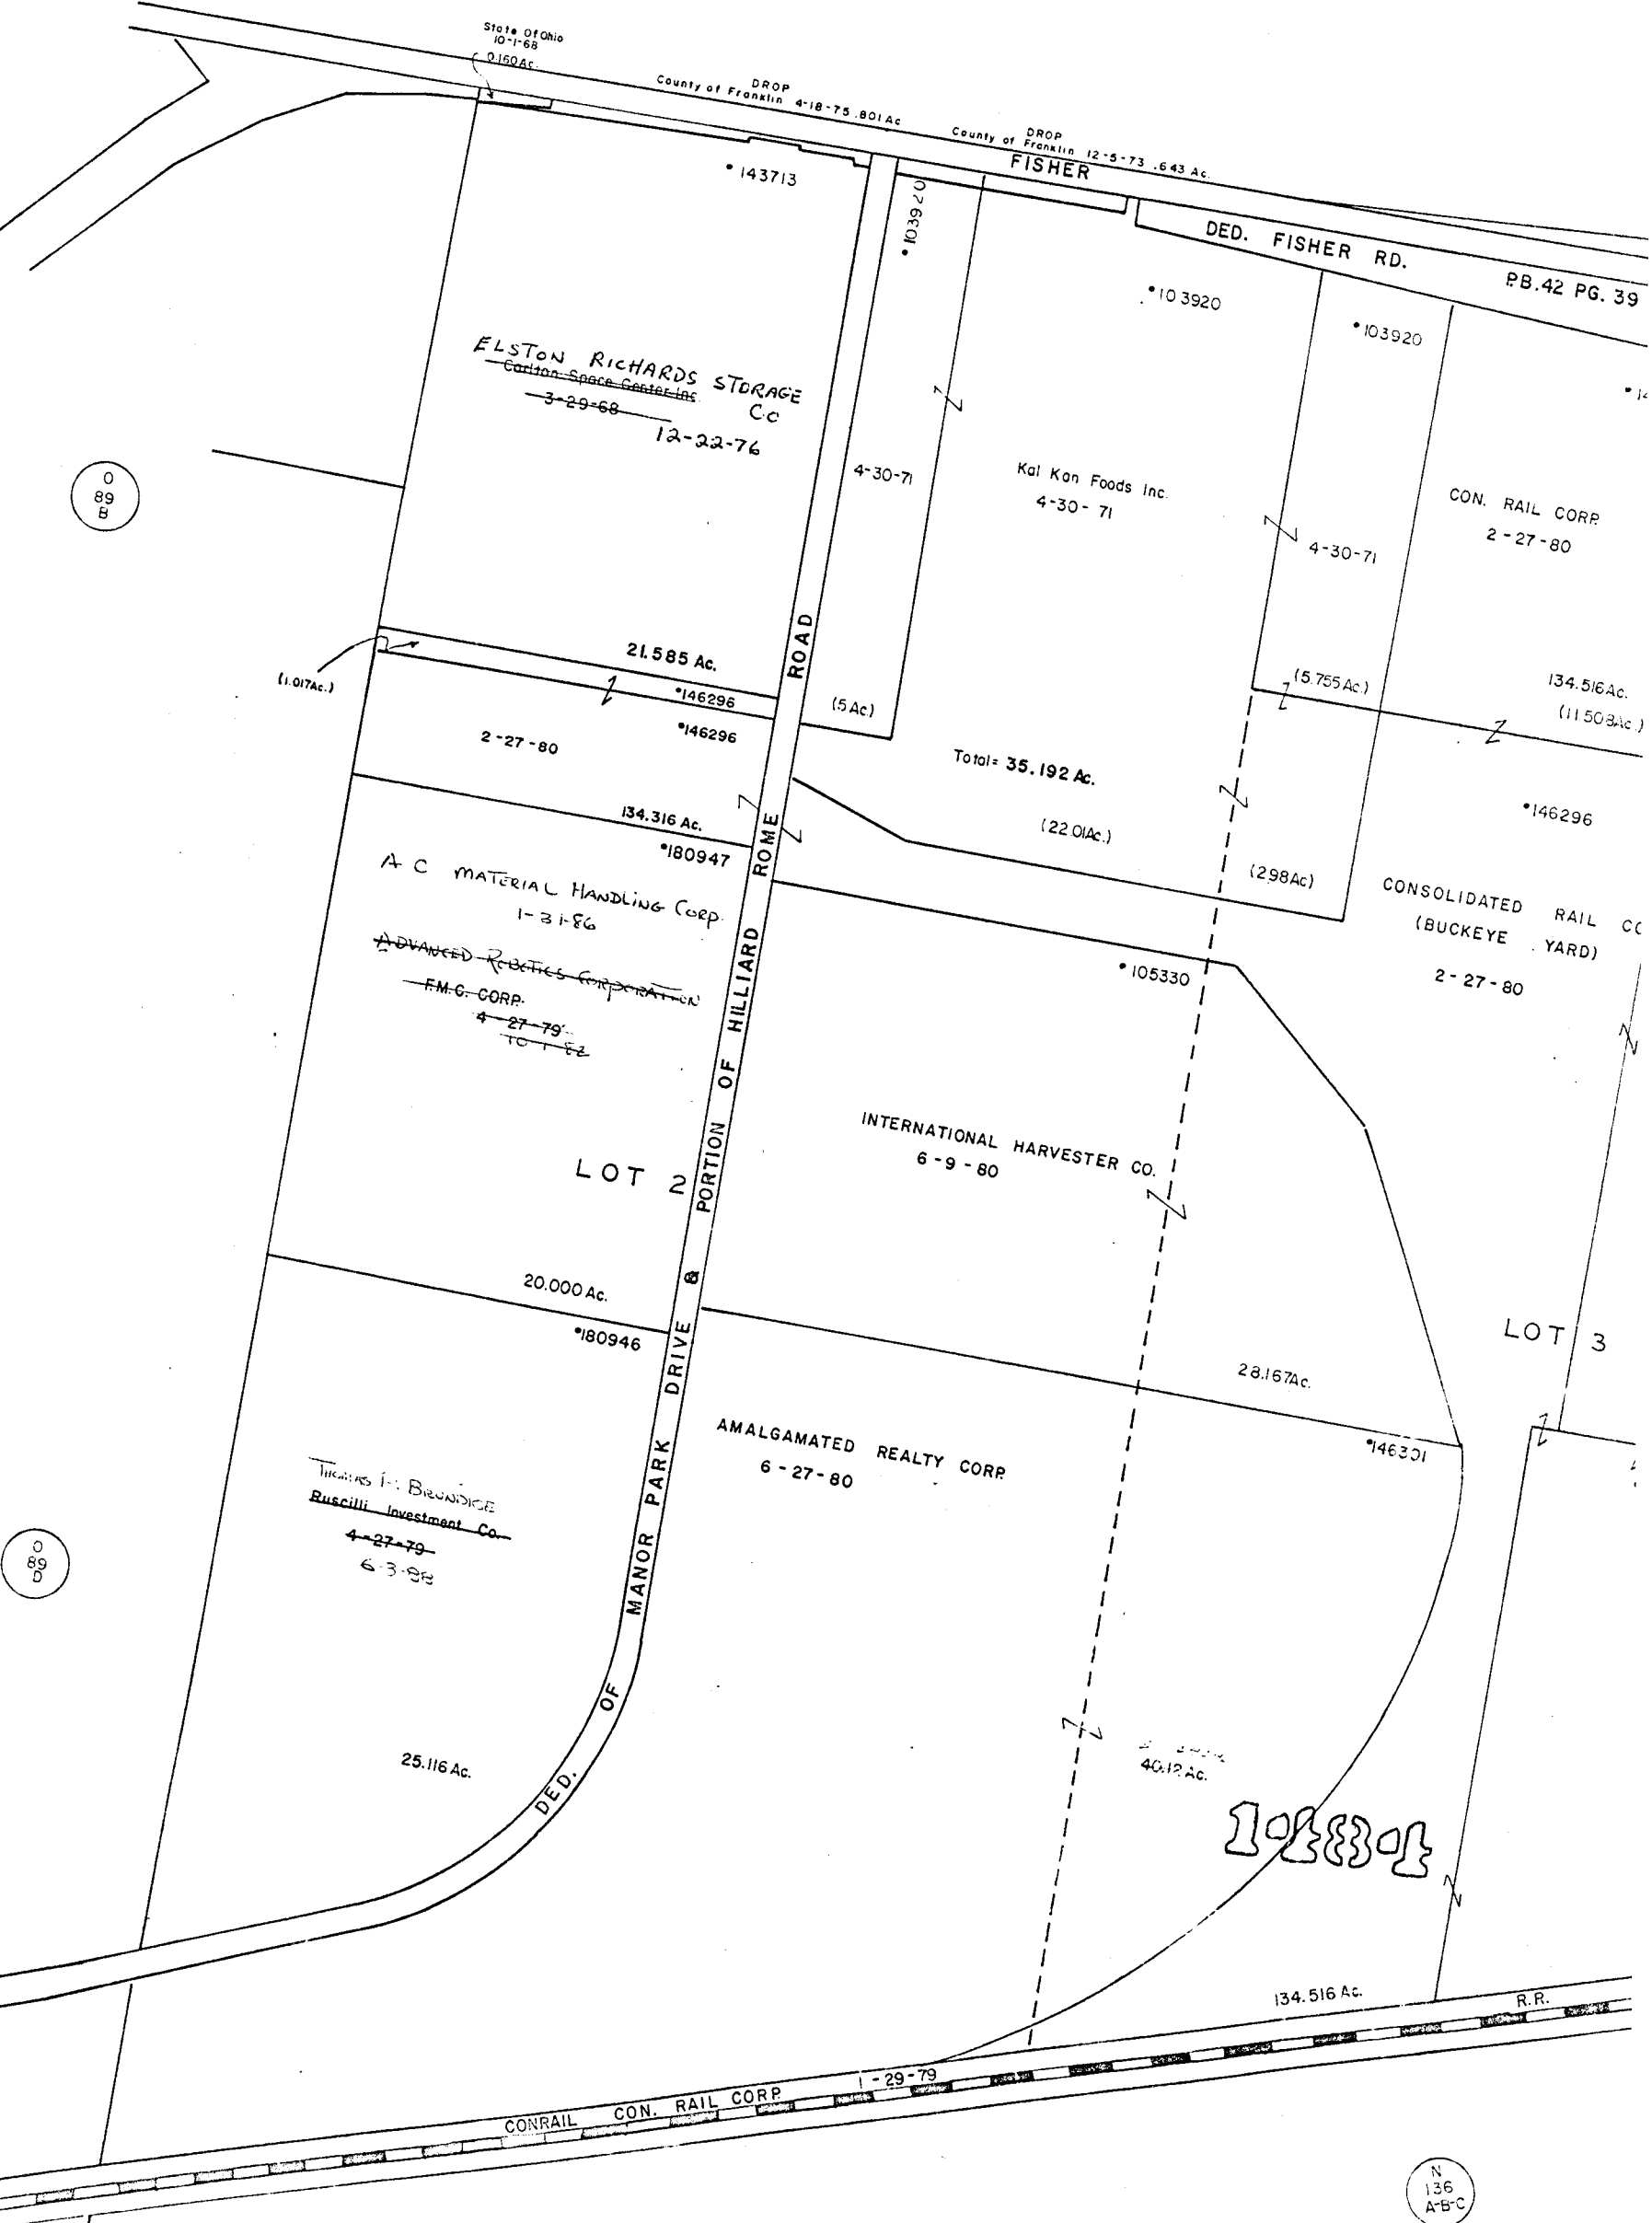

12183

N
136
A-B-C

