

0
94
A

0
91
G

0
78
A

2885

2886

PRAIRIE
PLEASANT

TWP
TWP

Joseph W. & Rose I. Murnane
10-16-52

John E. & Mabel J.
William H. Emmelhainz
3-11-25 102.92 Ac.

99.9 Ac.

108.92 Ac.

10.5 Ac.

Wendell P. & Hilda M. Strenhorf
6-24-69

Frank E. & Nancy L.
Alice L. & Gibbs O. Kugel
11-14-35
6-7-78
6-19-85

7 Ac.

Richard C. & Gladys Wolfe
7-1-76

96

14879

Map
B

O-94-C
PRAIRIE TWP.




SCALE 1"=200'

VMS

E=HIGHWAY EASEMENT	TAXING DISTRICTS	DISTRICT	CODE
	PRAIRIE TWP.		240
	PLEASANT TWP.		230

H... HOUSE NUMBERS

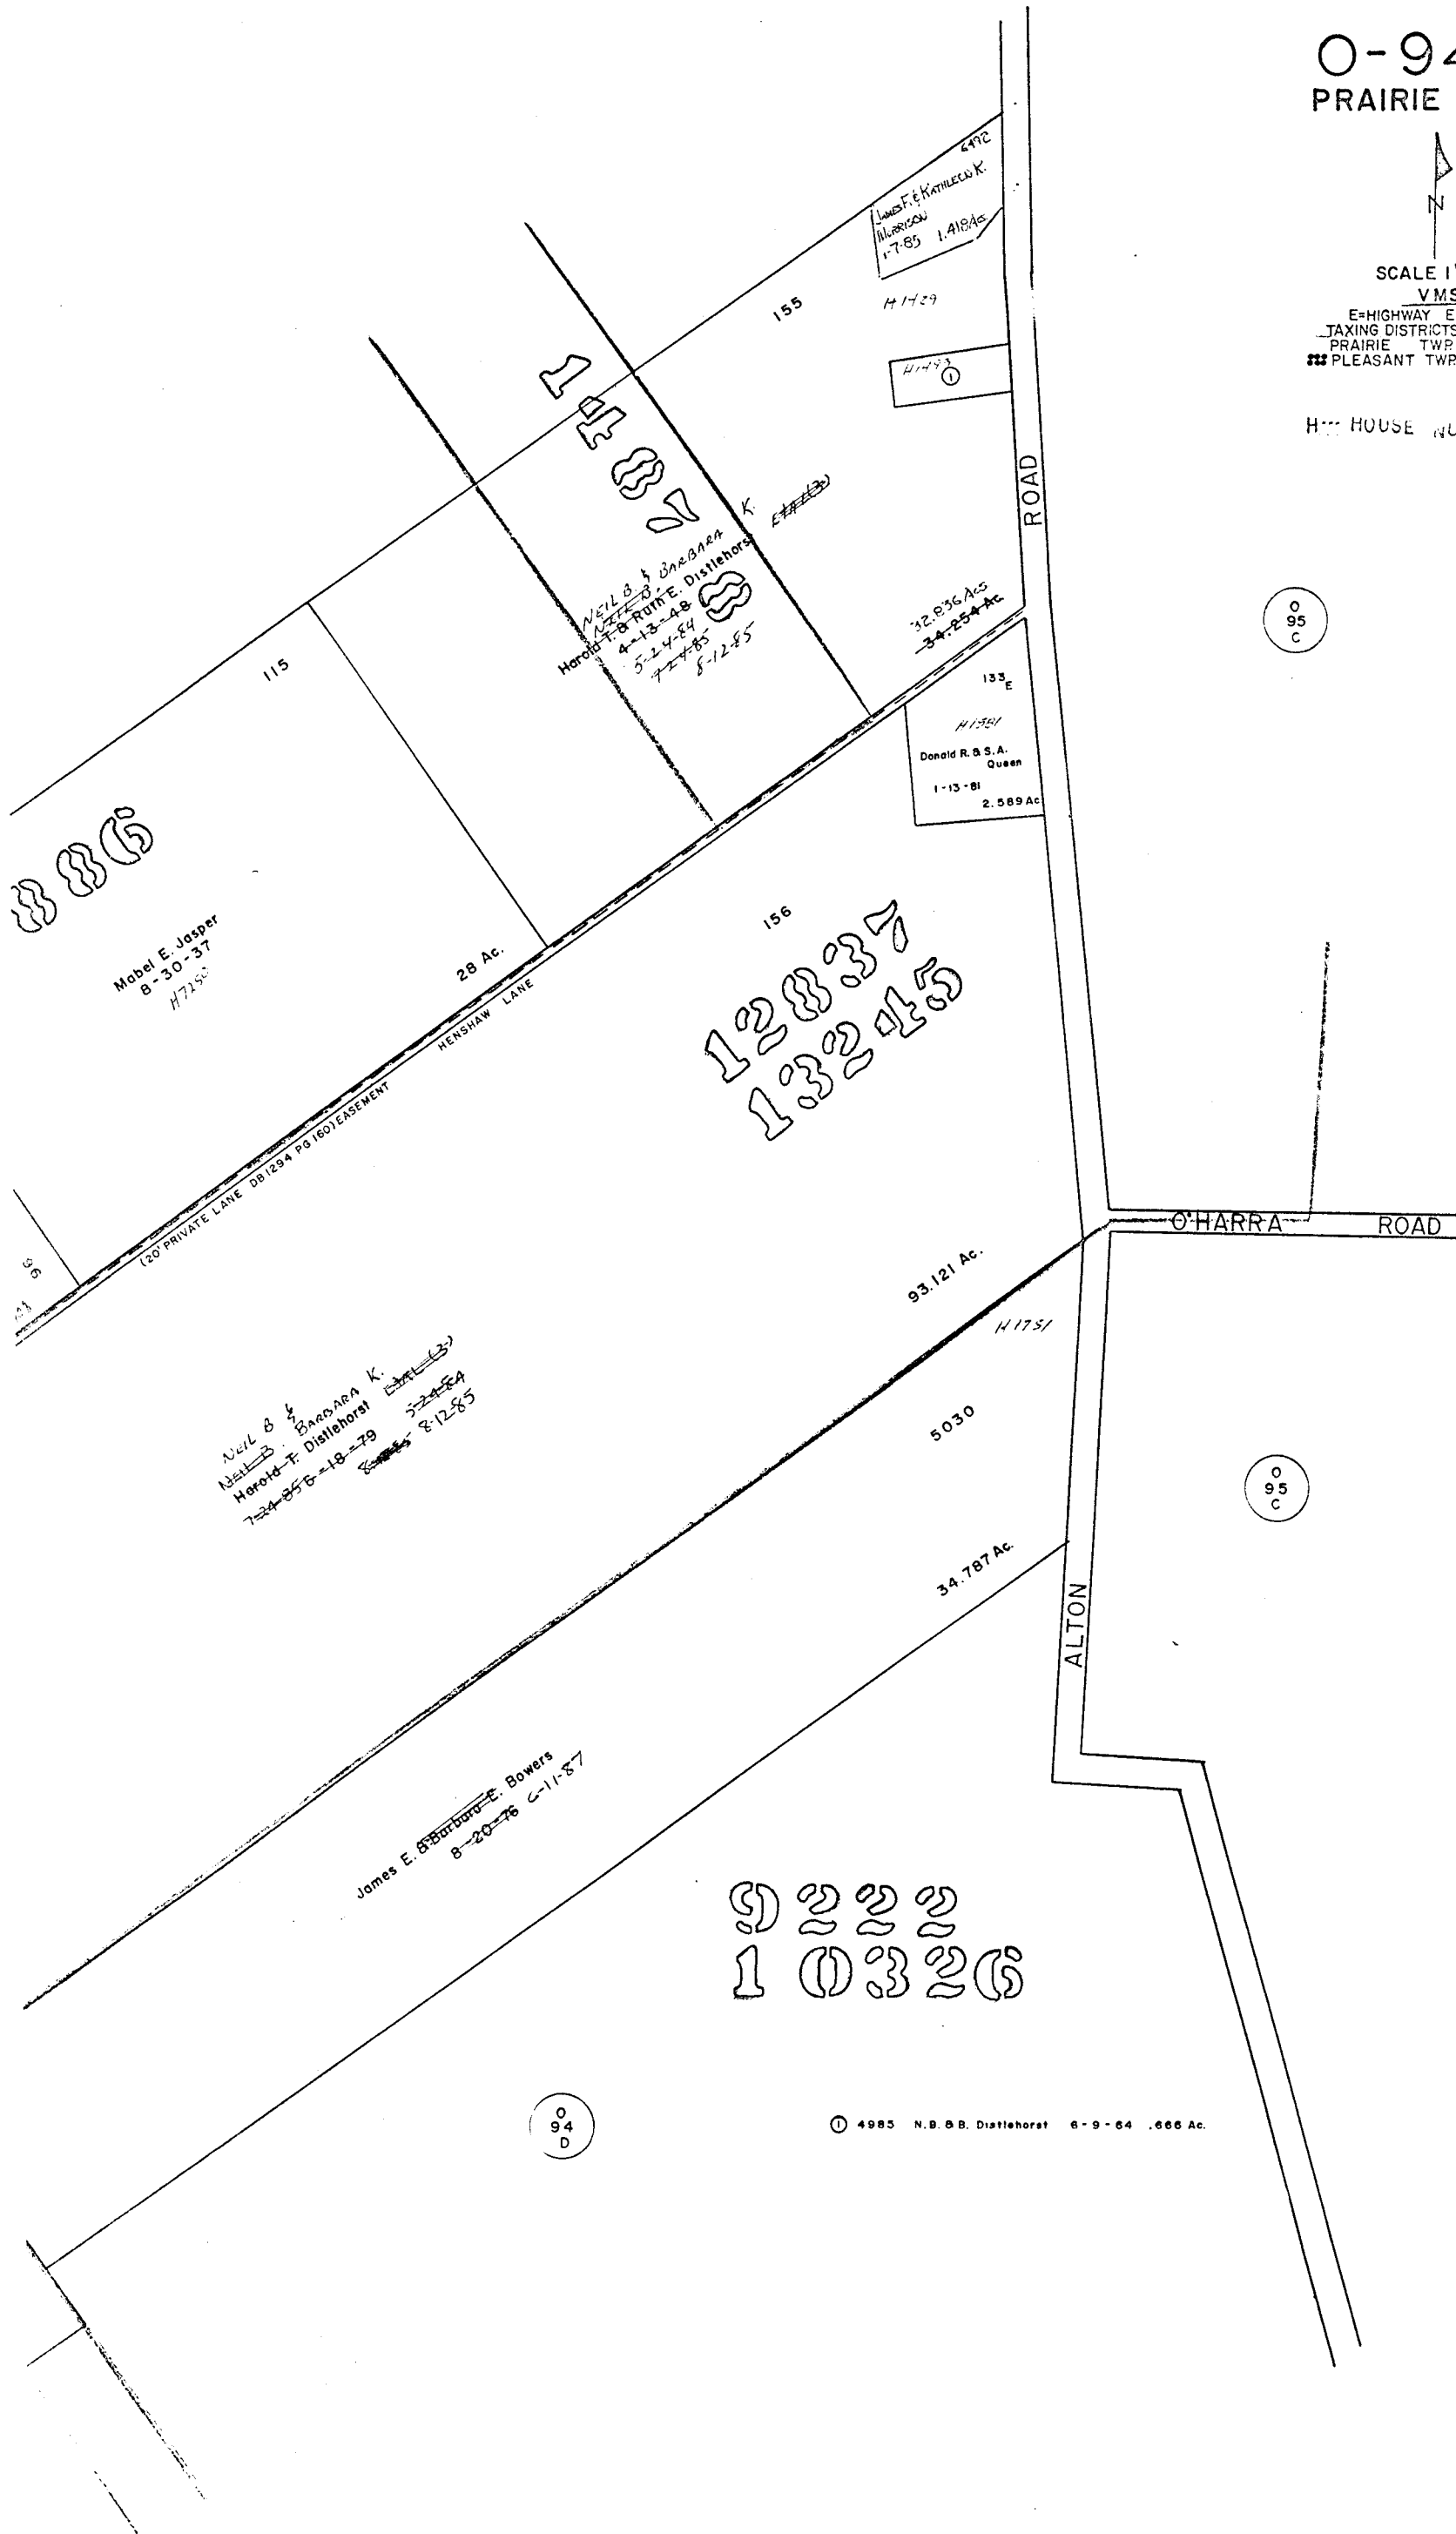

① 4983 N.B.B. Distlehorst 6-9-64 .666 Ac.

O-94-C

DATE	BY	REVISION
5/11/72		