


PROP 10-30-86  
City of Col. 0.577Ac

# DELAWARE

DROP City of Col. 7-23-86 0.355Ac

Prop City of Col. 0.398Ac

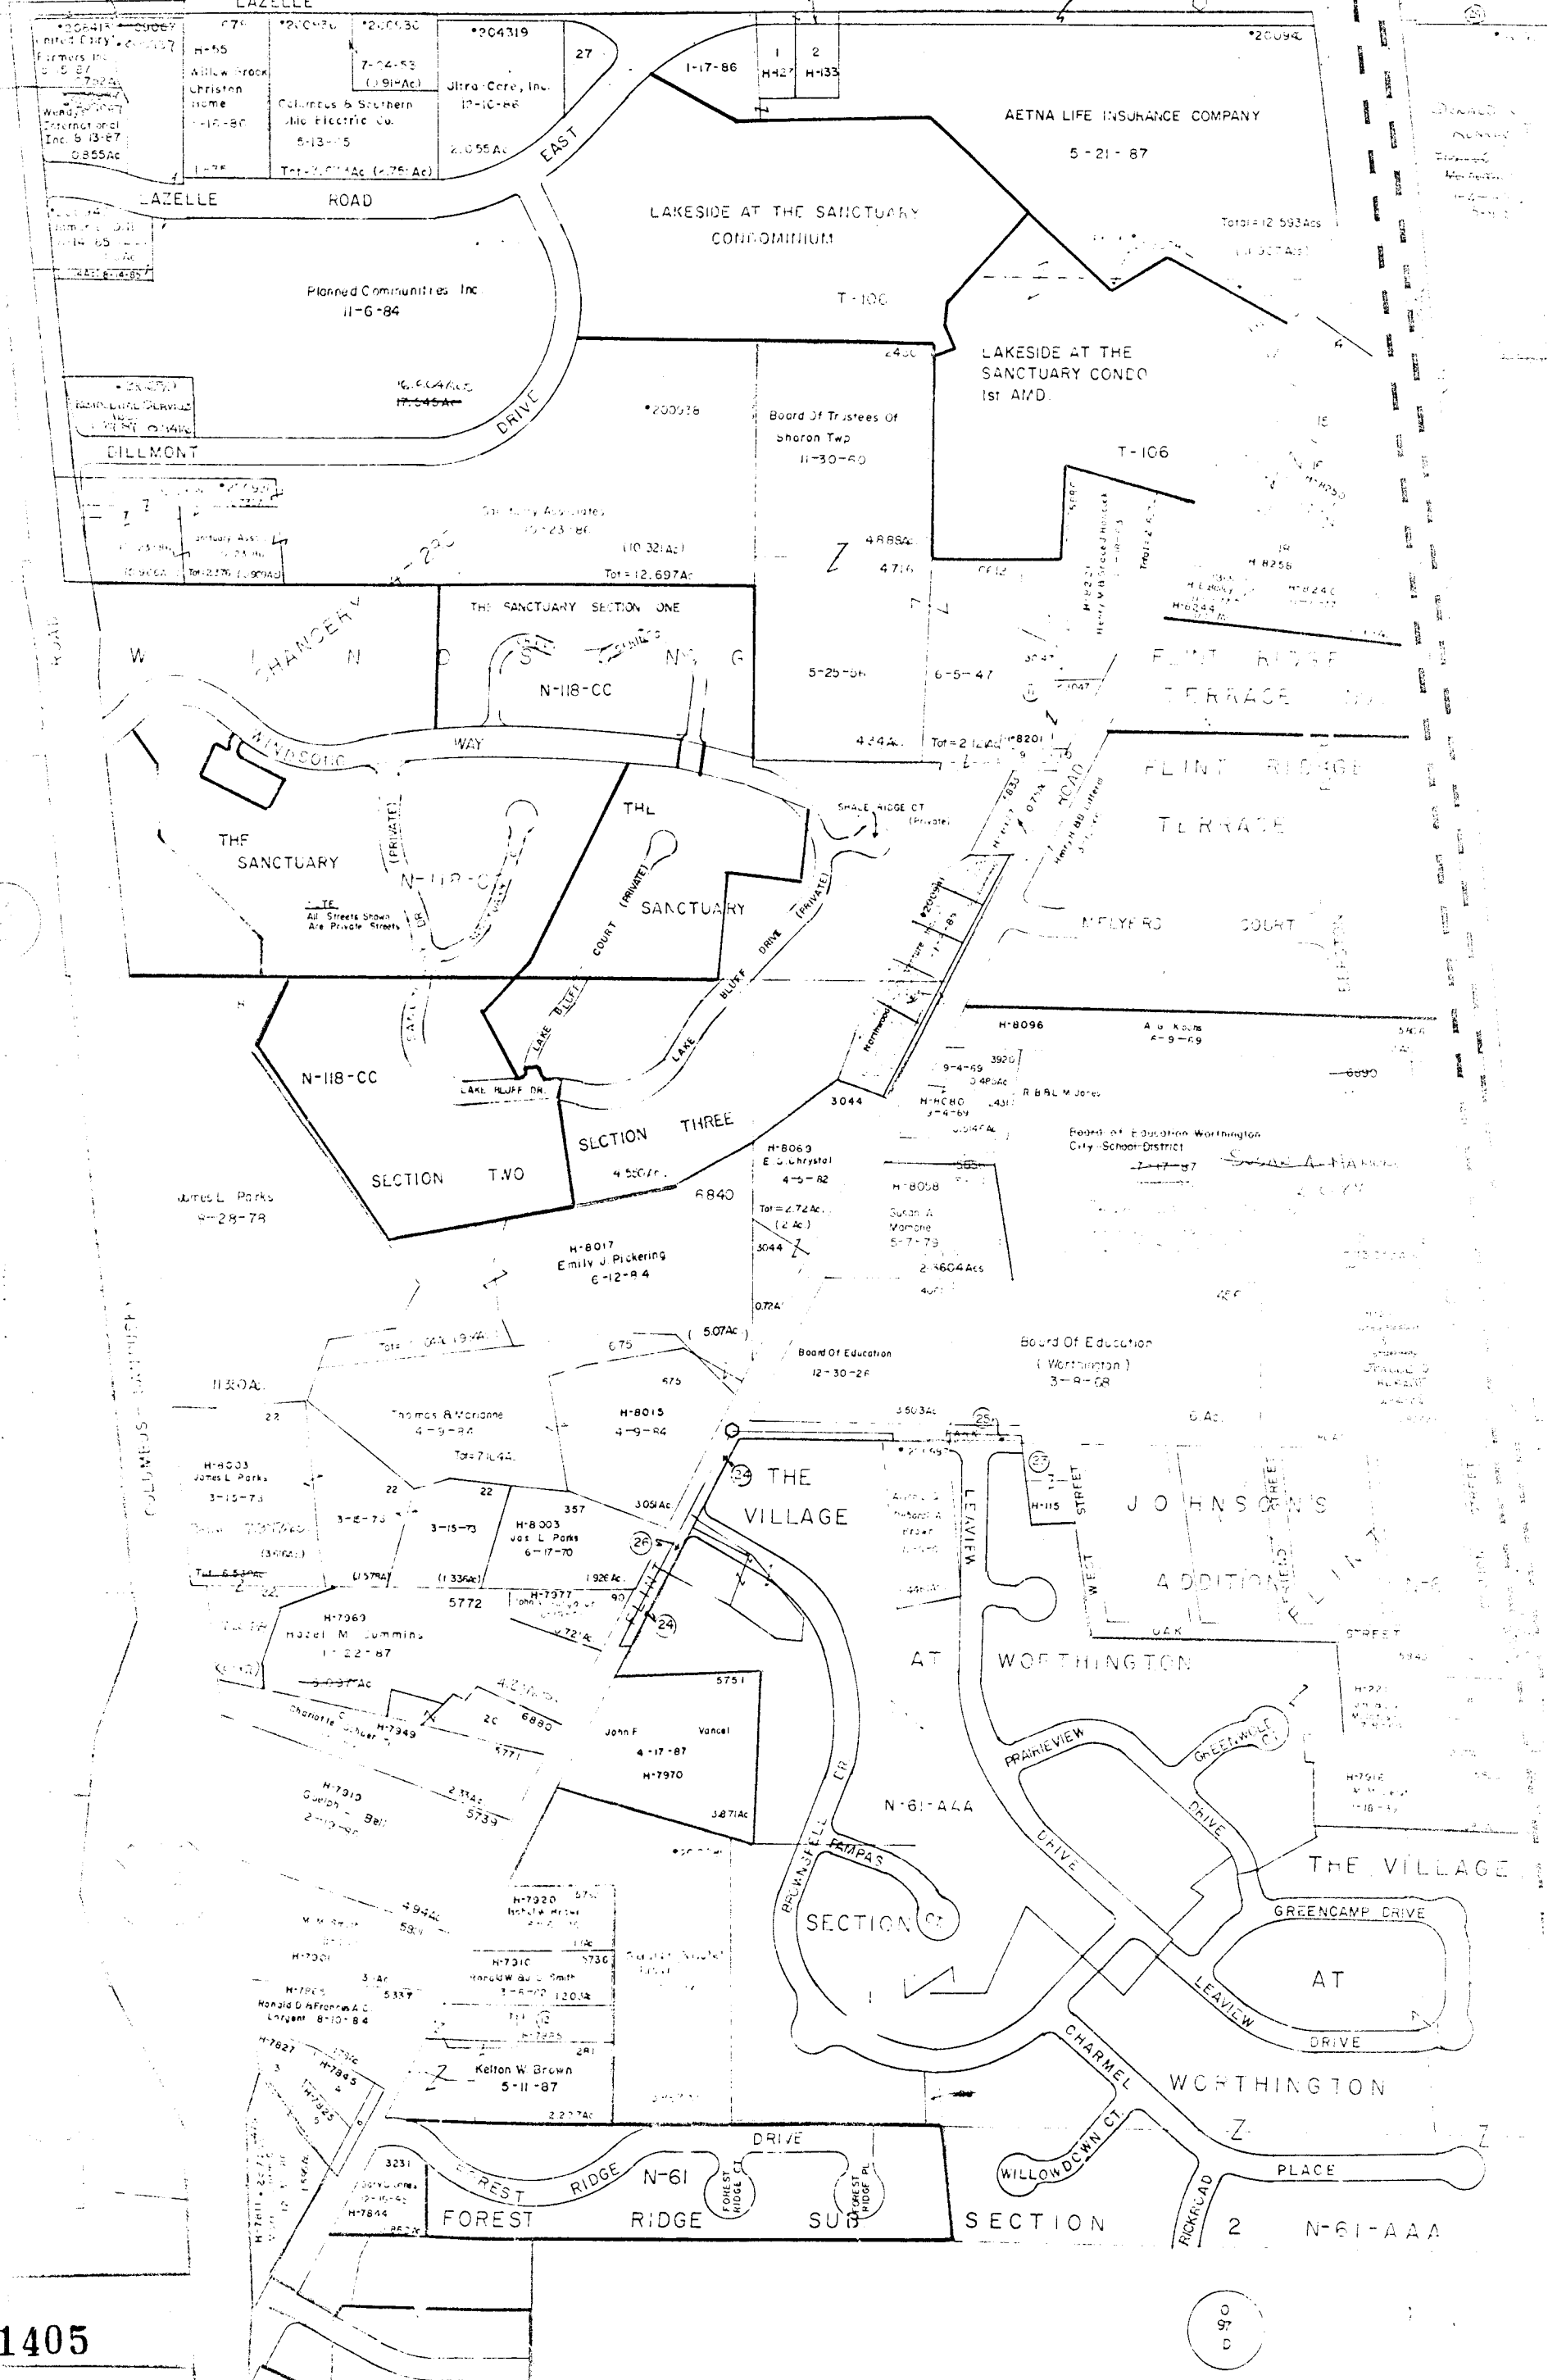


COUNTY

O-97-B

SHARON R.18 TWP 2 TWP2

SCALE = 1" = 200'  
E = HIGHWAY EASEMENT  
TAXING DISTRICT DISTRICT CODE  
SHARON 250  
\*COLS WORTH S.D. 910  
FRANKLIN COUNTY SURVEY MONUMENT  
H---HOUSE NUMBERS

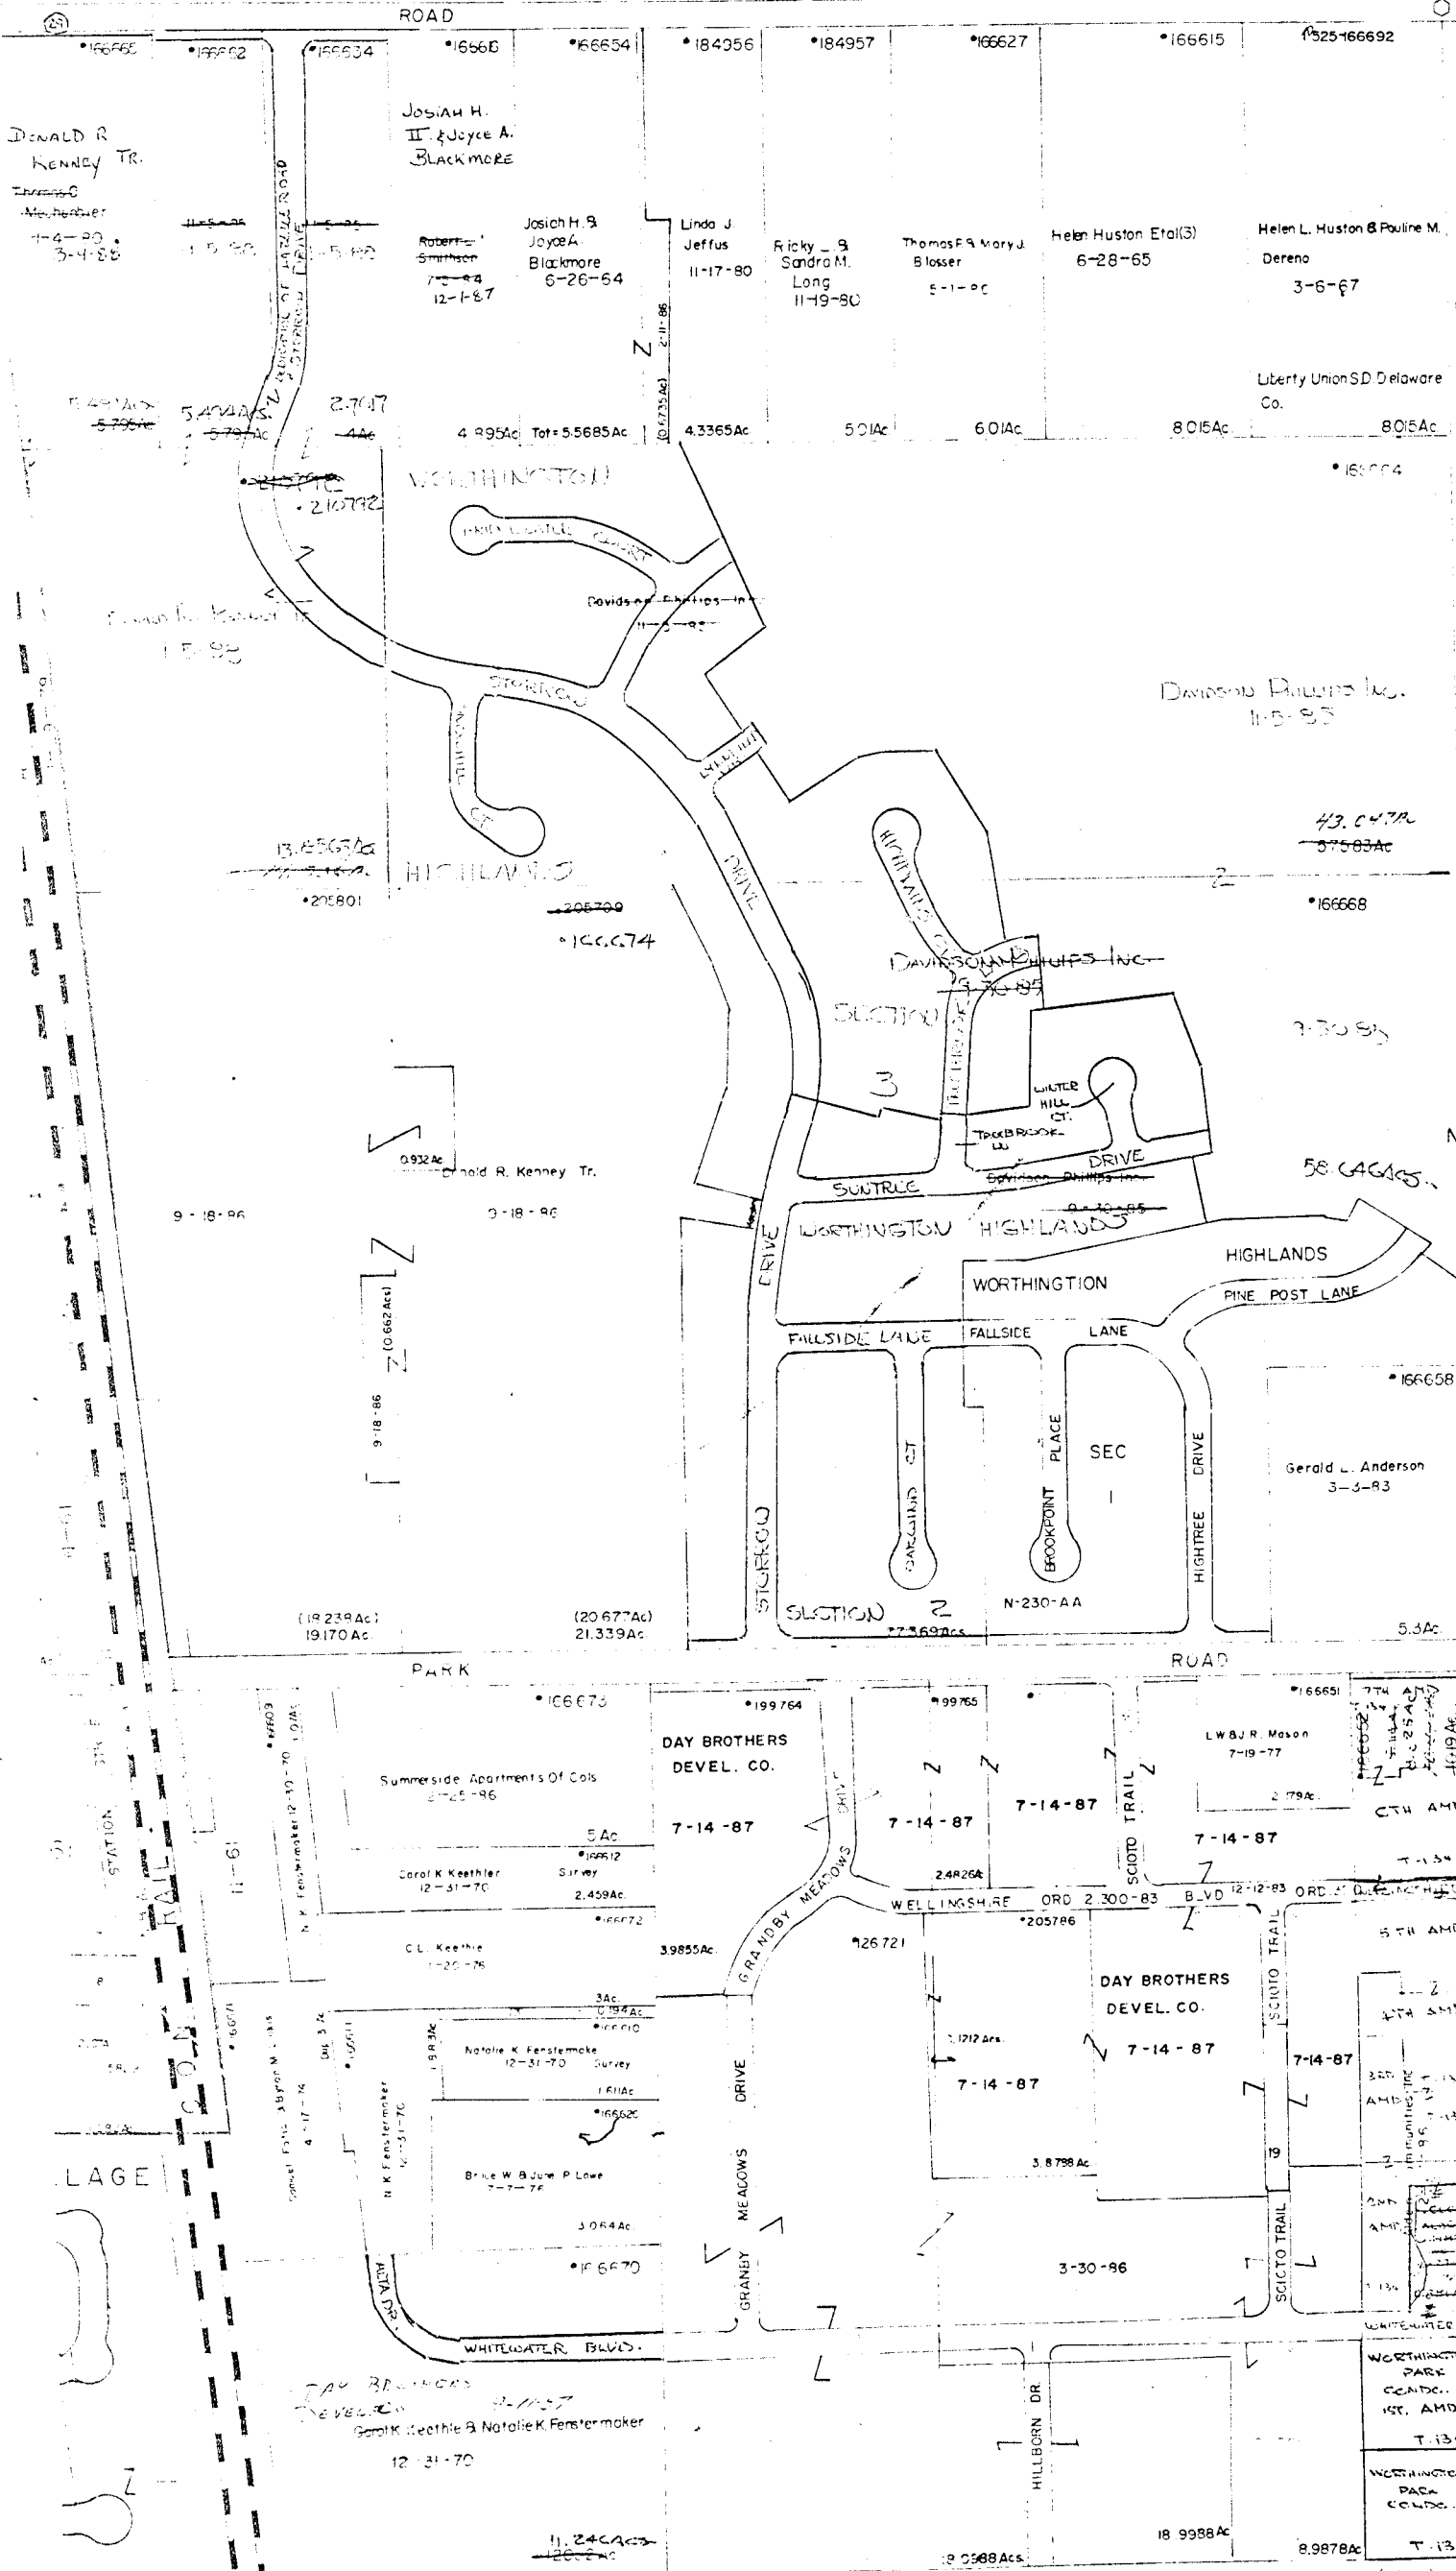

1-204543	AETNA LIFE INS. CO.	5-21-87	0.000
2-204547	"	"	0.000
3-456	Robert L. Roshor	11-8-81	0.280
4-478	John O. Briggs	6-12-80	0.210
5-460	Alan W. Mills	11-25-86	0.370
6-694	R. J. Wheaton Jr	7-30-45	0.162
7-5826	Earl E. Wathen	7-29-76	7.811
8-6194	"	"	0.270
9-3280	Board of Township Tr	11-29-55	0.000
10-3279	"	"	0.000
11-3047	Jeannette H. & Keith B. Semoras	4-15-81	1.000
12-5485	William H. Davis Etal (4)	6-26-86	1.000
13-1937	"	"	0.160
14-2412	Dwight L. Moody & James L. Reeves	3-26-88	0.710
15-2411	Gordon A. & Kay A. Lucas	7-8-75	0.630
16-15	"	6-26-75	0.844
17-1292	"	7-8-75	0.717
18-4079	Mary M. Farber	12-17-84	1.386
19-000	City of Columbus	4-19-85	0.354
20-6880	Mary K. Brown	1-3-87	1.850
21-6881	"	"	1.850
22-21324	Burr Corporation	1-17-86	0.490
23-5911	T.J. Turner	11-7-73	0.430
24-DROP	City of Col	10-10-85	0.466
25-	"	"	0.109
26-	"	"	0.000
27	LAZELLE RD BUILDING CONDO	"	"
28	*204546 W. A. OFFENBERG	"	"