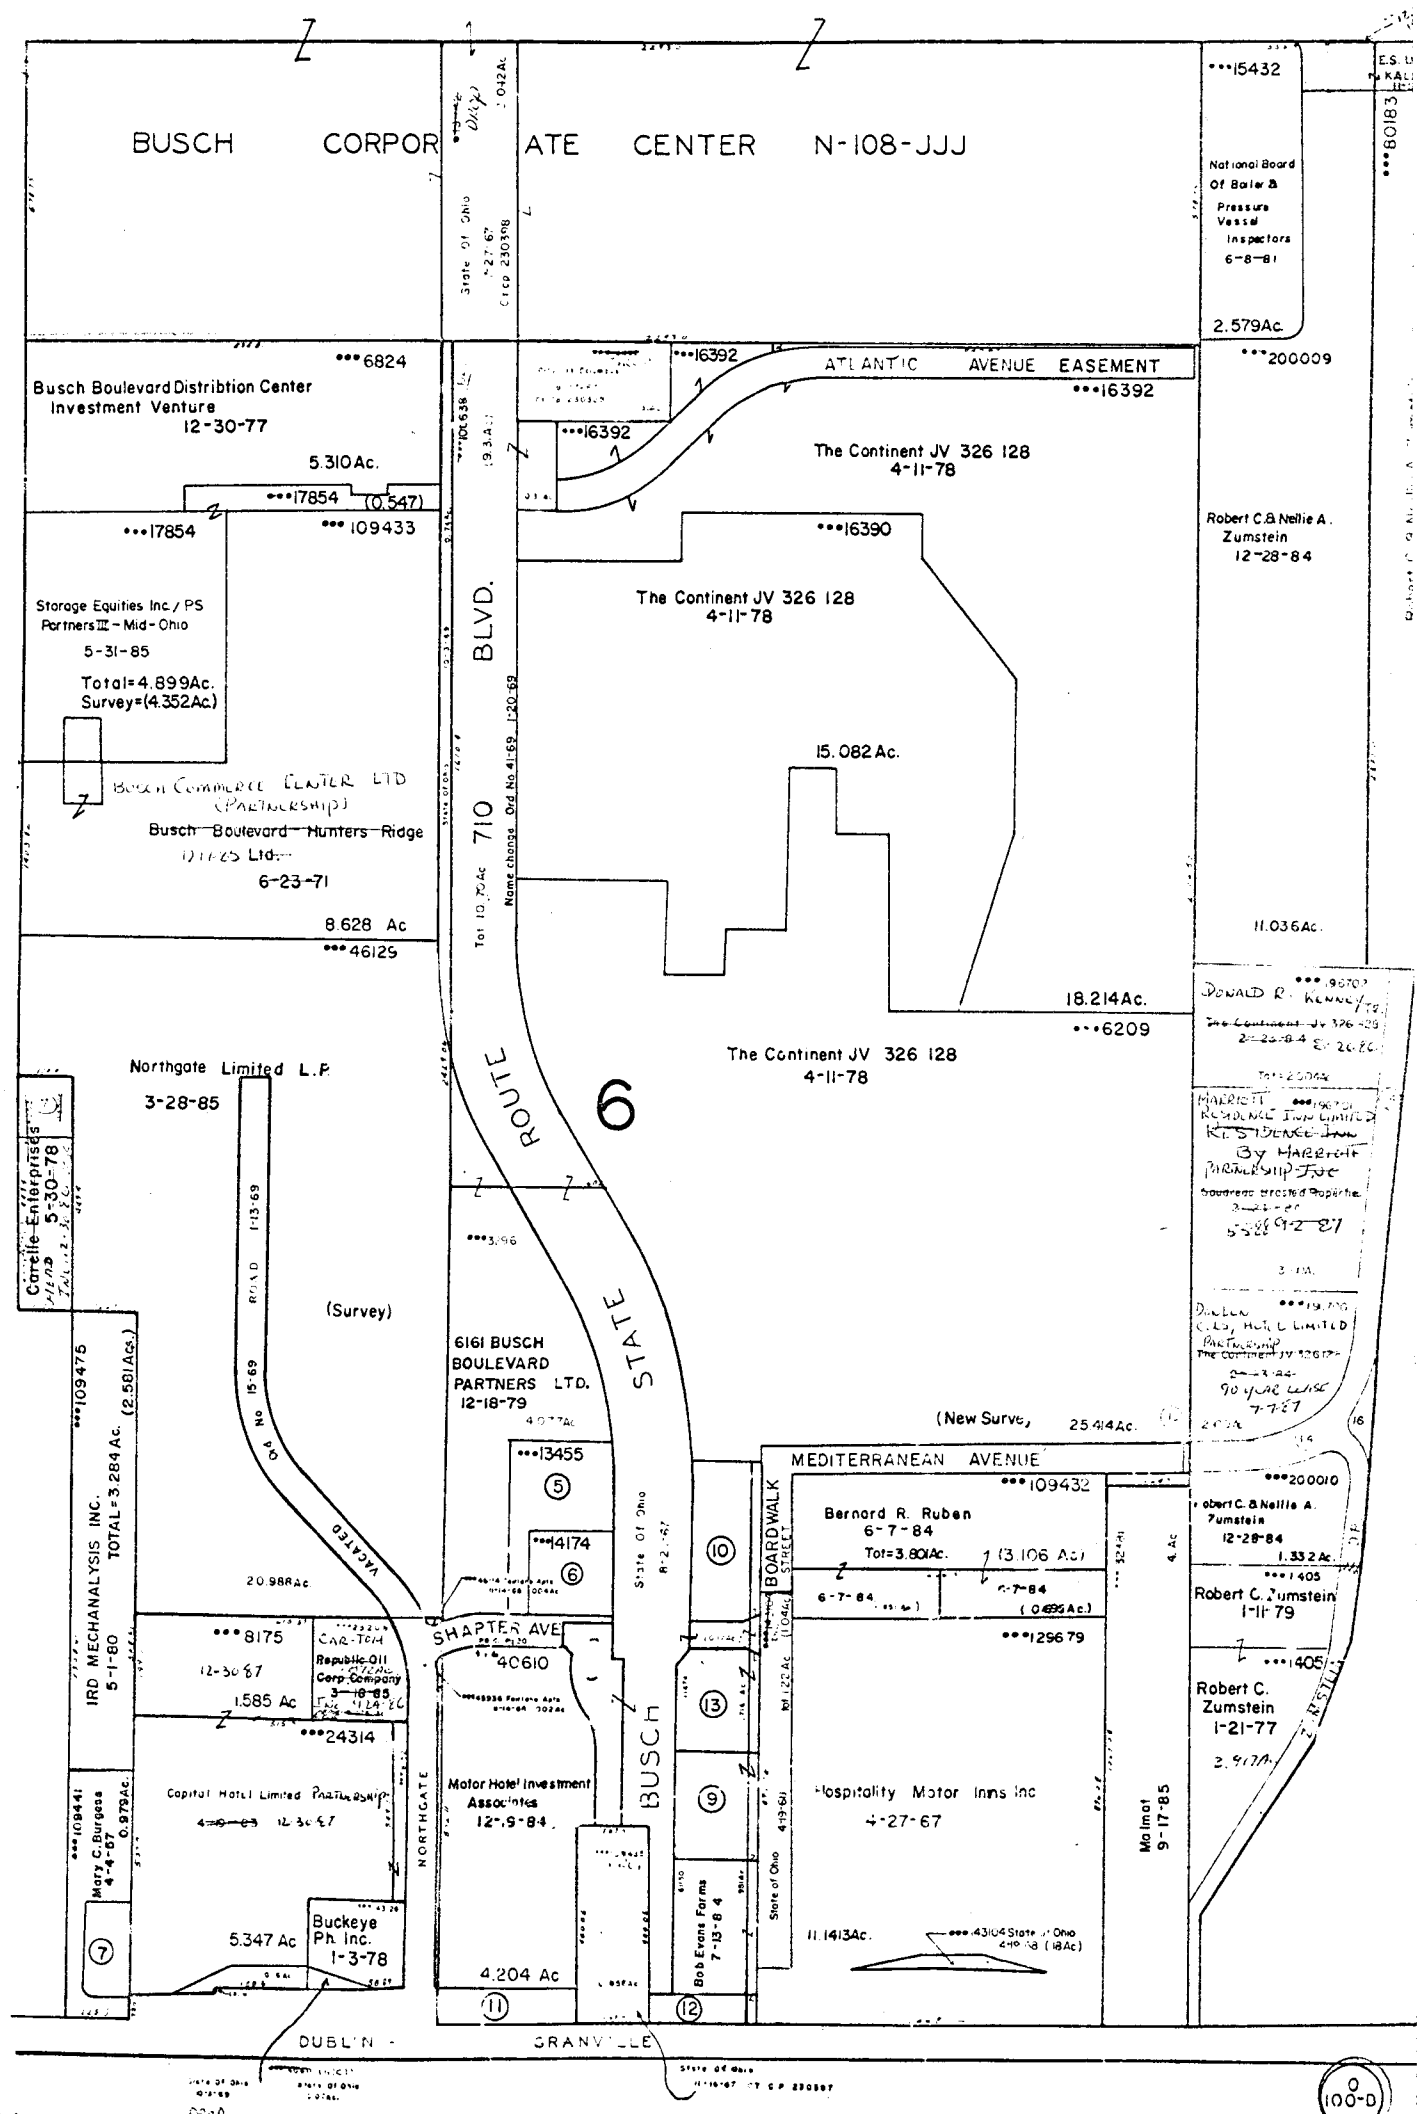

① State of Ohio (Hi-Way) (Ct. Cp. 237,874) 11-3-71 0.189Ac. No. 6253

② State of Ohio (Hi-Way) (Ct. Cp. 237,874) 11-3-71 0.178Ac. No 6250

③ Drop - State of Ohio 4-21-75 0.184Ac.

④ " " " " " " 0.164Ac.

⑤ ••13455 Rax Restaurants Inc. 6-15-83 0.9682 Ac.

⑥ ••14174 Olive J. Lusthauer 4-1-83 0.6708Ac.

⑦ •••19170 Charles M. Burgess 10-20-77 0.354Ac.

⑧ ••13130 City of Cols. (Hi-WAY) 5-3-78 (To Cor 1-4-67) .177Ac.

⑨ ••20019 Bob Evans Farm Foods Inc. 2-1-78 .720Ac.

⑩ •••178076 John M. Lewis, Bankone Trust Co. 12-5-87 .964Ac.

⑪ State of Ohio - Pt of 103325 .610Ac. (Letter) Hi-Way Easement

⑫ " " " " " " .445Ac. " " "

⑬ ••• 11474 Wendy'S International Inc. 9-15-82 0.716Ac.

14 - DED. OF MEDITERRANEAN AVE., ZUMSTEIN DRIVE & EASEMENT

15 - Drop City Of Cols (Hi-Way) 2-23-84 0.001Ac

16 - •••109523 Robert C. Zumstein 4-7-48 0.098Ac.

⑰ ••• 212265 Rubies Continental Inc. 2-21-85

O-100-A

SHARON TWP.
R.18 T.2

N

E= HIGHWAY EASEMENT
SCALE 1" 200'

TAXING DISTRICT	DISTRICT CODE
••• COLUMBUS	010
• COLS.-WORTH S.D.	610

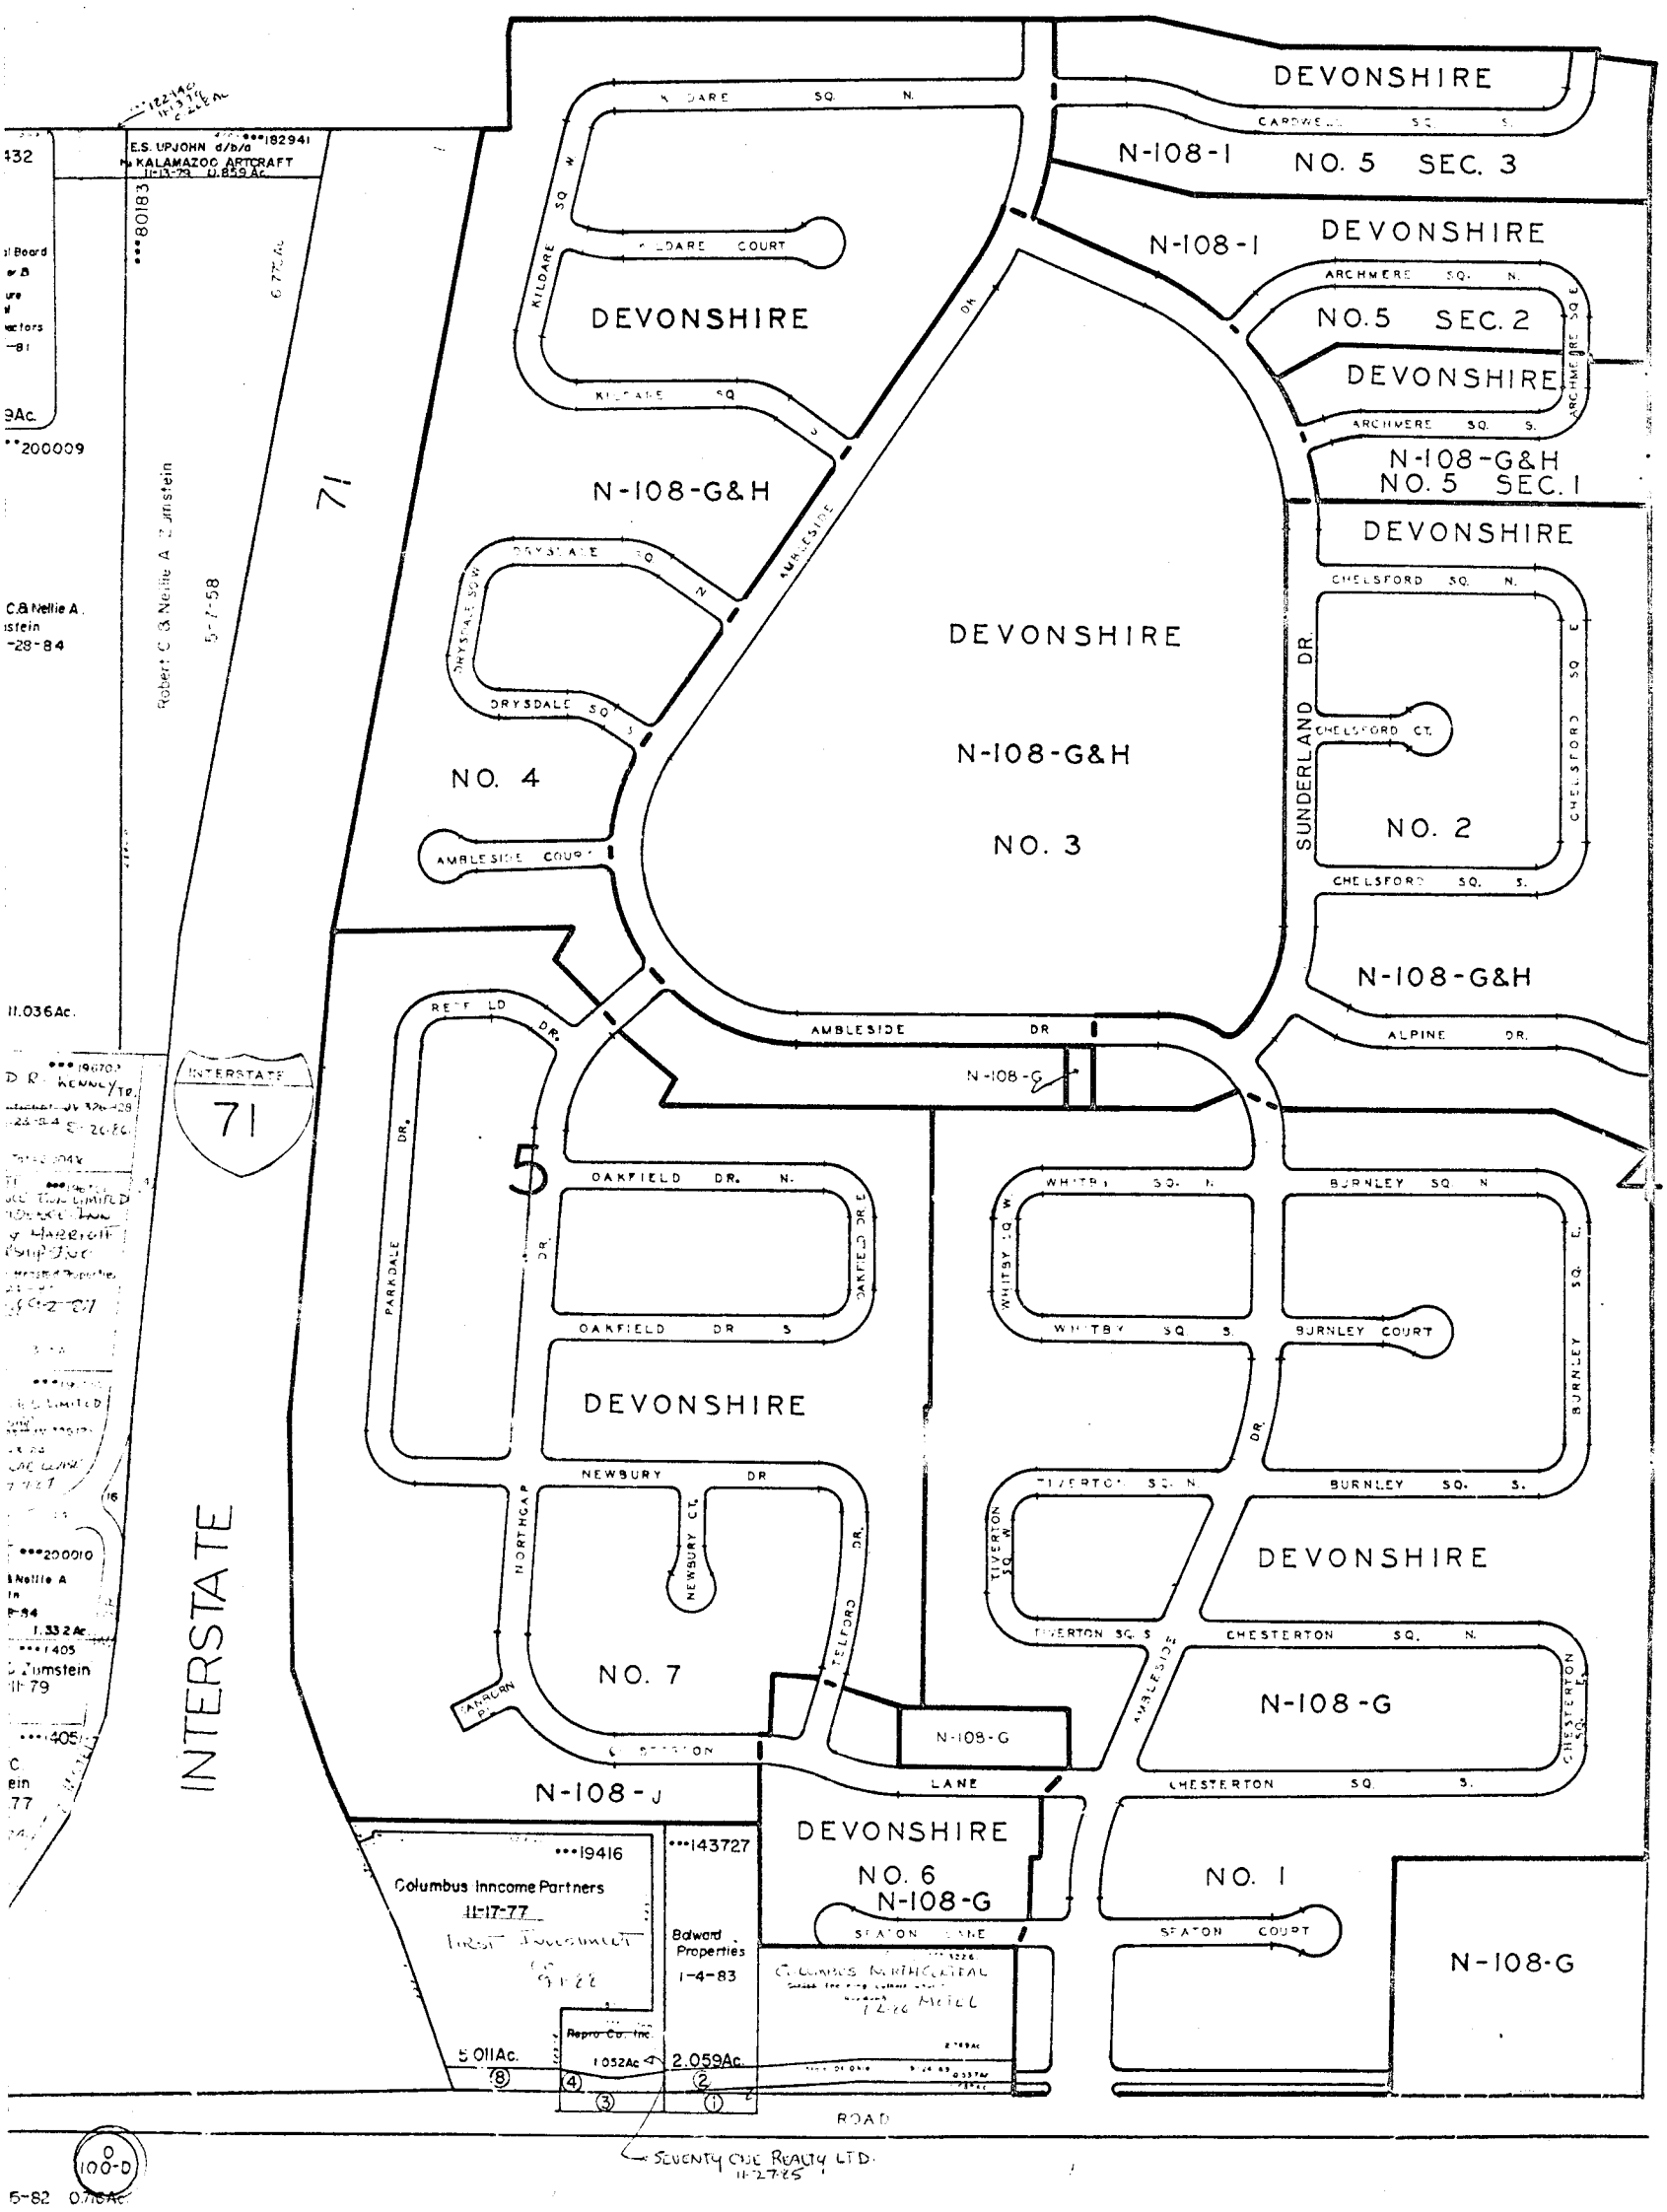

O-100-B

O-100-D

1450