

O-100-


SHARON TWP  
R.18 T.W.2



E=HIGHWAY  
SCALE  
TAXING DISTRICT  
EASEMENT  
DISTRICT COD  
OIO

0  
98  
F

SHARON WOODS  
SEC 7  
N-108-MM

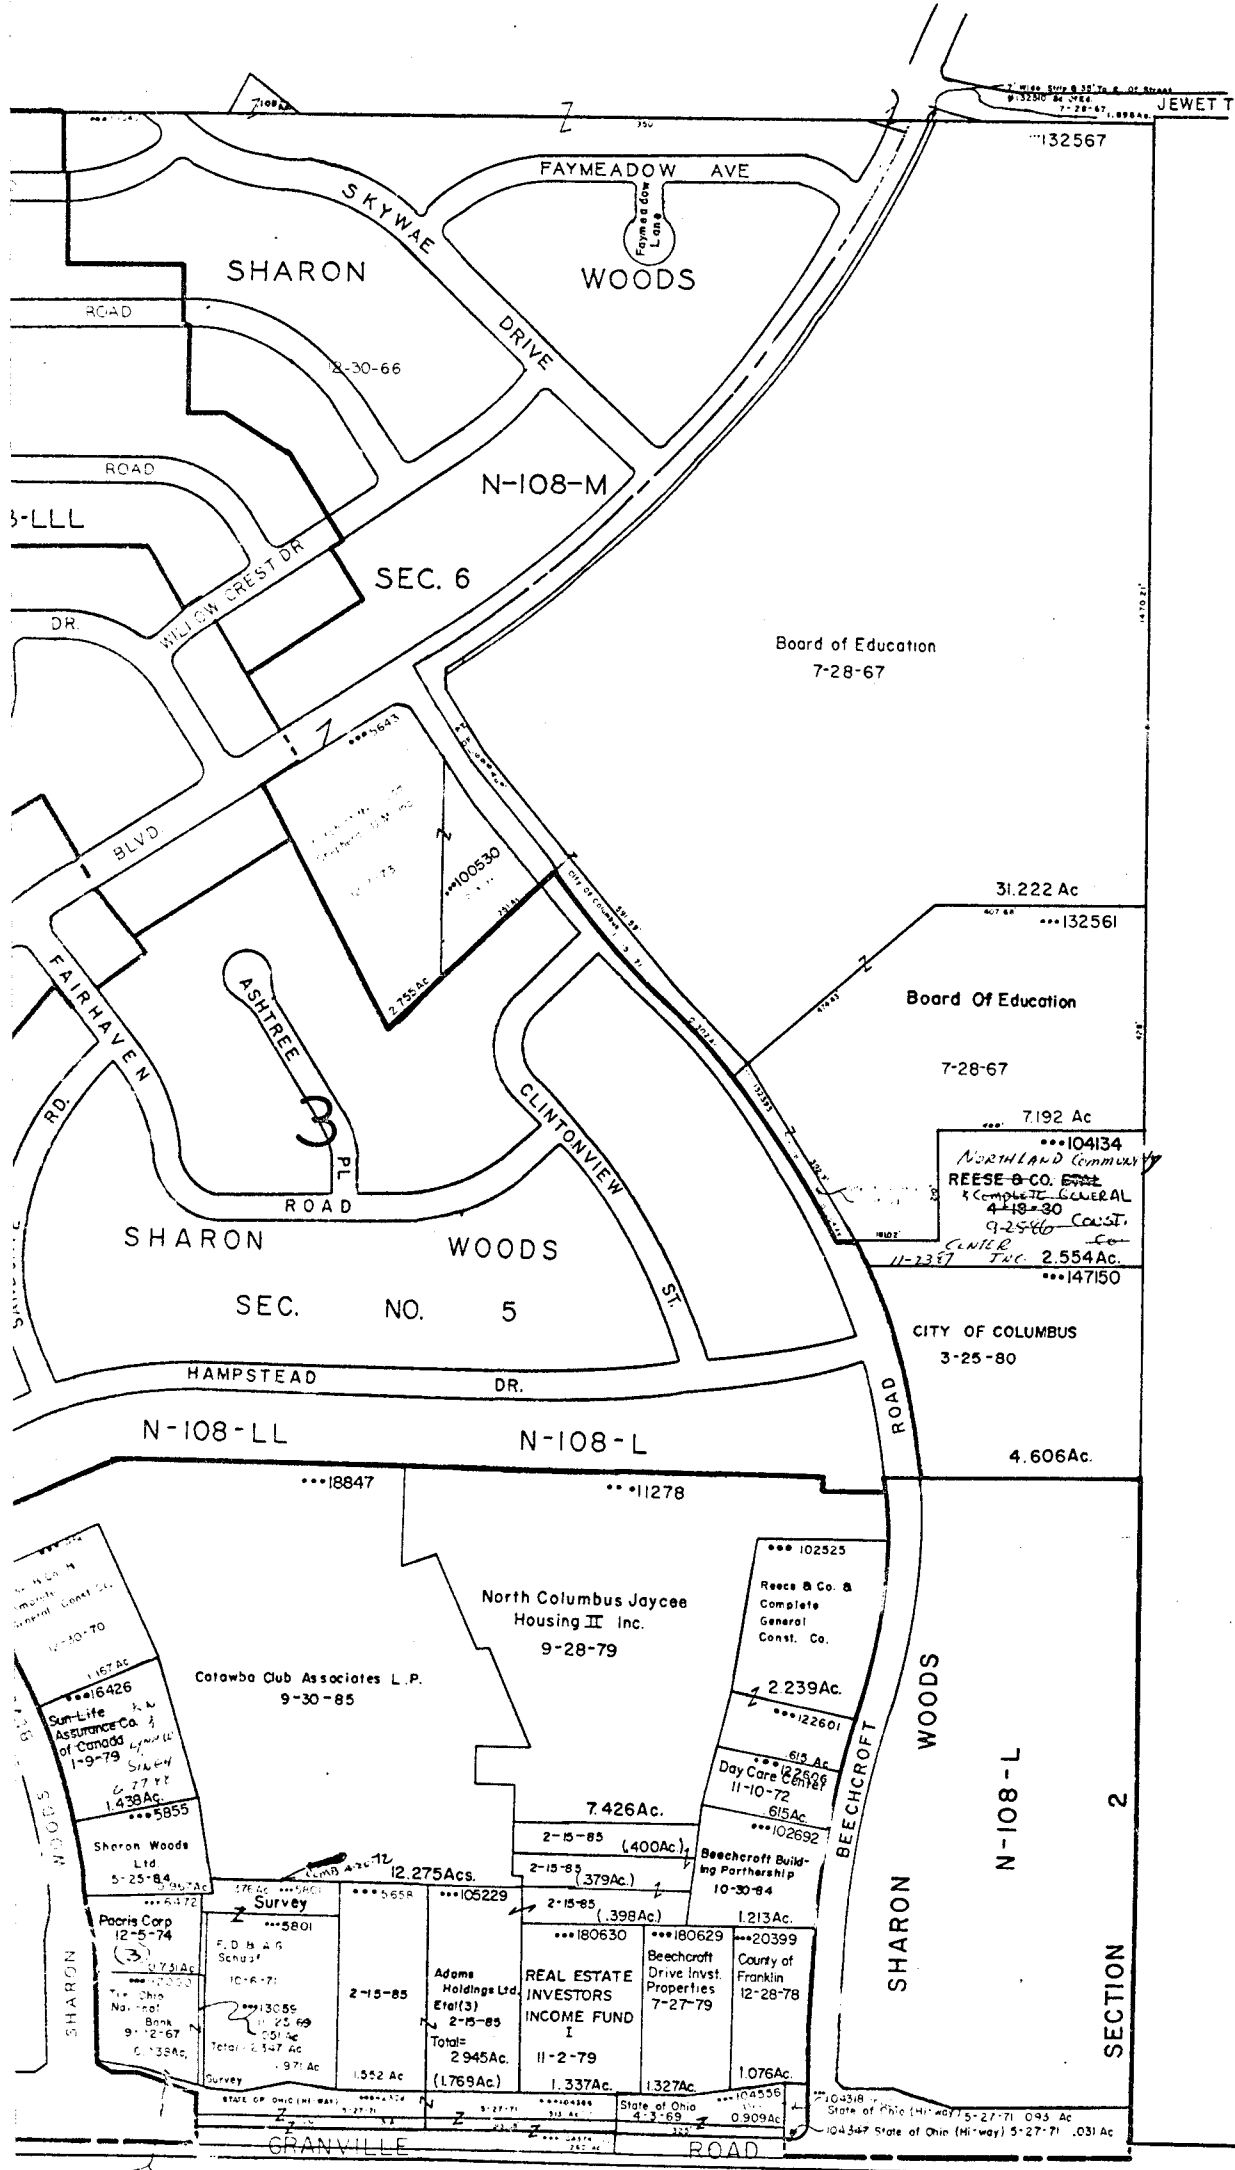

- ① 17278 Samuel K. Freshman 3-4-85 .561Ac.
- ② 17447 " " " " .51Ac.
- ③ 6472 Transportation Communication Consultants Inc. 11-23-87 2.554Ac.

0  
100  
C

0  
100  
E

O-100-2  
1452