


JEFFERSON

0
33
H

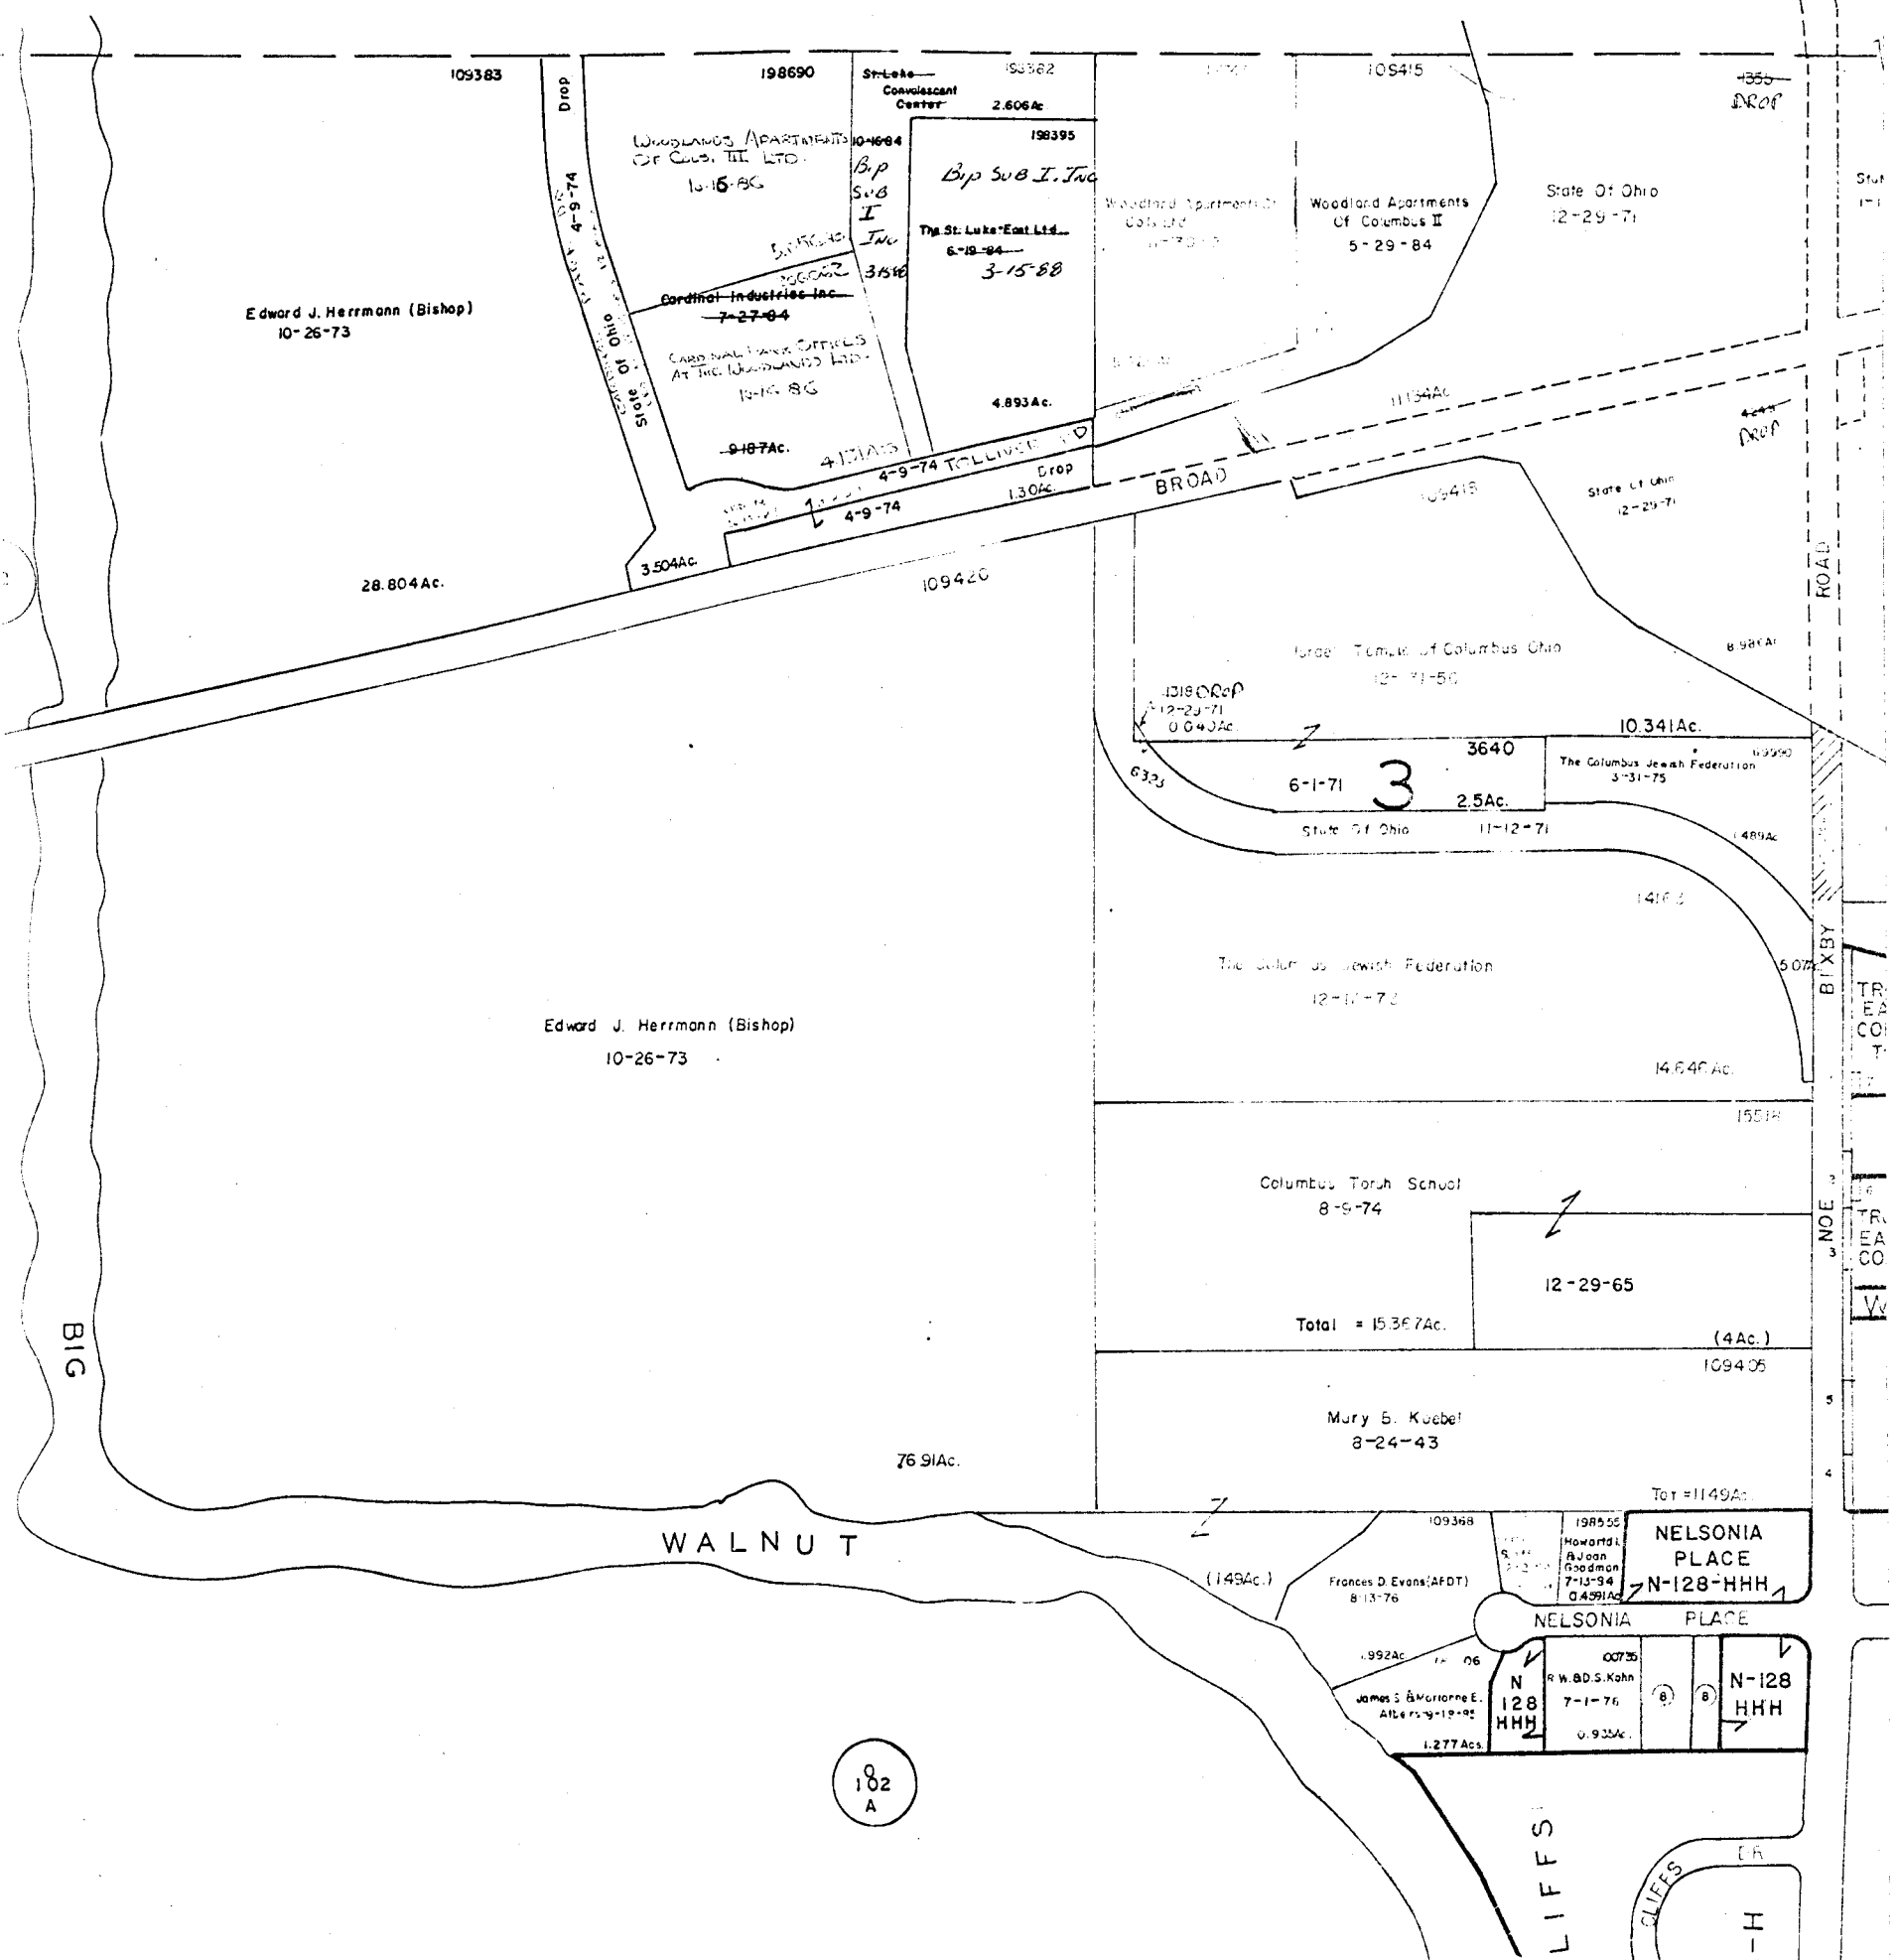


0
102
A

1-3438	City of Columbus	5-26-71	0.565 Ac.
2-3409	"	"	0.100 Ac.
3-3471	"	"	0.110 Ac.
4-3473	"	"	0.10 Ac.
5-3467	"	"	0.110 Ac.
6	DROP City of Columbus	12-11-79	0.023 Ac.
7	"	12-11-79	0.023 Ac.
8-196516	Sarah B. Williams	3-5-64	0.758 Ac.

W.S. 364
2-29-79
Sharlene
ETAL
4-18-79
1.3

Dwight L. B.T.M. Rife
11-9-71
Regan W. School
10-1-79
Dwight B.
Widdell

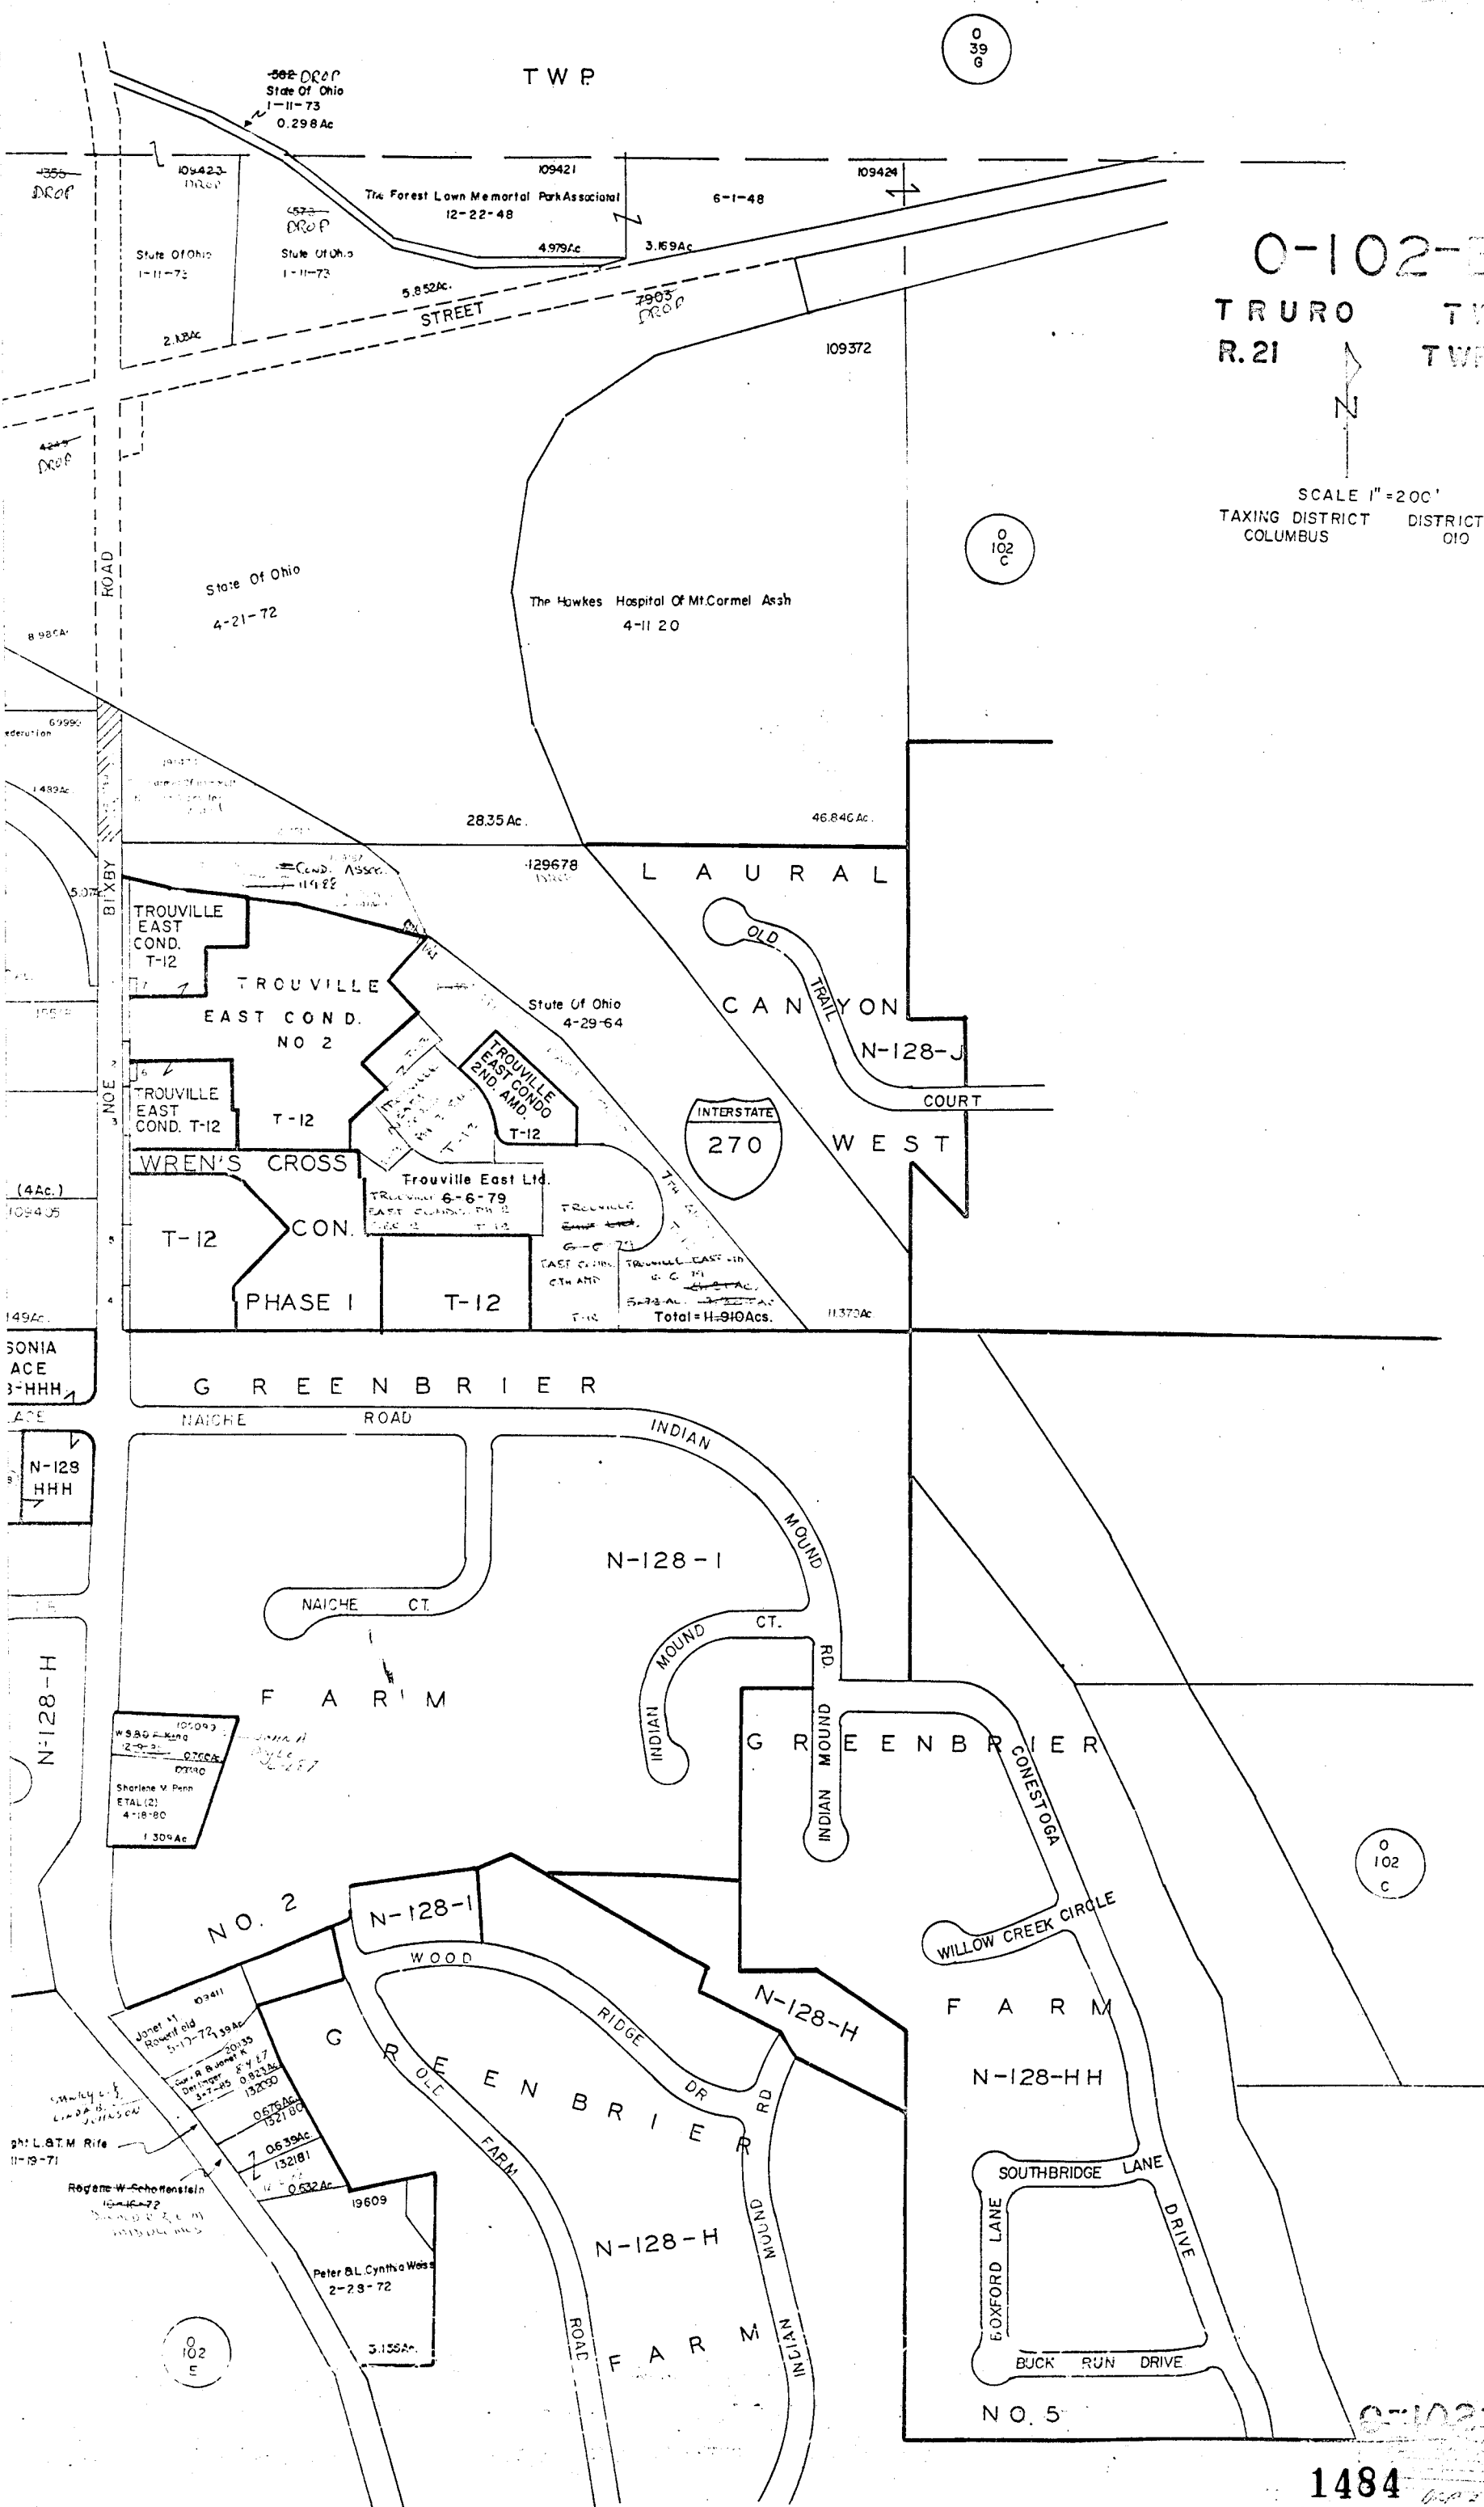

0
39
6

0-102-B

TRURO TWP
R.21 TWP



SCALE 1"=200'
TAXING DISTRICT COLUMBUS
DISTRICT CODES OIO

0
102
C

2

0
102
C

0
102
E