

100
S

104
B


0-102-H
 TRURO TWP.
 R.21. TWP.12.



SCALE: 1"=200'

E = HI-WAY EASEMENT

TAXING DISTRICTS DISTRICT CODE
 COLUMBUS OIO
 **COL.-REYNOLDSBURG S.D. 550

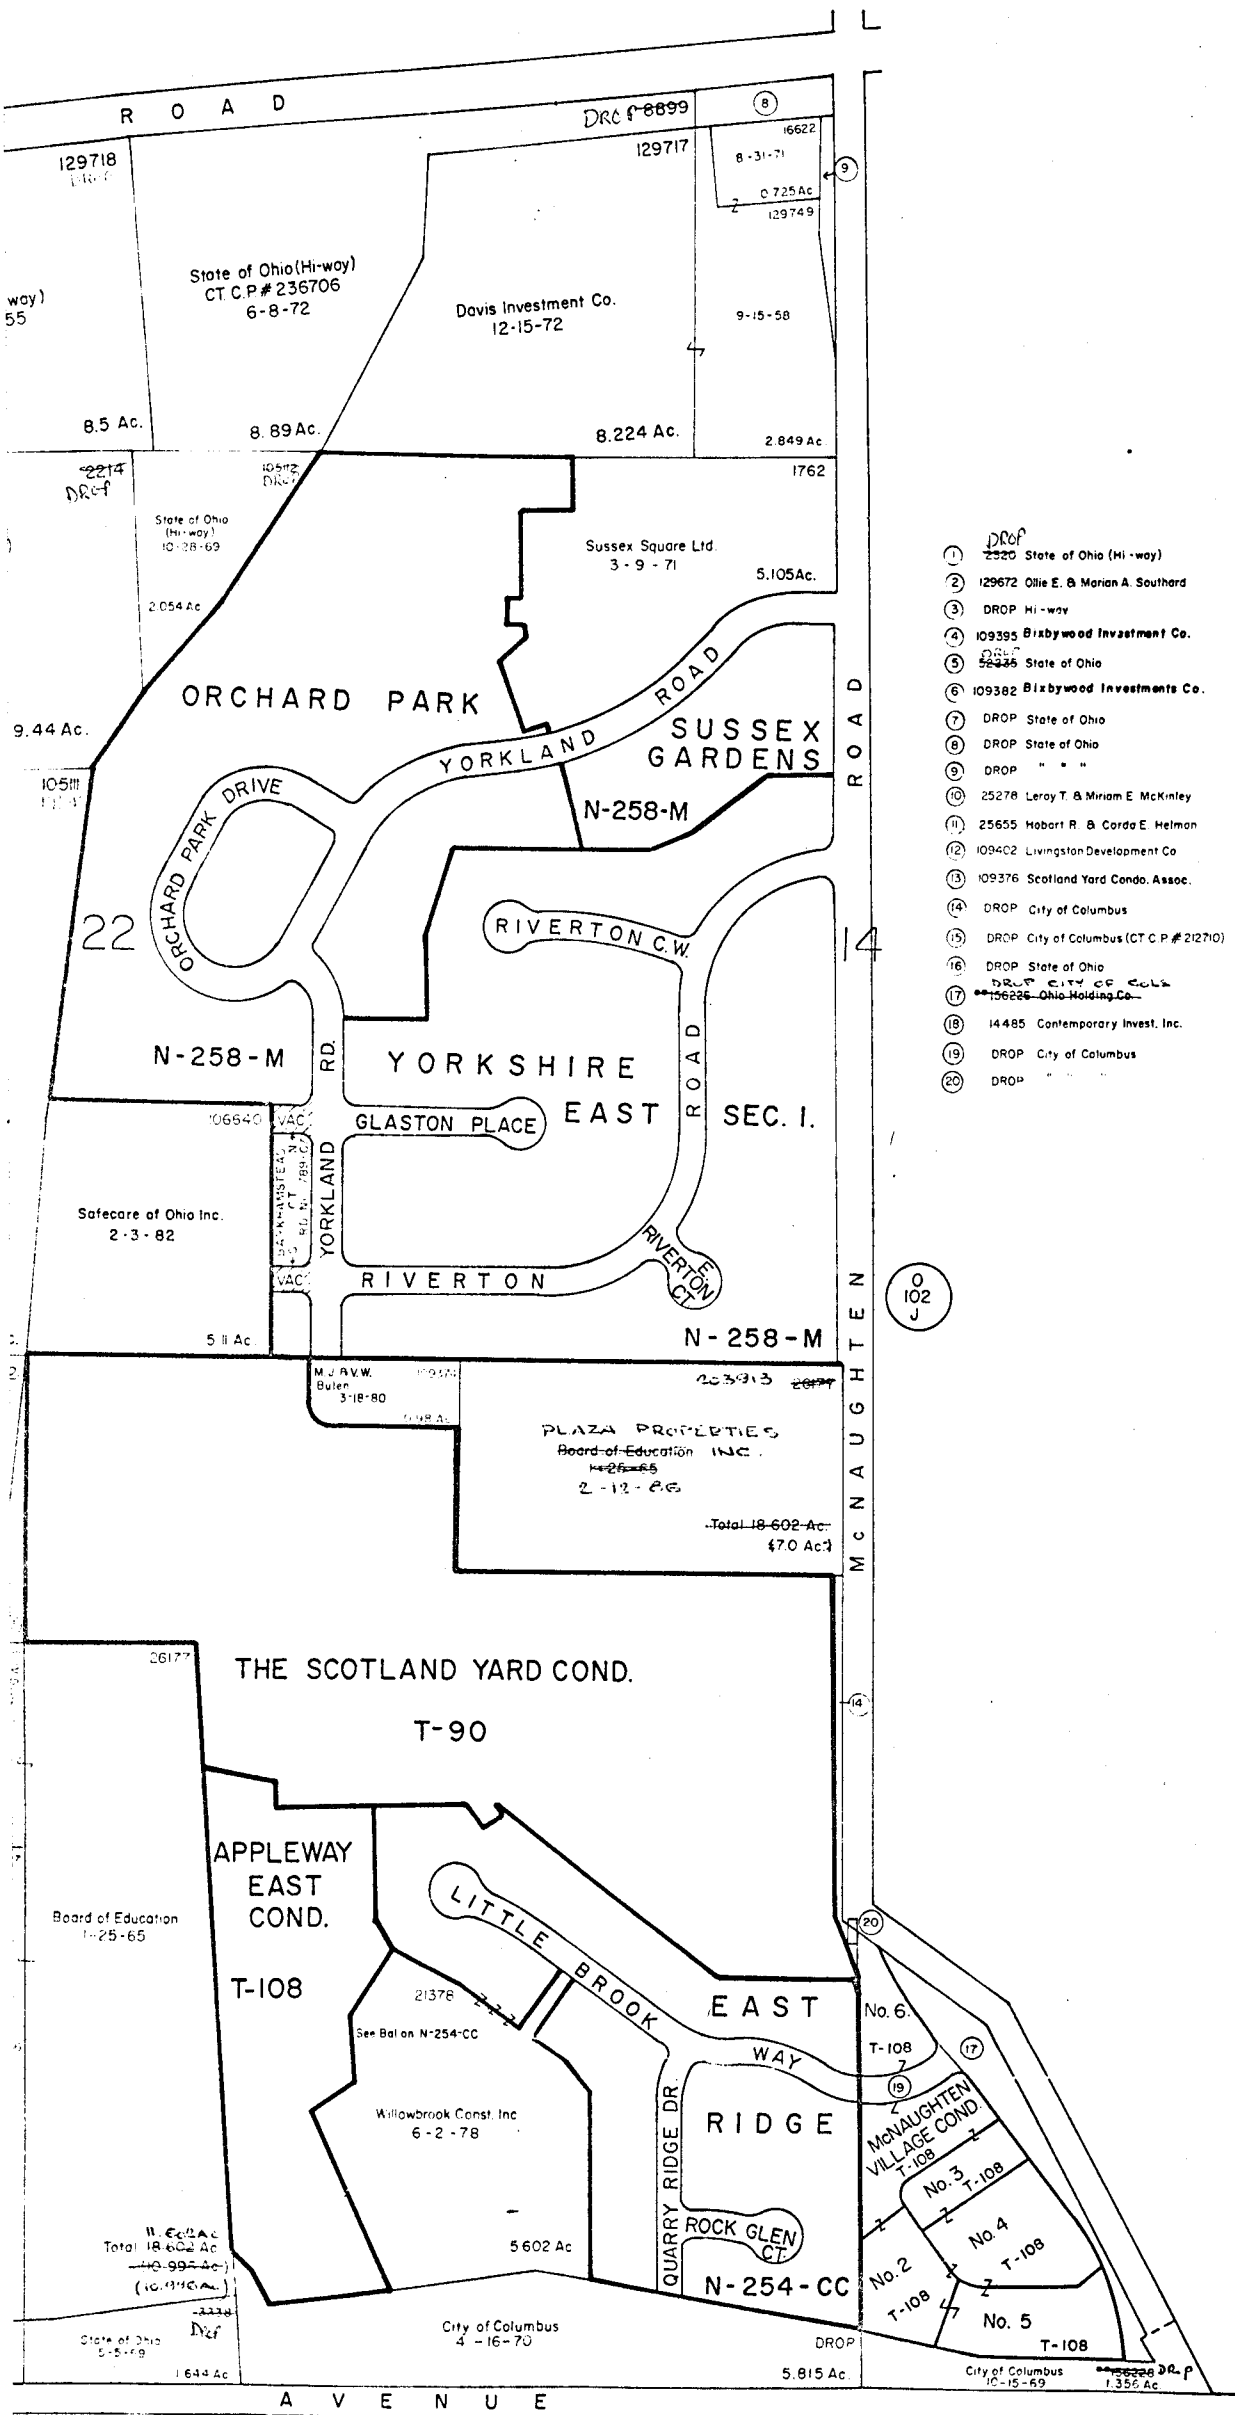


0
102
J

0
104
C

0-102-H

