


O 102 F

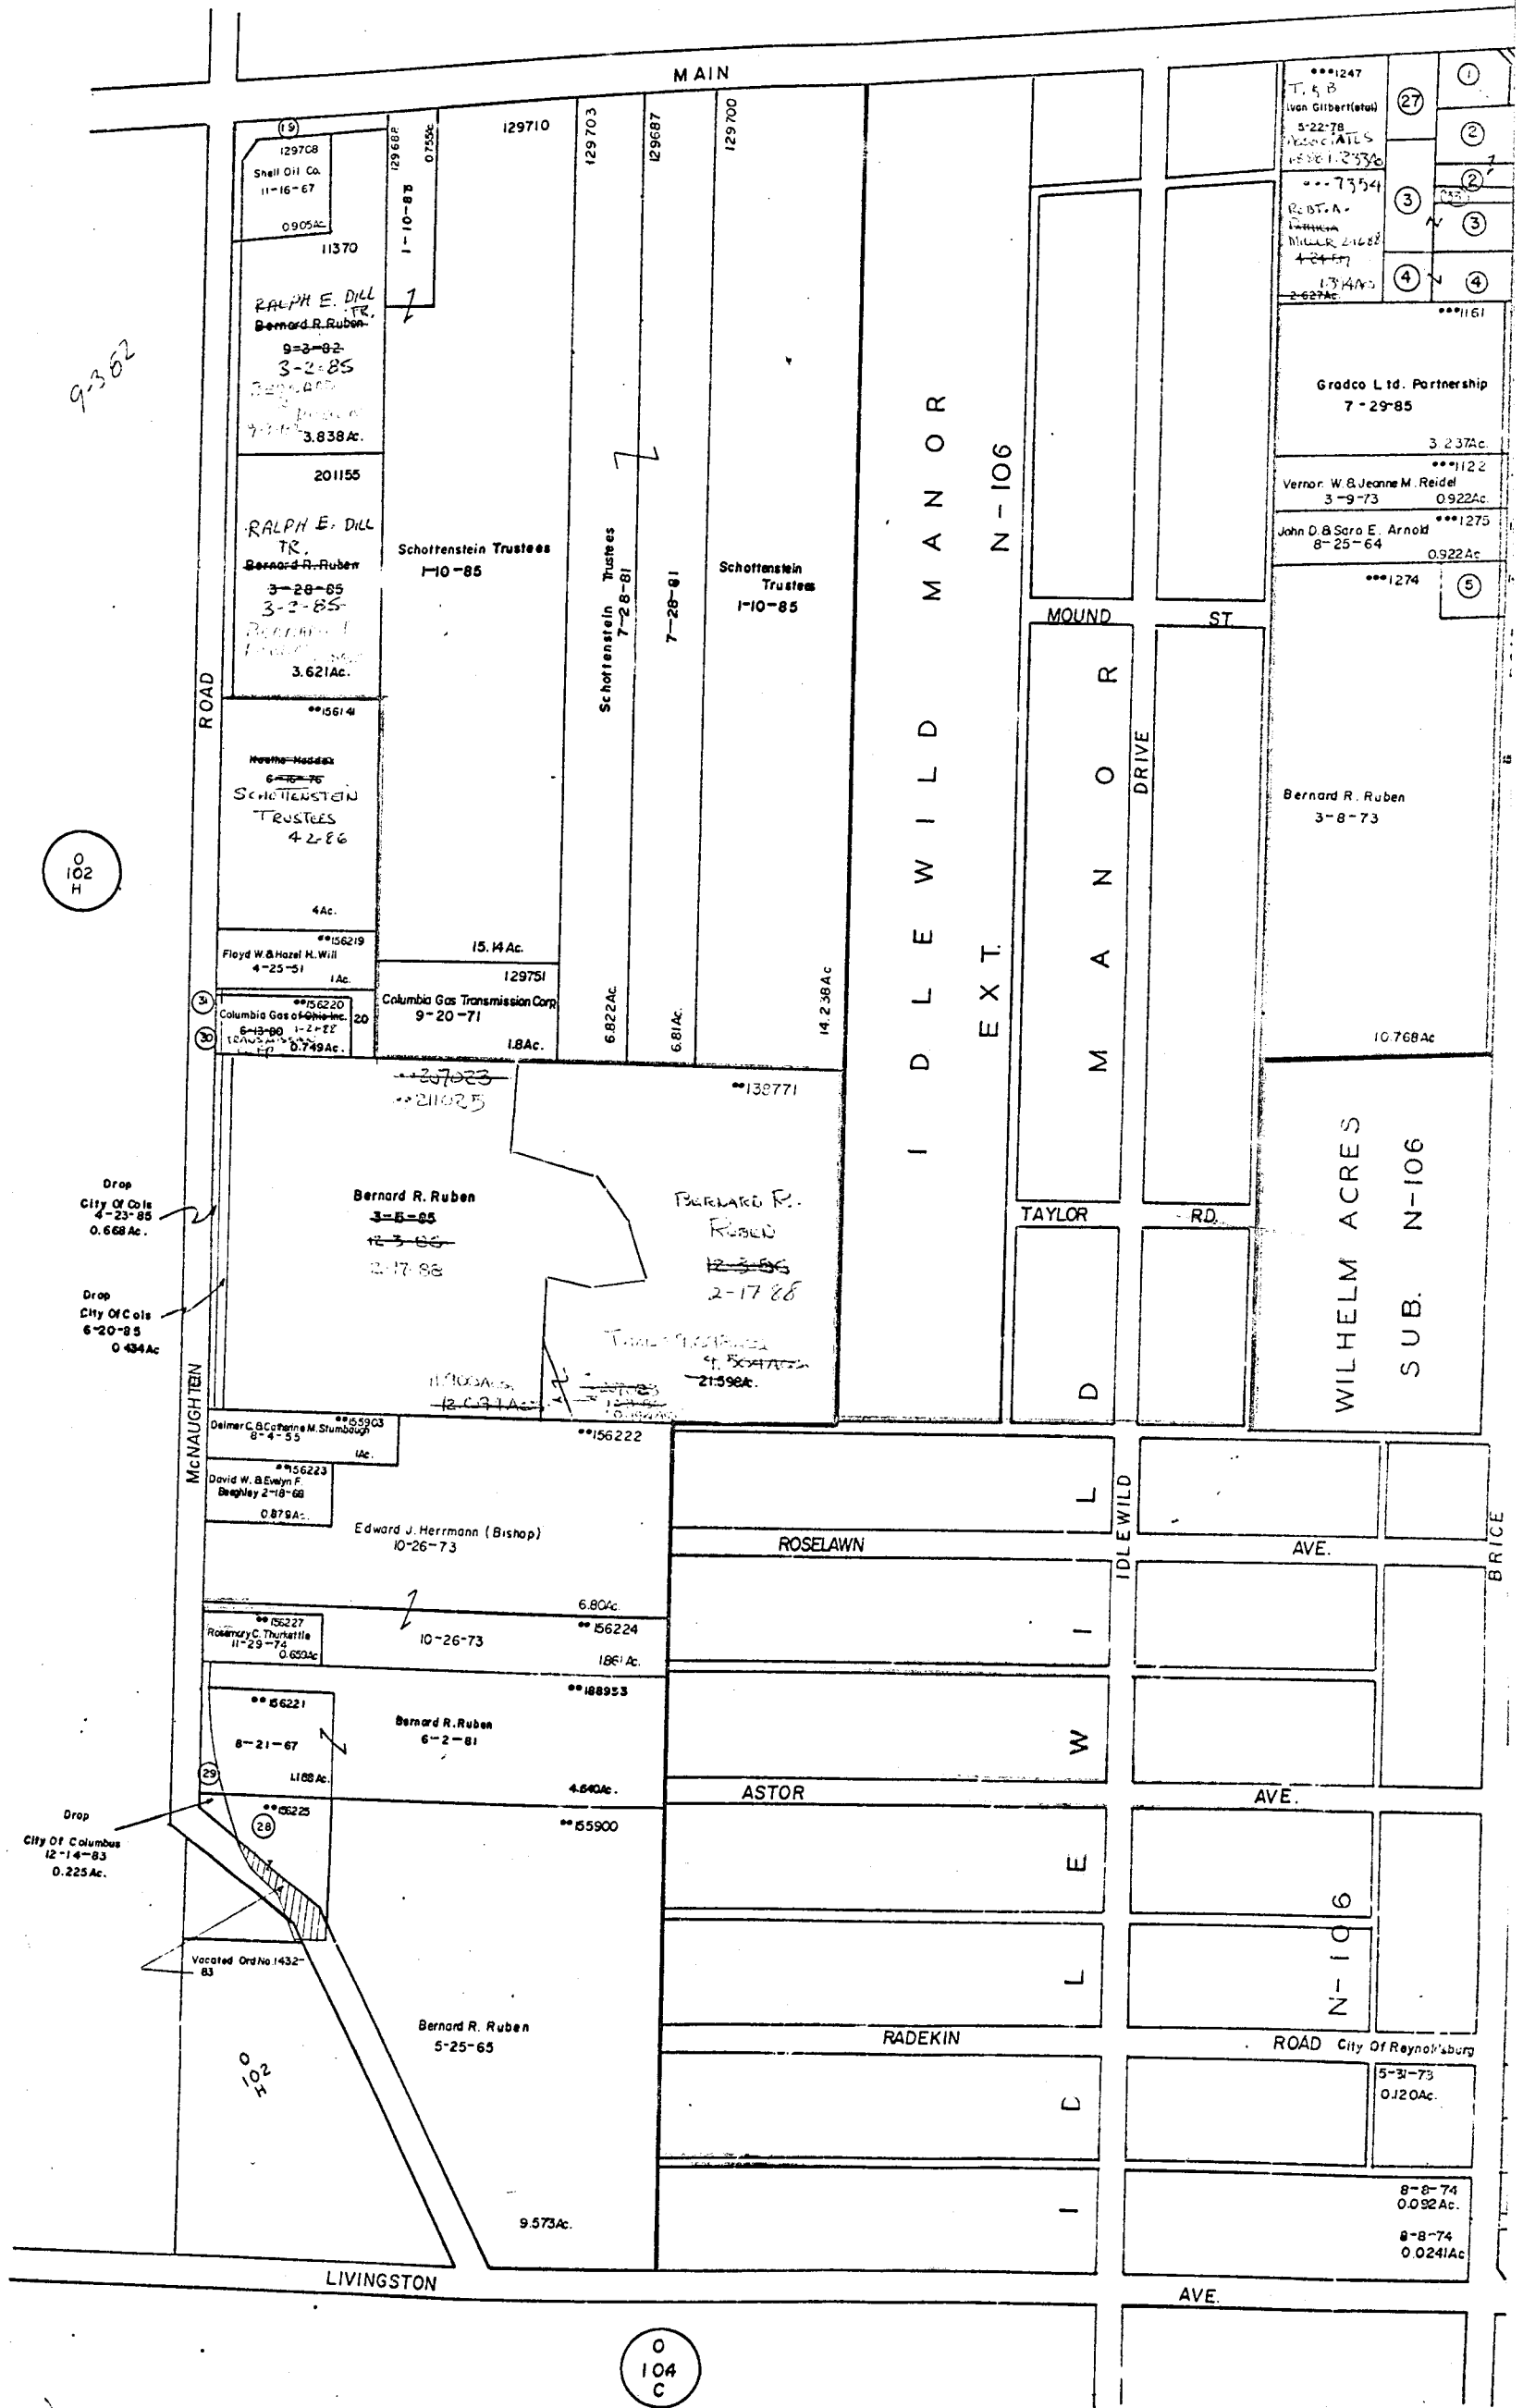

9-3-82

O 102 H

Drop
City of Cole
4-23-85
0.668 Ac.

Drop
City of Cole
6-20-85
0.434 Ac.

Drop
City of Columbus
12-14-83
0.225 Ac.

MCNAUGHTEN ROAD

100

LIVINGSTON

O 104 C

0-102-


TRURO
R.21

TWR
TRURO




SCALE 1"=200'

TAXING DISTRICT DISTRICT CODE
**COLS-REYNOLDSBURG S.D. 550
***CITY OF REYNOLDSBURG 050
CITY OF COLUMBUS 010

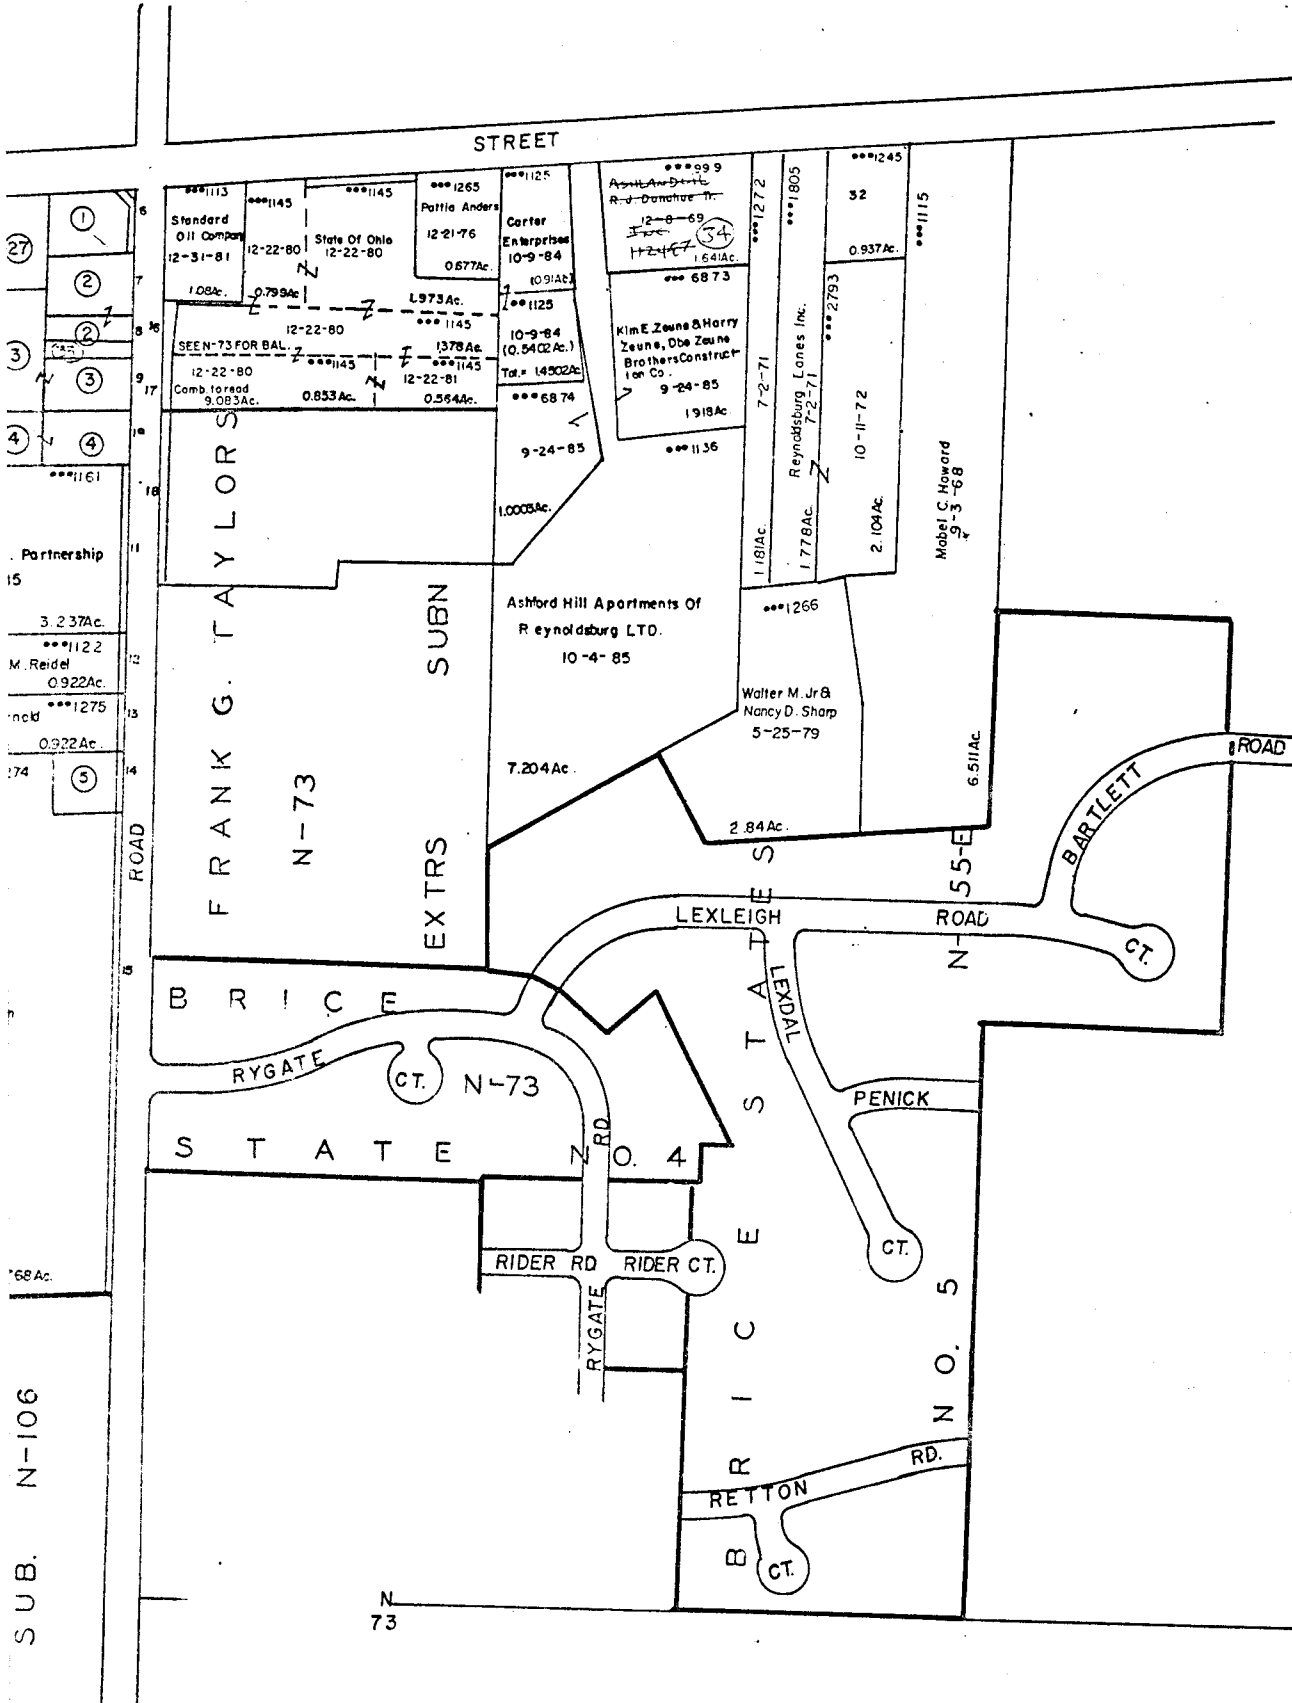

0
106
6

1-***1325	Manifold & Phalar Inc.	7-25-75	0.678Ac.	16-Drop	City Of Reynoldsburg	6-11-74	0.114Ac.
2-***1126	Brice & Main Carwash Inc.	6-27-77	0.701Ac.	17-	"	"	"
3-***1193	C.M.B.S. Development Co.	3-26-80 (0.404)(0.252) T=0.656Ac	5.66Ac.	18-	See N-73		
4-***1324	"	"	"	19-	436677 City Of Cols	10-24-67	1.538Ac.
5-***1276	James V & Carol A Starnes	5-20-66	0.290Ac.	20-	5230 Columbia Gas Of Ohio Inc.	3-26-64	0.212Ac.
6-	Drop City Of Reynoldsburg	1-21-74	0.052Ac.	21-	1251 Harold H Stortzer	4-16-63	0.75Ac.
7-	Drop	2-1-74	0.120Ac.	22-	1258 B. L. Matlin	4-22-80	0.437Ac.
8-	"	"	0.154Ac.	23-	1350	10-2-57	0.1529Ac.
9-	"	"	"	24-	1159	5-31-55	0.5239Ac.
10-	"	"	0.100Ac.	25-	320	5-26-71	0.4072Ac.
11-	"	"	"	26-	1201 Society Properties-Co.	1-3-78	0.910Ac.
12-	"	1-8-74	0.287Ac.	27-	9240 SMK Inc.	7-5-80	0.515Ac.
13-	"	1-21-74	0.078Ac.	28-	156225 Bernard R. Cohen	3-7-84	0.31Ac. (1.201 ACS)
14-	"	12-9-75	0.078Ac.	29-	Drop The City Of Cols (Hi-Way)	5-28-81	0.339Ac.
15-	"	1-8-74	0.101Ac.	30-	Drop	9-9-81	0.108Ac.
		8-8-74	0.828Ac.	31-	"	"	0.04Ac.
				32-	1245 Robert R. & Carmon Ricketts	4-26-85	0.937Ac.
				33-	712 Brice & Main Car Wash Inc.	5-19-87	0.135Ac.
				34-	0499 Swift Oil Co. Inc.	6-28-88	1.641Ac.

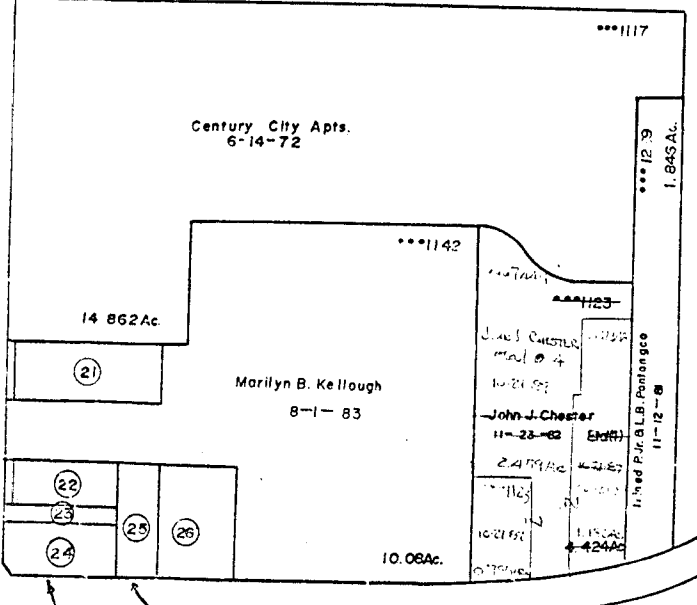

0.506Ac 7878Ac 0.052Ac
8-8-74 8-8-74
City Of Reynoldsburg

0
105
A

0-102-1
1498