


SCALE 1"=200'
E= HIGHWAY EASEMENT

TAXING DISTRICT DISTRICT CODE
COLUMBUS 010
H-HOUSE NUMBERS

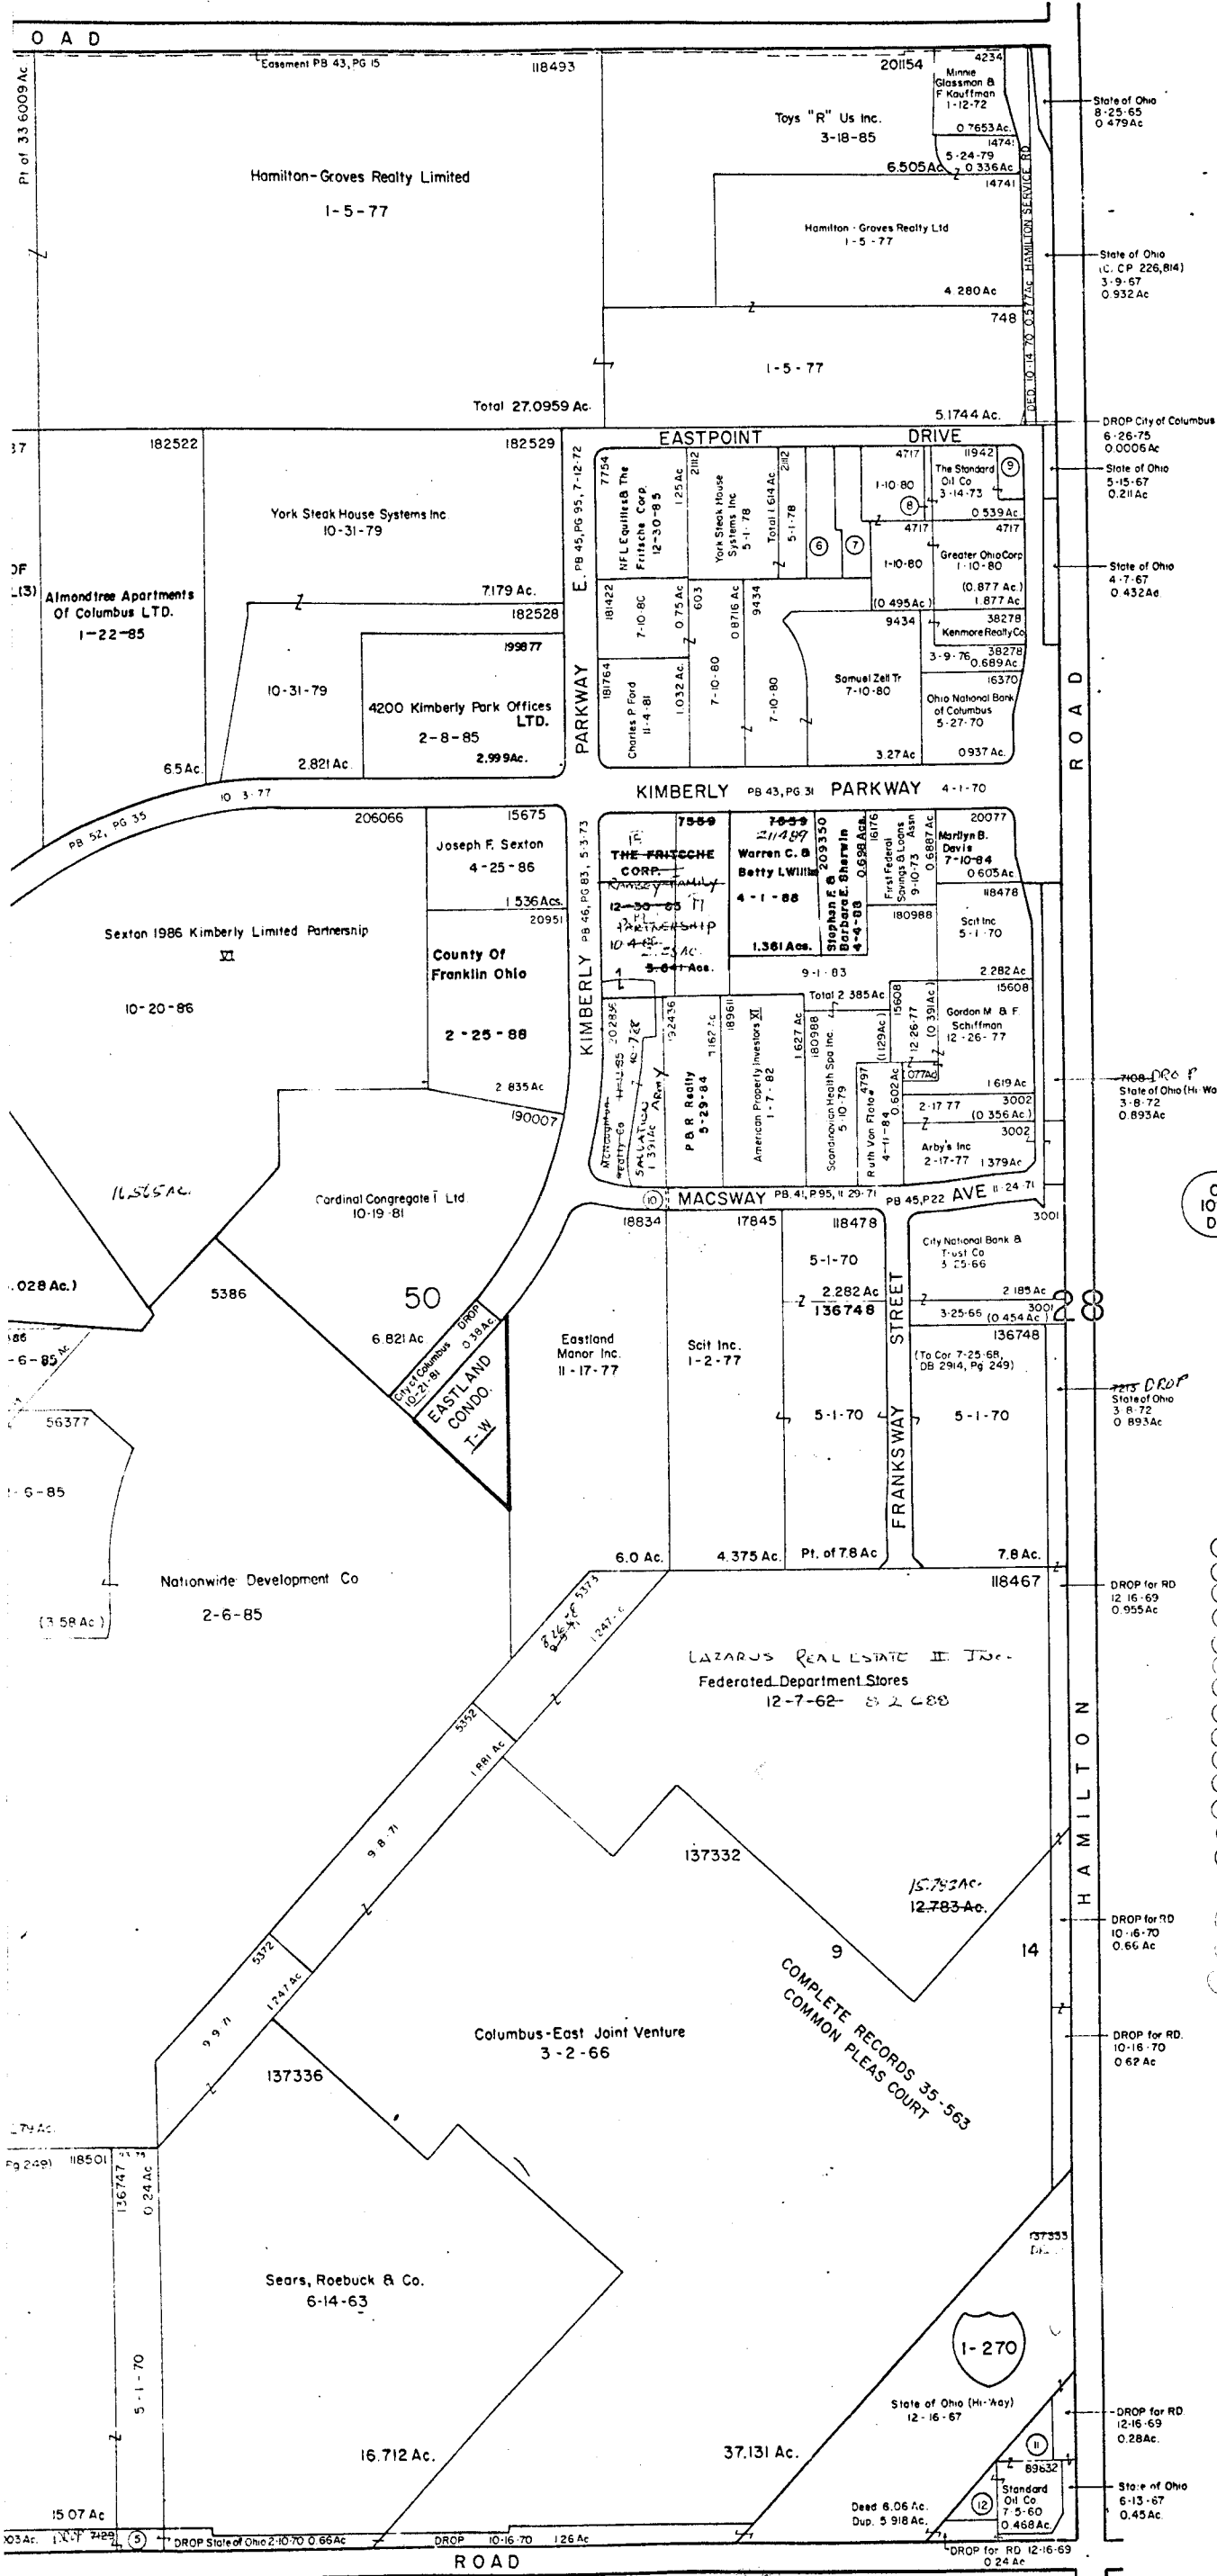

- ① 19402 Robert D Messe 6-7-77 0.046 Ac
- ② 14214 Assoc for the Developmentally Disabled 1-20-82 0.384 Ac
- ③ #8510 Scit Inc 5-10-70 0.356 Ac
- ④ State of Ohio (Hi Way) 3-8-72 0.092 Ac
- ⑤ " " " " 3-8-72 0.17 Ac
- ⑥ 13942 Eastpoint Drive Partnership 6-3-74 0.4235 Ac
- ⑦ 14546 " " " " 6-3-74 0.3800 Ac
- ⑧ #1982 Standard Oil Co 3-14-73 0.0449 Ac
- ⑨ #8838 " " " " 3-14-73 0.156 Ac
- ⑩ 3973 Sears Roebuck & Co. et al (3) 11-19-71 1.450
- ⑪ 13735 Standard Oil Co. 11-14-83 0.222 Ac. Deed 0184
- ⑫ 13734 " " " " 11-14-83 0.23 Ac. Deed 0151A
- ⑬ 4797 PEBBLE HILL ASSOCIATES 11-18-87 .602 Ac.
- ⑭ 205697 Larry F. Gunsorek & Robert S. Hart 8-11-86 .0420 Ac.
- ⑮ 205696 Bilger Corp. 8-11-86 0.347 Ac.
- ⑯ 118717 Larry F. Gunsorek & Robert S. Hart 9-30-85 0.43 Ac.

O
42
B

T W P