
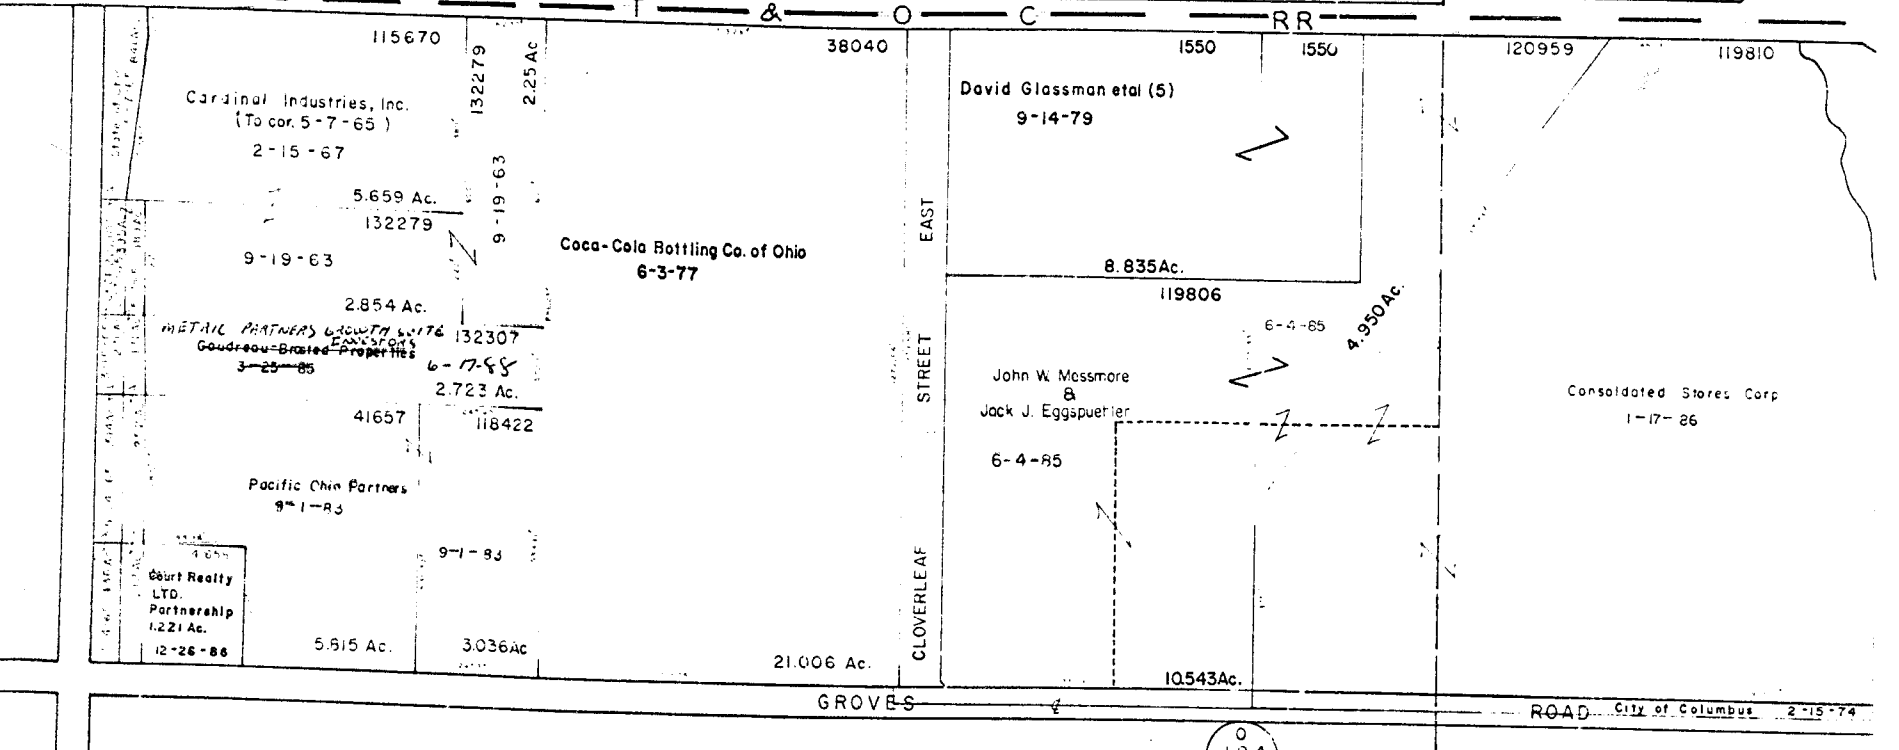
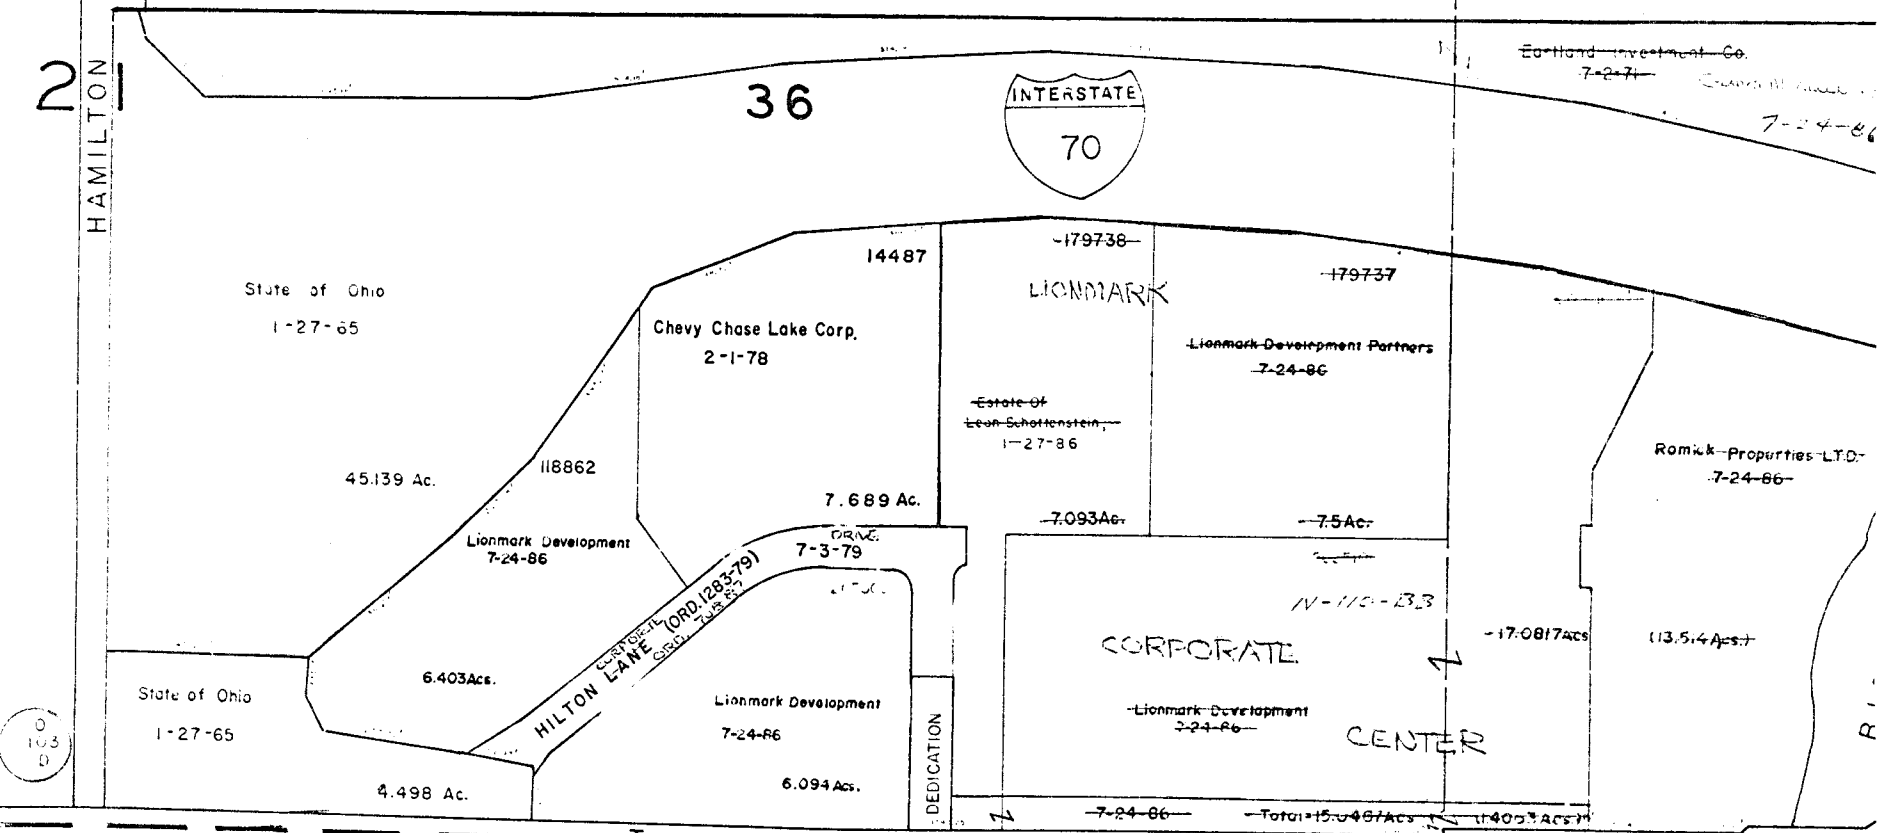


0 102  
A

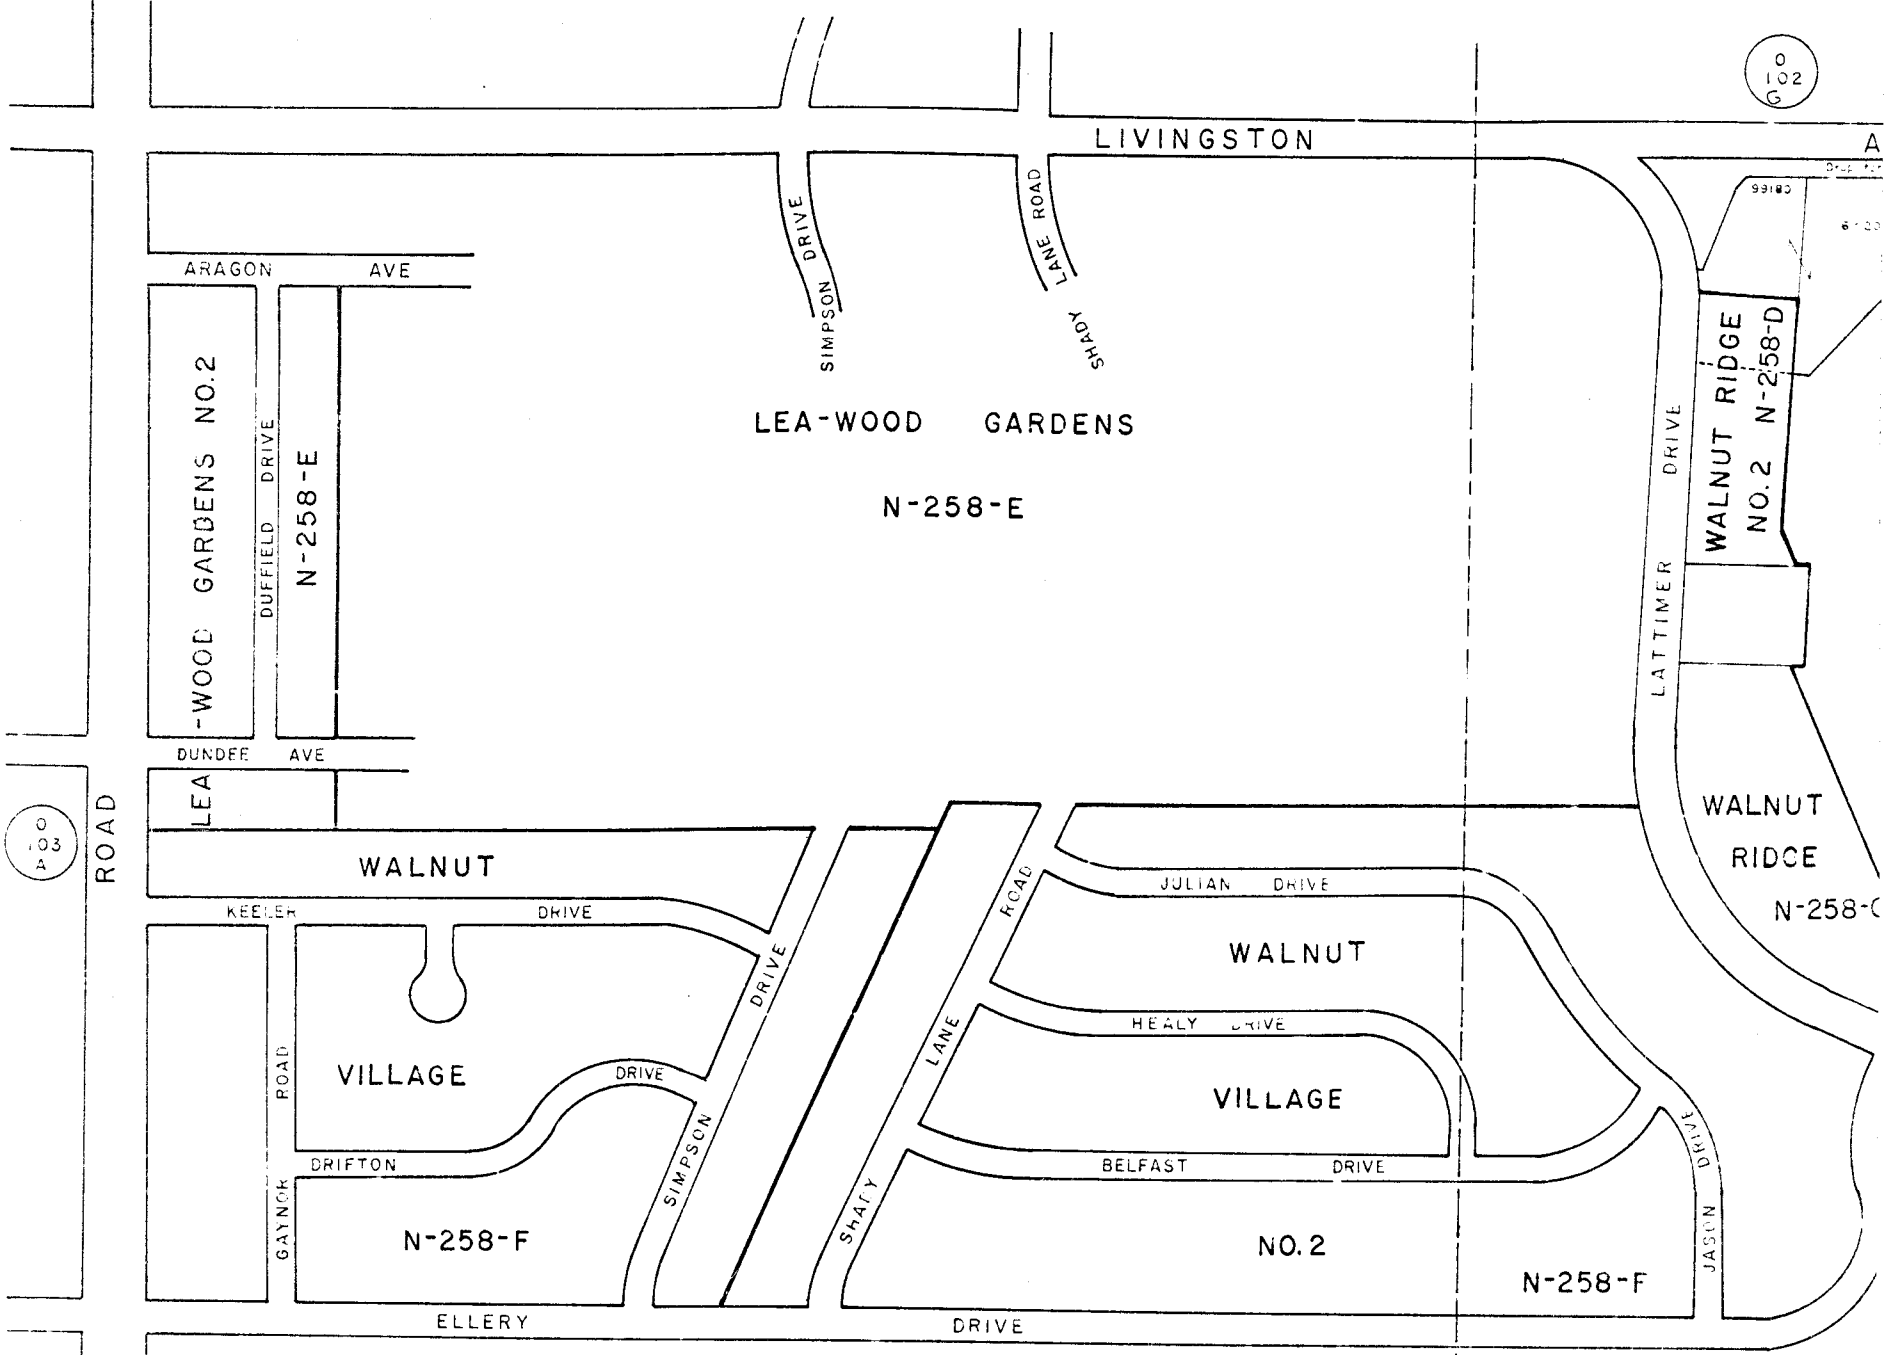

0 103  
A

0 103  
D

0 104  
D

0  
102  
G

AVENUE

99180 6-20-60 (7.9 Ac) 4.473 Ac. 99180 City of Columbus 1-20-62 2.963 Ac (Drop for H.I.) 129657

WALNUT RIDGE  
NO. 2 N-258-D

City of Columbus  
6-29-62

Board of Education  
8-10-60

24.867 Ac.

48.205 Ac.

WALNUT  
RIDGE  
N-258-G

CREEK

0  
104  
B

N-258-G

Vac.

137720

37

15.107 Ac.

22

Properties LTD.  
7-24-66

BIG

0  
104  
B

40.613 Ac.

mbus 2-15-74 1.322 Ac. CRDP

O-104-  
TRURO TWP.  
R.21 TWP.12

SCALE 1"=200'

E=HIGHWAY EASEMENT  
TAXING DISTRICT DISTRICT CODE  
COLUMBUS 010

O-104-A

1512