


O-106-BB

TRURO TWP.
R.20-21 TWP. 12-16

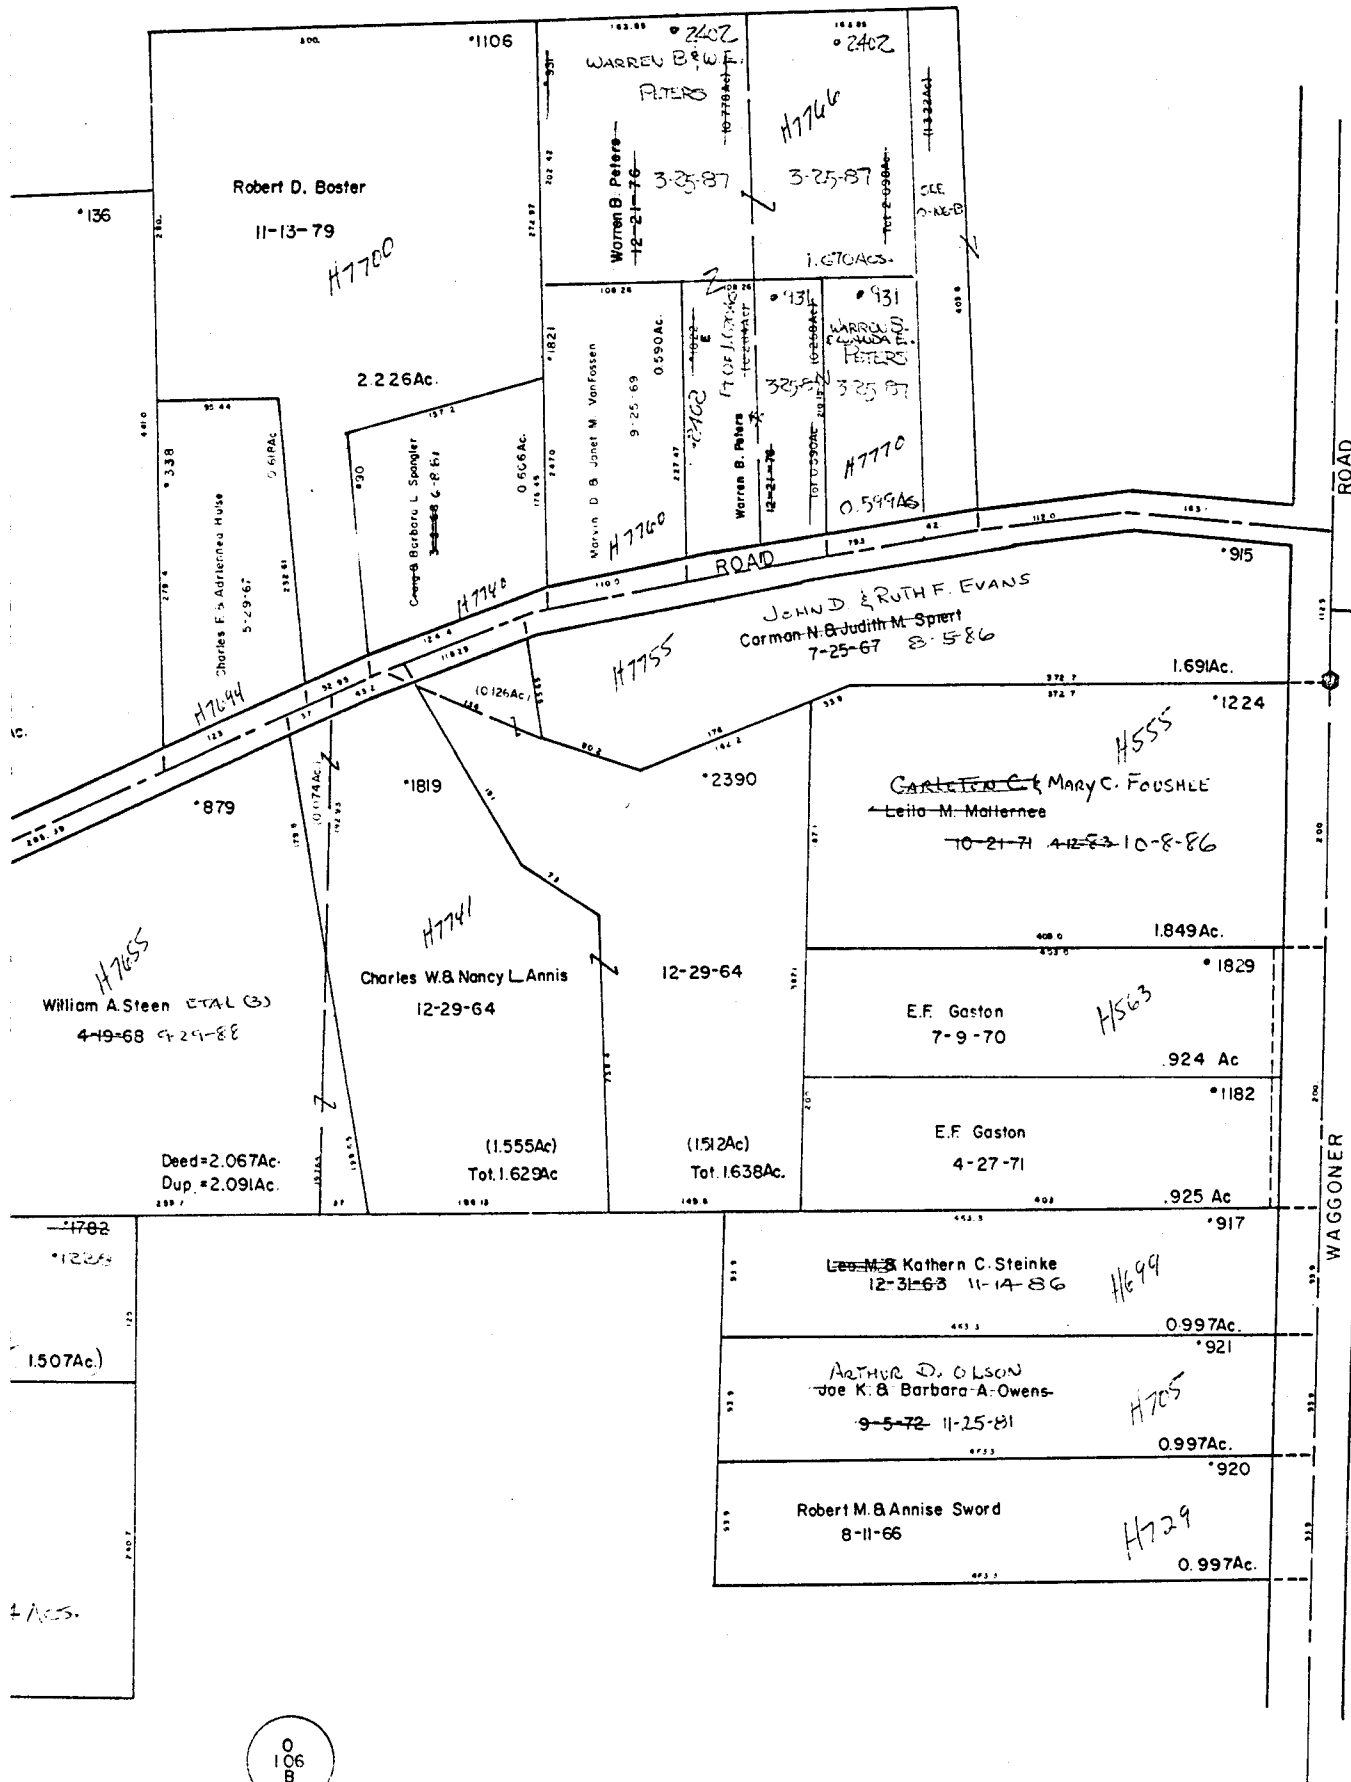

SCALE 1" = 80'
E = HIGHWAY EASEMENT
TAXING DISTRICT DISTRICT CODE
• TRURO REYNOLDBURG S.D. 263
• CITY OF REYNOLDBURG 060
NUMBERS
- ORIGINAL COUNTY SURVEY MONUMENT



O
106
B

O
106
B