


O
106
B

O
106
B

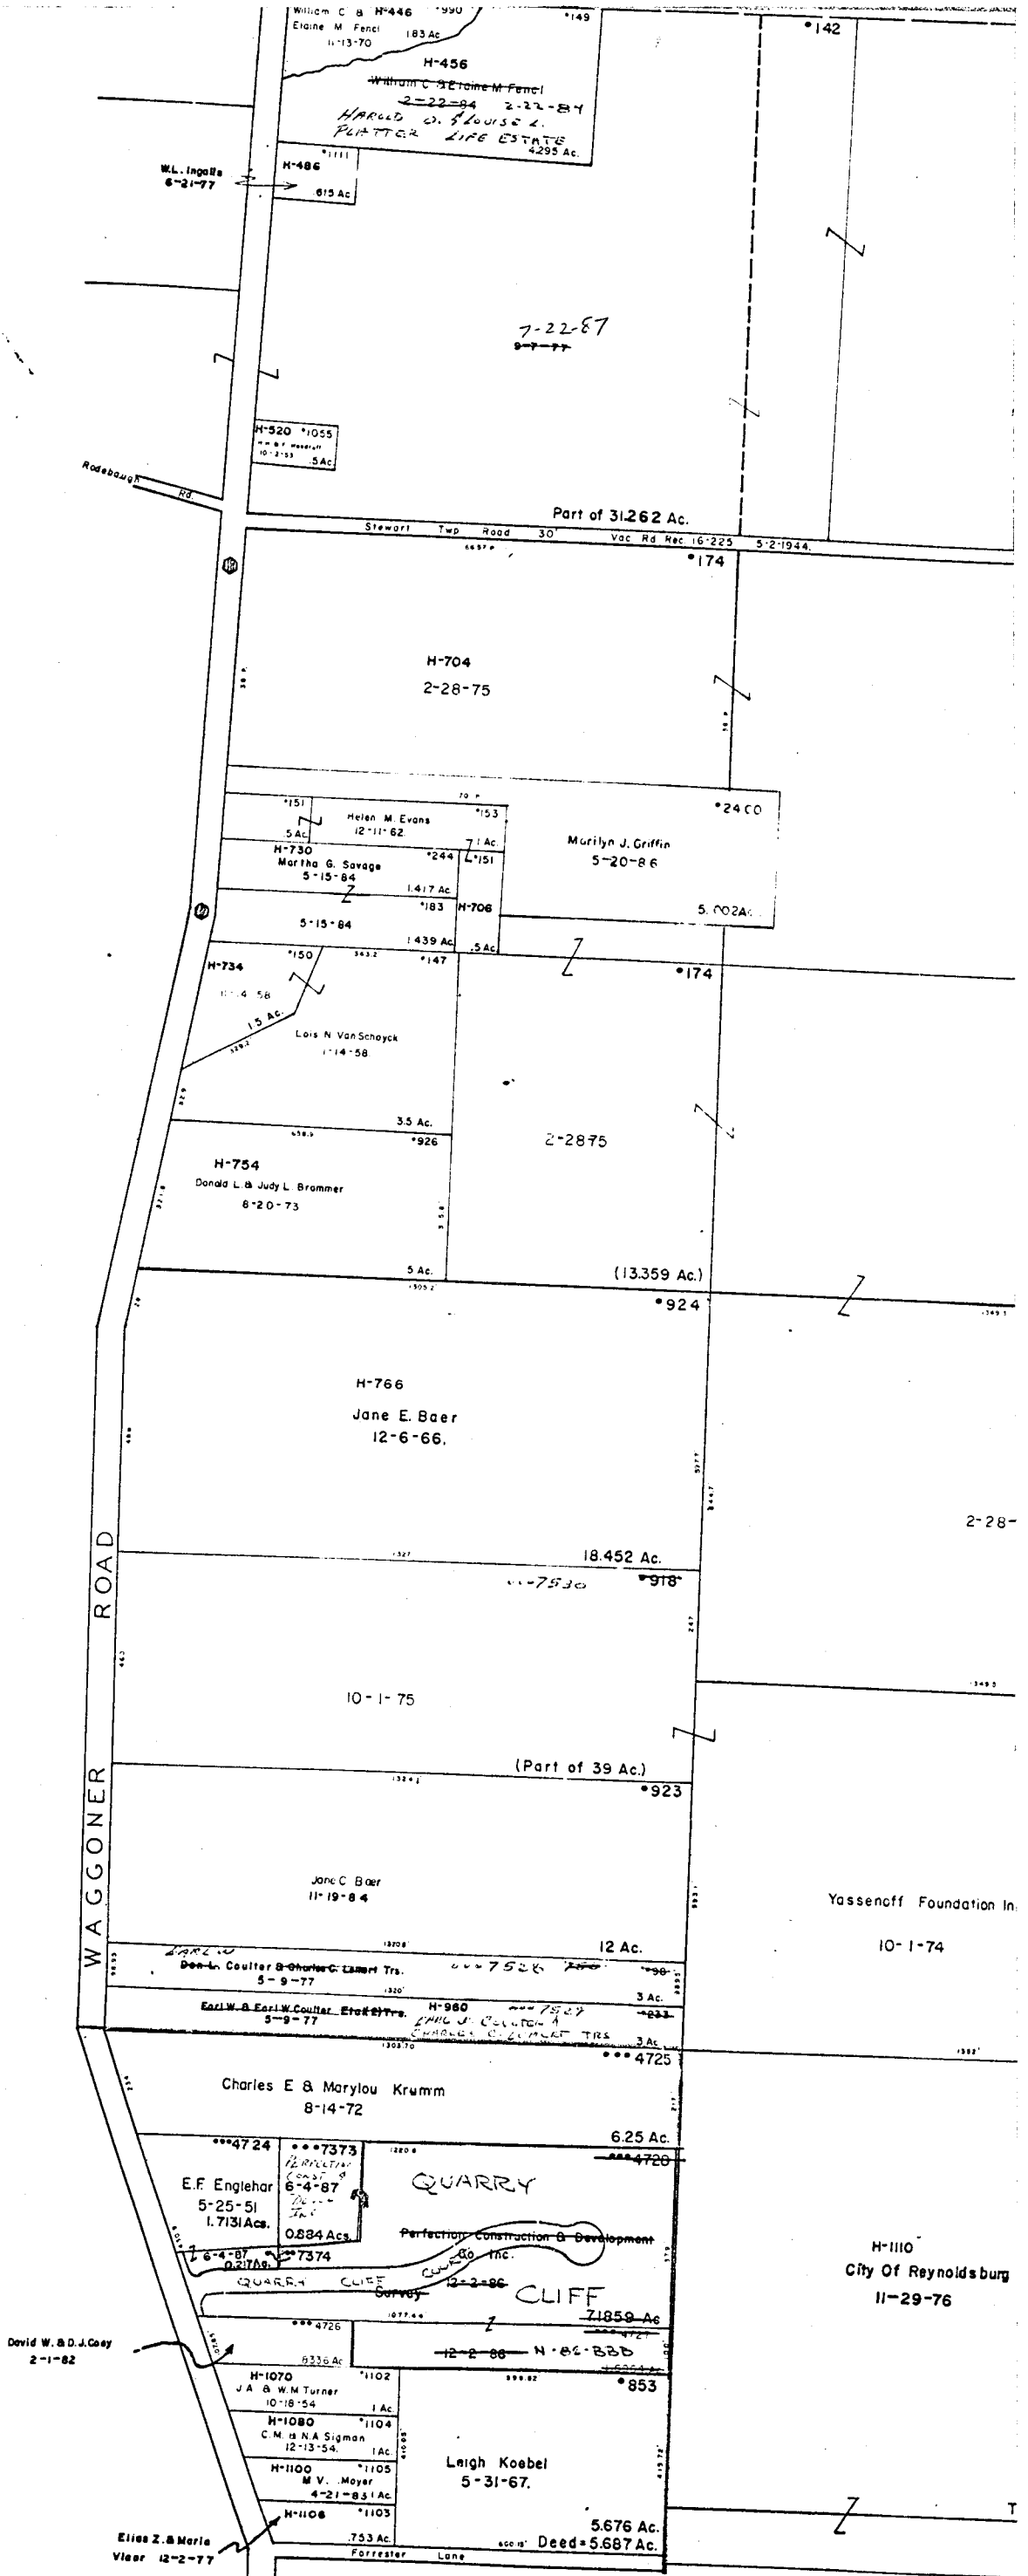

0
40

O-106-C

TRURO TWP

R-20 N TWP-16

SCALE 1" = 200'

E=HIGHWAY EASEMENT


TAXING DISTRICT DISTRICT CODE

TRURO REYNOLDSBURG SD 253

CITY OF REYNOLDSBURG 060

H---HOUSE NUMBERS

○ *Reynoldsburg*

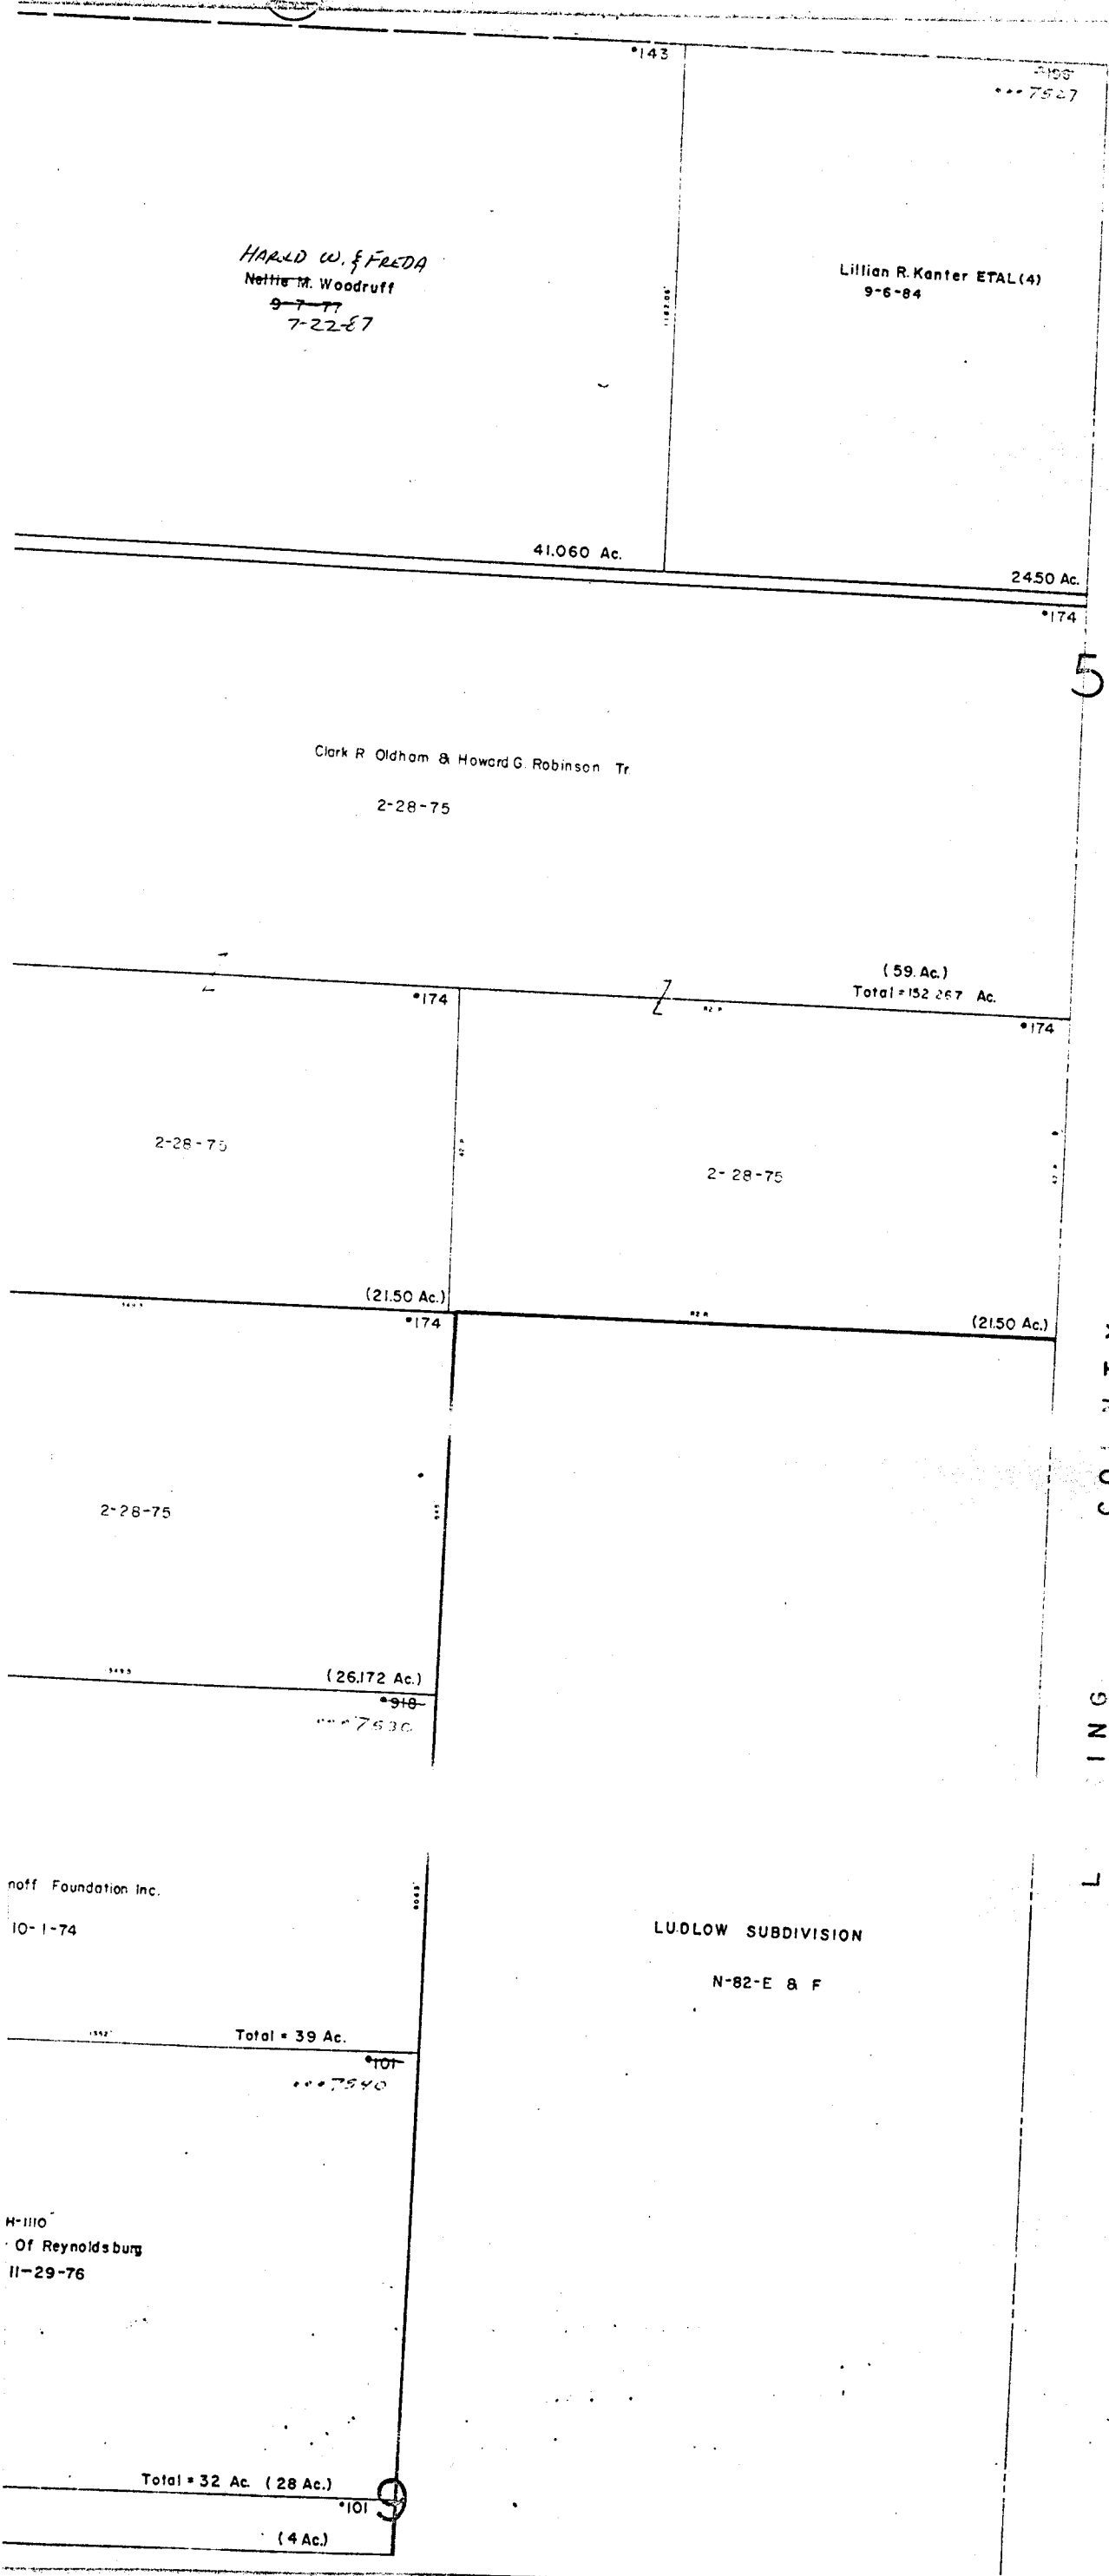

5

L
I
N
G
C
O
U
N
T
Y

1538

O-106-C