

0-109-B
WASHINGTON TWP




SCALE 1"=200'
V.M.S.

E= HIGHWAY EASEMENT
TAXING DISTRICT DISTRICT CODE

WASHINGTON	270
• WASH. TWP-DUBLIN CORP.	273
•• WASH. TWP-HILLIARD S.D.	272
••• WASH. TWP-DUBLIN CORP - HILLIARD S.D.	274

SEE HOUSE NUMBERS

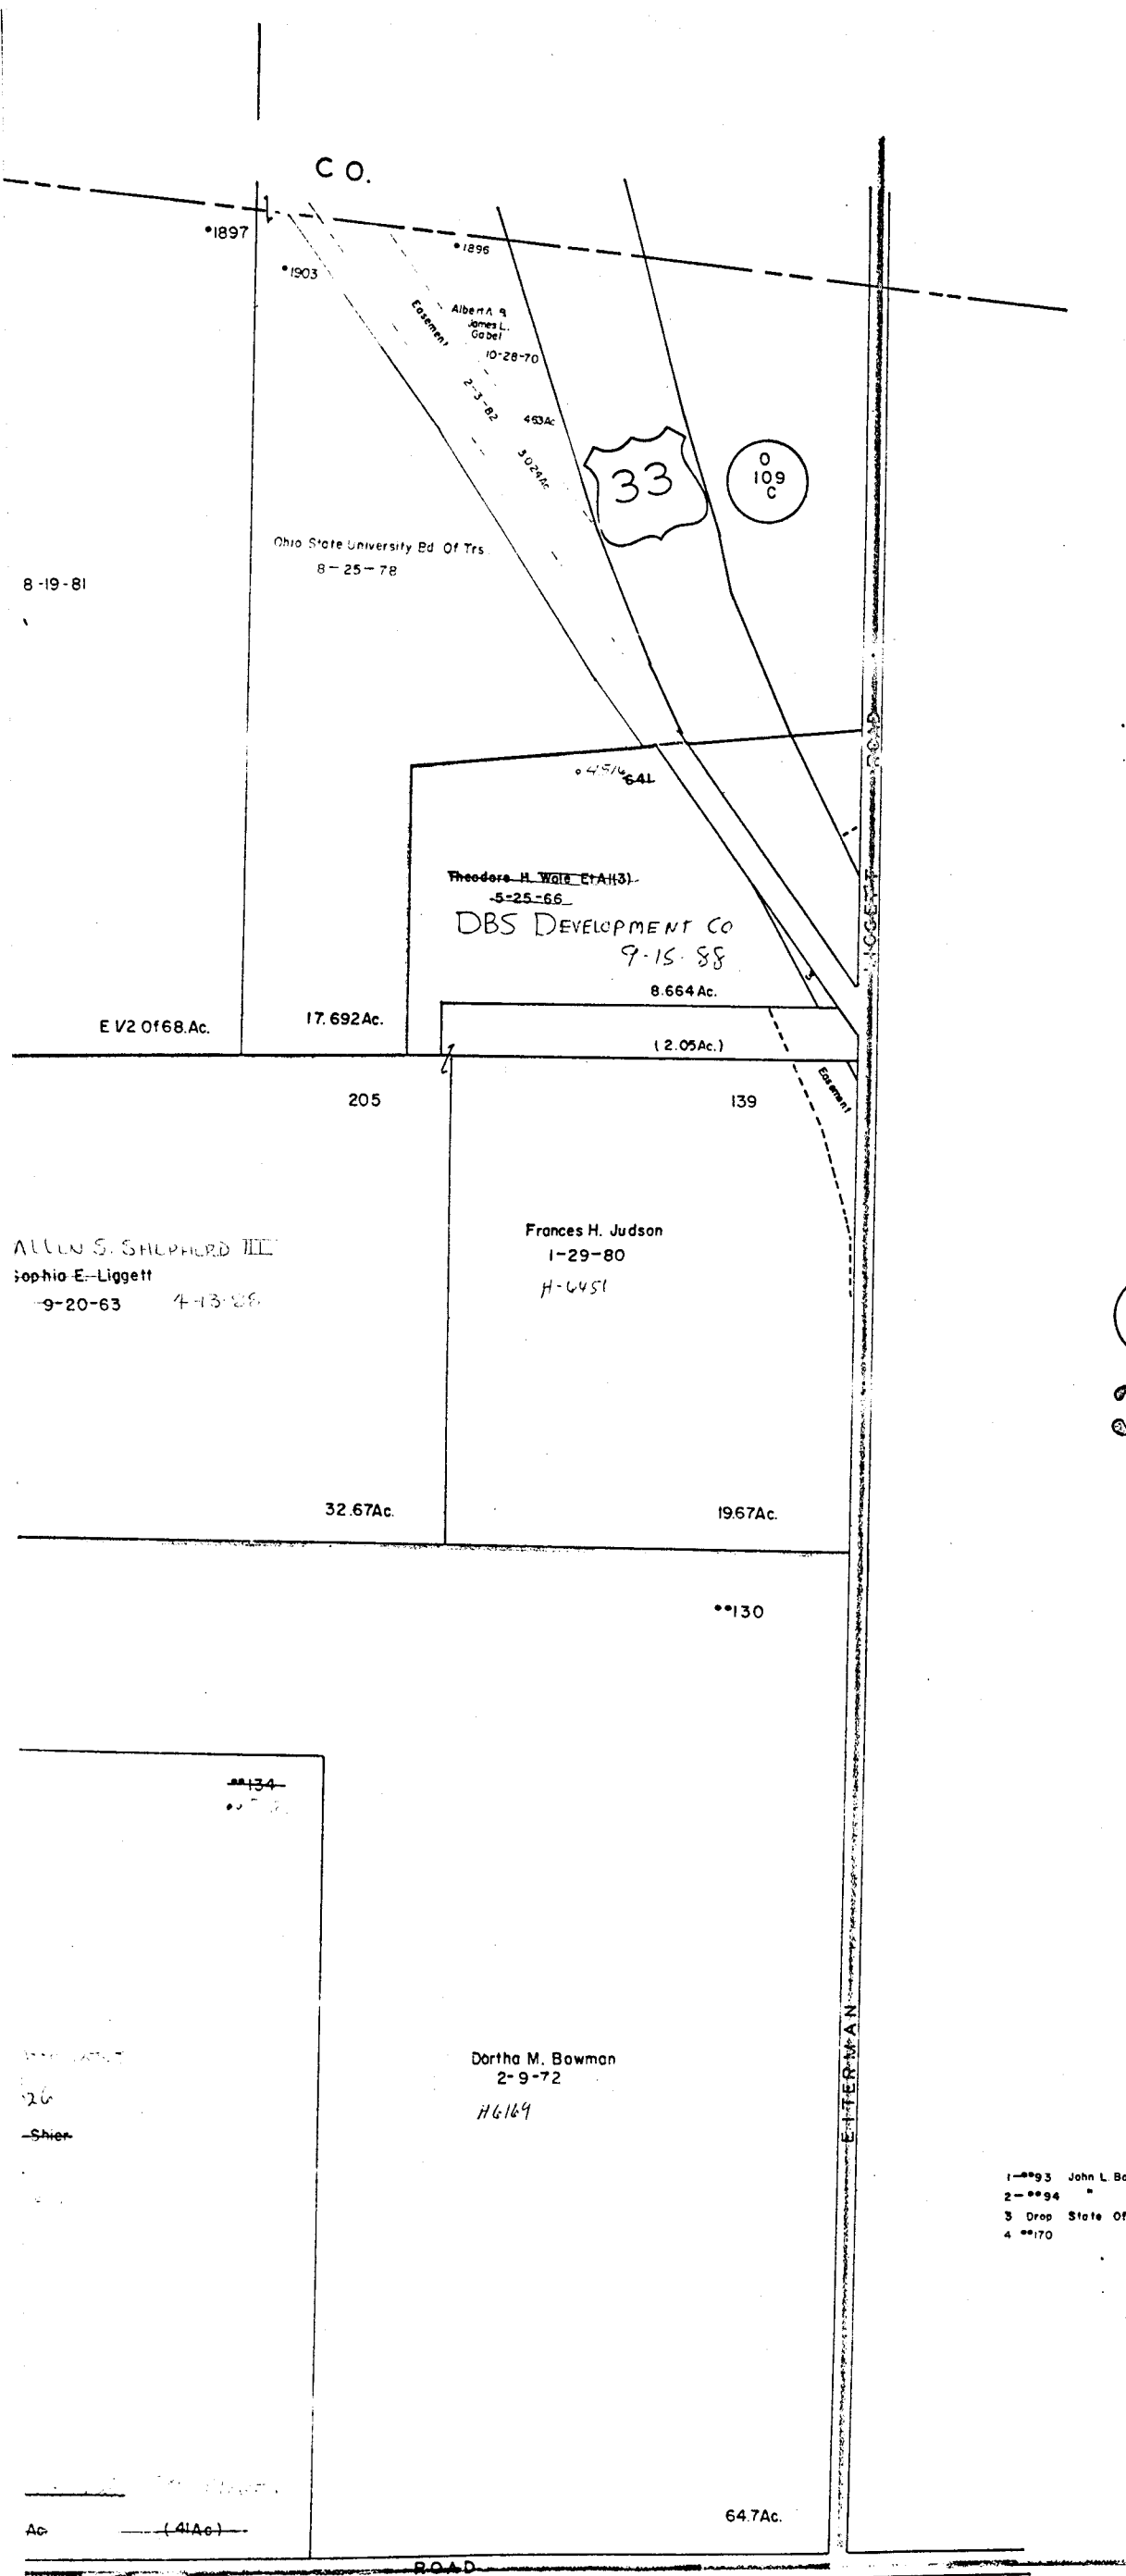

0
109
C

3452

EITERMAN ROAD

- 1-1893 John L. Bond 6-3-81 50'x100' H5275
- 2-1894 " " " " 0.152 Ac.
- 3 Drop State Of Ohio 11-29-66 0.475 Ac.
- 4 1870 Clara Hamilton 9-10-64 0.61 Ac. W.D. E. II. & SHARON A. Downey 11-29-88

Ac. (41Ac)

ER ESTATES

SHIER LANE

-88-C

0
110
3

3453

0-109-B

