


0
110
A

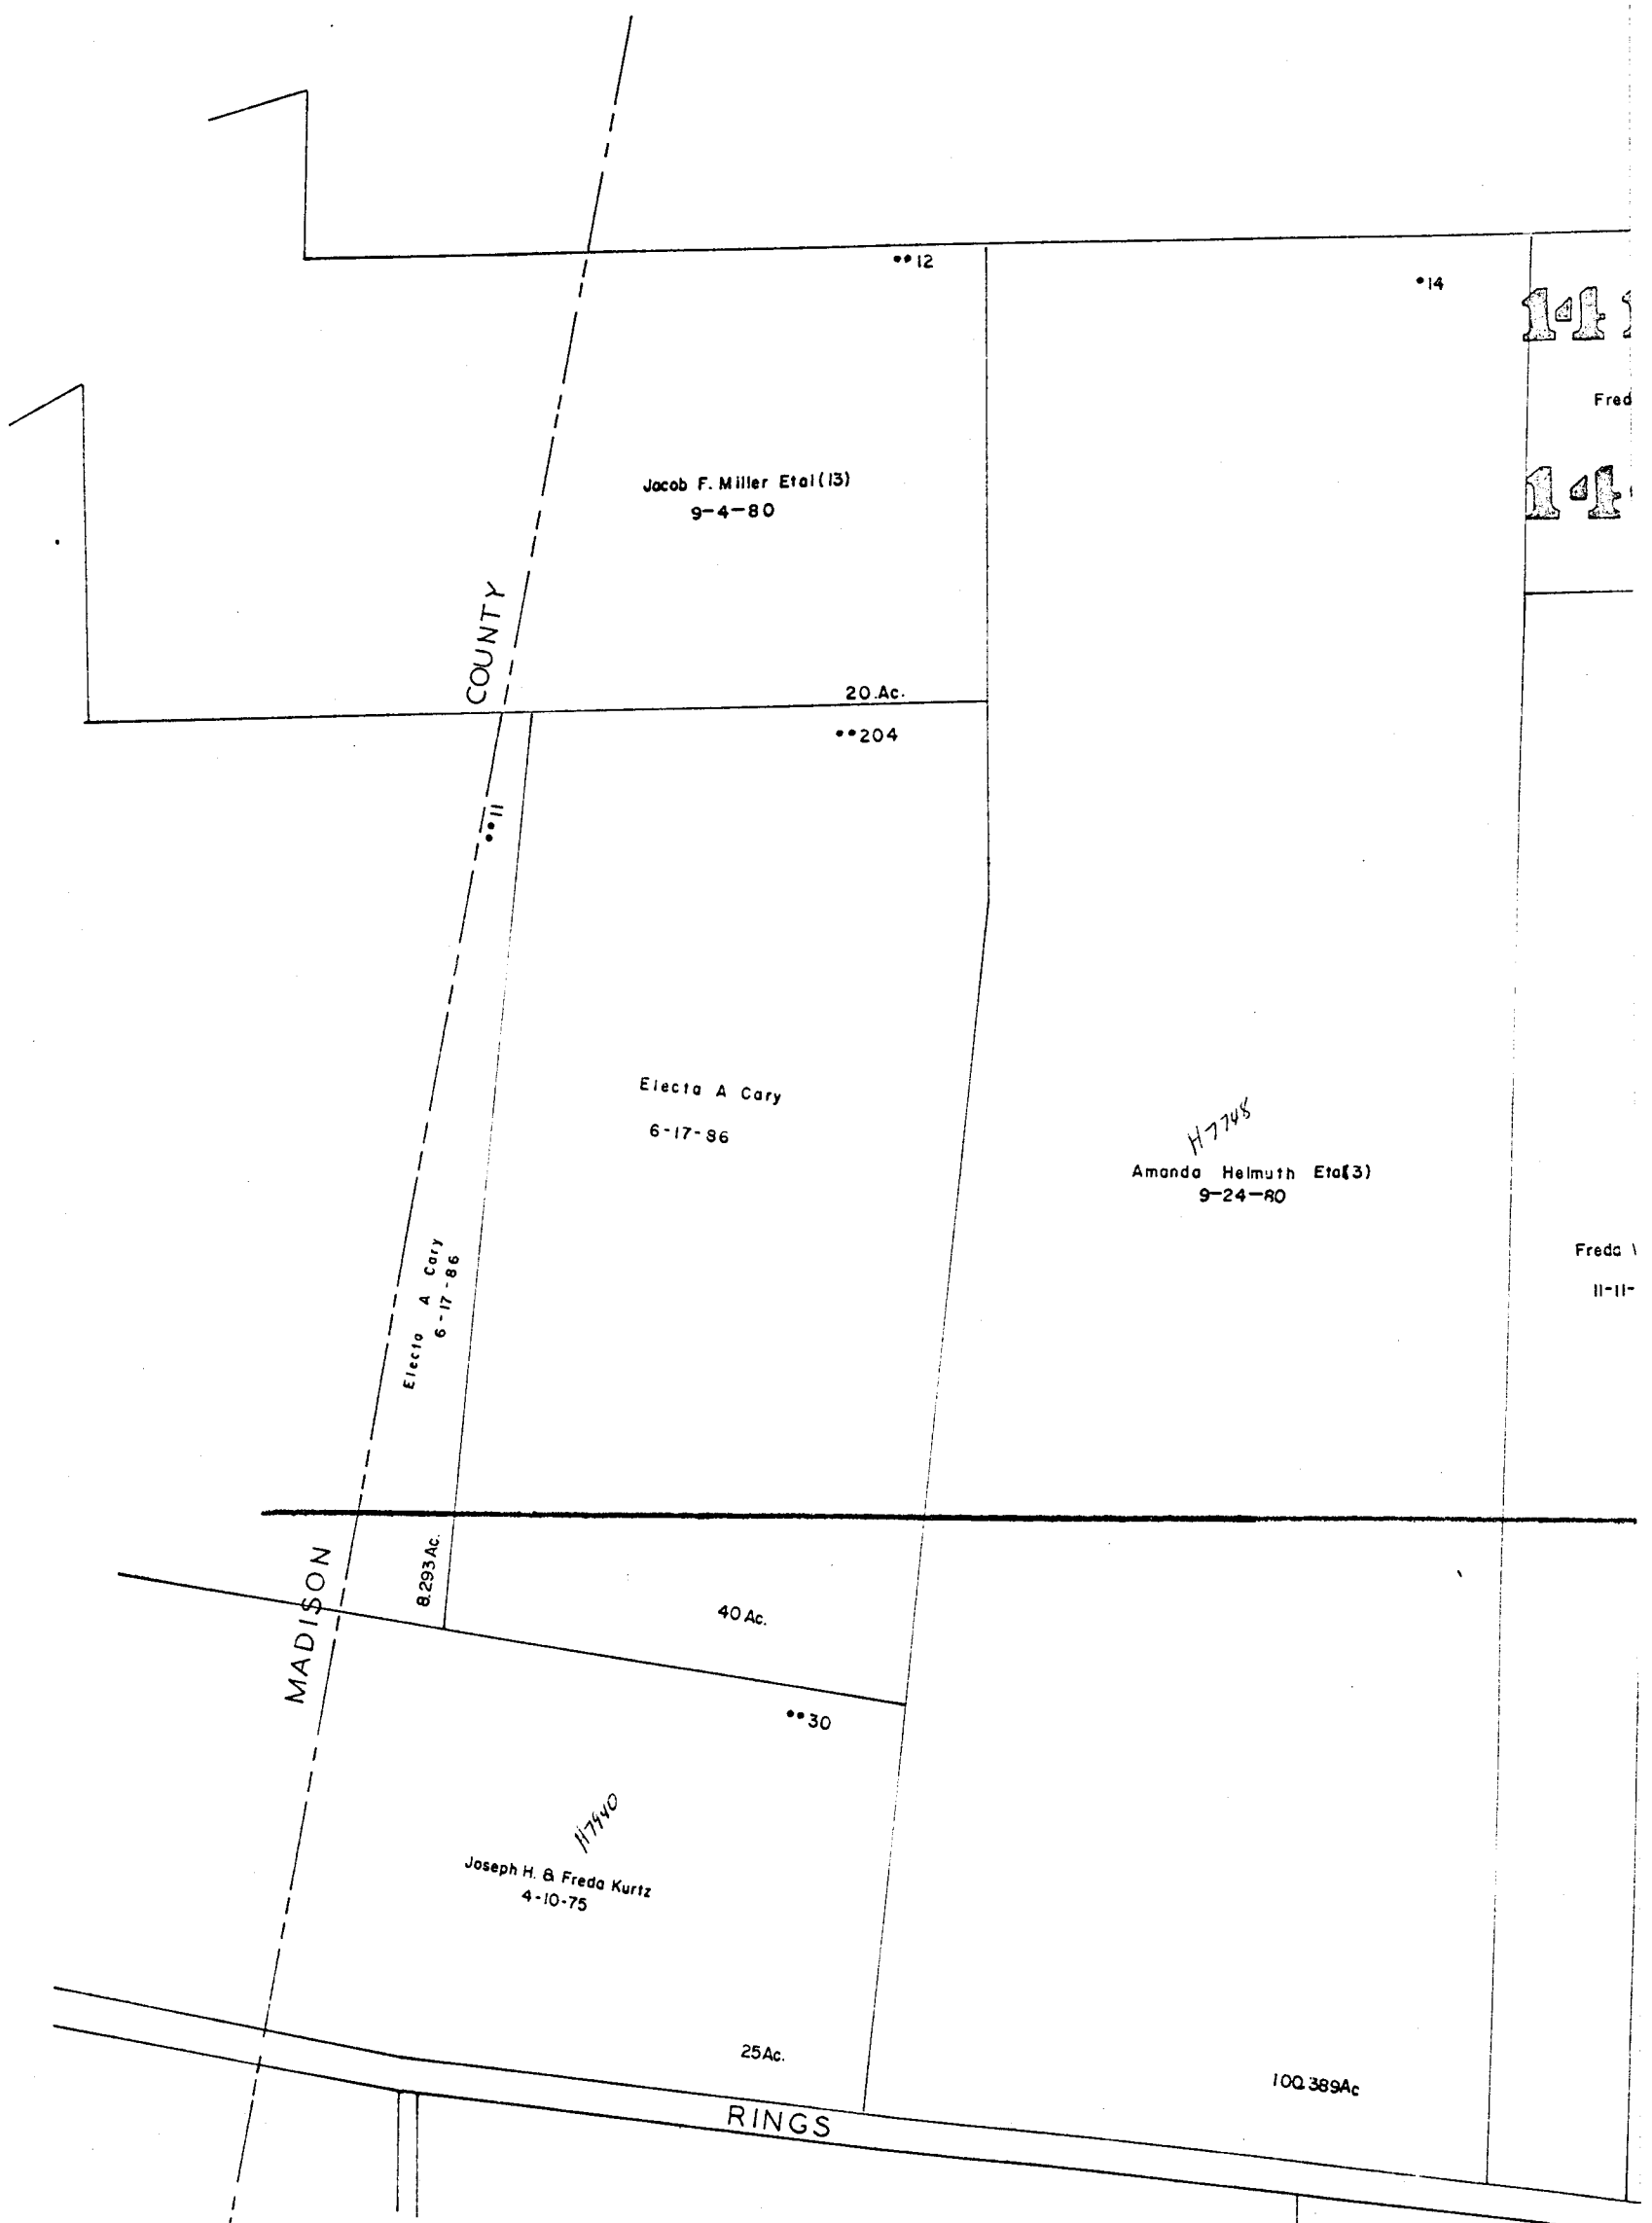

141

Freda

141

COUNTY

**12

**14

Jacob F. Miller Etal (13)
9-4-80

20 Ac.

**204

Electa A Cary
6-17-86

H7745
Amanda Helmuth Etal (3)
9-24-80

Freda
11-11

Electa A Cary
6-17-86

MADISON

8293 Ac.

40 Ac.

**30

H7740
Joseph H. & Freda Kurtz
4-10-75

25 Ac.


100.389 Ac

RINGS

78335

0
110
G

0-110-D
WASHINGTON TWP.

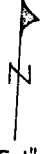

SCALE 1"=200'

V.M.S.


E=HIGHWAY EASEMENT
TAXING DISTRICT DISTRICT CODE
••WASH-SCIOTO DARBY 272

H... HOUSE NUMBERS

0
110
A

6953

0
110
E

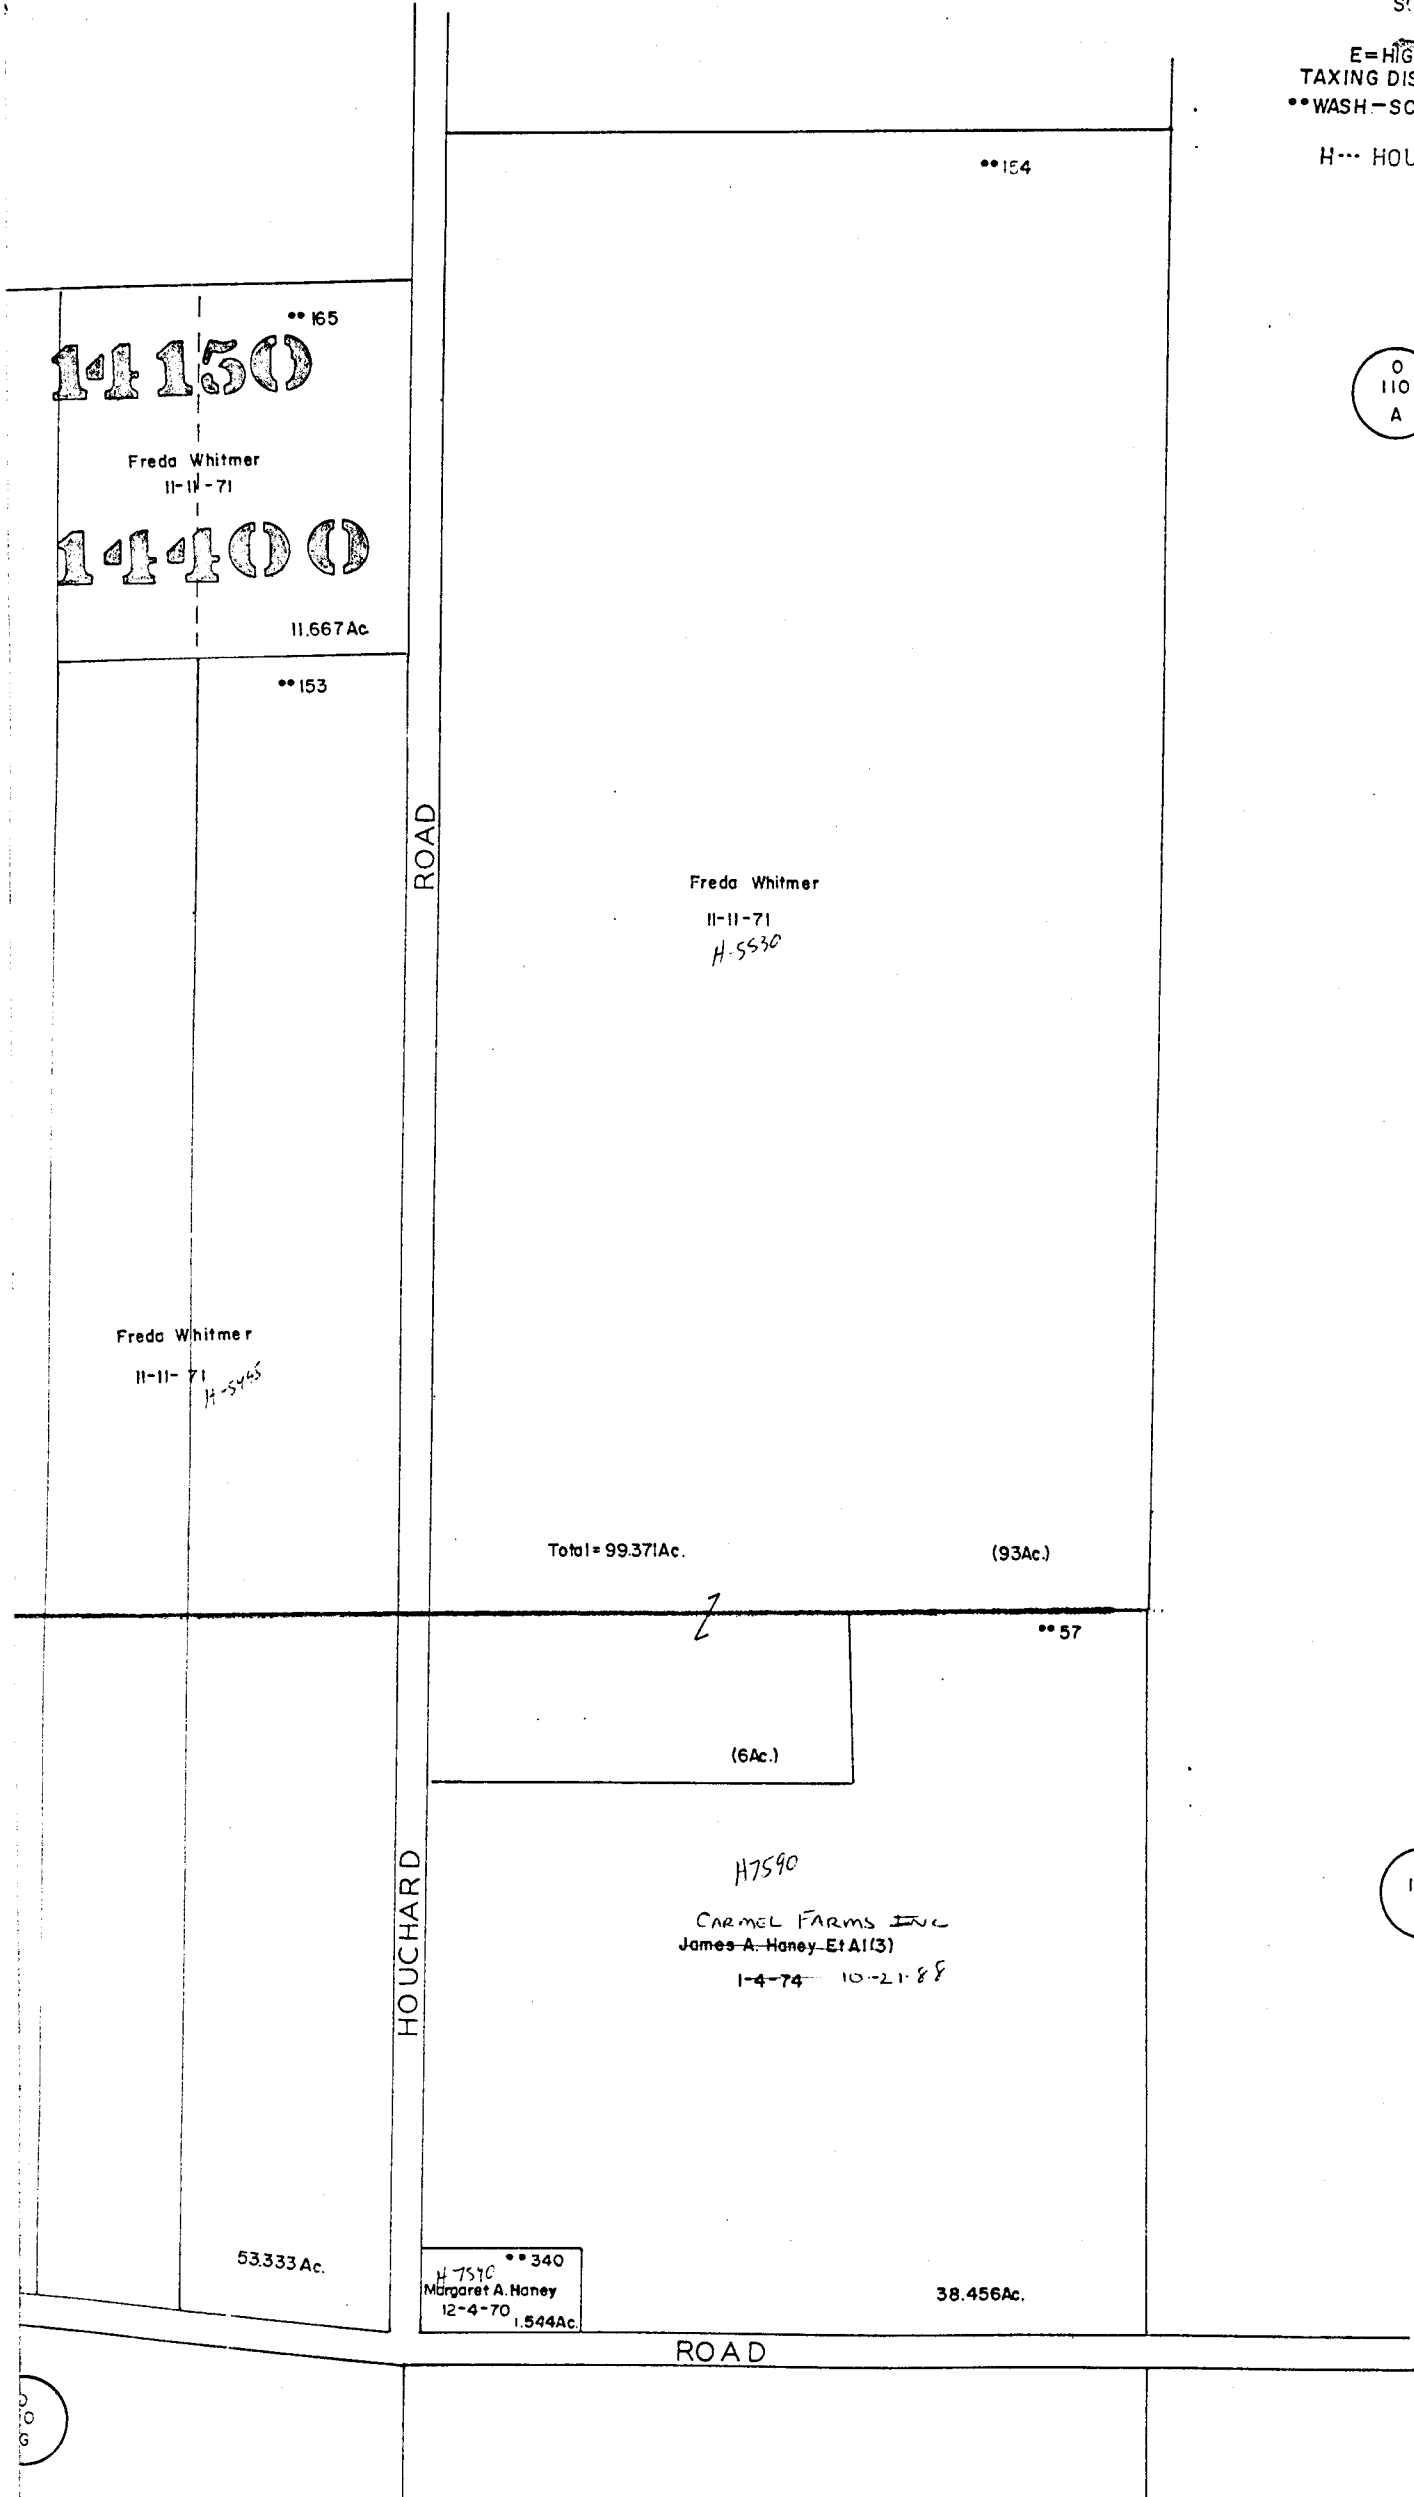

0-110-D
