

①	**10	John G & Dolores D'Amico	12-3-85
②	**335	Columbia Gas of Ohio, Inc.	1-30-70
③	**40	Jeffrey C. & Faye M. Spriggs	9-18-85
④	**453	Ben M. & Beverly K. Kennedy	8-13-86
⑤	**452	Chester A & Kay E. Gunka	12-3-82
⑥	**446	Stanley R. & Patricia L. Haas	4-9-79
⑦	**445	John S. & D.L. Kunze	8-9-78

O-110-K

WASHINGTON TWP




SCALE 1" = 200'
V.M.S.
E=HIGHWAY EASEMENT


TAXING DISTRICT DISTRICT CODE
 ** WASHINGTON-HILLIARD S.D. 272
 H--- HOUSE NUMBERS

O
110
F

3001

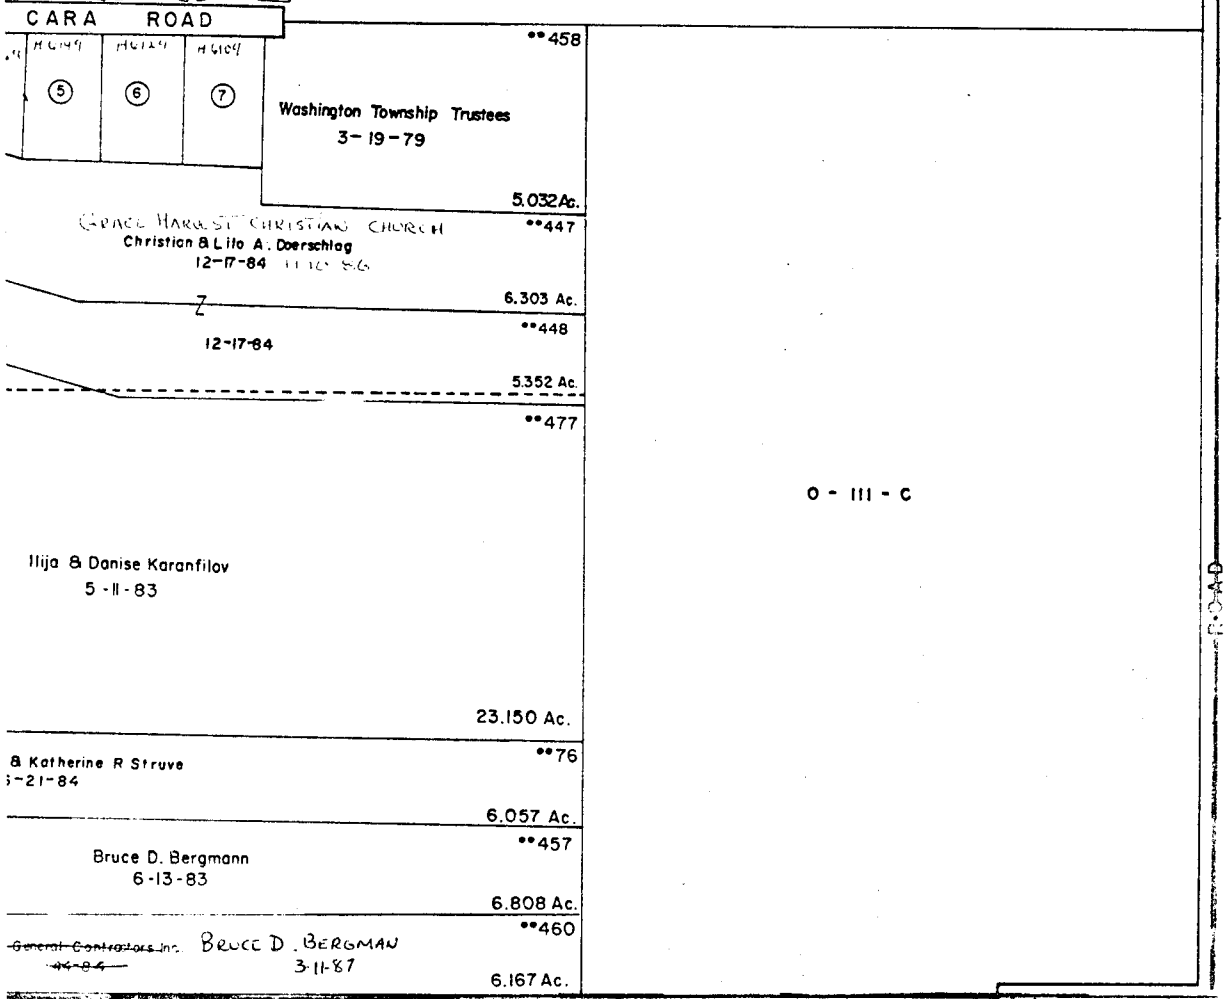

O
111
C

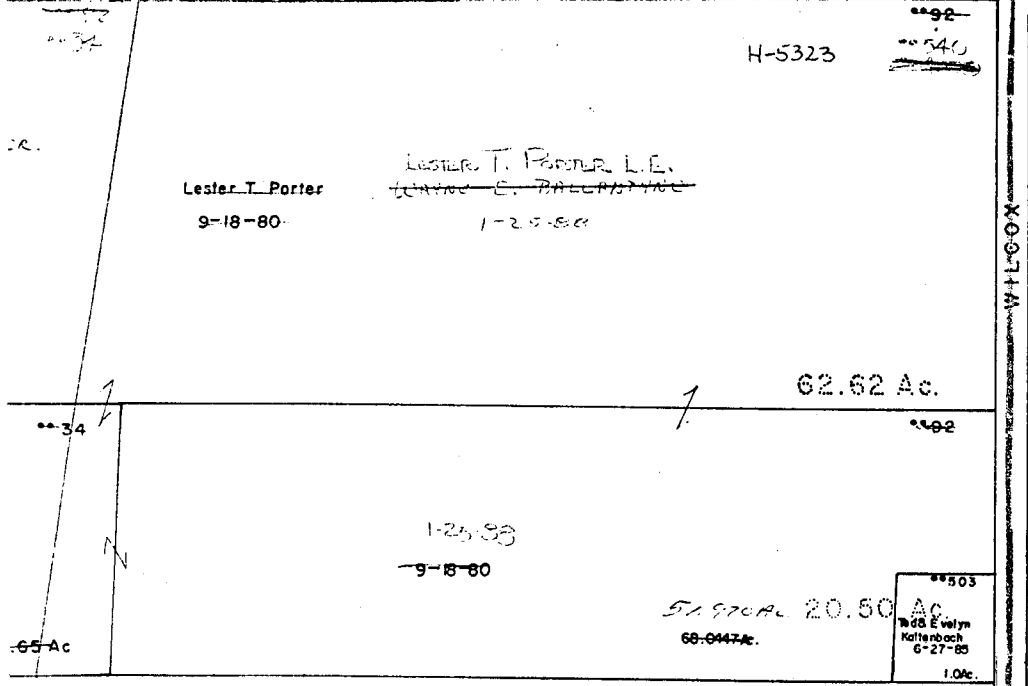

O
111
C

3012

O
110
F

12-3-85	.871 Ac
1-30-70	0.10 Ac
9-18-85	1.024 Ac
8-13-86	1.030 Ac.
12-3-82	0.861 Ac.
4-9-79	0.861 Ac.
8-9-78	0.861 Ac.

O-110-K