

O-III-C
WASHINGTON TWP



SCALE 1"=200'

V.M.S.

E=HIGHWAY EASEMENT



TAXING DISTRICT DISTRICT CODE

WASHINGTON 270

WASH.-HILLIARD S.D. 272

Col's 010

H HOUSE NUMBER

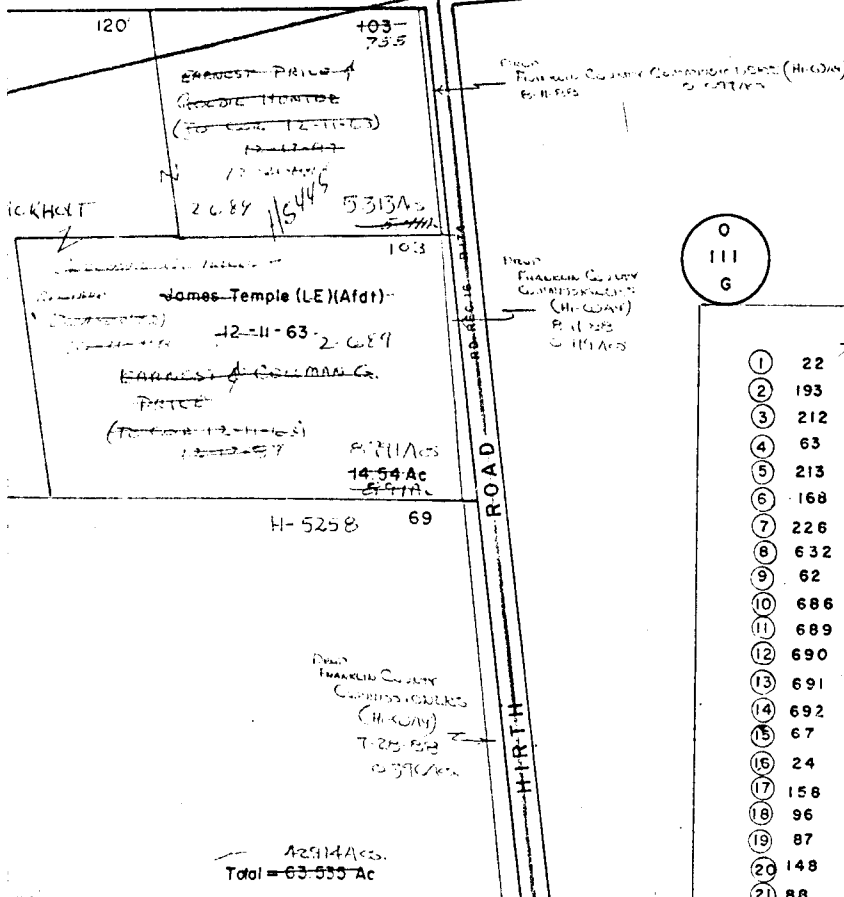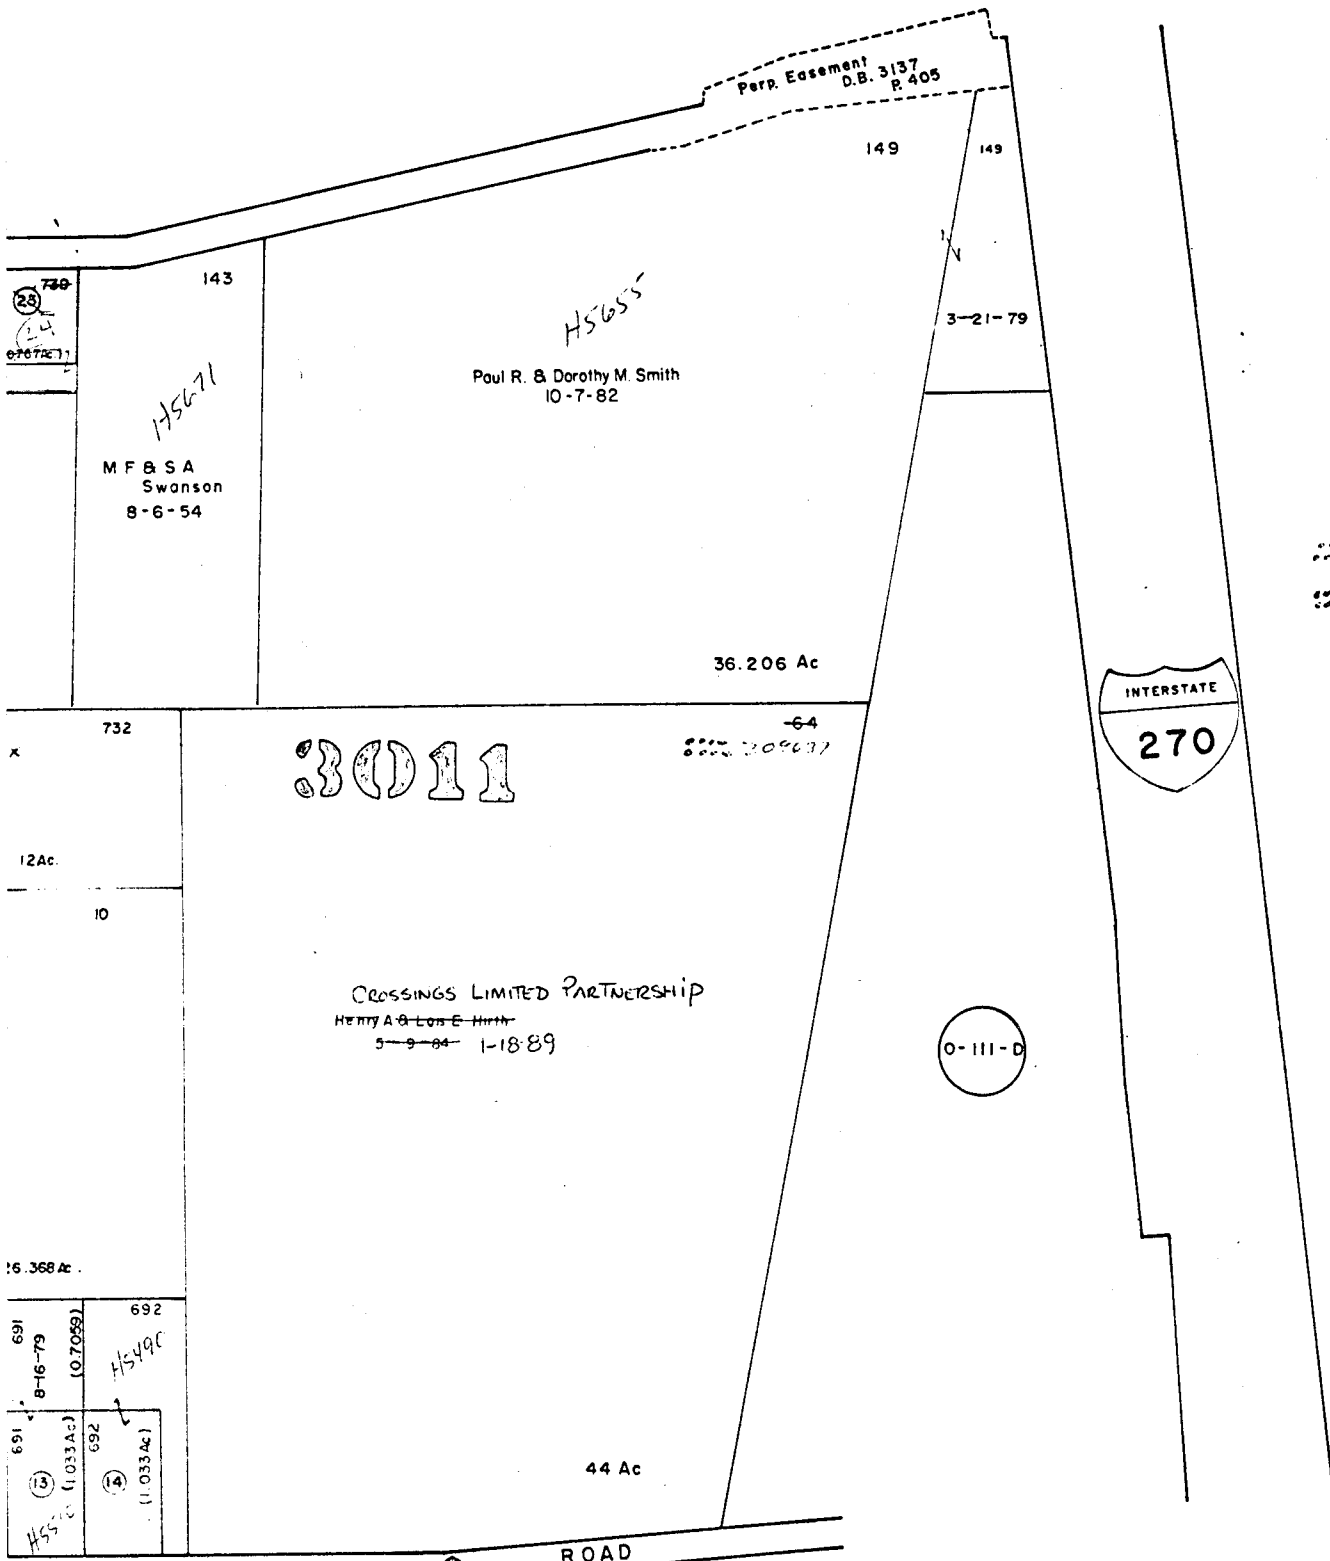

Parcel #	Owner Name	Date	Acreage
22	Morris Kirkpatrick	7-14-86	1.227 Ac
193	Lee W. Dong et al	6-16-82	1.227 Ac
212	Charles O. & Mary M. Holliday	8-9-85	1.2068 Ac
63	E W & Virginia K Williams	11-8-72	1.2068 Ac
213	J M & J A Johnson	2-1-73	1.2068 Ac
168	David H & D Grease	11-1-67	1.032 Ac
226	Leah M Morris	10-27-67	1.033 Ac
632	Simon L. & Susan C. Still	8-22-86	1.739 Ac
62	Harry G. & M. Kaszewicz	7-7-75	1.023 Ac
686	H G & M M Kaszewicz	8-7-67	1.033 Ac
689	Darrel G & S W Mahanna	10-3-73	1.739 Ac
690	Edison C. & Susan K. Nelson	7-9-85	1.739 Ac
691	John R. & Sherry L. Stewart	8-19-86	(1.033 Ac) Total=1.7389 Ac.
692	A R & J C Whitehead	5-9-74	2.3251 Ac.
67	Russel & C L Duemmel	6-5-68	1 Ac
24	D K & J L Corbett	6-5-68	1 Ac
156	J L & D R Corbett	9-8-70	1 Ac
96	Geo. W. & R D Sherman	6-9-71	1.091 Ac
87	D S & D L Lowery	6-2-71	1.203 Ac
148	Donald S. & D. L. Lowery	6-1-77	1.313 Ac
88	R G Crooks	6-4-71	.9937 Ac
160	Lee W Dong et al	6-16-82	.8975 Ac
740	Ruth Long	7-24-86	1.0 Ac
740	Steven S. & Angela Martin	7-24-86	1.0 Ac

O-III-C

