


O
III
B

2119

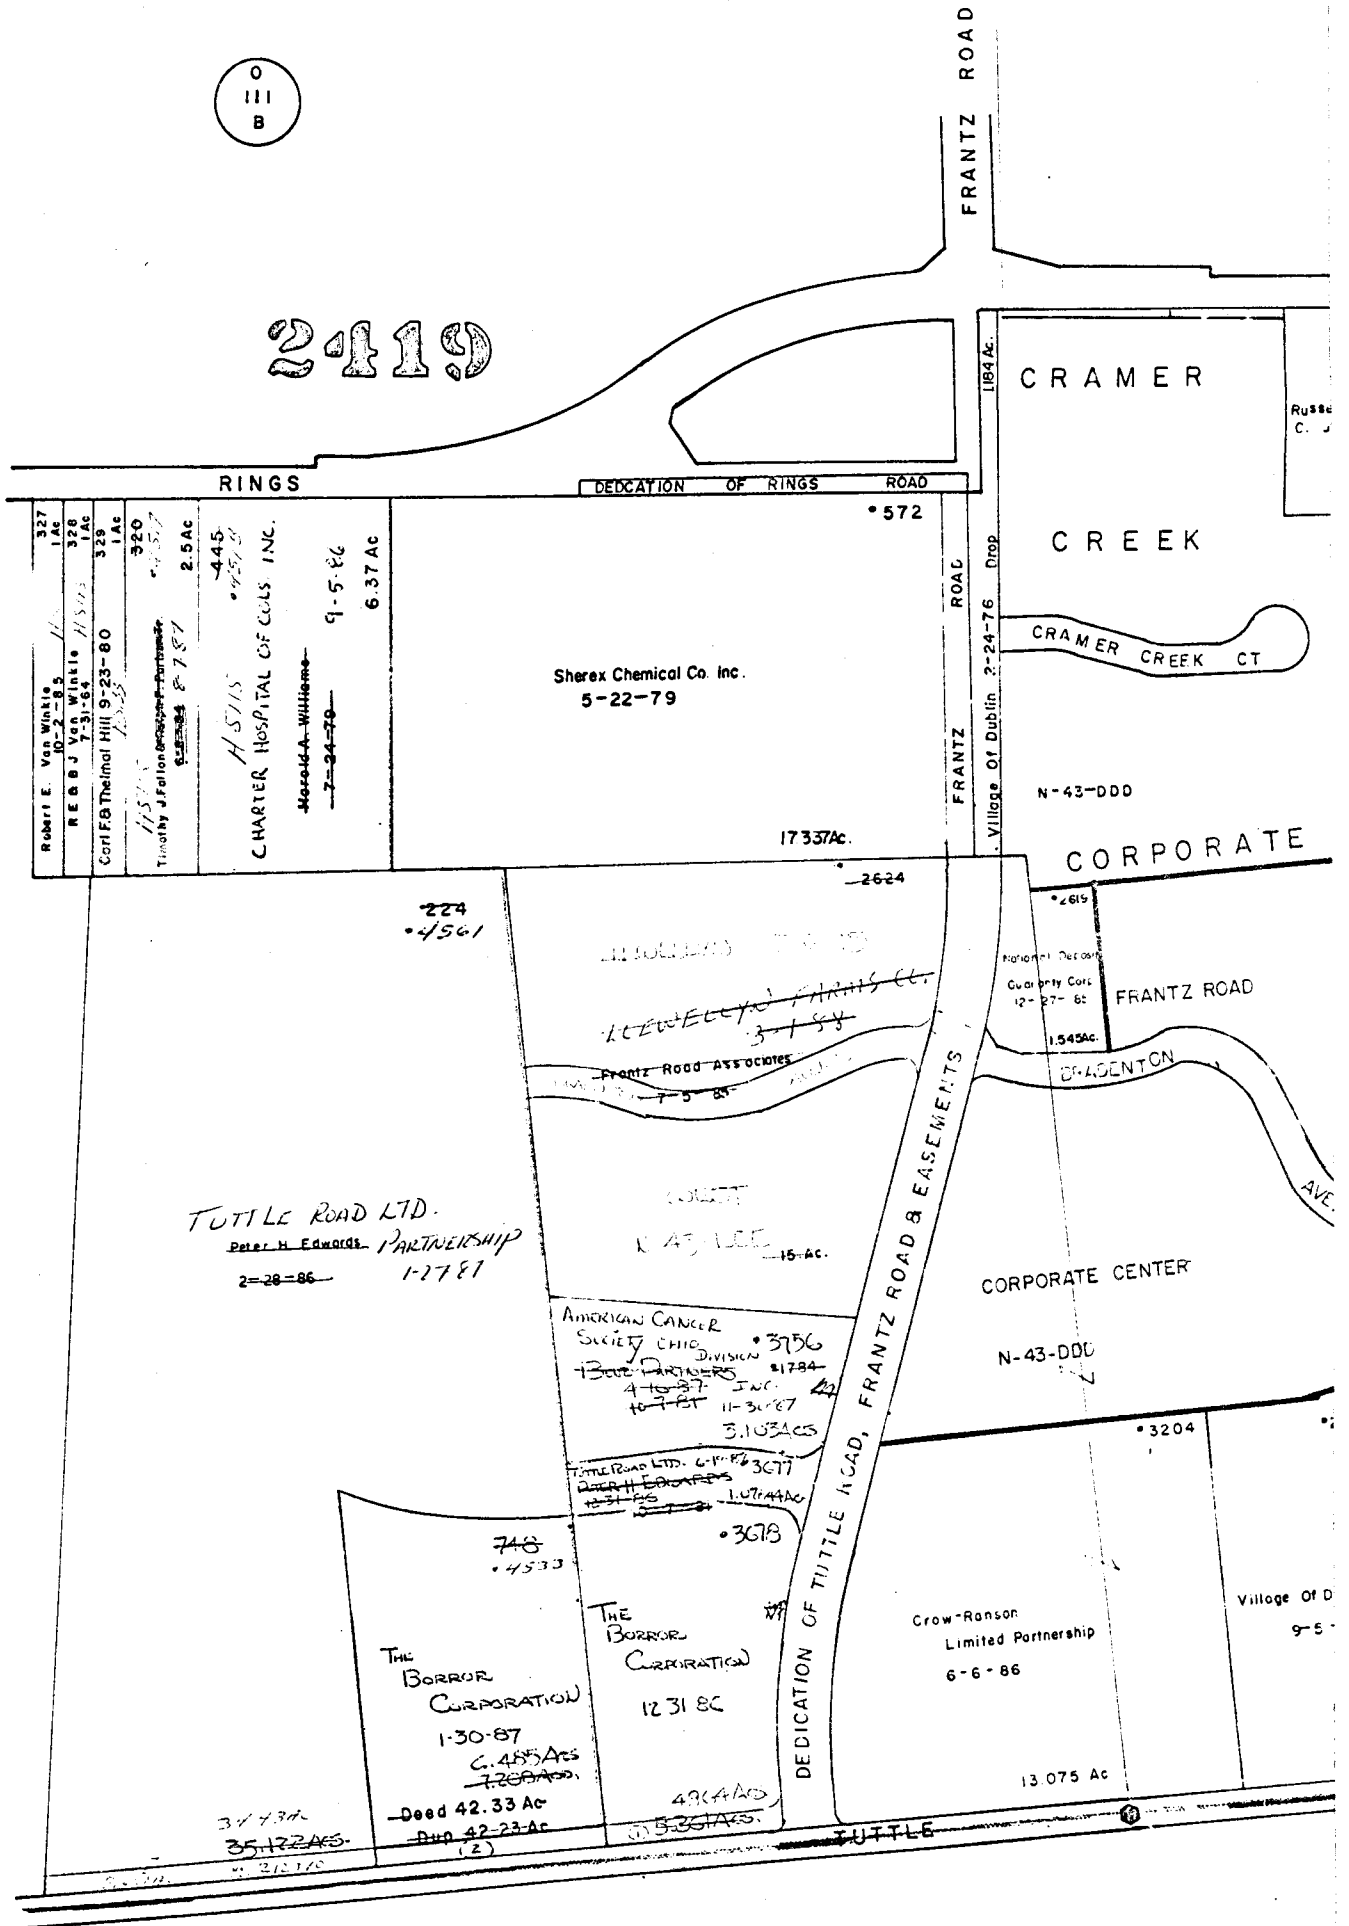


O-III-E
WASHINGTON TWP



SCALE 1" = 200'

V.M.S.
E=HIGHWAY EASEMENT
TAXING DISTRICT DISTRICT CODE
WASHINGTON 270
• WASH. DUBLIN CORP 273
H... HOUSE NUMBER

FRANKLIN COUNTY SURVEY DOCUMENT

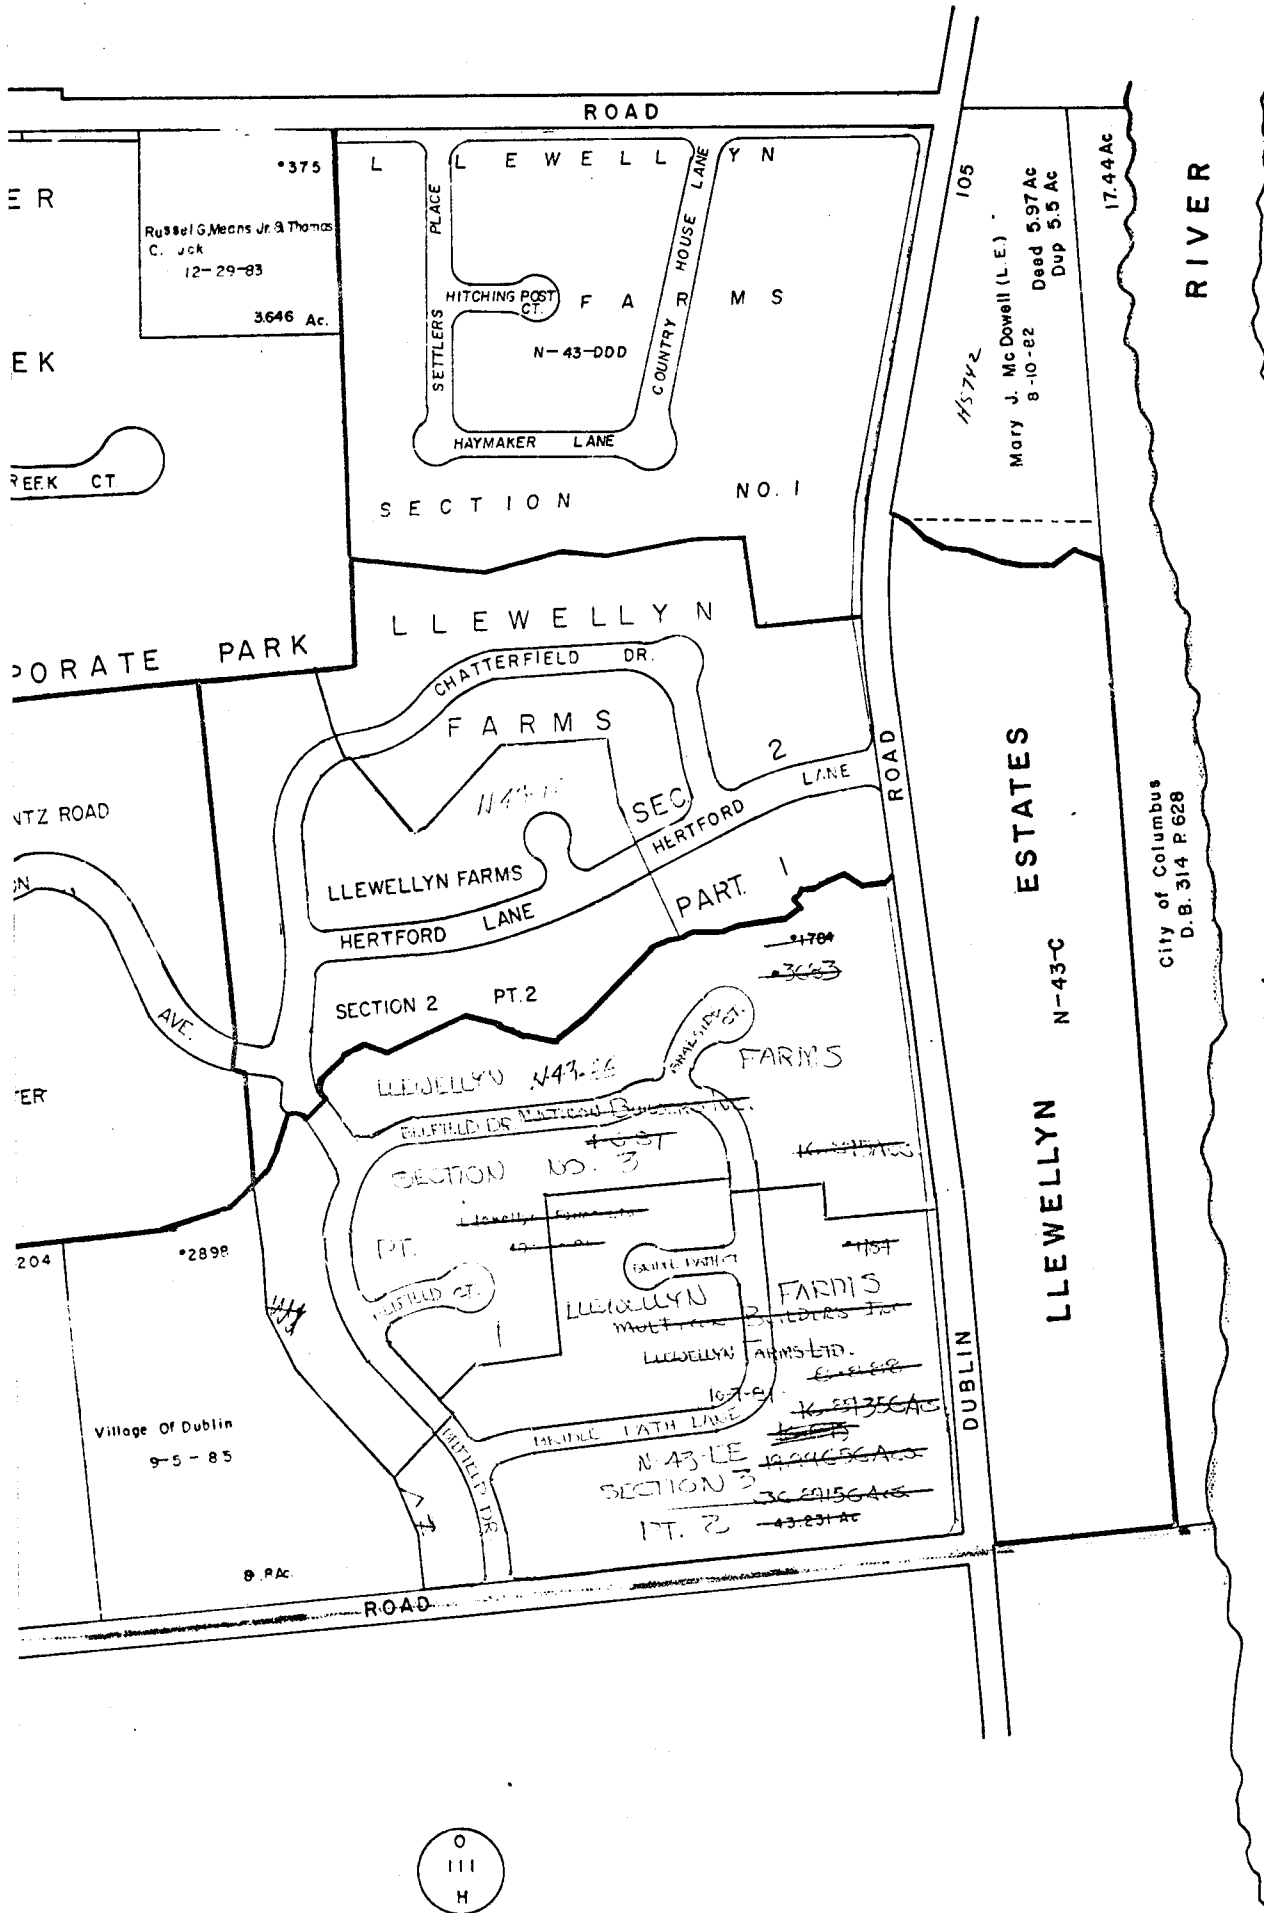

PERRY TOWNSHIP

SCIOTO

O-III-E