

0  
111  
D

2

C  
111  
C

C  
111  
A


C  
111  
F

3022



2419

O III E

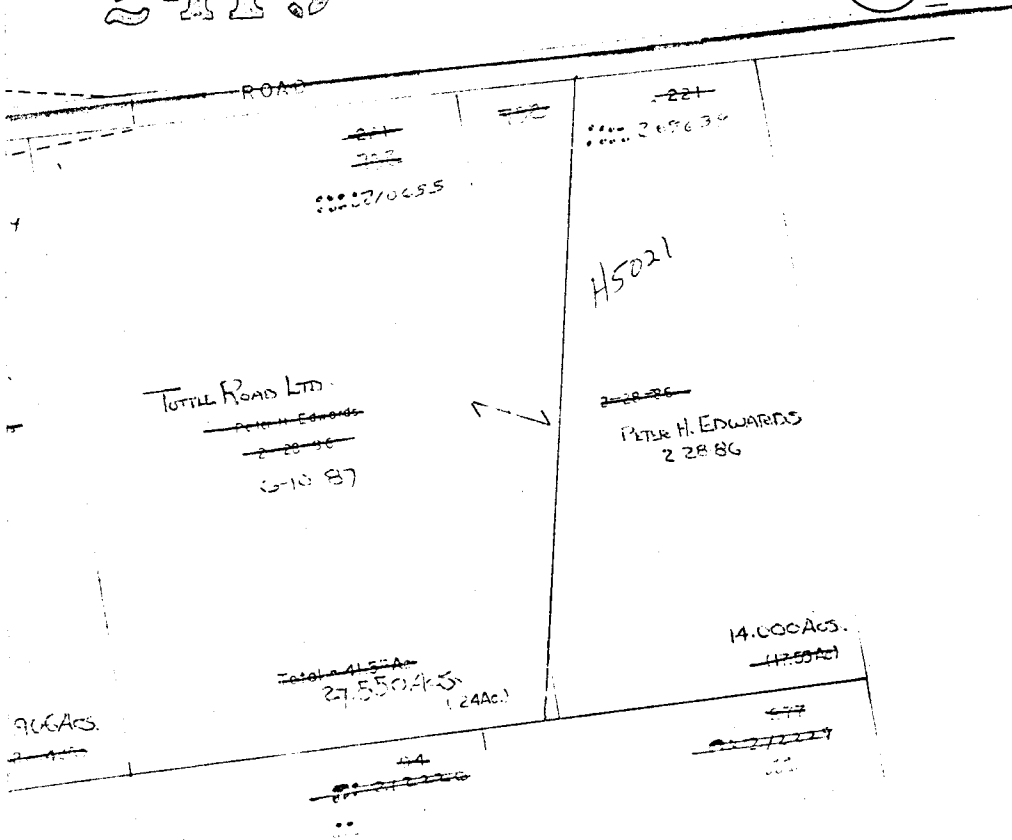

O-III-G  
WASHINGTON TWP.



SCALE 1"=200'

E=HIGHWAY EASEMENT

TAXING DISTRICT DISTRICT CODE

WASHINGTON TWP 270

\*\*WASH TWP-HILLIARD S.D. 272

H... HOUSE NUMBER


HILLIARD 0 50

COLUMBUS - HILLIARD 200

C/S 010

2418

O III H

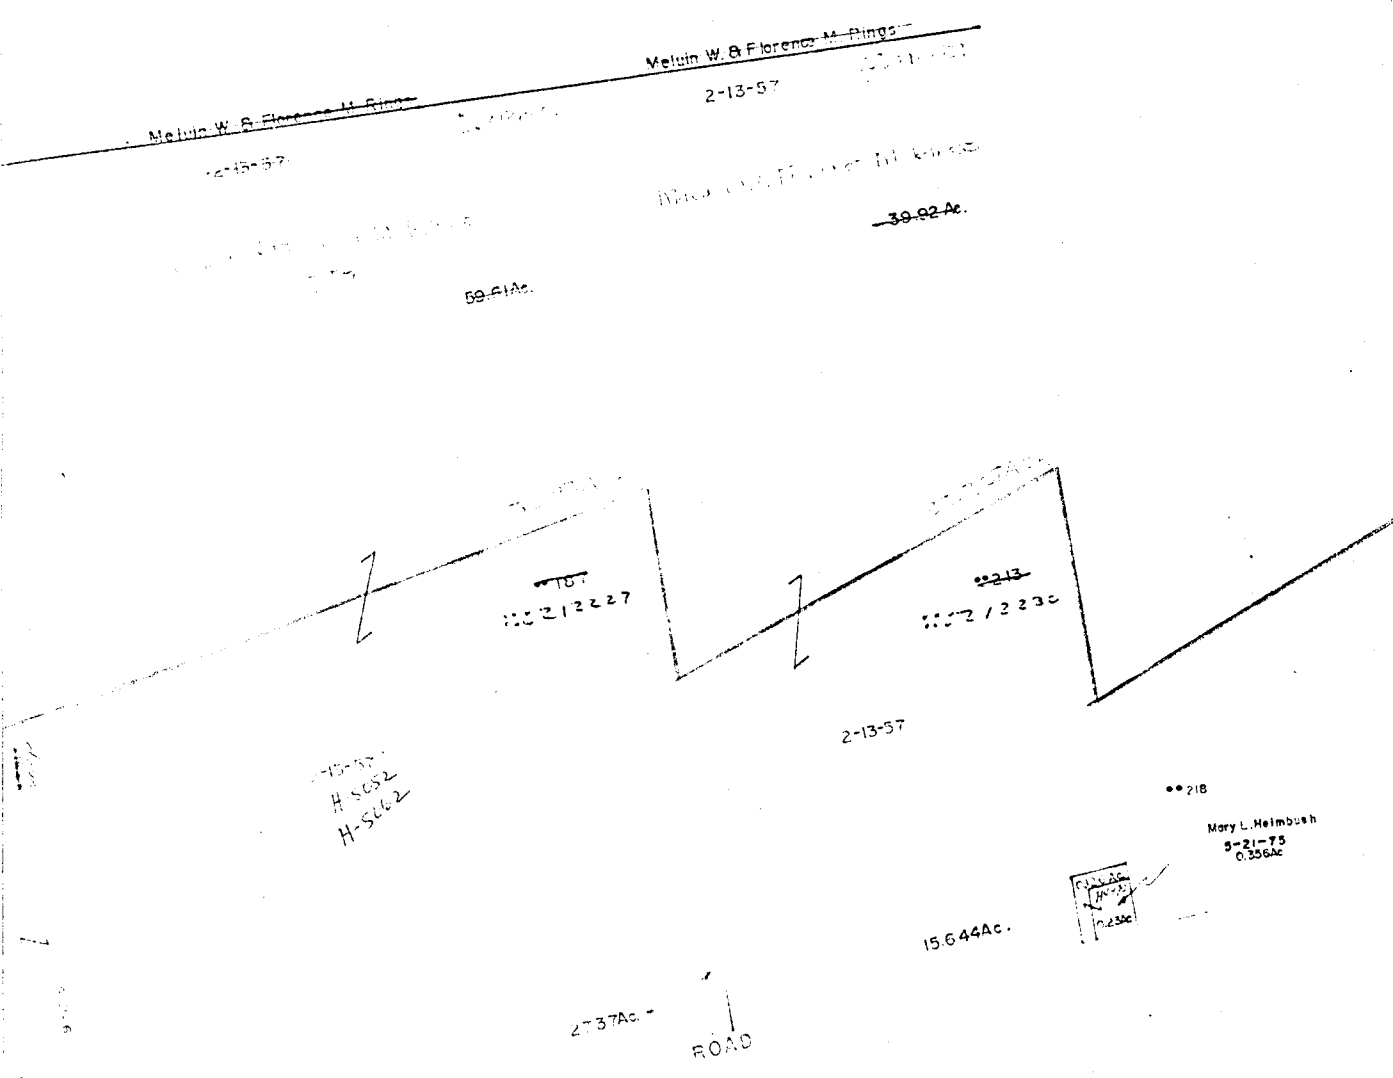

O III A

O-III-G