


0-7-F  
BROWN TWP

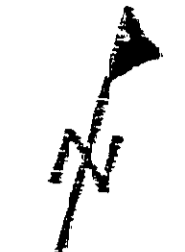

SCALE 1"=200'  
V.M.S.  
E=HIGHWAY EASEMENT  
TAXING DISTRICT BROWN  
DISTRICT CODE 120

H-HOUSE NUMBERS

882

COUNTY CREEK  
MADISON  
BIG

07C

07C

07B

09B

09A

LOT 3  
City of Columbus  
12-31-68

LOT 1  
City of Columbus  
12-31-68

LOT 3

LOT 1

LOT 4

LOT 5

LOT 2


LOT 2  
Ok Hee Song  
3-1-88

H-2271  
THE BRADLEY LAKE  
PARTNERSHIP

2606

DEED BOOK  
RECORDERS OFFICE  
PAGE 181

2670

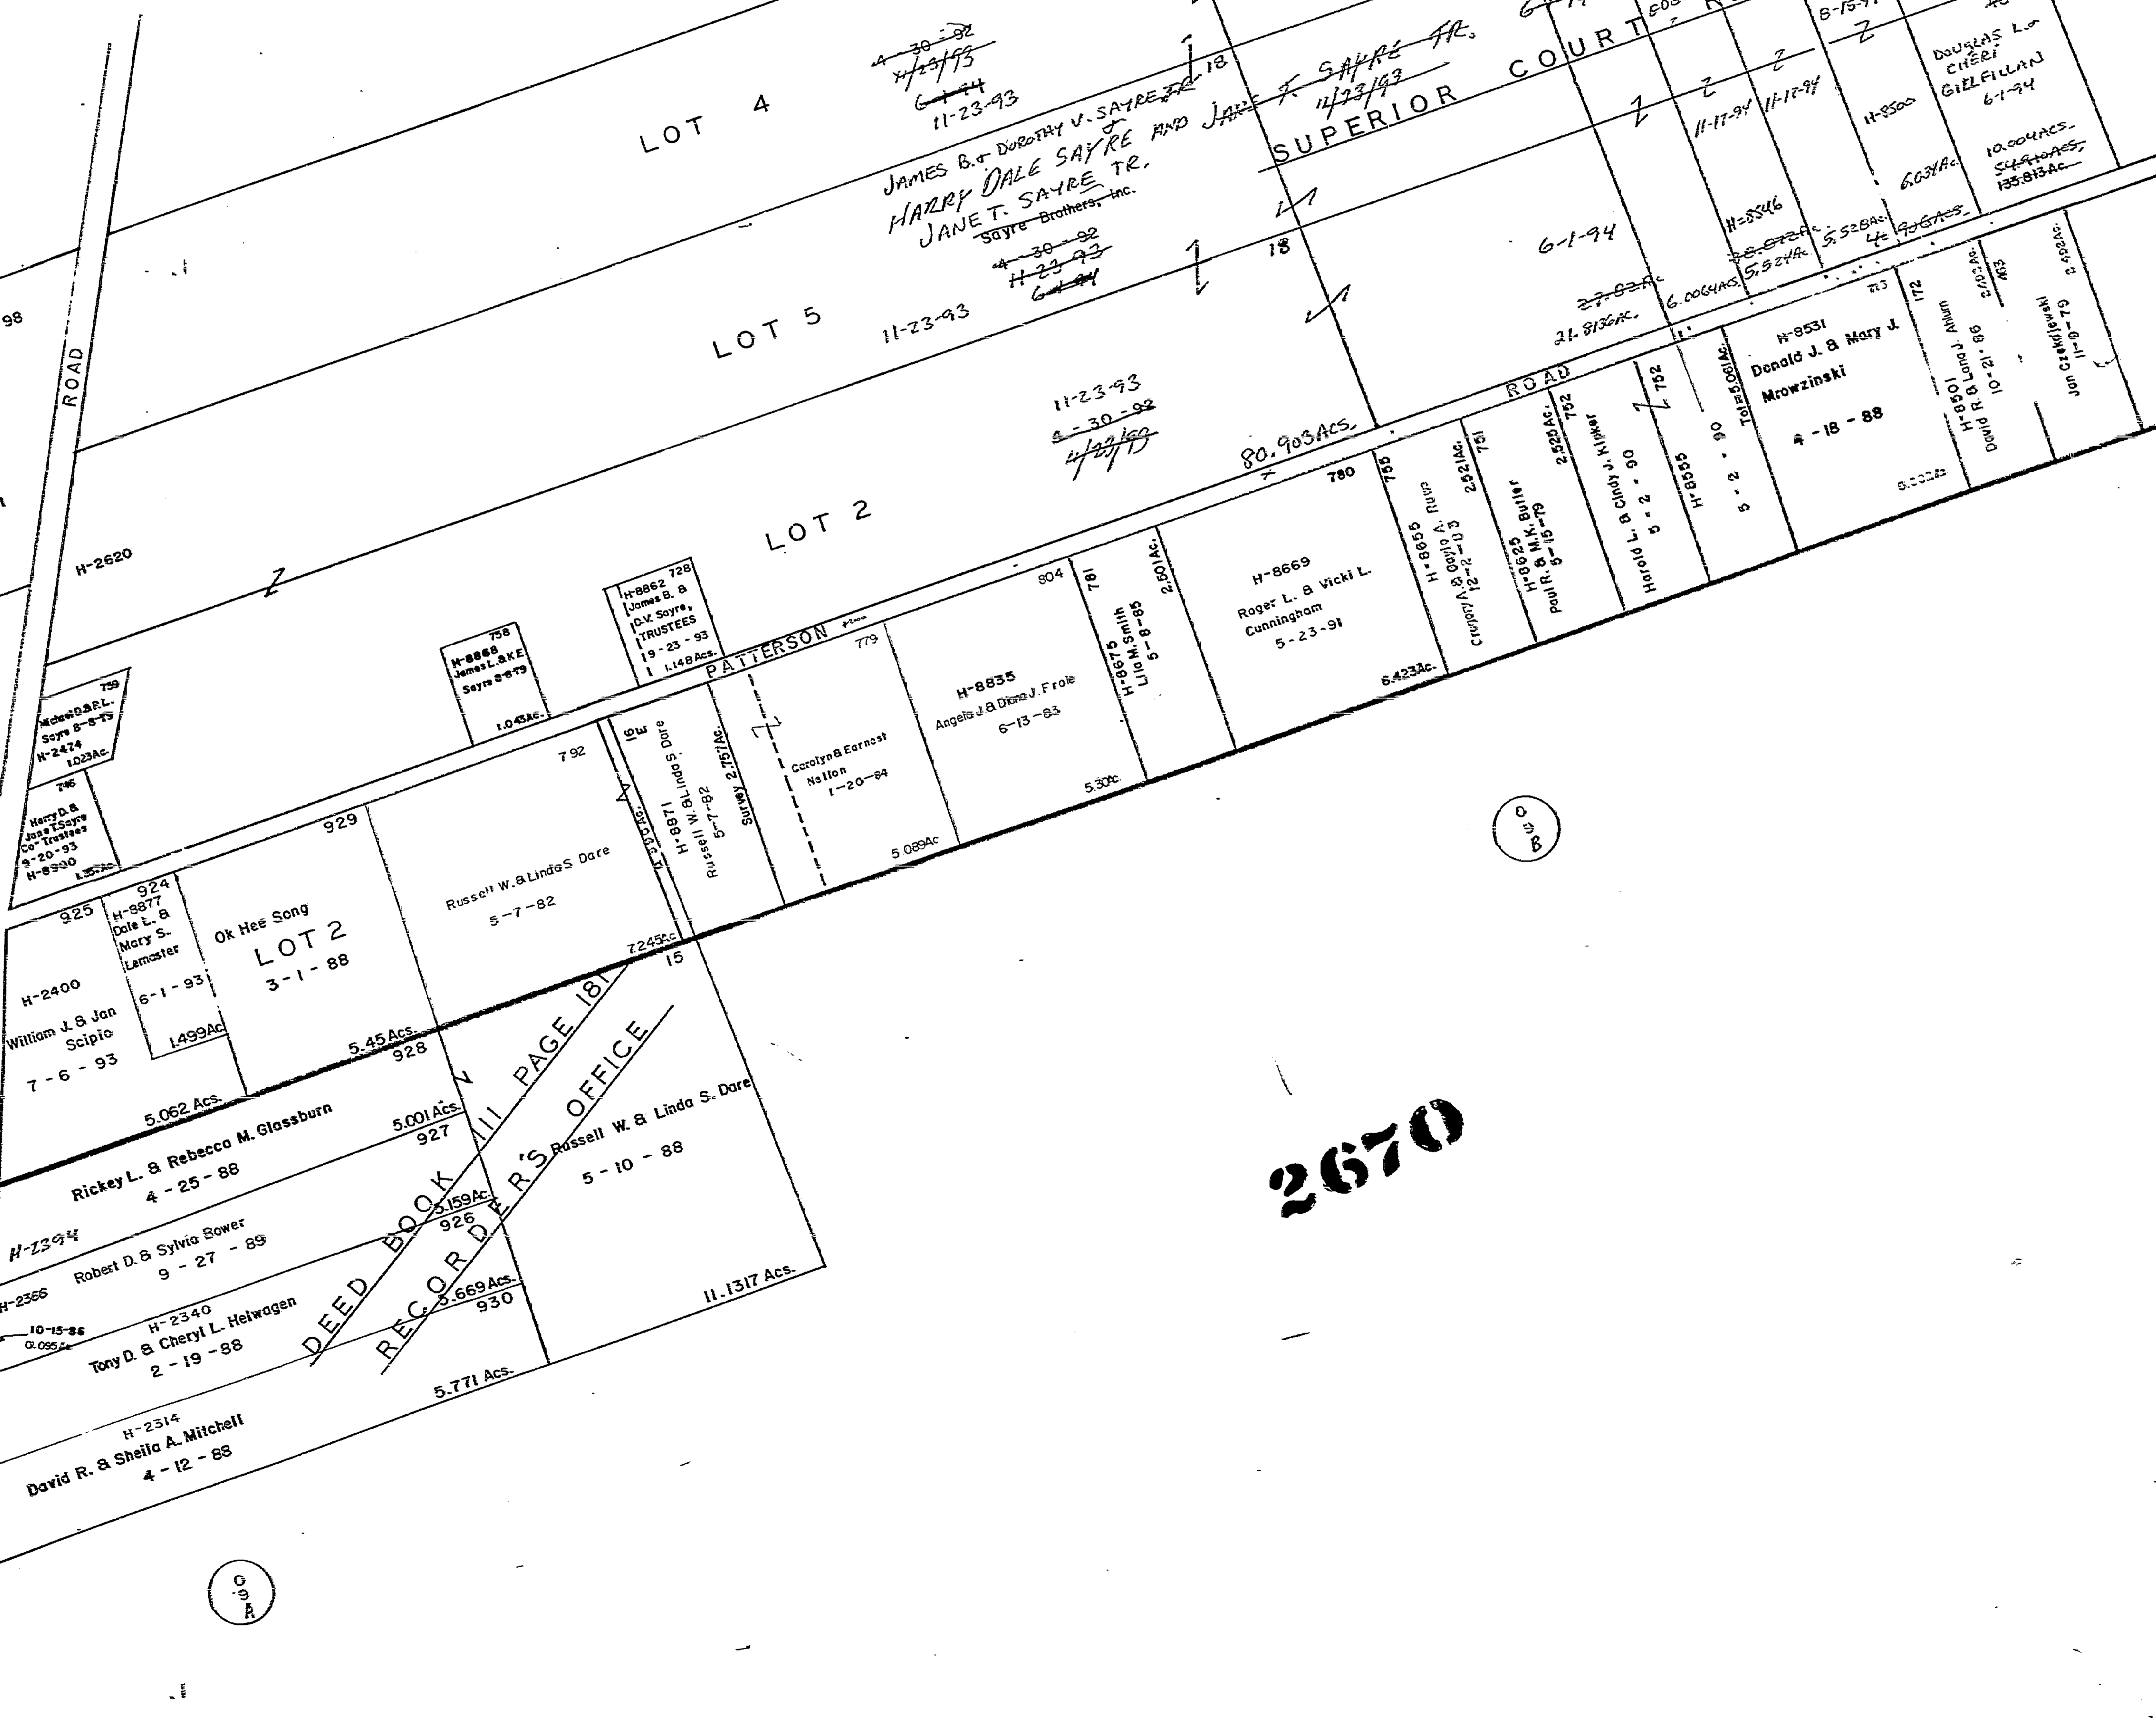

0-7-F  
1998