O-11-A
BROWN TWP.

N

SCALE 1"=200'

VMS

TAXING DISTRICTS

BROWN TWP. 12C

PRAIRIE TWP. ~~SCIOTO DARBY S.D.~~ Hilliard City S.D.

H--- HOUSE NUMBERS


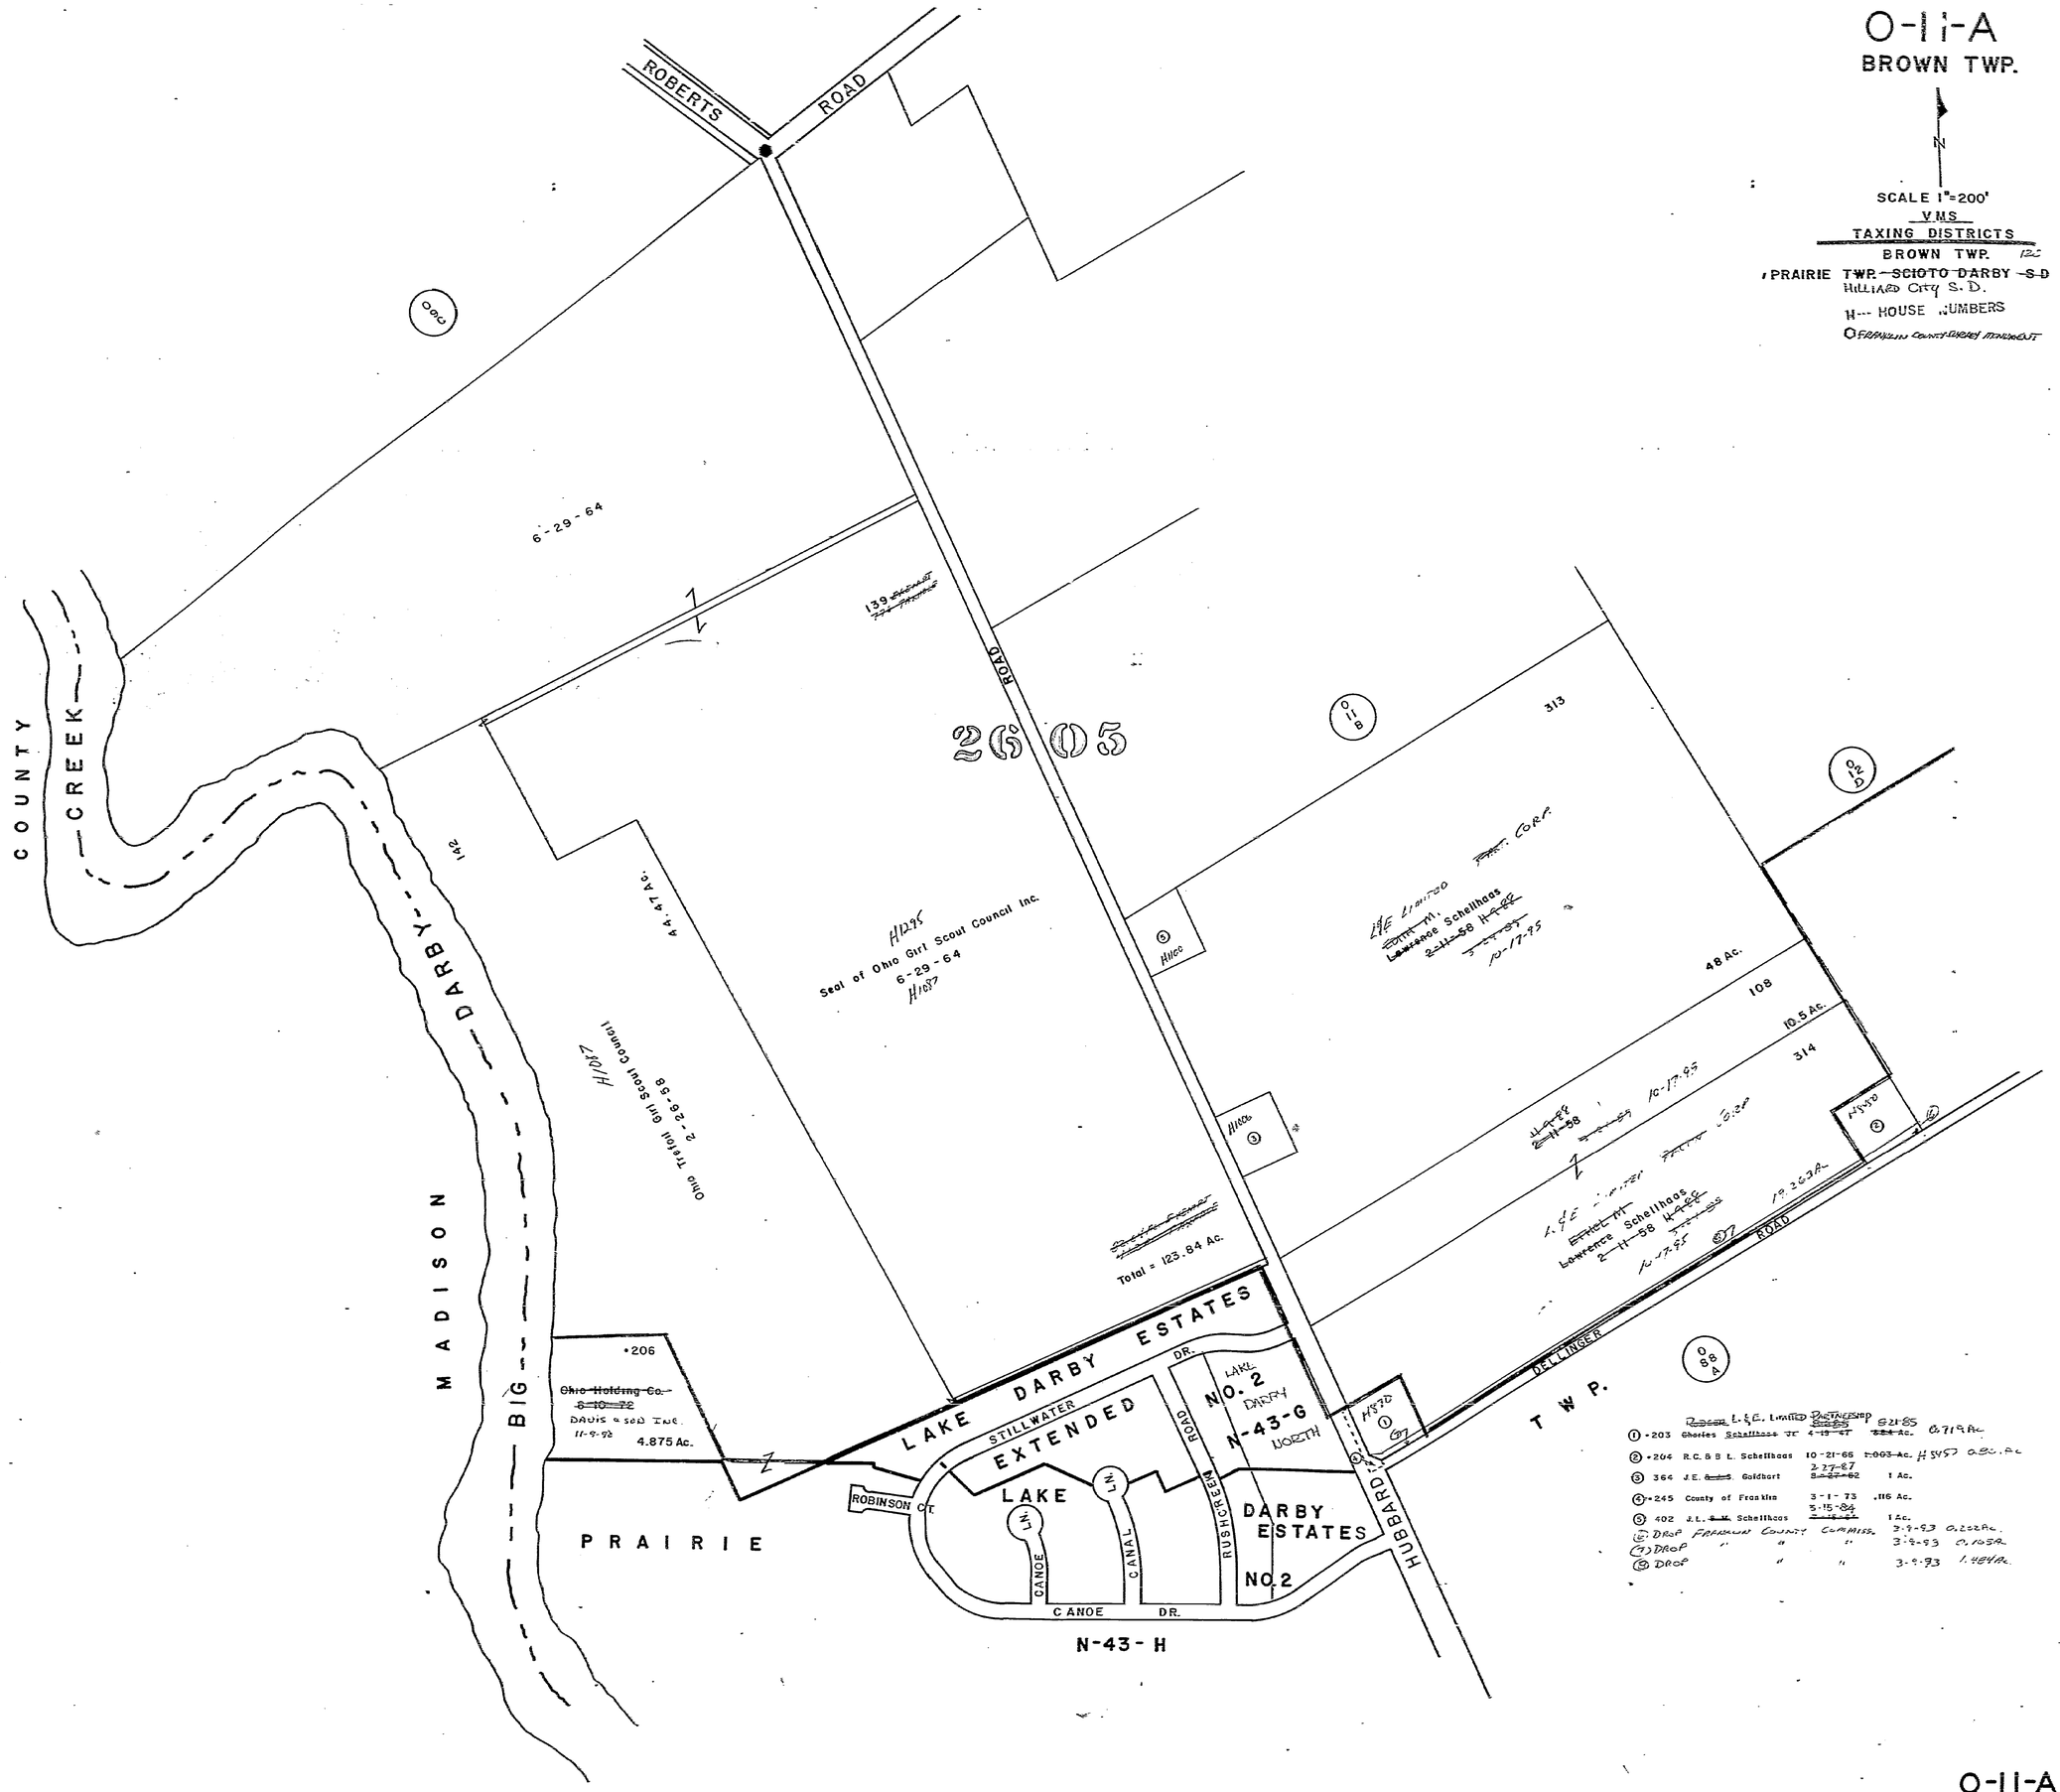

① •203	~~Charles Schelthaas Jr~~	4-19-47	~~.884 Ac.~~	0.719 Ac.
② •204	R.C. & B.L. Schelthaas	10-21-66	~~1.003 Ac.~~	H5457 0.82 Ac.
③ 364	J.E. ~~&~~ Goldhart	2-27-87 ~~8-27-82~~	1 Ac.	
④ •245	County of Franklin	3-1-73	.116 Ac.	
⑤ 402	J.L. ~~& M.~~ Schelthaas	5-15-84 ~~2-14-67~~	1 Ac.	
⑥ DROP	FRANKLIN COUNTY COMMISS.		3-9-93	0.222 Ac.
⑦ DROP	"	"	3-9-93	0.105 Ac.
⑧ DROP	"	"	3-9-93	1.484 Ac.

O-11-A

10-6-77

Drawn by	RAC
Traced by	RAC
Checked by	RAC
Date of Map	RAC